
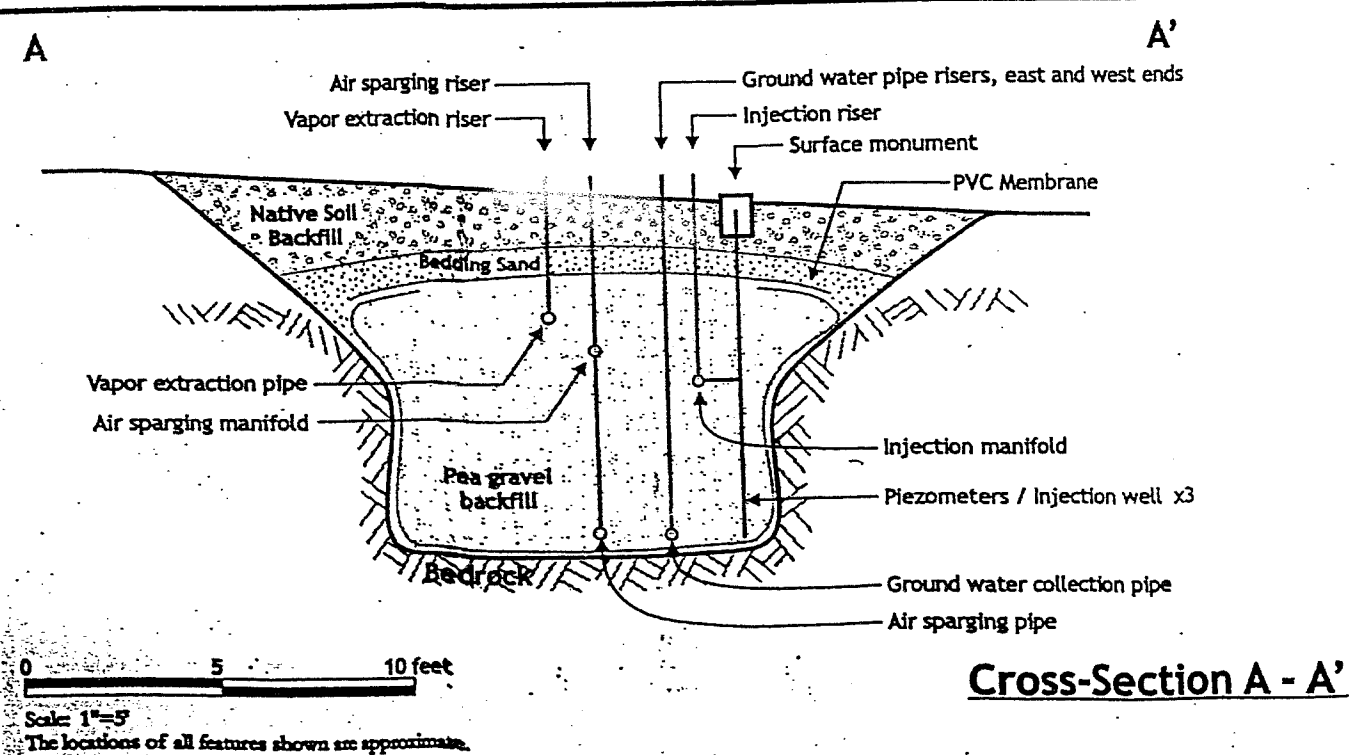


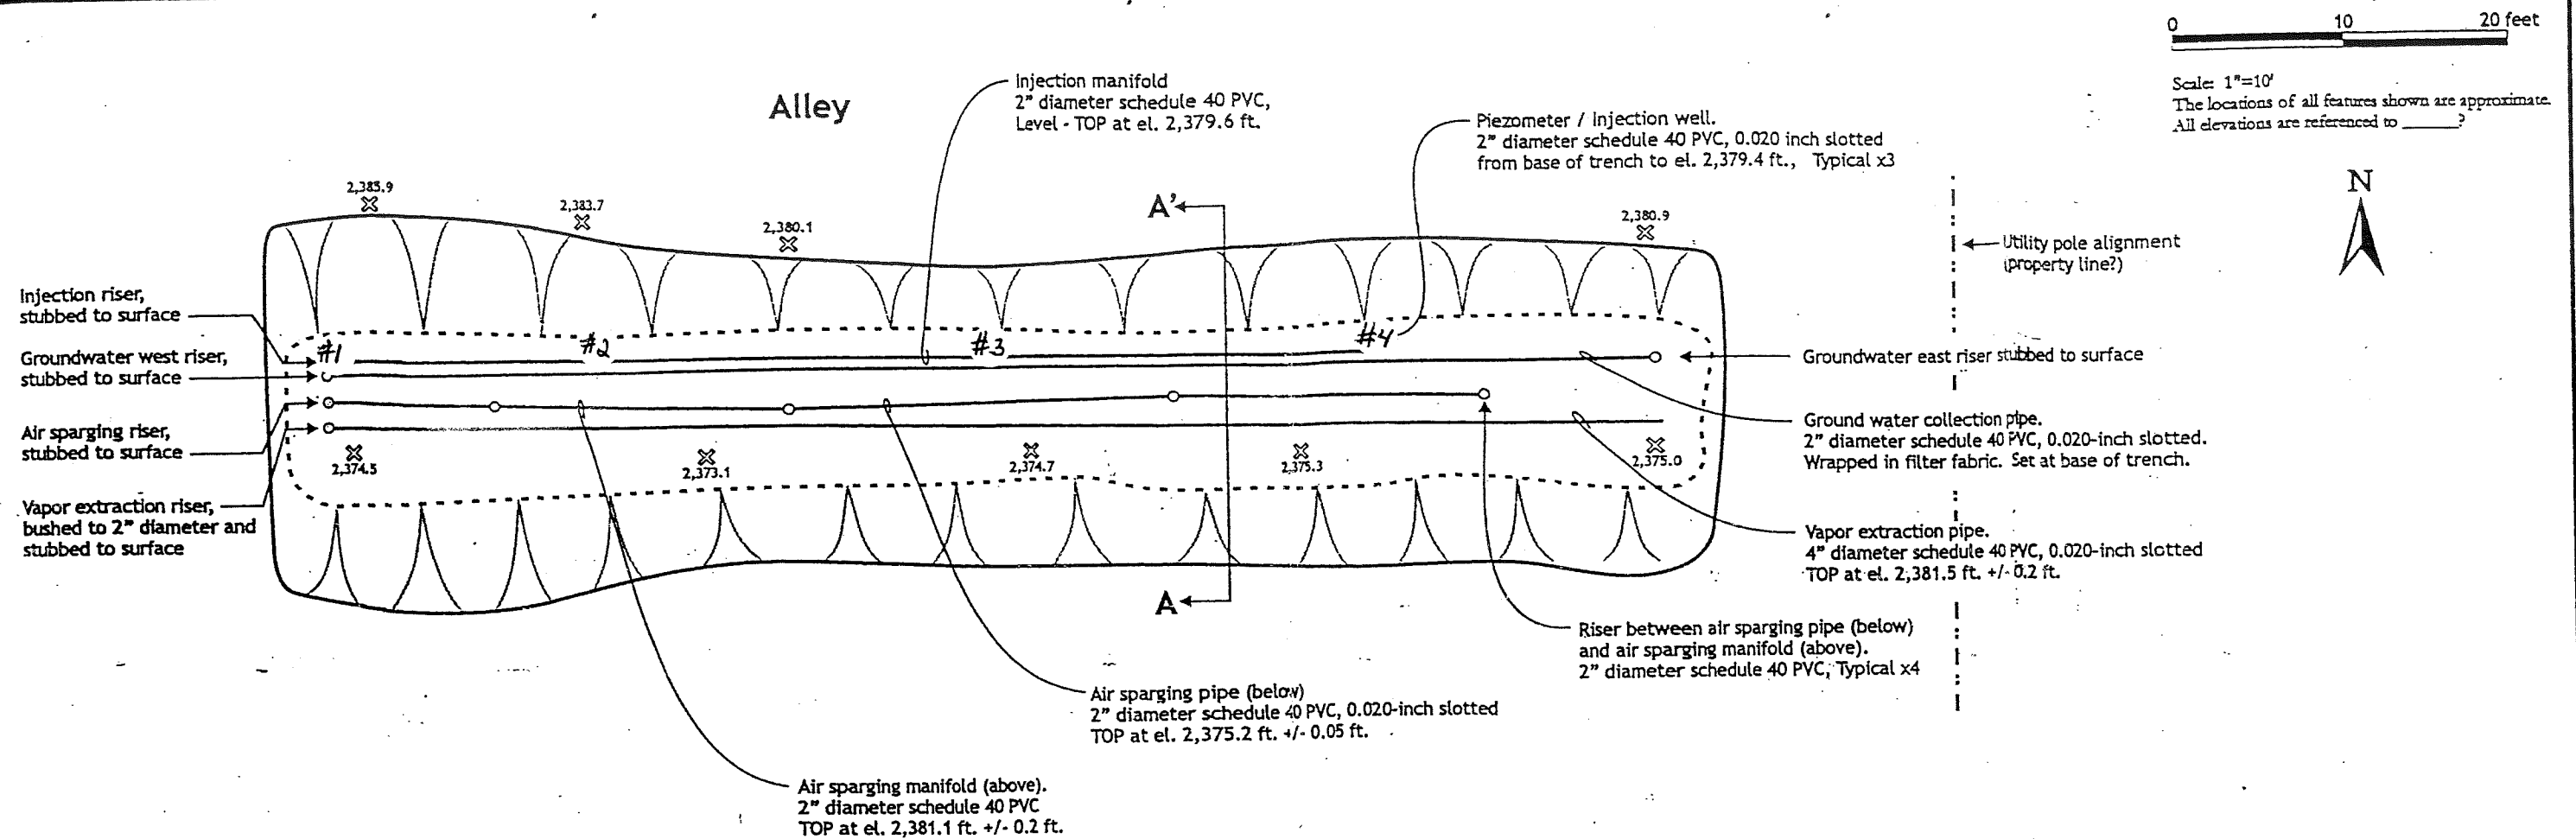

**Priceless Gas
Ground Water Treatment System**
1110 Morgan Street
Davenport, Washington

GLACIER
environmental services, inc.
4416 Russell Road, Suite A
Mukilteo, Washington 98275
425-355-2822

Pinnacle GeoSciences
13620 NE 20th Street, Suite J.
Bellevue, Washington 98005-4901
425-649-7538

Division: _____
Drawn: SCP
Checked: NLP

Approved: NLP 01/05/2005

Size
B

Scale
1 inch = 10 feet

Drawing Number
Treatment System As-Built

Revision
0

Figure 3