




ALISTO ENGINEERING GROUP

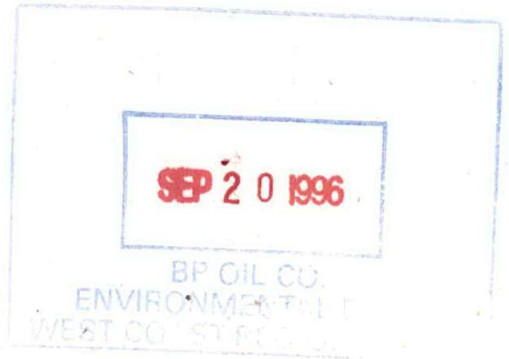

September 19, 1996

Mr. Peter DeSantis
BP Oil Company
295 S.W. 41st Street
Renton, Washington 98055

20-008-003-02

Subject: Remediation System Well Installations
BP Oil Company Service Station No. 11066
2421 148th Avenue N.E.
Bellevue, Washington

Dear Mr. DeSantis:

BP Oil Company retained Alisto Engineering Group to install 13 air sparging and/or dual completion (air sparging and vapor extraction) wells at BP Oil Company Service Station No. 11066, 2421 148th Avenue N.E., Bellevue, Washington. The work was performed as part of the proposed remediation system. The well locations are shown on the attached site plan.

Before drilling, well start cards were acquired from the Washington State Department of Ecology by the drilling contractor, Geo-Tech Explorations. Copies of the start cards are attached. Seven dual completion wells (CW1 through CW-7) and six air sparging wells (SP-2 through SP-7) were completed between July 15 and 22, 1996. The borings were drilled to depths ranging from 37 to 38 feet using a truck-mounted drilling rig with hollow-stem augers. During drilling, soil cuttings were logged using the Unified Soil Classification System indicating soil type, color, and moisture content. Soil cuttings were also field-screened for organic vapors using a photo-ionization detector.

The wells were constructed in the borings through the auger to centralize the well casing and minimize the introduction of native material into the annulus space. In the dual completion wells, the air sparging wells were constructed of 1-inch-diameter schedule 40 poly-vinyl chloride (PVC) 0.010-inch slotted casing at the bottom 2 feet, with blank casing to approximately 2 feet below grade. The vapor extraction wells were constructed of 2-inch diameter PVC 0.010-inch slotted casing.

The annular space at the screened portion of the air sparging wells were backfilled with 10/20 sand (filter pack) to approximately six inches above the top of the screened section. Approximately 6 inches of bentonite was added to the annulus above the filter pack and hydrated to minimize intrusion of cement into the filter pack. The remaining annulus was then sealed with neat cement grout to between 21 and 25 feet. The augers were extracted to above the grout and left in-place overnight while the cement grout cured.

0001 0 5 1832

Mr. Peter DeSantis
September 19, 1996
Page 2

The vapor extraction wells were installed within the same borehole as the air sparging wells. Each vapor extraction well was constructed with 2-inch-diameter PVC 0.010-inch slotted section from the top of the lower grout layer to between 5 and 7 feet below grade, and blank section from the top of the slotted casing to approximately 6 inches below grade.


The screened portion of the vapor extraction wells were backfilled with 10/20 sand to approximately 6 inches above the top of the screened interval. Approximately 6 inches of bentonite was added to the annulus above the filter pack and hydrated. The remaining annulus was sealed with cement to approximately 10 inches below grade. The surface seal was constructed with 6 inches of sand covered by 3 inches of quick-set concrete.

Sparging wells SP-2 through SP-7 were constructed with 2-inch-diameter PVC 0.010-inch slotted casing. The screened section of SP-2 extends from 36 to 37 feet, and the screened sections of SP-3 through SP-7 extend from 35 to 37 feet. Solid PVC casing was installed above the screened intervals to within 6 inches of grade. The annular space at the screened section was backfilled with 10/20 sand to approximately 6 inches above the screened interval. Approximately 6 inches of bentonite was added to the annulus above the filter pack, and the remainder of the annulus was sealed with neat cement grout to approximately 1 foot below grade. Sparging well SP-7 was constructed as above; however, the annular space above the filter pack was sealed to one foot below grade with bentonite chips and hydrated. The borings logs including details of well construction are included as attachments.

Please call if you have questions or comments.

Sincerely,



ALISTO ENGINEERING GROUP

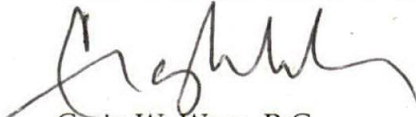

Craig W. Ware, R.G.
Project Manager

Attachments

Attachments

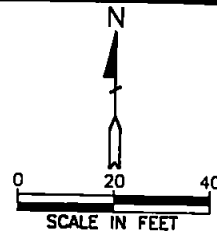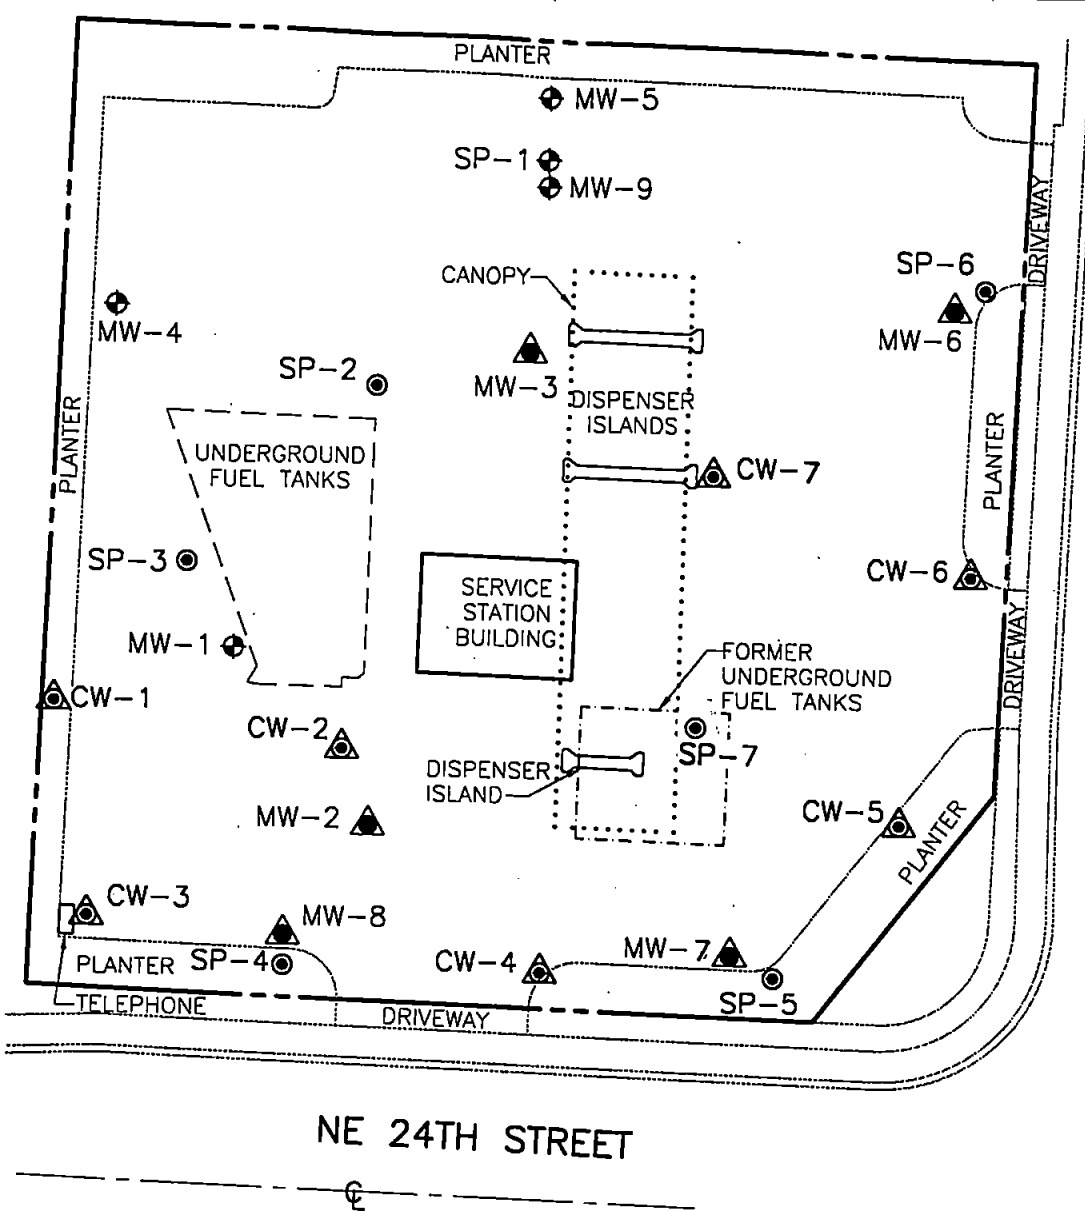

LEGEND

- ⊕ GROUNDWATER MONITORING WELL
- ▲ VAPOR EXTRACTION WELL
- ⊙ AIR SPARGING POINT
- ⊕ VAPOR EXTRACTION WELL

FIGURE 1

SITE PLAN



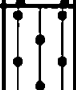

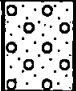
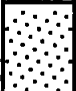









BP OIL SERVICE STATION NO. 11066
2421 148TH AVENUE N.E.
BELLEVUE, WASHINGTON

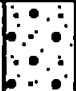PROJECT NO. 20-008



ALISTO ENGINEERING GROUP
TUKWILA, WASHINGTON

GEOLOGIC LEGEND

COARSE-GRAINED SOILS	GRAVELS more than 1/2 of coarse fraction > No. 4 Sieve	LITTLE OR NO FINES		GW	Well-graded gravels, gravel-sand mixtures, little or no fines
				GP	Poorly-graded gravels, gravel-sand mixtures
		APPRECIABLE NO FINES		GM	Silty gravels, gravel-sand-silt mixtures
				GC	Clayey gravels, gravel-sand-clay mixtures
	SANDS more than 1/2 of coarse fraction < No. 4 Sieve	LITTLE OR NO FINES		SW	Well-graded sands, gravelly sands, little or no fines
				SP	Poorly-graded sands, gravelly sands, little or no fines
		APPRECIABLE NO FINES		SM	Silty sands, sand-silt mixtures
				SC	Clayey sands, sand-clay mixtures
FINE-GRAINED SOILS	SILTS AND CLAYS Liquid limit < 50		ML	Inorganic silts and very fine sands, rock flour, silty or clayey fine sands or clayey silts with slight plasticity	
			CL	Inorganic clays of low to medium plasticity, gravelly clays, sandy clays, silty clays, lean clays	
			OL	Organic silts and organic silty clays of low plasticity	
	SILTS AND CLAYS Liquid limit > 50		MH	Inorganic silts, micaceous or diatomaceous fine sandy or silty soils, elastic silts	
			CH	Inorganic clays of high plasticity, fat clays	
			OH	Organic clays of medium to high plasticity, organic silts	
HIGHLY ORGANIC SOILS			Pt	Peat and other highly organic soils	

SYMBOL LEGEND:

	Cement
	Sand
	Bentonite
	Driven Interval of Soil Sample
	Sample preserved for possible analysis
	No sample recovered
	Stabilized water level
	Groundwater level encountered during drilling

LEGEND TO BORING LOGS

BP OIL STATION NO. 11066
2421 148TH AVENUE
NORTH BELLEVUE, WASHINGTON
PROJECT NO. 20-008



ALISTO ENGINEERING GROUP
TUKWILA, WASHINGTON



ALISTO ENGINEERING GROUP
TUKWILA, WASHINGTON

LOG OF BORING SP-2

Page 1 of 1

SEE SITE PLAN

ALISTO PROJECT NO: 20-008-03

DATE DRILLED: 07/15/96

CLIENT: BP Oil Company

LOCATION: 2421 148th Avenue NE, Bellevue, Washington

DRILLING METHOD: Hollow-Stem Auger (10"); logged by cuttings

DRILLING COMPANY: Geotech Exploration

CASING ELEVATION:

LOGGED BY: J. Day

APPROVED BY: Al Sevilla

BLOWS/6 IN.

PTD VALUES

WELL DIAGRAM

DEPTH
feet

SAMPLES

GRAPHIC LOG


SOIL CLASS

GEOLOGIC DESCRIPTION

4

240

440

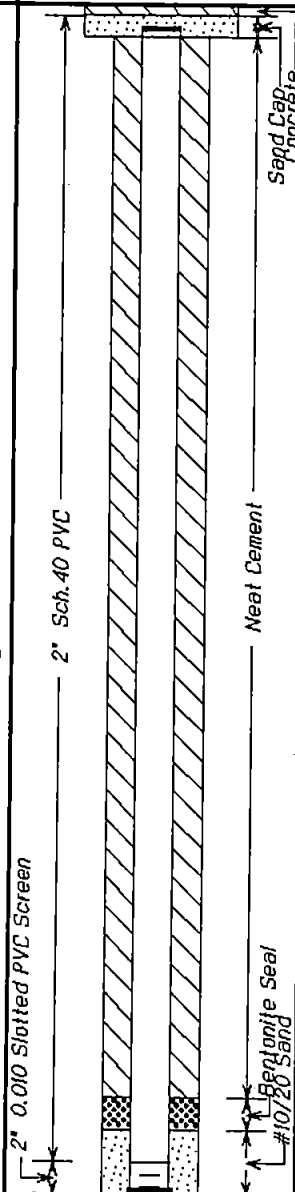

6

12

18

24

30

36

SM

3" asphalt over 12" aggregate base.

silty SAND: olive gray, moist; fine- to medium-grained sand.

Boring terminated at 37 feet.



ALISTO ENGINEERING GROUP
TUKWILA, WASHINGTON

LOG OF BORING SP-3

Page 1 of 1

SEE SITE PLAN

ALISTO PROJECT NO: 20-008-03

DATE DRILLED: 07/18/98

CLIENT: BP Oil Company

LOCATION: 2421 148th Avenue NE, Bellevue, Washington


DRILLING METHOD: Hollow-Stem Auger (10"); logged by cuttings

DRILLING COMPANY: Geotech Exploration

CASING ELEVATION:

LOGGED BY: J. Day

APPROVED BY: Al Sevilla

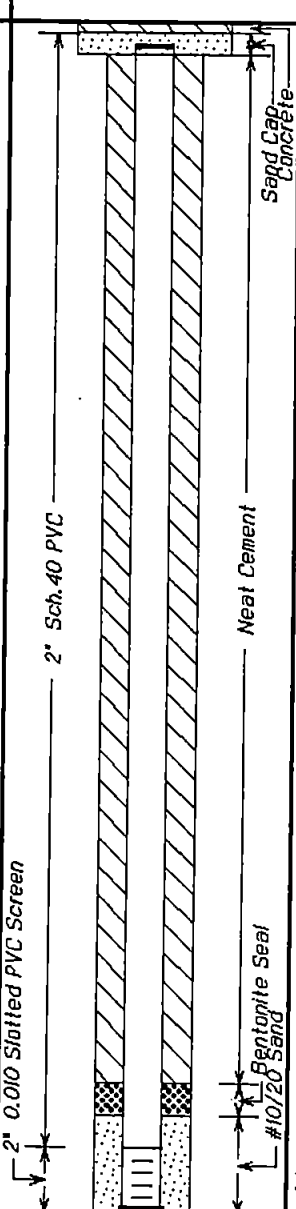BLOWS/8 IN.	PTD VALUES	WELL DIAGRAM	DEPTH feet	SAMPLES	GRAPHIC LOG	SOIL CLASS	GEOLOGIC DESCRIPTION
						SM	3" asphalt over 8" aggregate base. silty SAND: olive, moist; fine- to coarse-grained sand; occasional gravel; some wood debris. Same: at 5 feet, olive gray, moist; fine- to medium-grained sand; trace of coarse sand and gravel up to 2-inch-diameter. Same: at 10 feet, light brown; predominantly fine-grained sand.
							Boring terminated at 37 feet.



ALISTO ENGINEERING GROUP
TUKWILA, WASHINGTON

LOG OF BORING SP-4

Page 1 of 1

SEE SITE PLAN

ALISTO PROJECT NO: 20-008-03

DATE DRILLED: 07/17/96

CLIENT: BP Oil Company

LOCATION: 2421 148th Avenue NE, Bellevue, Washington

DRILLING METHOD: Hollow-Stem Auger (8"); logged by cuttings

DRILLING COMPANY: Geotech Exploration

CASING ELEVATION:

LOGGED BY: J. Day

APPROVED BY: Al Sevilla

BLOWS/6 IN.

PTD VALUES

WELL DIAGRAM


DEPTH
feet

SAMPLES

GRAPHIC LOG

SOIL CLASS

GEOLOGIC DESCRIPTION

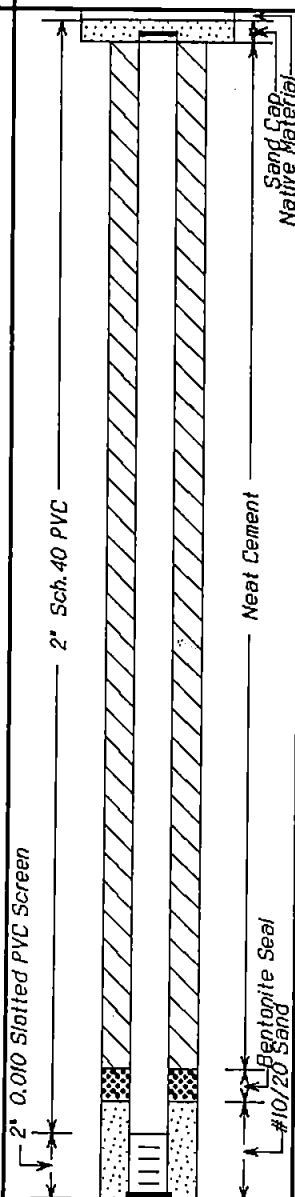

SM

silty SAND: yellow brown; fine- to coarse-grained sand; some gravel.

Same: at 5 feet, color change to olive gray; decrease in silt.

Same: at 11 feet, light olive gray; increase in gravels and cobbles.

Boring terminated at 37 feet.



ALISTO ENGINEERING GROUP
TUKWILA, WASHINGTON

LOG OF BORING SP-5

Page 1 of 1

SEE SITE PLAN

ALISTO PROJECT NO: 20-008-03

DATE DRILLED: 07/18/98

CLIENT: BP Oil Company

LOCATION: 2421 148th Avenue NE, Bellevue, Washington

DRILLING METHOD: Hollow-Stem Auger (8"); logged by cuttings

DRILLING COMPANY: Geotech Exploration

CASING ELEVATION:

LOGGED BY: G.B.L.

APPROVED BY: Al Sevilla

BLOWS/8 IN.

PID VALUES

WELL DIAGRAM

DEPTH
feet

SAMPLES

GRAPHIC LOG




SOIL CLASS

GEOLOGIC DESCRIPTION

Pt
SM

4" bark and mulch

silty SAND: olive gray, dense; fine- to coarse-grained sand;
trace gravel.

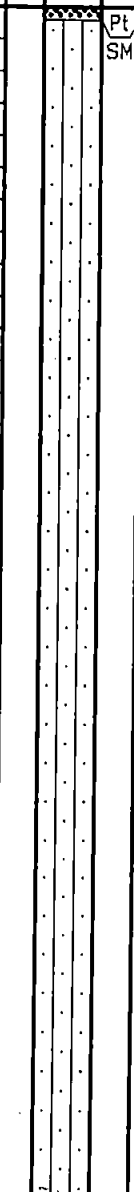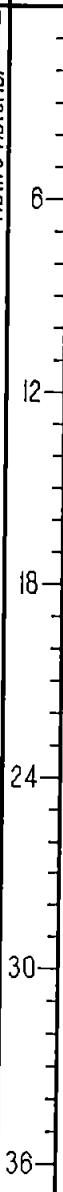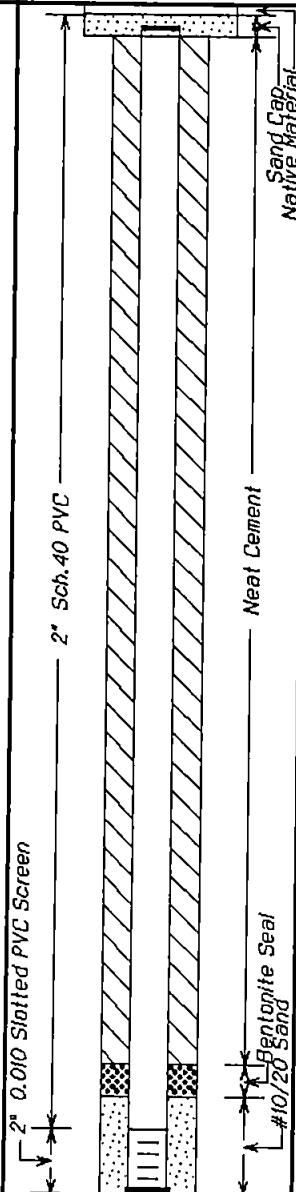

Boring terminated at 37 feet.



ALISTO ENGINEERING GROUP
TUKWILA, WASHINGTON

LOG OF BORING SP-6

Page 1 of 1

SEE SITE PLAN

ALISTO PROJECT NO: 20-008-03

DATE DRILLED: 07/22/96

CLIENT: BP Oil Company

LOCATION: 2421 148th Avenue NE, Bellevue, Washington

DRILLING METHOD: Hollow-Stem Auger (8"); logged by cuttings

DRILLING COMPANY: Geotech Exploration

CASING ELEVATION:

LOGGED BY: G.B.L.

APPROVED BY: Al Sevilla

BLOWS/6 IN.

PID VALUES

WELL DIAGRAM

DEPTH
feet

SAMPLES

GRAPHIC LOG

SOIL CLASS

GEOLOGIC DESCRIPTION

Pt
OL

3" asphalt over 8" aggregate base

Organic sandy soil: brown with gravel and construction debris.

SM

silty SAND: olive gray; fine- to medium-grained sand; trace of coarse-grained sand; trace gravel.

Boring terminated at 38 feet.



ALISTO ENGINEERING GROUP
TUKWILA, WASHINGTON

LOG OF BORING SP-7

Page 1 of 1

SEE SITE PLAN

ALISTO PROJECT NO: 20-008-03

DATE DRILLED: 07/19/96

CLIENT: BP Oil Company

LOCATION: 2421 148th Avenue NE, Bellevue, Washington

DRILLING METHOD: Hollow-Stem Auger (8"); logged by cuttings

DRILLING COMPANY: Geotech Exploration

CASING ELEVATION:

LOGGED BY: G.B.L.

APPROVED BY: Al Sevilla

BLOWS/6 IN.

PTD VALUES

WELL DIAGRAM

DEPTH
feet

SAMPLES

GRAPHIC LOG

SOIL CLASS

GEOLOGIC DESCRIPTION

3" asphalt over 12" aggregate base

SAND: light brown; well graded; trace silt to 8 feet.

silty SAND: olive gray, compact; fine- to medium-grained sand; trace gravel.

Boring terminated at 37 feet.



ALISTO ENGINEERING GROUP
TUKWILA, WASHINGTON

LOG OF BORING CW-1

Page 1 of 1

SEE SITE PLAN

ALISTO PROJECT NO: 20-008-03

DATE DRILLED: 07/16/96

CLIENT: BP Oil Company

LOCATION: 2421 148th Avenue NE, Bellevue, Washington

DRILLING METHOD: Hollow-Stem Auger (10"); logged by cuttings

DRILLING COMPANY: Geotech Exploration

CASING ELEVATION:

LOGGED BY: J. Day

APPROVED BY: Al Sevilla

BLOWS/6 IN.

PTD VALUES

WELL DIAGRAM



DEPTH
feet

SAMPLES

GRAPHIC LOG

SOIL CLASS

GEOLOGIC DESCRIPTION

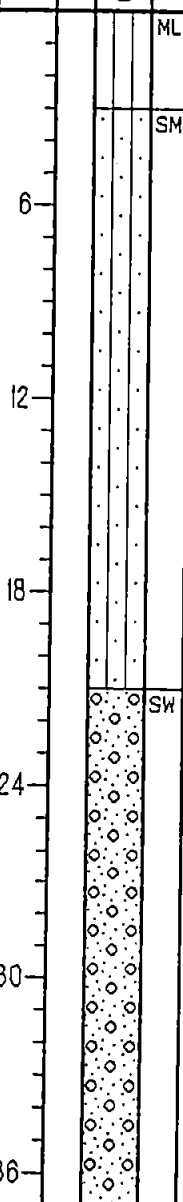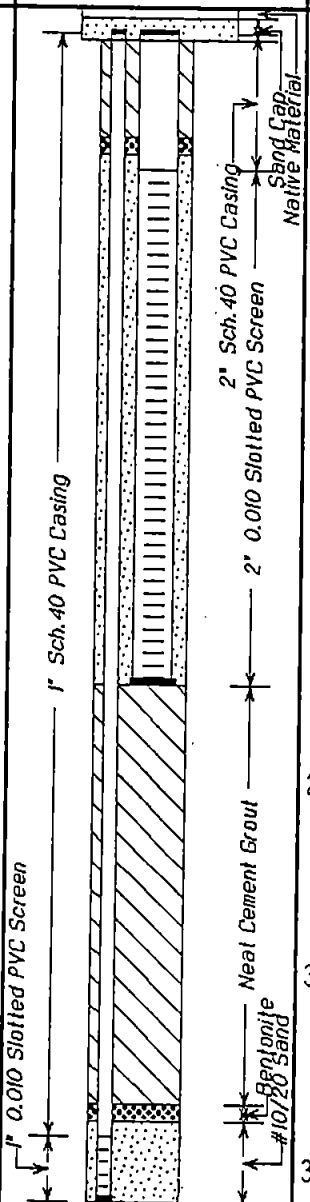

ML

sandy SILT: brown, moist; fine- to medium-grained sand.

SM

silty SAND: light olive brown, moist; fine- to coarse-grained sand.

Same: at 8 feet, occasional gravel and cobbles.

Same: at 11 feet, color change to light olive gray; decreased silt fraction.

SW

SAND: light olive gray, moist to wet; fine- to medium-grained sand; trace coarse-grained sand; gravel and cobbles.

Boring terminated at 37 feet.



ALISTO ENGINEERING GROUP
TUKWILA, WASHINGTON

LOG OF BORING CW-2

Page 1 of 1

SEE SITE PLAN

ALISTO PROJECT NO: 20-008-03

DATE DRILLED: 07/16/96

CLIENT: BP Oil Company

LOCATION: 2421 148th Avenue NE, Bellevue, Washington


DRILLING METHOD: Hollow-Stem Auger (10"); logged by cuttings

DRILLING COMPANY: Geotech Exploration

CASING ELEVATION:

LOGGED BY: J. Day

APPROVED BY: Al Sevilla

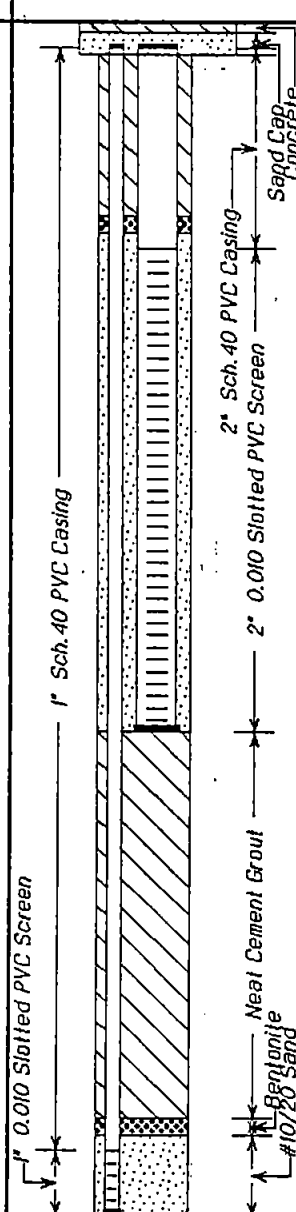BLOWS/8 IN.	PTD VALUES	WELL DIAGRAM	DEPTH feet	SAMPLES	GRAPHIC LOG	SOIL CLASS	GEOLOGIC DESCRIPTION
							
			0			SM	3.5" asphalt over 12" aggregate base
			6				silty SAND: yellowish brown, moist; fine- to medium-grained sand; some gravel up to 1 1/2-inch-diameter; high silt fraction. Same: at 5 feet, light olive brown; decreased silt fraction.
			12				Same: below 12 feet, color changes to olive gray.
			18			SP	SAND: light olive gray, moist; fine- to medium-grained sand; trace of coarse-grained sand and rounded gravel; occasional cobbles.
			24				
			30				
			36				
							Boring terminated at 37 feet.



ALISTO ENGINEERING GROUP
TUKWILA, WASHINGTON

LOG OF BORING CW-3

Page 1 of 1

SEE SITE PLAN

ALISTO PROJECT NO: 20-008-03

DATE DRILLED: 07/16/98

CLIENT: BP Oil Company

LOCATION: 2421 148th Avenue NE, Bellevue, Washington

DRILLING METHOD: Hollow-Stem Auger (10"); logged by cuttings

DRILLING COMPANY: Geotech Exploration

CASING ELEVATION:

LOGGED BY: J. Day

APPROVED BY: Al Sevilla

BLOWS/6 IN.

PID VALUES

WELL DIAGRAM


DEPTH
feet

SAMPLES

GRAPHIC LOG

SOIL CLASS

GEOLOGIC DESCRIPTION

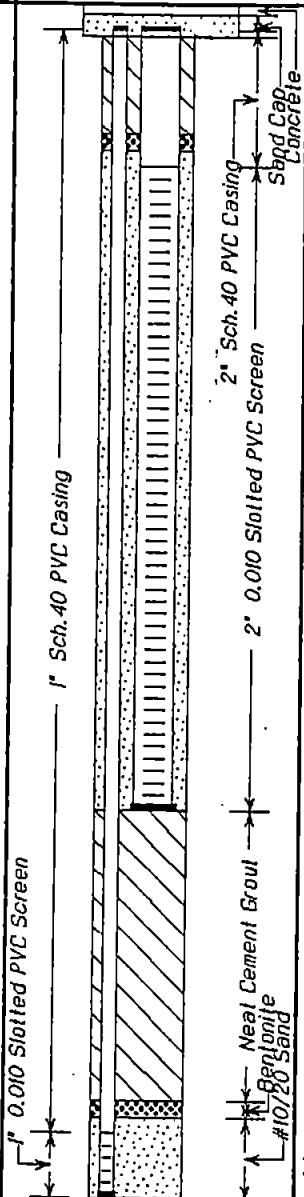

6

12

18

24

30

36

SM

SW

3" asphalt underlain by pea gravel

silty SAND: olive to olive gray, moist; fine- to medium-grained sand; some coarse-grained sand.

Same: decreased silt fraction.

SAND: pale olive gray, moist; fine- to coarse-grained sand; fine to 2-inch-diameter gravel; occasional cobbles.

Boring terminated at 37 feet.



ALISTO ENGINEERING GROUP
TUKWILA, WASHINGTON

LOG OF BORING CW-4

Page 1 of 1

SEE SITE PLAN

ALISTO PROJECT NO: 20-008-03

DATE DRILLED: 07/17/96

CLIENT: BP Oil Company

LOCATION: 2421 148th Avenue NE, Bellevue, Washington

DRILLING METHOD: Hollow-Stem Auger (10"); logged by cuttings

DRILLING COMPANY: Geotech Exploration

CASING ELEVATION:

LOGGED BY: G.B.L.

APPROVED BY: Al Sevilla

BLOWS/6 IN.	PTD VALUES	WELL DIAGRAM	DEPTH feet	SAMPLES	GRAPHIC LOG	SOIL CLASS	GEOLOGIC DESCRIPTION
							3.5" asphalt over 12" aggregate base
						SP	SAND: clean sand (backfill) to 4 feet with construction debris.
			6			SM	silty SAND: olive gray, moist, dense; trace of coarse-grained sand; trace of gravel up to 2-inches-diameter.
	ND		12				
	30		18				
	400+		24				Same: at 20 feet, strong hydrocarbon odor.
	430+		30				
			36				
							Boring terminated at 37 feet.



ALISTO ENGINEERING GROUP
TUKWILA, WASHINGTON

LOG OF BORING CW-5

Page 1 of 1

SEE SITE PLAN

ALISTO PROJECT NO: 20-008-03

DATE DRILLED: 07/18/98

CLIENT: BP Oil Company

LOCATION: 2421 148th Avenue NE, Bellevue, Washington


DRILLING METHOD: Hollow-Stem Auger (10"); logged by cuttings

DRILLING COMPANY: Geotech Exploration

CASING ELEVATION:

LOGGED BY: G.B.L.

APPROVED BY: Al Sevilla

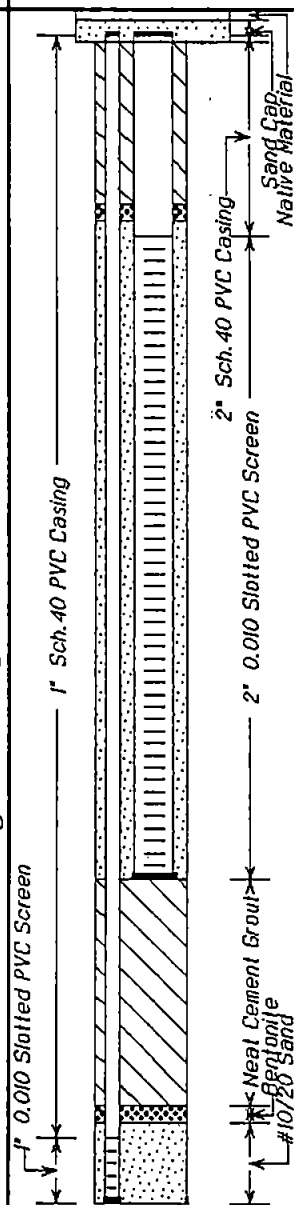BLOWS/8 IN.	PID VALUES	WELL DIAGRAM	DEPTH feet	SAMPLES	GRAPHIC LOG	SOIL CLASS	GEOLOGIC DESCRIPTION
						Pt SM	4" bark and mulch silty SAND: olive gray, dense; trace of coarse sand and gravel. Same
	>120		0				
			12				
			18				
			24				
	>250		30				Same: at 25 feet, damp, more dense.
			36				
							Boring terminated at 37 feet.



ALISTO ENGINEERING GROUP
TUKWILA, WASHINGTON

LOG OF BORING CW-6

Page 1 of 1

SEE SITE PLAN

ALISTO PROJECT NO: 20-008-03

DATE DRILLED: 07/18/98

CLIENT: BP Oil Company

LOCATION: 2421 148th Avenue NE, Bellevue, Washington

DRILLING METHOD: Hollow-Stem Auger (10"); logged by cuttings

DRILLING COMPANY: Geotech Exploration

CASING ELEVATION:

LOGGED BY: G.B.L.

APPROVED BY: Al Sevilla

BLOWS/6 IN.

PTD VALUES

WELL DIAGRAM

DEPTH
feet


SAMPLES

GRAPHIC LOG

SOIL CLASS

GEOLOGIC DESCRIPTION

>150

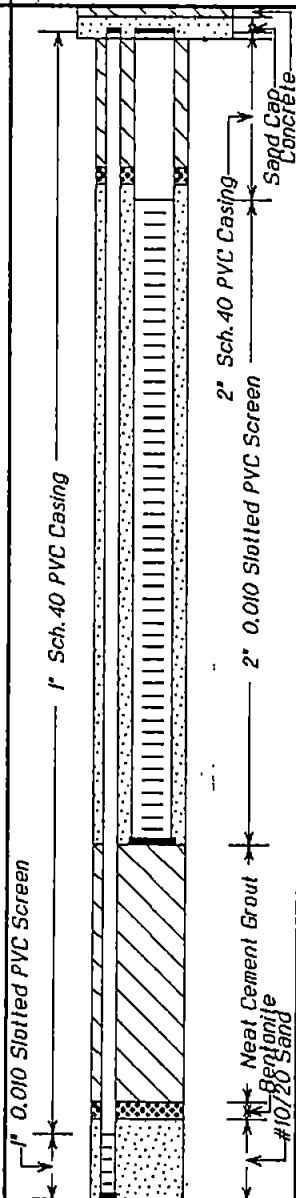

0

12

18

24

30

36

SM

SW

3.5" asphalt over 12" aggregate base

silty SAND: olive gray, compact; trace of coarse-grained sand; trace of gravel.

SAND: gray, damp, compact; fine-grained sand.

Boring terminated at 37 feet.



ALISTO ENGINEERING GROUP
TUKWILA, WASHINGTON

LOG OF BORING CW-7

Page 1 of 1

SEE SITE PLAN

ALISTO PROJECT NO: 20-008-03

DATE DRILLED: 07/18/96

CLIENT: BP Oil Company

LOCATION: 2421 148th Avenue NE, Bellevue, Washington


DRILLING METHOD: Hollow-Stem Auger (10"); logged by cuttings

DRILLING COMPANY: Geotech Exploration

CASING ELEVATION:

LOGGED BY: G.B.L.

APPROVED BY: Al Sevilla

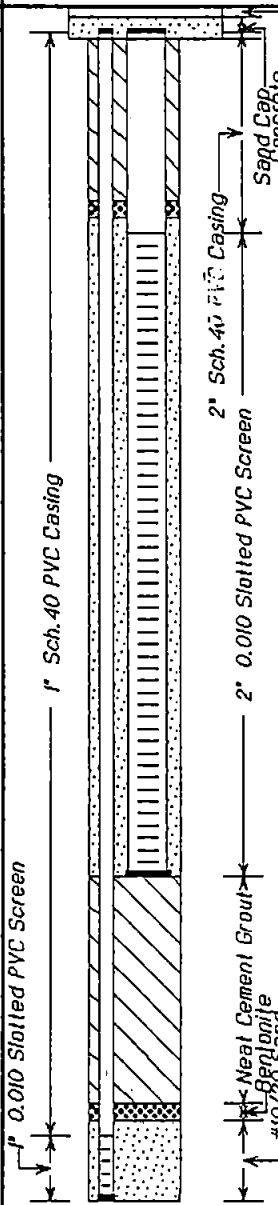
BLOWS/6 IN.	PID VALUES	WELL DIAGRAM	DEPTH feet	SAMPLES	GRAPHIC LOG	SOIL CLASS	GEOLOGIC DESCRIPTION
	15		0			SM	3.5" asphalt over 12" aggregate base
	1400		12				silty SAND: olive gray, moist; fine- to medium-grained sand; gravel up to 2-inch-diameter; trace of coarse-grained sand.
			18				Same: at 15 feet, strong hydrocarbon odor.
			24				Same: at 20 feet, very dense.
			30			SW	SAND: olive gray, moist; fine-grained sand; trace of coarse-grained sand.
			36				Boring terminated at 37 feet.

RESOURCE PROTECTION WELL REPORT

START CARD NO. 27446

PROJECT NAME: B.P. oil
 WELL IDENTIFICATION NO. Dual completion A, B, C, D, E, F, G
 DRILLING METHOD: Hollow stem
 DRILLER: Robert D. Rogers
 FIRM: Geotek Exploration
 SIGNATURE: [Signature]
 CONSULTING FIRM: Alisto
 REPRESENTATIVE: Bruce Lomer

COUNTY: King
 LOCATION: 1/4 1/4 Sec Twn R
 STREET ADDRESS OF WELL: 2421 148th Ave NE
Bellevue
 WATER LEVEL ELEVATION: 26'
 GROUND SURFACE ELEVATION:
 INSTALLED: 18-19 July
 DEVELOPED:

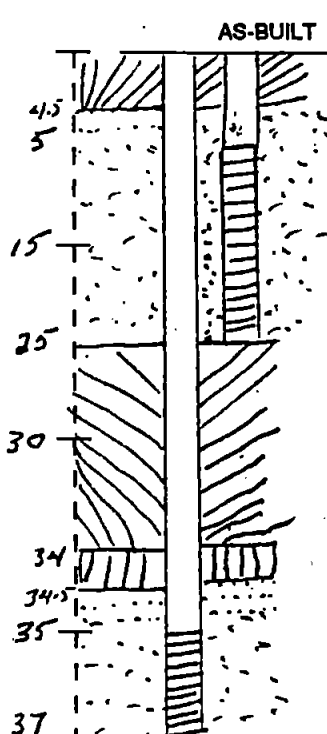

WELL DATA	
Dual Bottom A, B, C, D, E, F, G	Screen 35-37 1" PVC Solid 0-35 1" PVC 10/20 sand 34.5-37 Bentchips 34.0-34.5
Dual Top A	Cement bent grout 25-34 Screen 5-25 2" PVC Solid 0-5 1" PVC 10/20 sand 4.5-25.0 Bentchips 4.0-4.5 Cement bent grout 1-4 Temp protective cover Before trenching 0-1
Dual Top B	Cement bent grout 21-34 Screen 5-21 10/20 Filter pack 4.5-21 Bentchips 4.0-4.5 Cement bent grout 1-4.0
Dual Top C	Cement bent grout 22-34 Screen 7-22 10/20 sand 6.5-22 Bentchip 6.0-6.5 Cement bent grout 1-6.0
Dual Top D	Cement bent grout 24-34 Screen 6-24 10/20 sand 5.5-24 Bentchips 5.0-5.5 Cement bent grout 1-5.0
Top E Top	Cement bent grout 26.5-34 Screen 7-26.5 10/20 sand 6.5-26.5 Bentchips 6.0-6.5 Cement grout 1-6.0
Top F	Cement bent grout 27.5-34 Screen 7.5-27.5 10/20 sand 7.0-27.5 chips 6.5-7.0 Cement grout 1-7.0
Top G	Cement bent grout 28-34 Screen 6-28 10/20 sand 5.5-28 chips 5.0-5.5 grout 1-5

FORMATION DESCRIPTION
Gravel sand silt coaks 0-37

SCALE: 1" = _____


PAGE _____ OF _____

RESOURCE PROTECTION WELL REPORT

START CARD NO. 27446

PROJECT NAME: B.P. Oil
 WELL IDENTIFICATION NO. Sparg 5
 DRILLING METHOD: Hollow Stem
 DRILLER: Robert D. Rogers
 FIRM: Geotek Explorations
 SIGNATURE: [Signature]
 CONSULTING FIRM: Histo
 REPRESENTATIVE: Bruce Lomer

COUNTY: King
 LOCATION: 1/4 1/4 Sec Twn R
 STREET ADDRESS OF WELL: 2421 148th Ave NE
Bellevue
 WATER LEVEL ELEVATION: 26'
 GROUND SURFACE ELEVATION:
 INSTALLED: 19 July 96
 DEVELOPED:

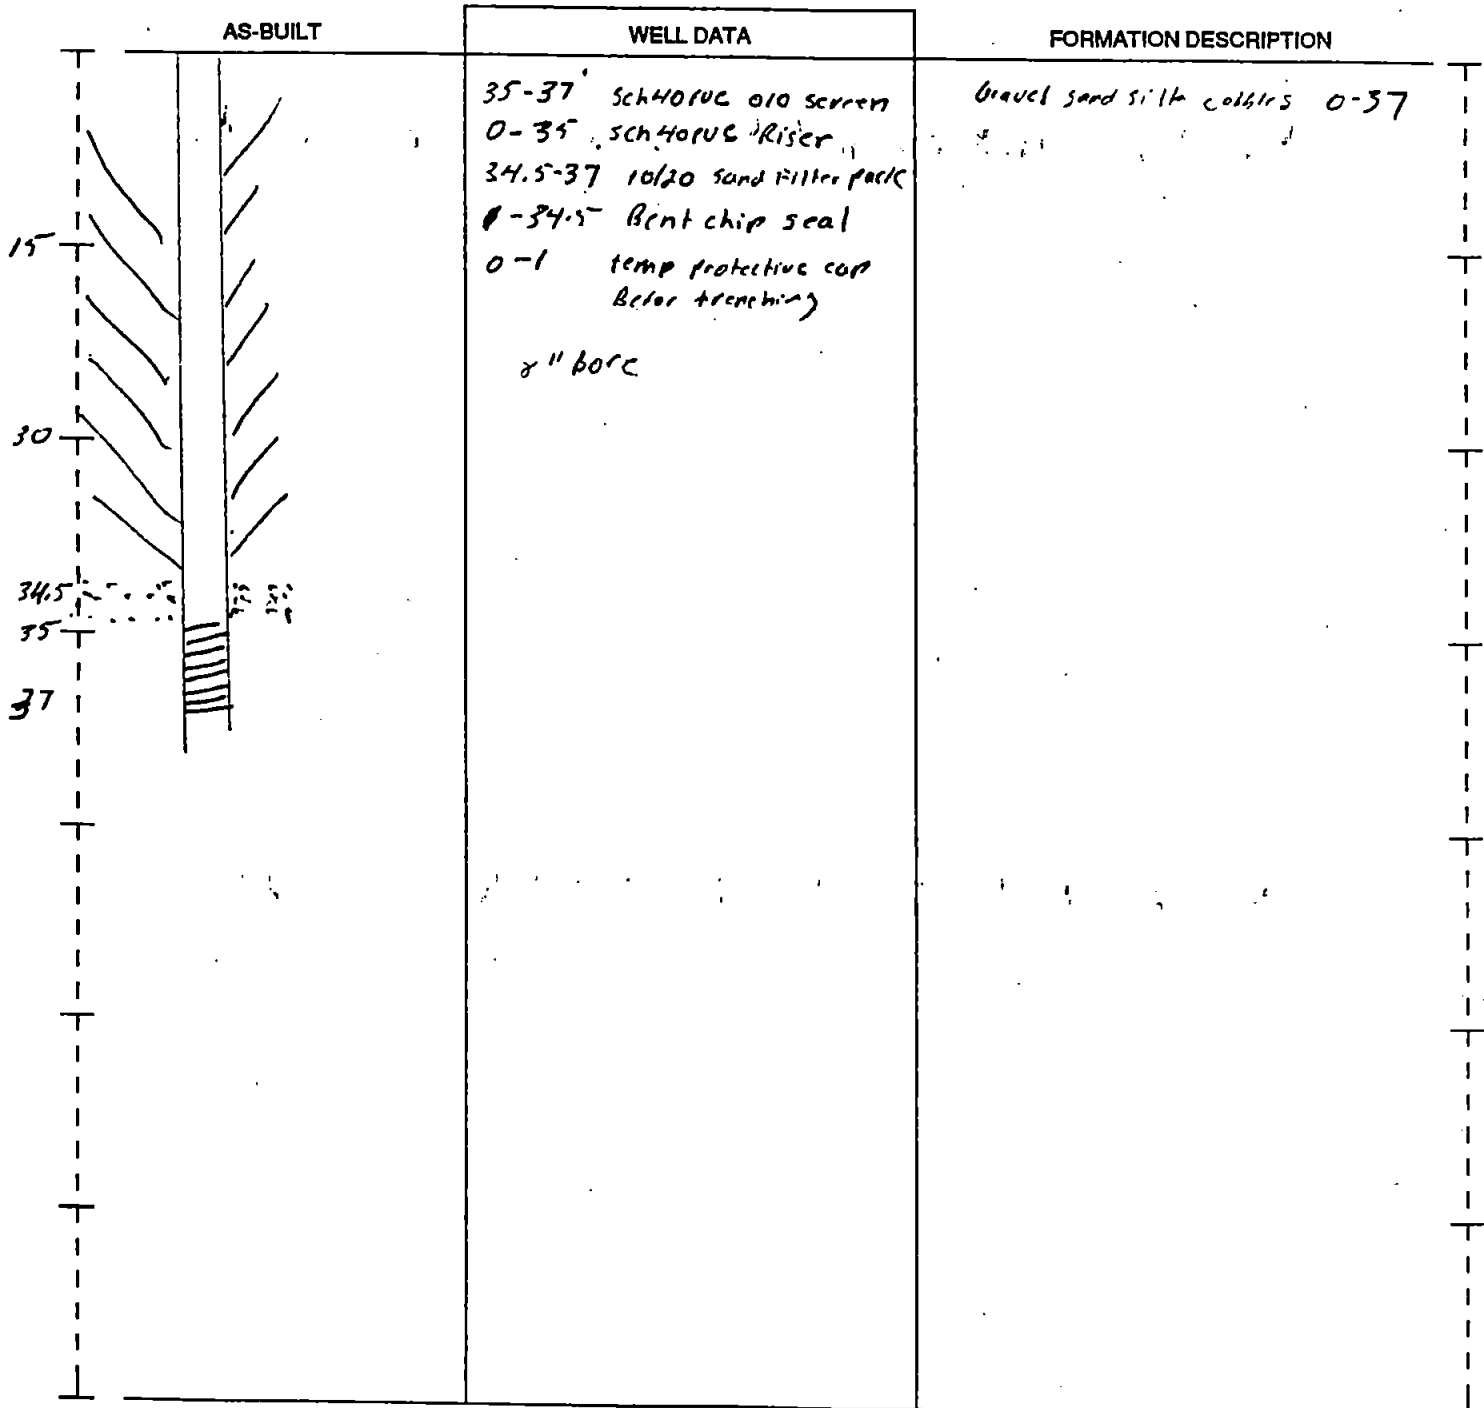

SCALE: 1" =

PAGE OF

RESOURCE PROTECTION WELL REPORT

START CARD NO. 27446


PROJECT NAME: B.P. Oil
 WELL IDENTIFICATION NO. Grange 6
 DRILLING METHOD: Hollow Stem
 DRILLER: W.H. Mc
 FIRM: Geotek Exploration S
 SIGNATURE: W.H. Mc
 CONSULTING FIRM: Histo
 REPRESENTATIVE: Bruce Lomcr

COUNTY: King
 LOCATION: 1/4 1/4 Sec Twn R
 STREET ADDRESS OF WELL: 2421 148th Ave
Bellevue
 WATER LEVEL ELEVATION: 26'
 GROUND SURFACE ELEVATION:
 INSTALLED: 22 July 96
 DEVELOPED:

AS-BUILT

WELL DATA

FORMATION DESCRIPTION

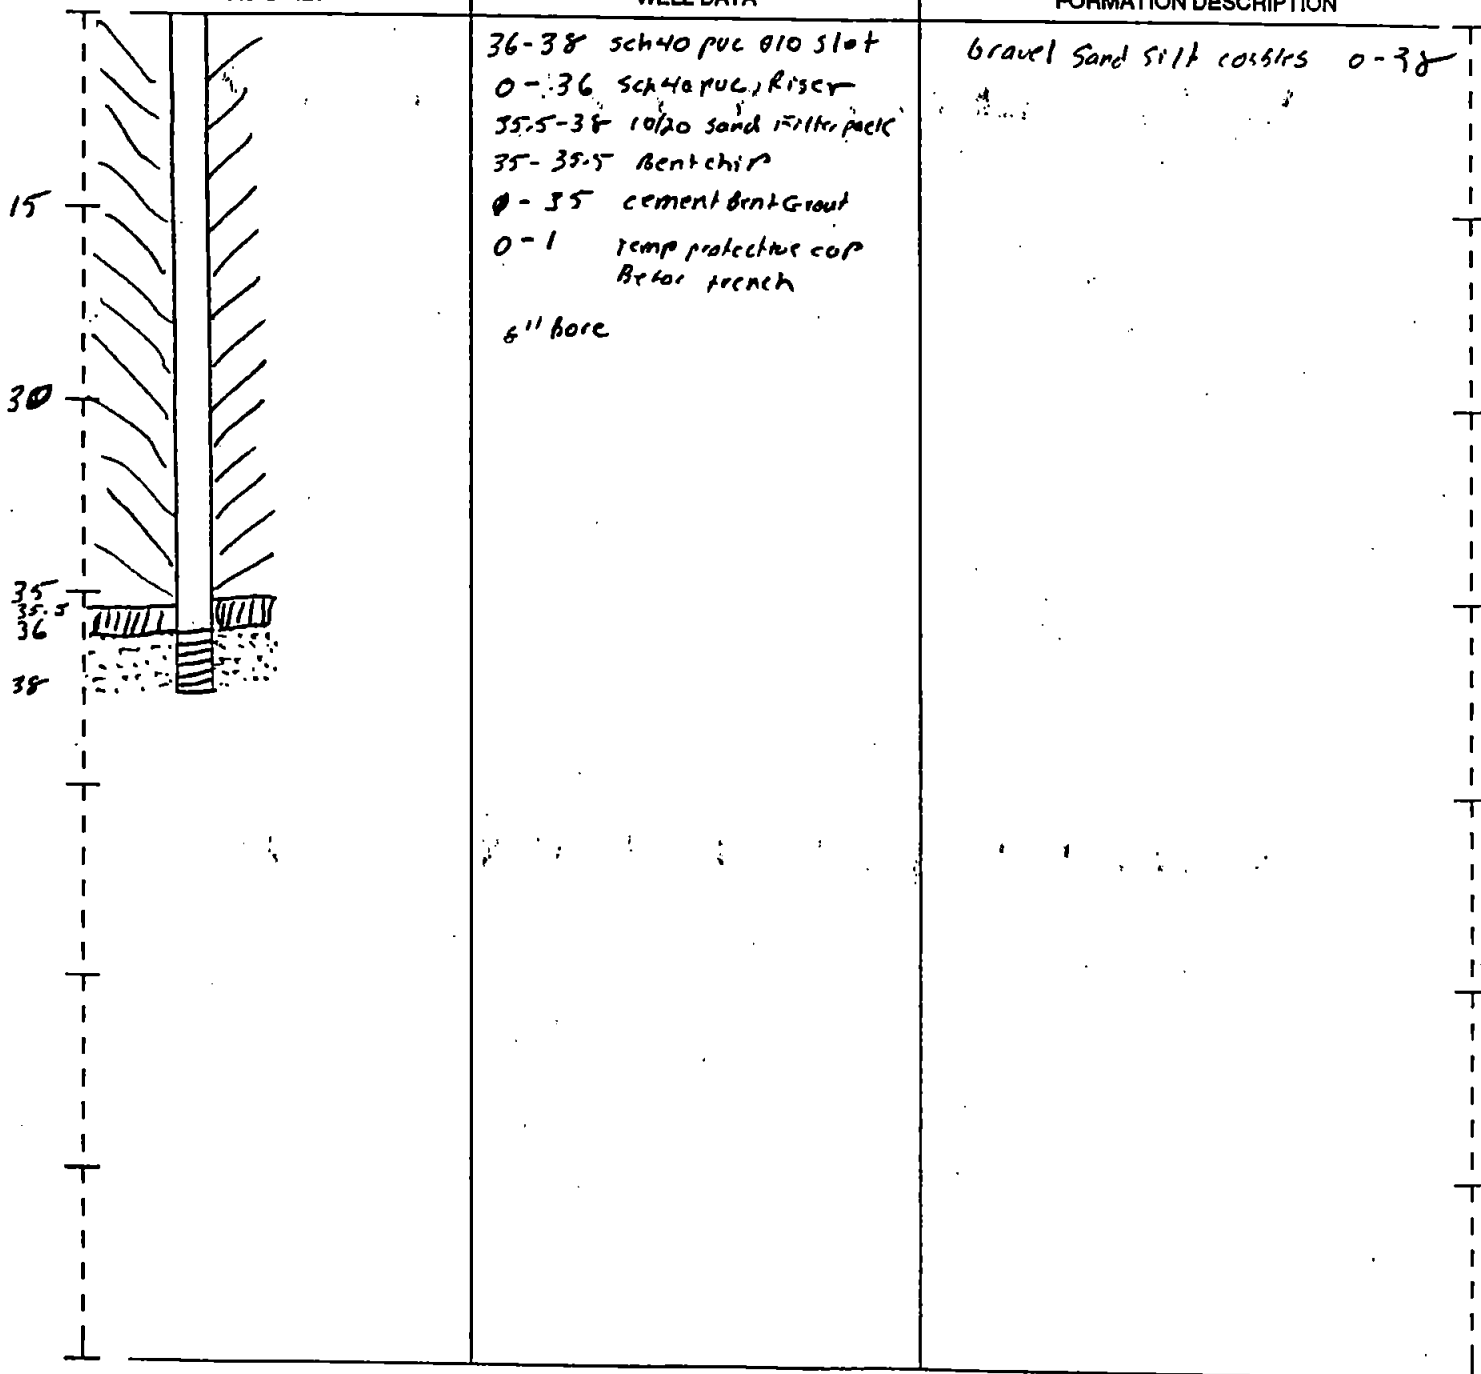

SCALE: 1" =

PAGE OF


RESOURCE PROTECTION WELL REPORT

PROJECT NAME: B.P. Oil
 WELL IDENTIFICATION NO. SPARGE 3, 4, 10
 DRILLING METHOD: 1/2 hollow stem
 DRILLER: Robert U. Rogers
 FIRM: Gratic Exploration
 SIGNATURE: [Signature]
 CONSULTING FIRM: Alisto
 REPRESENTATIVE: Bruce Lomer

START CARD NO. 27446

COUNTY: King
 LOCATION: 1/4 1/4 Sec 7 Tw 1 R7
 STREET ADDRESS OF WELL: 2421 148th Ave NE
Bellevue
 WATER LEVEL ELEVATION: 26'
 GROUND SURFACE ELEVATION: _____
 INSTALLED: 17, 18, 19 July
 DEVELOPED: _____

AS-BUILT

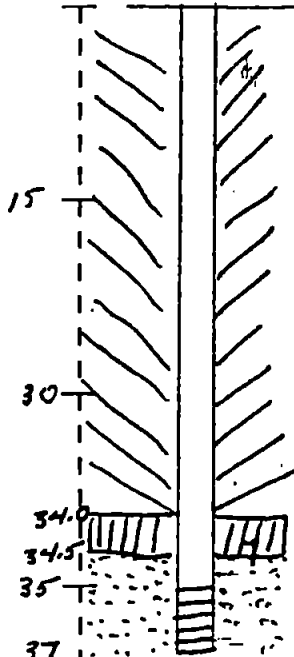

WELL DATA

35-37' sch 40 pvc 10/20 slot
 0-35' sch 40 pvc riser
 34.5-37' 10/20 Filter pack
 34-34.5' Bent chip
 1-34' cement Bent Grout
 0-1' remr protive cap before trenching
 6" bore

FORMATION DESCRIPTION

Gravel sand silt collrs 0-37

RESOURCE PROTECTION WELL REPORT

START CARD NO. 27446


PROJECT NAME: B.P. Oil
 WELL IDENTIFICATION NO. Spurge 1-2
 DRILLING METHOD: Hollowstem
 DRILLER: Robert D. Rogers
 FIRM: Cateck Explorations
 SIGNATURE: [Signature]
 CONSULTING FIRM: Alisto
 REPRESENTATIVE: Bruce Lomer

COUNTY: King
 LOCATION: 1/4 1/4 Sec Twn R
 STREET ADDRESS OF WELL: 2421 148th Ave NE
Brilliant
 WATER LEVEL ELEVATION: 26'
 GROUND SURFACE ELEVATION:
 INSTALLED: 15, 16 July 96
 DEVELOPED:

AS-BUILT

WELL DATA

FORMATION DESCRIPTION

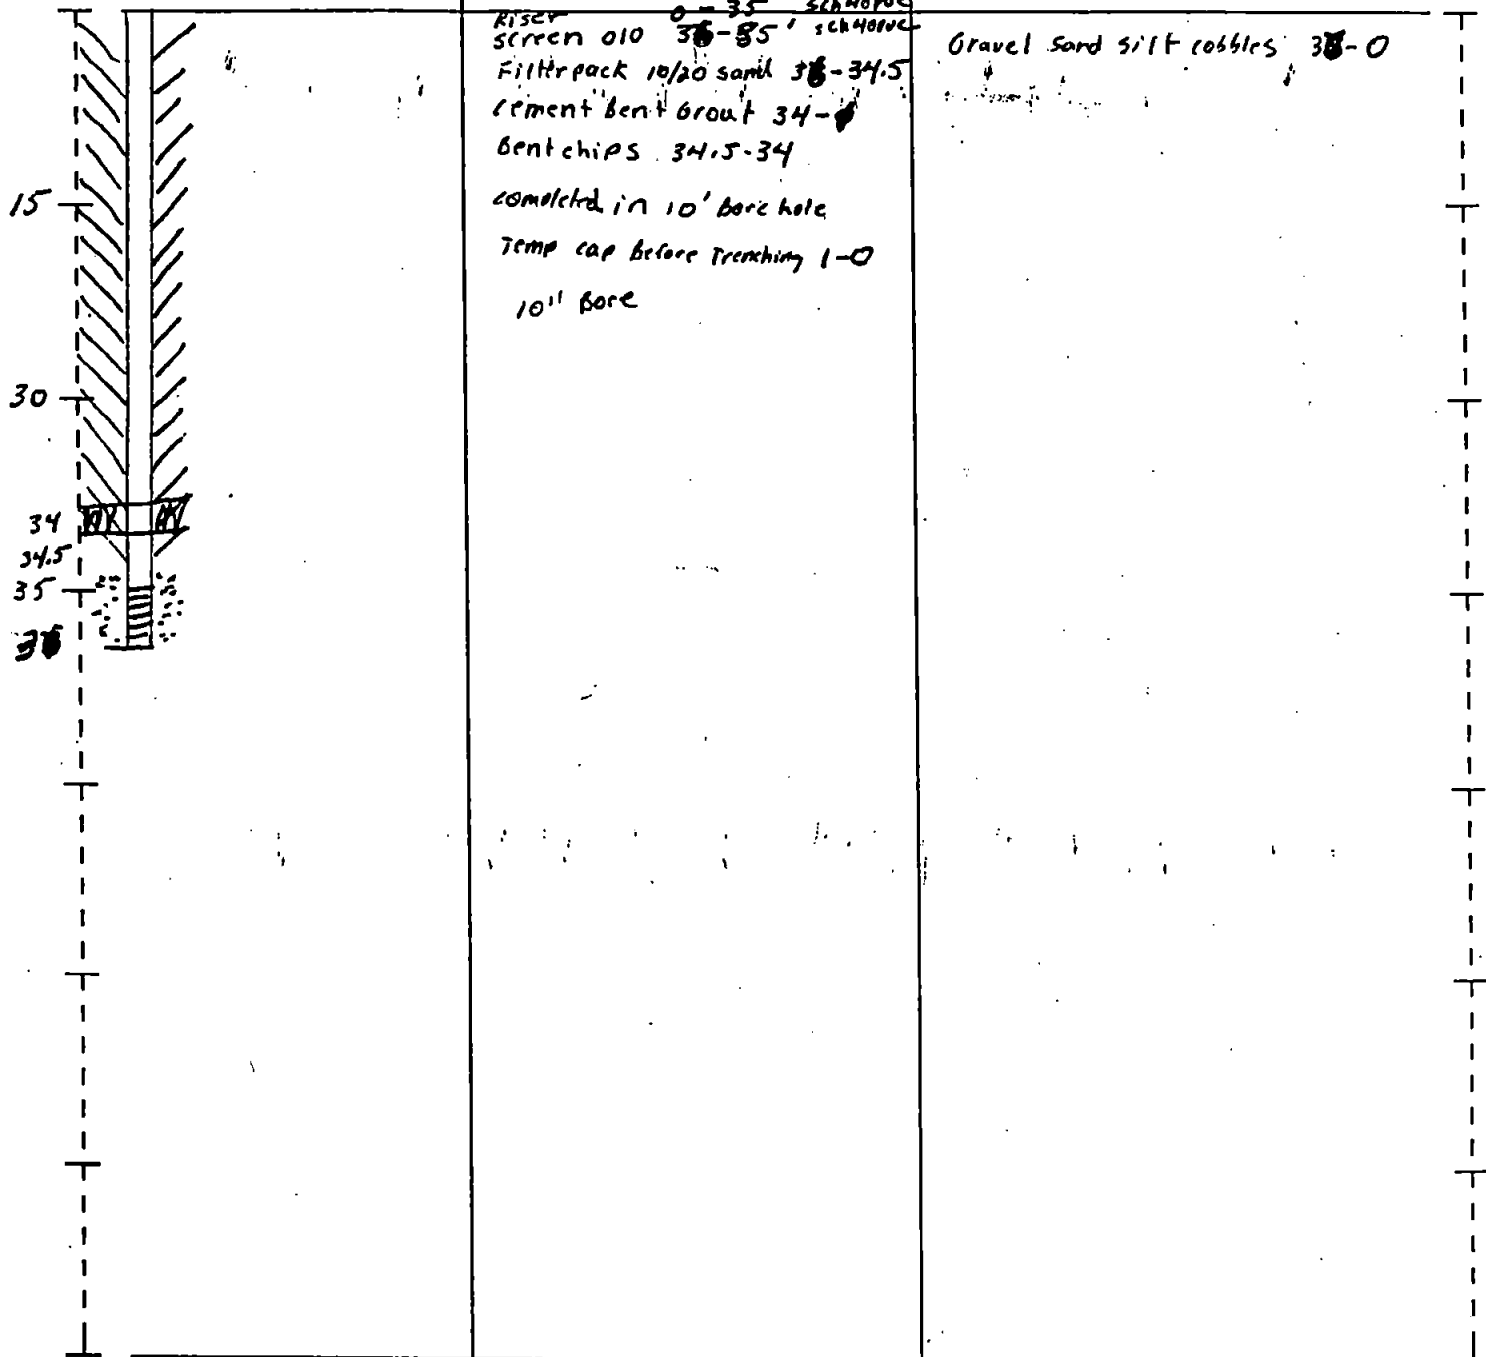

SCALE: 1" =

PAGE OF