


APPENDIX C
Berth 1 As-Built Drawings

DRAFT

NOTE:
 UNDERWATER CONTOURS FROM STATION
 B-19-00 TO B-23-00 FROM NO/A CHART,
 SEE NOTE 3, SHEET C101.

LAND CONTOURS FROM AERIAL TOPO BY
 AERO DATA CORP. ON JUNE 1, 1975

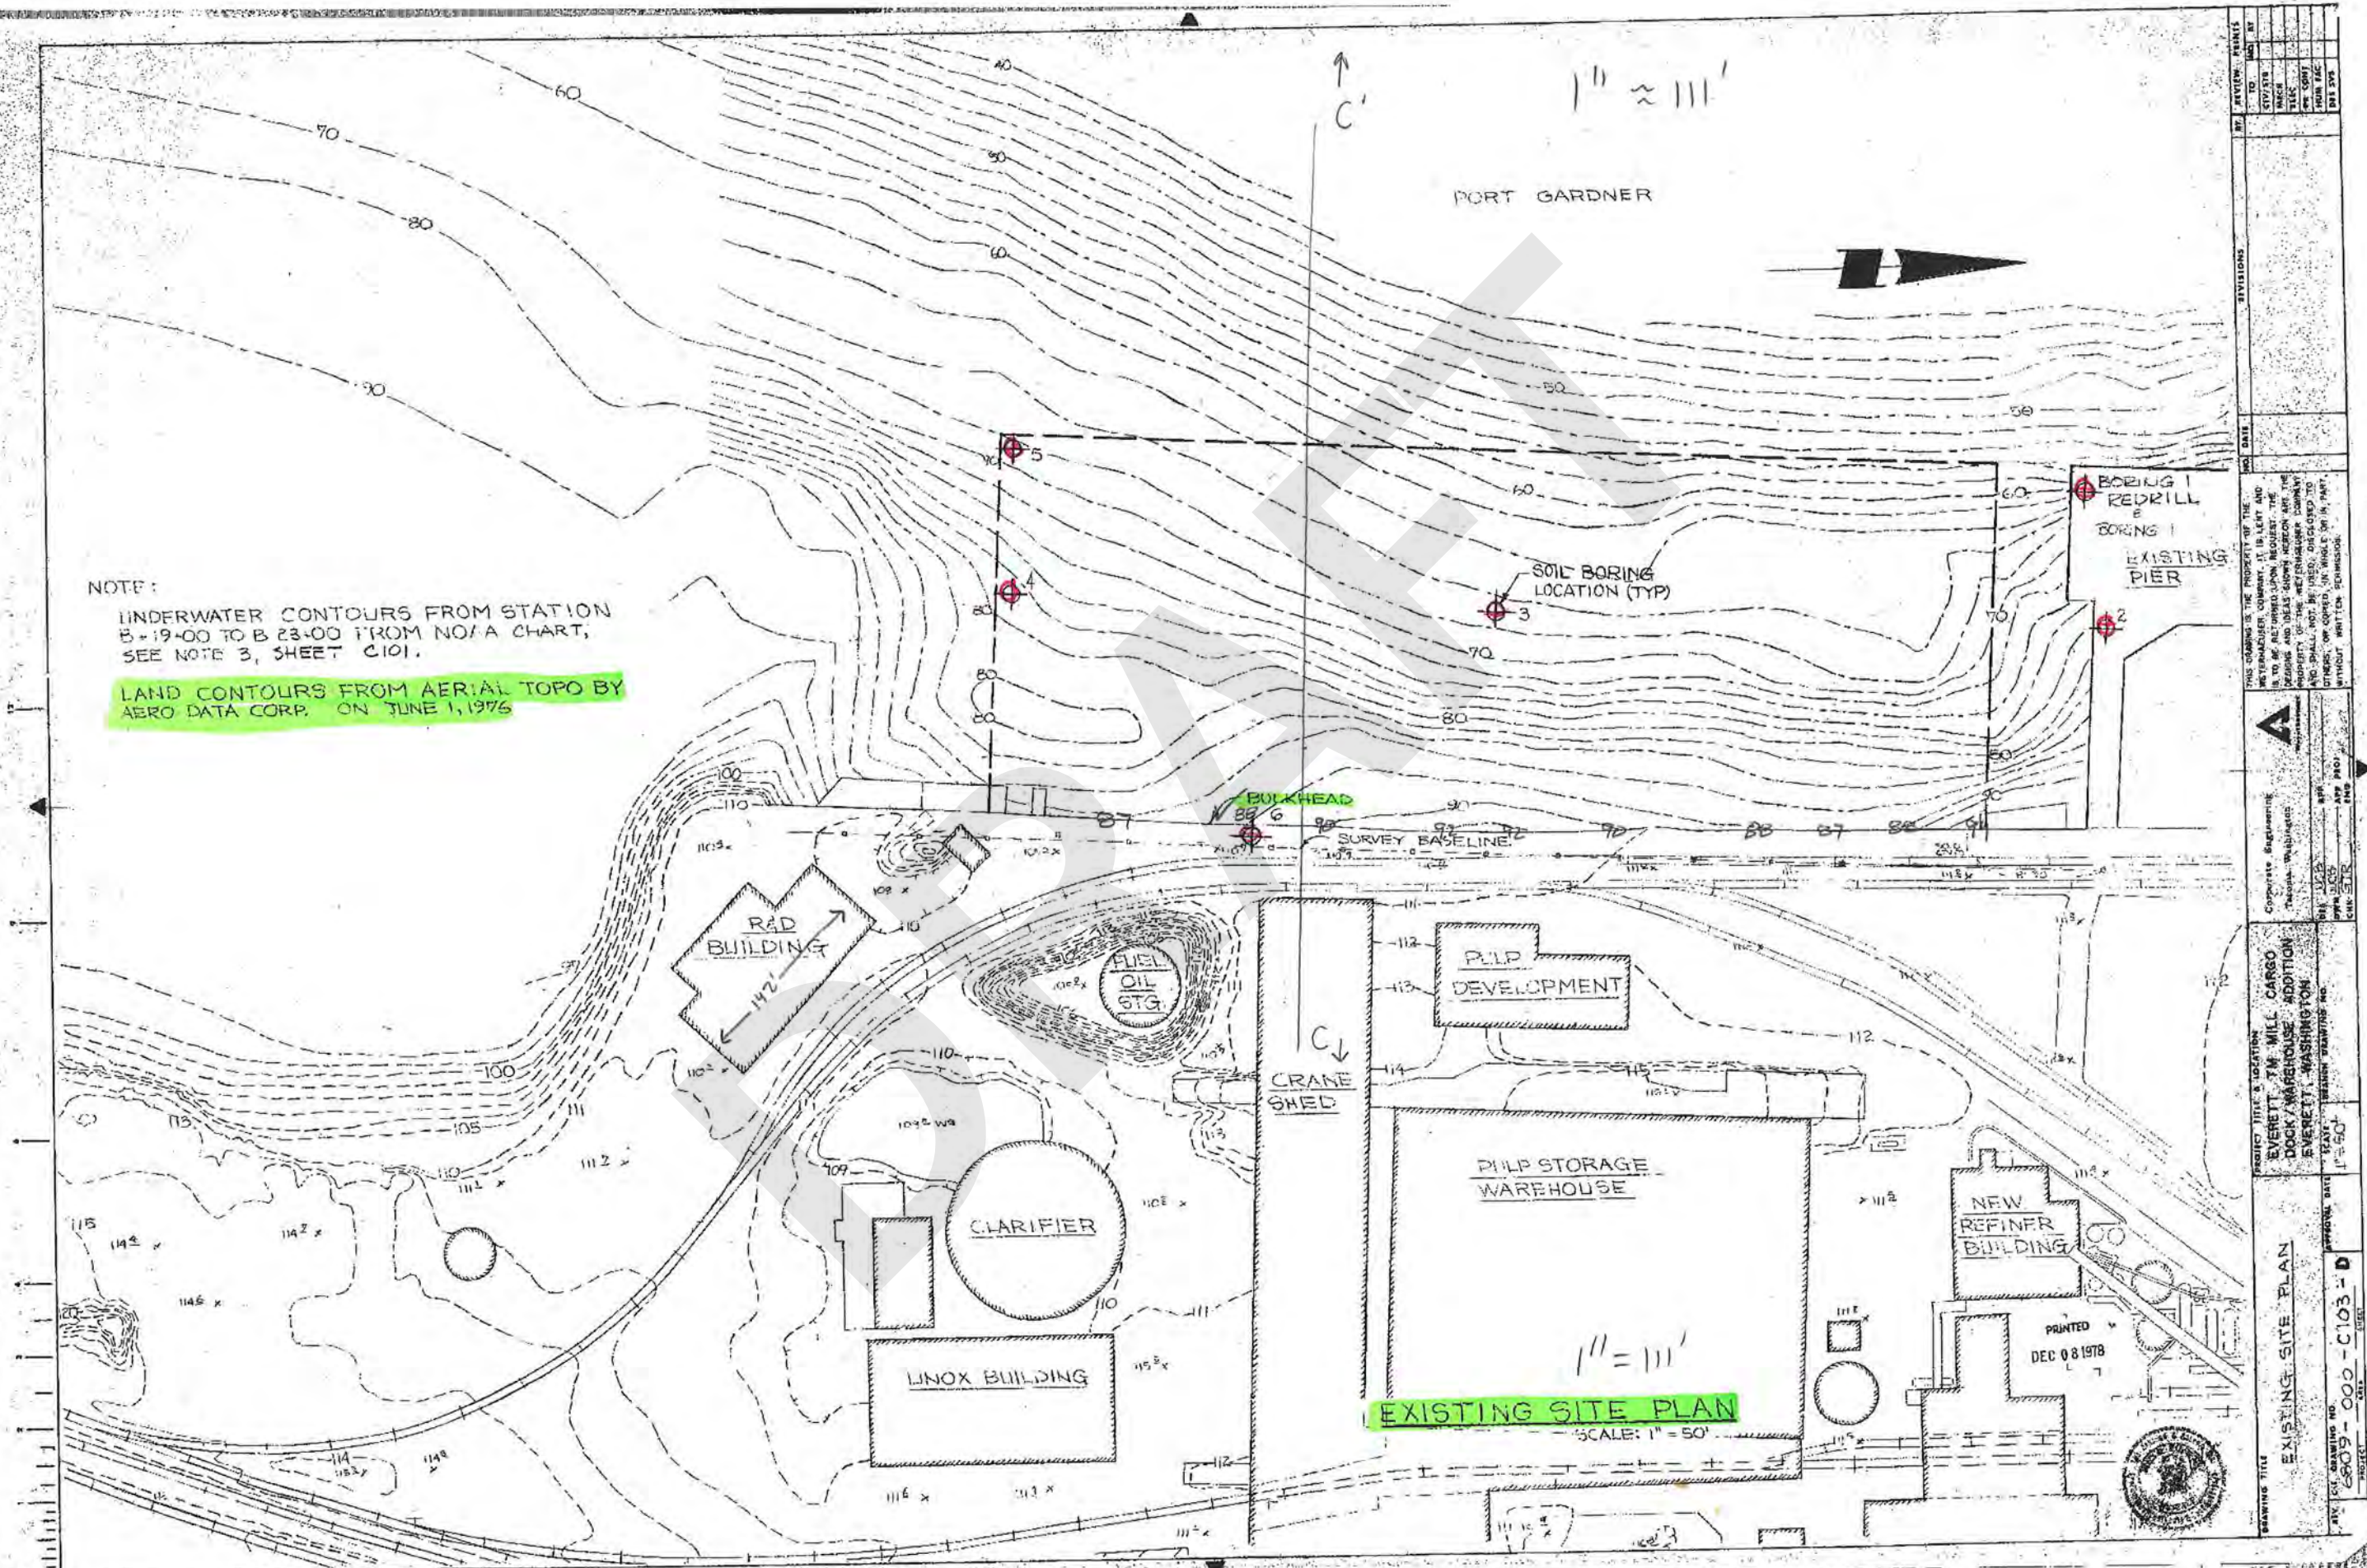


EXISTING SITE PLAN
 SCALE: 1" = 50'

PRINTED
 DEC 08 1978

PROJECT TITLE	EXISTING SITE PLAN
PROJECT NO.	809-00-C103-D
DATE	12-8-78
SCALE	1" = 50'
PROJECT LOCATION	EVERETT T.M. MILL CARGO DOCK/WAREHOUSE ADDITION EVERETT, WASHINGTON
DESIGNED BY	TEAT, WASHINGTON INC.
DRAWN BY	...
CHECKED BY	...
APPROVED BY	...
DATE	...
PROJECT NO.	...
DATE	...
SCALE	...
PROJECT LOCATION	...
DESIGNED BY	...
DRAWN BY	...
CHECKED BY	...
APPROVED BY	...
DATE	...


Top and outboard top of berm

PORT GARDNER

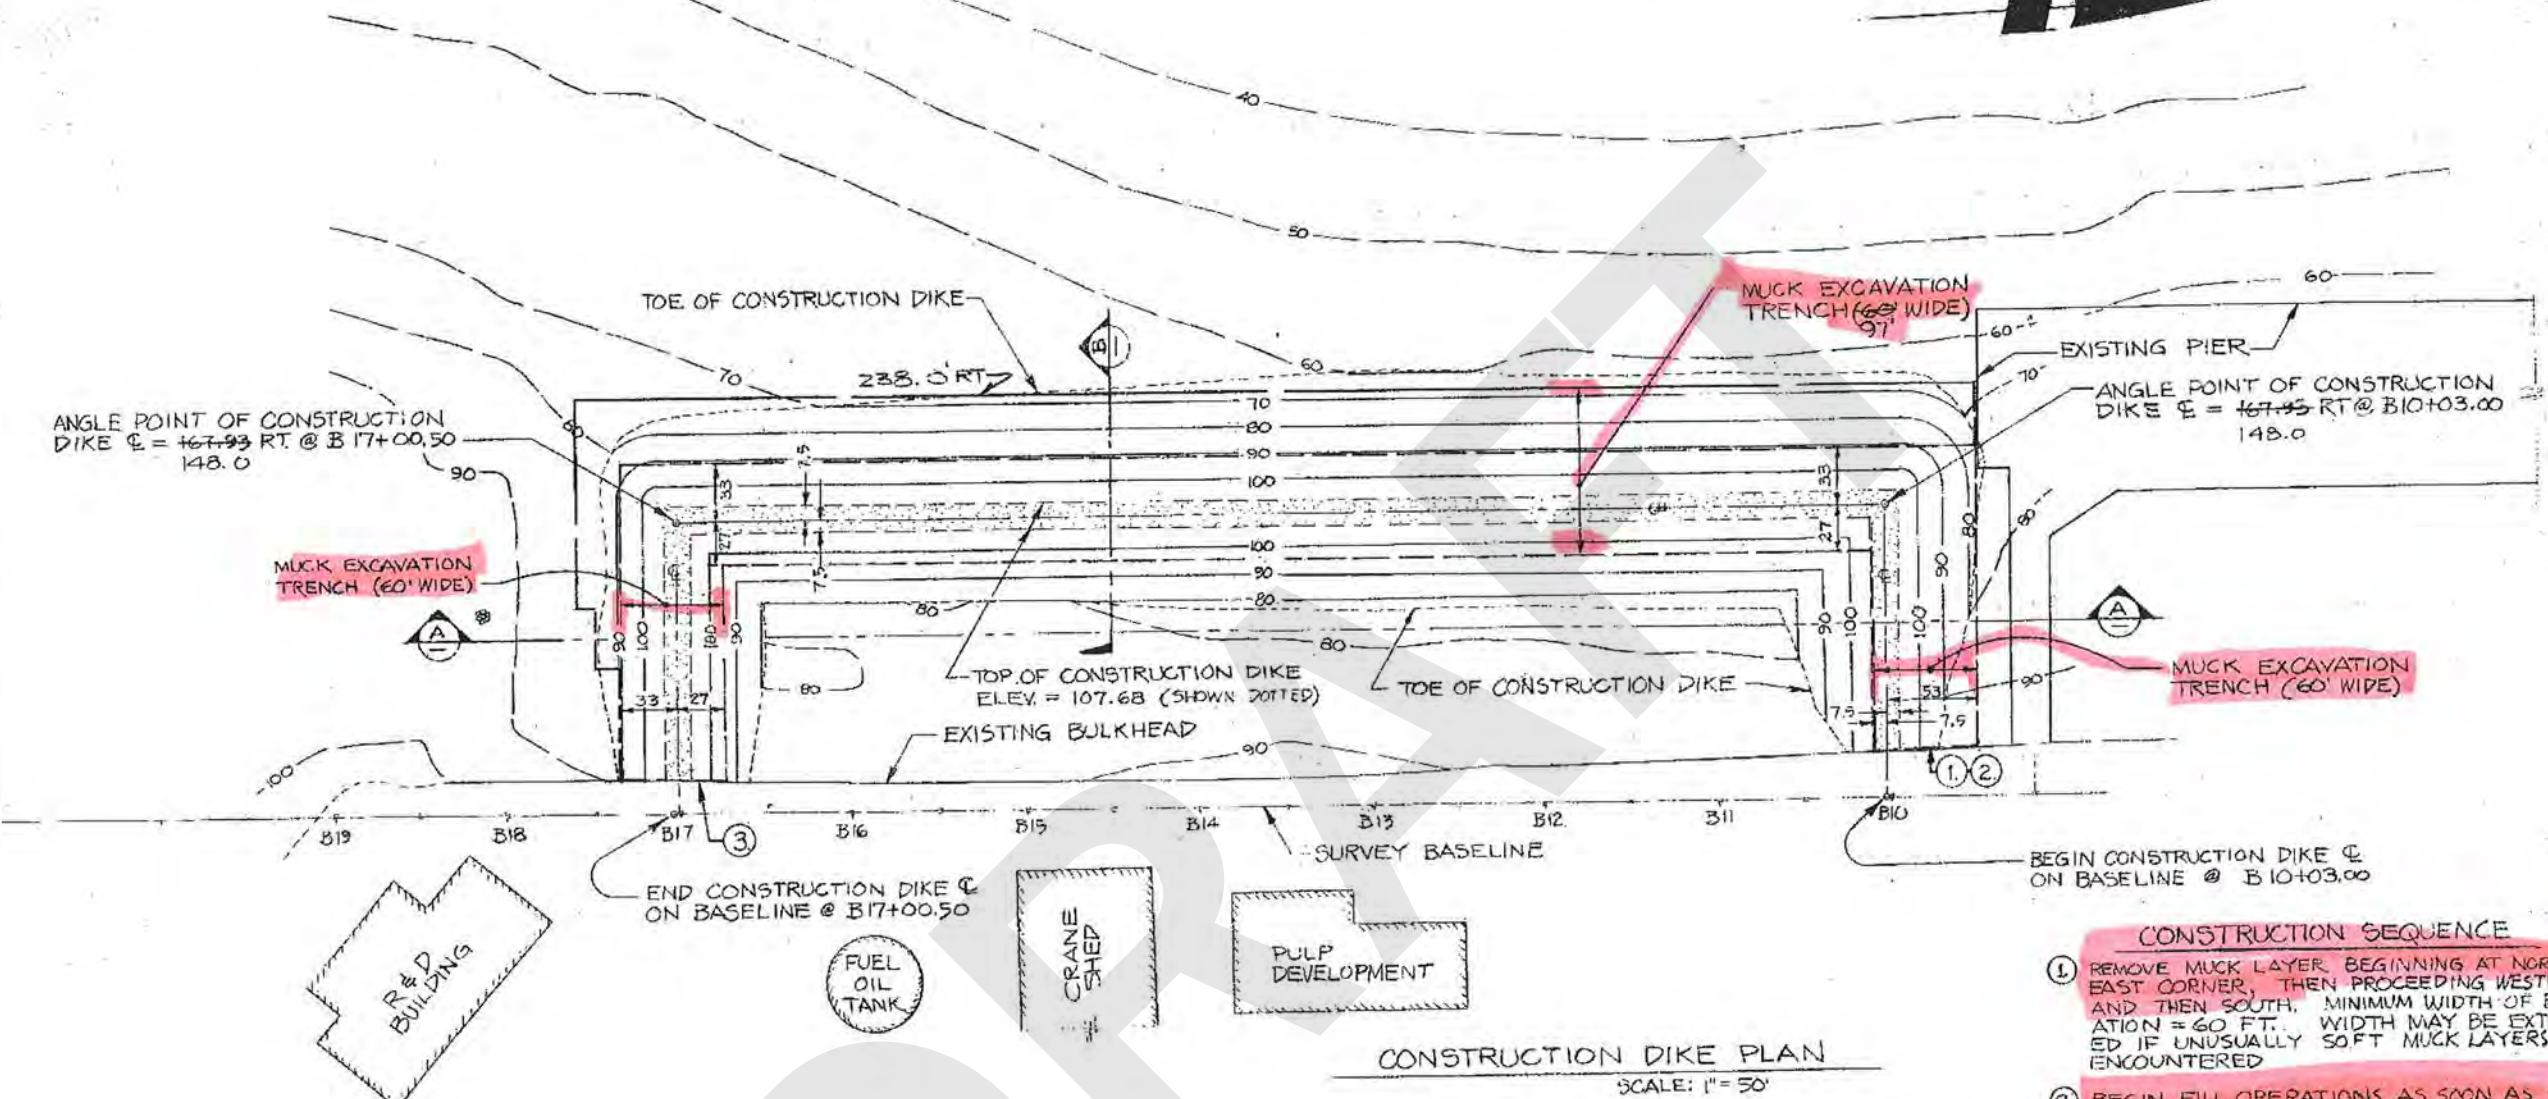


CONSTRUCTION DIKE PLAN
SCALE: 1" = 50'

- CONSTRUCTION SEQUENCE**
- 1 REMOVE MUCK LAYER, BEGINNING AT NORTH-EAST CORNER, THEN PROCEEDING WESTWARD AND THEN SOUTH. MINIMUM WIDTH OF EXCAVATION = 60 FT. WIDTH MAY BE EXTENDED IF UNUSUALLY SOFT MUCK LAYERS ARE ENCOUNTERED.
 - 2 BEGIN FILL OPERATIONS AS SOON AS POSSIBLE AFTER MUCK LAYER HAS BEEN REMOVED. (NOTE: MUCK MAY FLOW BACK INTO THE EXCAVATED TRENCH). CONTRACTOR TO SCHEDULE MUCK EXCAVATION AND FILL OPERATIONS TO AVOID PLACING FILL ON TOP OF MUCK IN MUCK REMOVAL AREA. FILL TO BE PLACED IN CENTER OF TRENCH INITIALLY AND EXPANDED LATERALLY AND OUTWARD TO AVOID RETAINING ANY MUCK IN TRENCH AREA. PRIOR TO FILL PLACEMENT, BOTTOM OF TRENCH TO BE INSPECTED AND APPROVED BY THE ENGINEER. SEE SHEET C-107 FOR GRADATION LIMITS FOR FILL.
 - 3 FILL OPERATIONS MAY BE CARRIED ON SIMULTANEOUSLY AT SOUTH END AT CONTRACTOR'S OPTION.
 - 4 CONSTRUCT WEIR DISCHARGE SYSTEM FOR DREDGING OPERATIONS.
 - 5 FOR ADDITIONAL INFORMATION CONCERNING FILL PLACEMENT, MUCK REMOVAL AND INSPECTION, SEE SPECIFICATIONS. ALSO, SEE SHEET C-107 FOR OF DIKE MATERIAL.

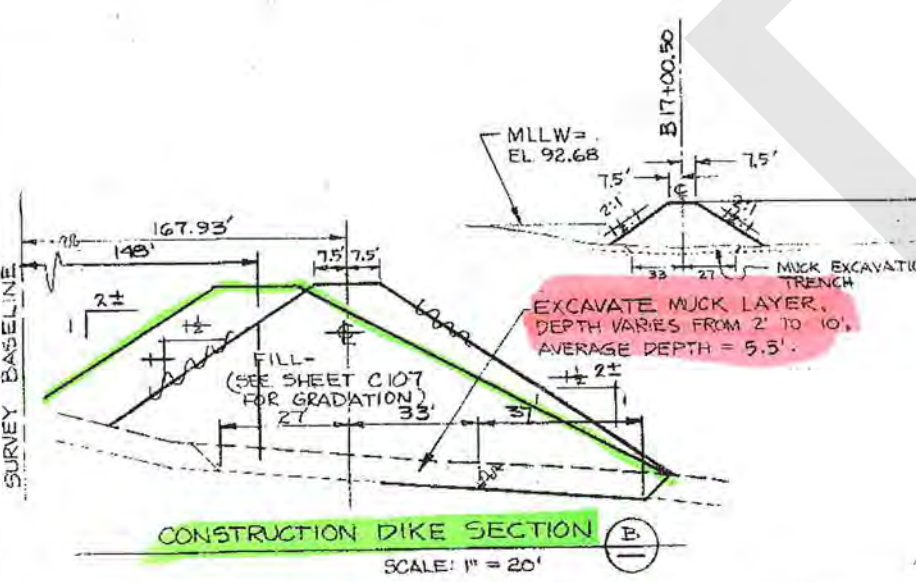

CONSTRUCTION DIKE SECTION B
SCALE: 1" = 20'

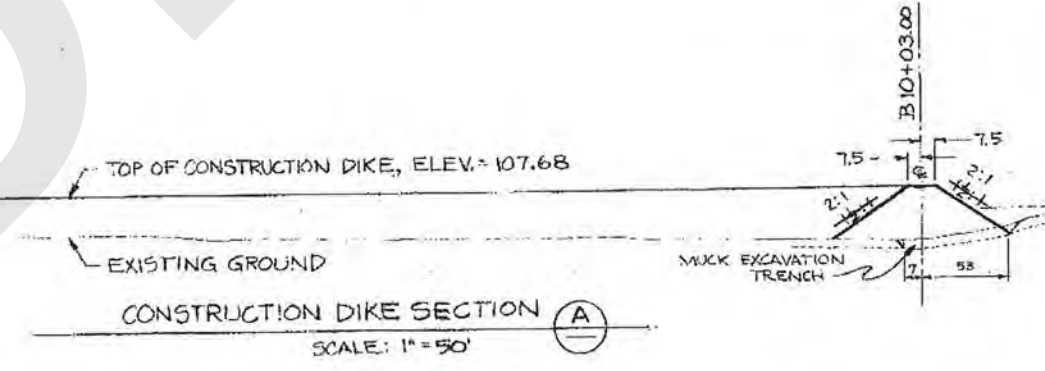


CONSTRUCTION DIKE SECTION A
SCALE: 1" = 50'

CONSTRUCTION DIKE

NO.	DATE	REVISIONS	BY	CHKD BY	APP'D BY
1					
2					
3					
4					
5					
6					
7					
8					
9					
10					

PROJECT TITLE & LOCATION	PROJECT NO.	SCALE	APPROVAL DATE
POE MILL A-061741	1100	1" = 50'	
PROJECT TITLE	PROJECT NO.	SCALE	APPROVAL DATE
CONSTRUCTION DIKE	1100	1" = 50'	
DESIGNED BY	PROJECT NO.	SCALE	APPROVAL DATE
EVERETT T.M. MILL CARGO DOCK WAREHOUSE ADDITION	1100	1" = 50'	
EVERETT WASHINGTON	1100	1" = 50'	
DATE	PROJECT NO.	SCALE	APPROVAL DATE
DEC 08 1978	1100	1" = 50'	

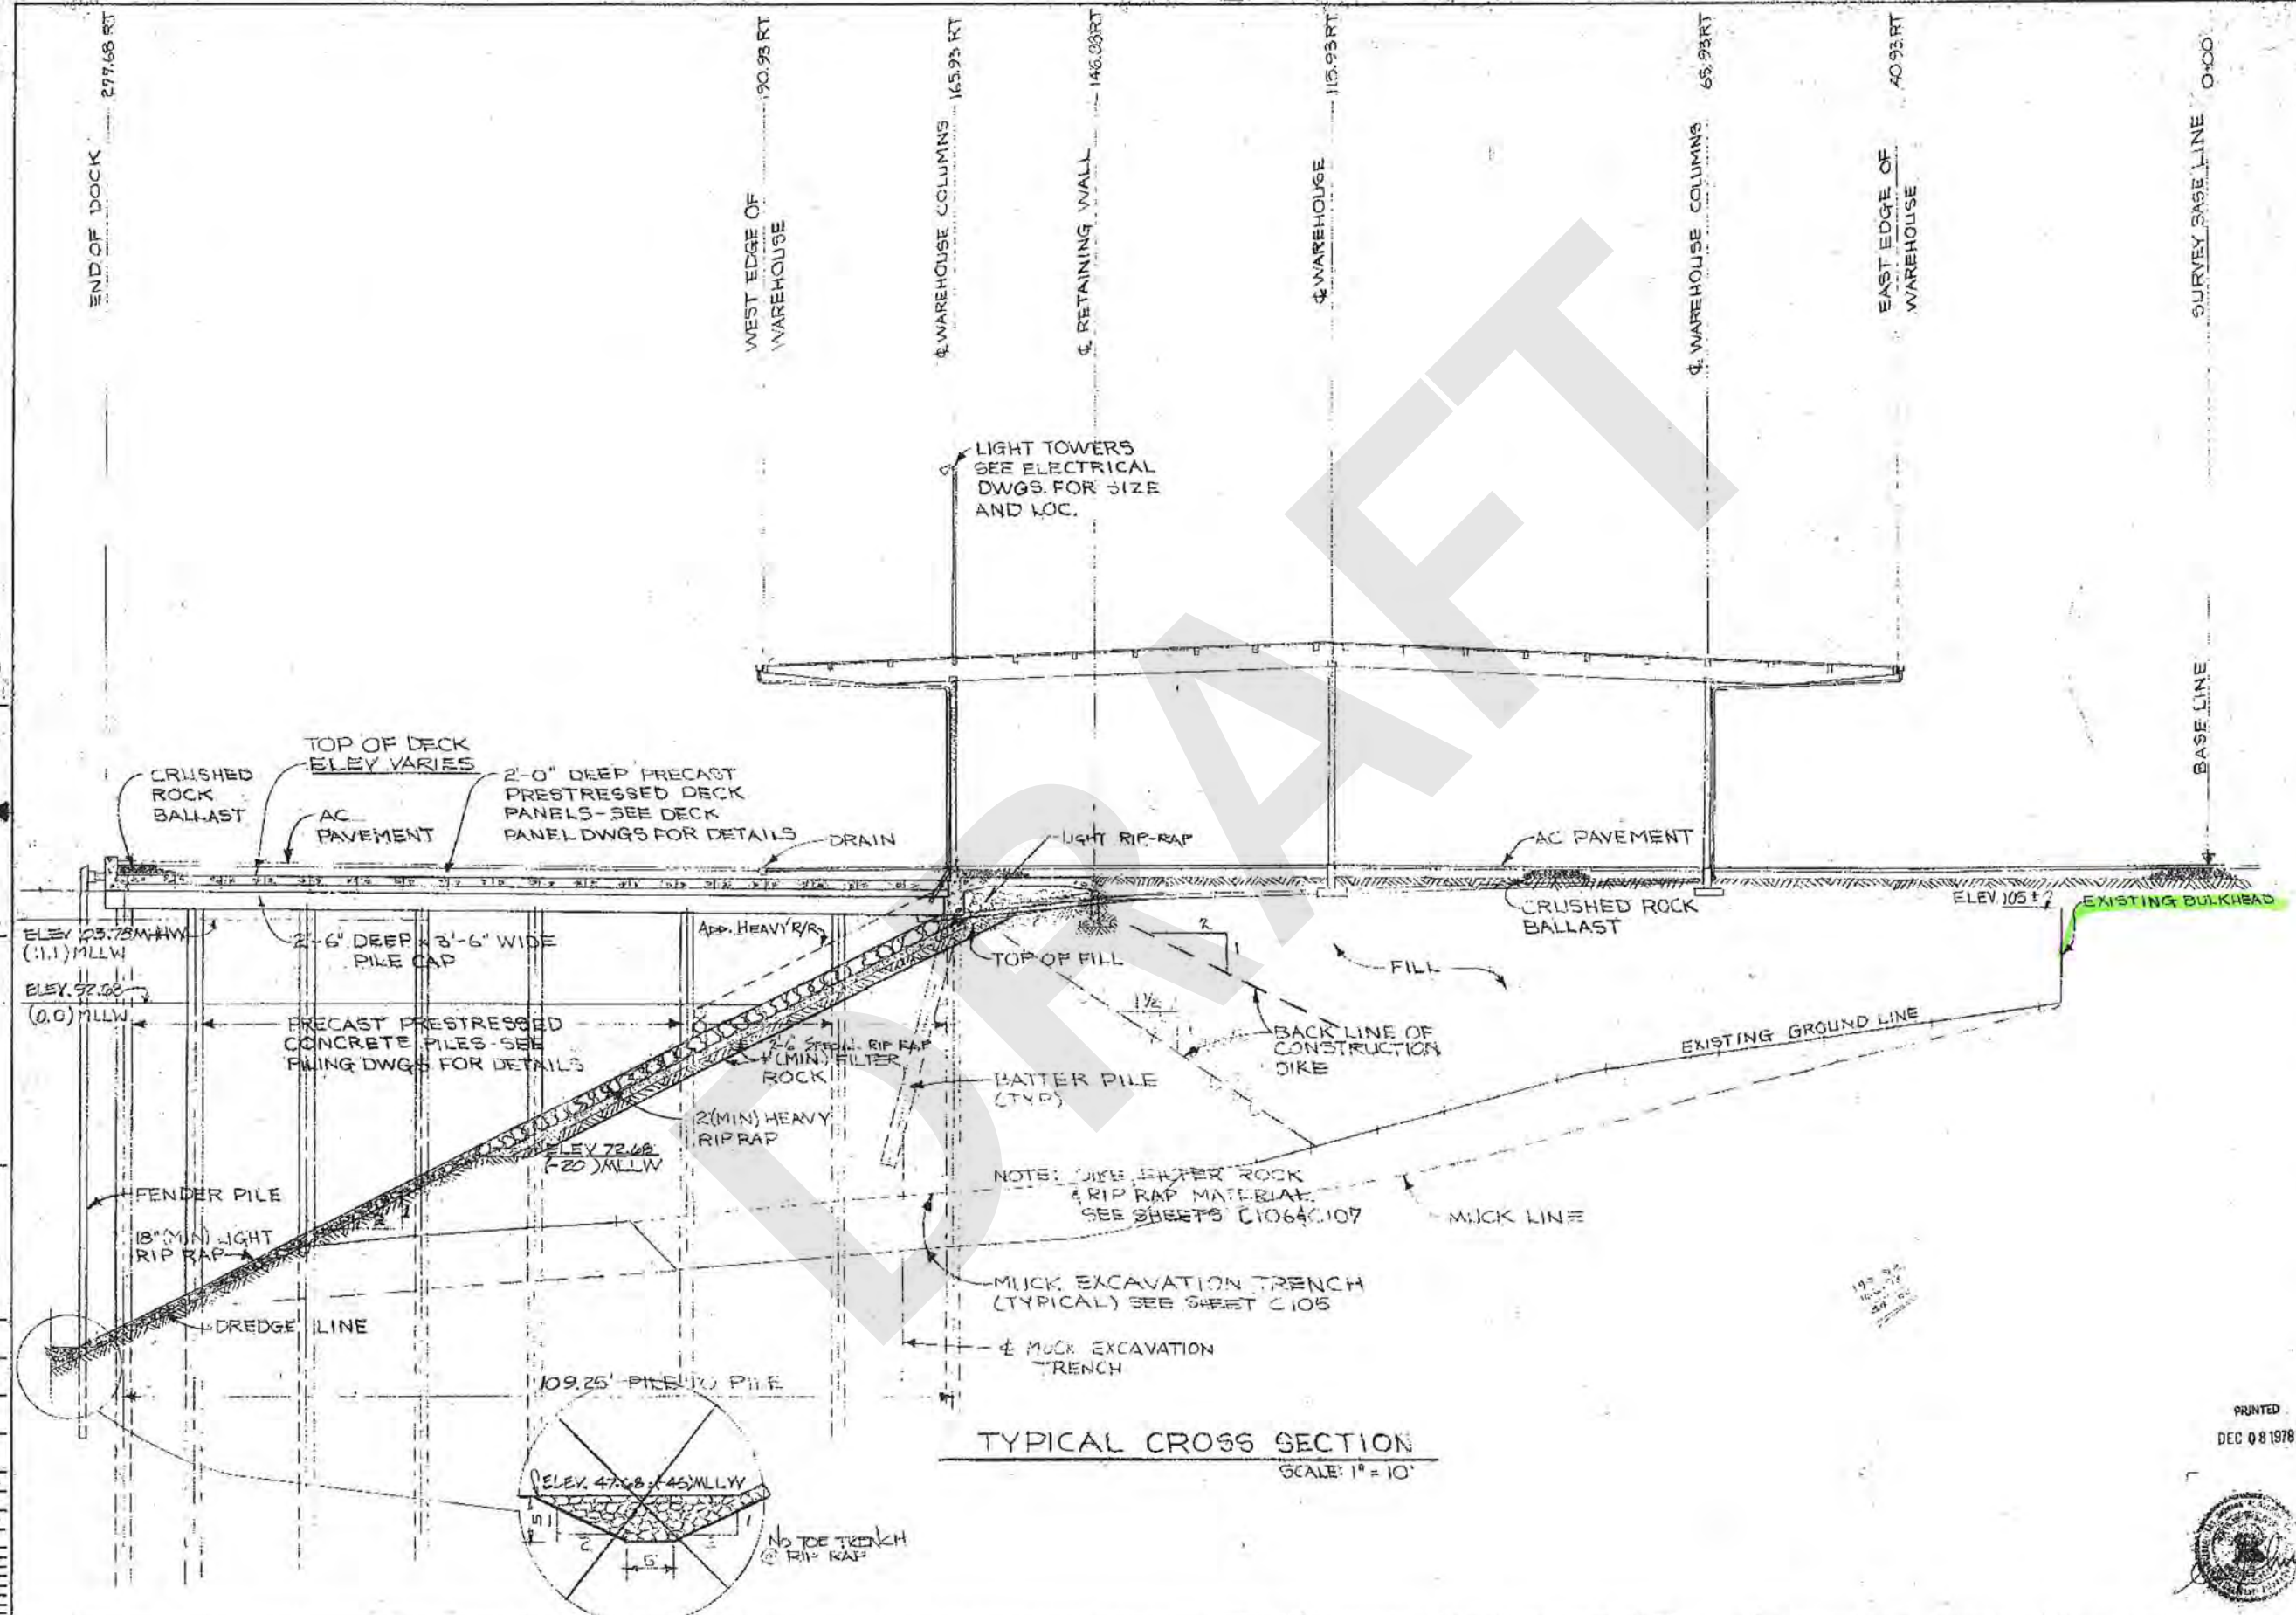

TYPICAL CROSS SECTION
SCALE: 1" = 10'

PRINTED
DEC 08 1978



DRAWING TITLE TYPICAL CROSS SECTION	PROJECT TITLE & LOCATION EVERETT T-1 MILL, CARDO DOCK / WAREHOUSE ADDITION EVERETT, WASHINGTON	SCALE 1" = 10'	DATE 12/10	DESIGNED BY WCB	CHECKED BY WCB	DATE 12/10/78	REVISIONS	NO. DATE	BY
							NO.	DATE	BY
THIS DRAWING IS THE PROPERTY OF THE WASHINGTON STATE DEPARTMENT OF TRANSPORTATION. IT IS LOANED TO YOU FOR YOUR INFORMATION AND IS TO BE RETURNED UPON REQUEST. THE CONTENTS AND IDEAS SHOWN HEREON ARE THE PROPERTY OF THE WASHINGTON STATE DEPARTMENT OF TRANSPORTATION AND SHALL NOT BE USED, DISCLOSED TO OTHERS, OR COPIED, IN WHOLE OR IN PART, WITHOUT WRITTEN PERMISSION.							DATE	BY	
CORPORATION ENGINEERING THOMAS, WASHINGTON 1000 10TH AVENUE, SE TACOMA, WA 98402 PHONE (206) 835-1111 FAX (206) 835-1112							NO.	DATE	BY