

WEEKLY SUMMARY REPORT

PHOTOGRAPHS



Comment: Removing decking and crane mats from transload



Comment: Placing 3" minus backfill in SMA-2 with rock box



Comment: Placing 3" minus backfill in SMA-2 with rock box



Comment: Pulling temporary piles at transload facility



PROJECT NO.: 130388-01.02

REPORT PERIOD: December 19 to December 23, 2016

REPORT NO.: 045

PREPARED BY: Jason Cornetta

PROJECT NAME/LOCATION: Port Gamble Bay Cleanup

WEEKLY SUMMARY REPORT

Report Submitted to:		Contractor Name and Contact:	
To:	Arthur Kapell, Celina Abercrombie, WA Dept. of Ecology	General:	Orion Marine Contractors Inc. (OMCI)
cc:	Linda Berry-Maraist, PR/OPG John Laplante, PE, Clay Patmont, Ross Pickering, PE, Jason Cornetta, Anchor QEA, LLC	Subcontractors:	Zimmer Sand Pit New Shine Quarry Pyramid Materials MJ Trucking Harbor Offshore

1. Structure Demolition and Pile Extraction

- No Activity

2. Creosote Processing and off Site Disposal

- Piling extracted during dredging were processed in the creosote processing area for off-site disposal

3. Former Landfill Shoreline Debris Removal

- No Activity

4. Intertidal Excavation and Capping

- No Activity

5. Stockpile Management

- No Activity

6. Subtidal Capping, EMNR , and RMC Placement

- Subtidal capping (armor and habitat substrate layer placement) in SMA-1 with 1201 spud barge and 9260 American Crane using 4 CY re-handle bucket.
- Placement of EMNR material in SMA-1 with the 1201 spud barge and 9260 American Crane using 4 CY re-handle bucket.
- Placement of the SMA-2 4-foot subtidal contingency cap with the 1201 spud barge and 9260 American Crane.
- Placement of the SMA-2 perimeter tie-in cap (between revised dredge prism and original SMA-2 subtidal cap limits) with the 1201 spud barge and 9260 American Crane.
- Placement of 3" minus backfill and habitat substrate in SMA-2, 2:1 slope areas, with the 1901 spud barge and 9299 American Crane using 10 CY rock box. Areas above -10 MLLW are receiving 12" of habitat substrate and areas below -10 MLLW are receiving 6" of habitat substrate.

7. Subtidal Dredging

- No Activity – Subtidal dredging is complete.



PROJECT NO.: 130388-01.02

REPORT PERIOD: December 19 to December 23, 2016

REPORT NO.: 045

PREPARED BY: Jason Cornetta

PROJECT NAME/LOCATION: Port Gamble Bay Cleanup

WEEKLY SUMMARY REPORT

8. Environmental Controls

- Water quality monitoring: Water quality monitoring was performed in accordance with the Ecology-approved Water Quality Monitoring Plan (Appendix E 401 Water Quality Memorandum) and the Water Quality Monitoring Plan (Attachment 2 of Appendix E to the BODR). Water quality monitoring was performed for:
 - Limited monitoring was conducted for capping in SMA-2 on 12/23/16.
 - No confirmed turbidity exceedances were measured during monitoring activities.
- The final round of mussel cage retrieval is scheduled for the week of 1/9/17.
- The final round of archeological monitoring is scheduled for the week of 1/9/17, for the remaining intertidal excavation in SMA-1.

9. Problems Encountered and Corrective Actions

- None.

10. Health and Safety Observations

- Daily health and safety tool box talks performed.
- No health and safety incidents.

11. Other on Site Activities

- Subtidal and Intertidal Capping, EMNR, RMC, and backfill materials were imported and stockpiled on Site.

12. Anticipated Work for Next Week

- Continue capping and backfill material importing and stockpiling.
- Continue placing 3" minus backfill in 2h:1v slope areas in SMA-2
- Continue removal of transload facility
- Continue placing habitat substrate on completed 3" minus backfill areas
- Begin low-tide nighttime capping in the Pier 4 cap area.
- Begin armor placement in the erosion areas.

13. Changes and Modifications

- No Changes or Modifications required

14. Quantities (See Attached Tracking Tables)

15. Photos



PROJECT NO.: 130388-01.02

REPORT PERIOD: December 19 to December 23, 2016

REPORT NO.: 045

PREPARED BY: Jason Cornetta

PROJECT NAME/LOCATION: Port Gamble Bay Cleanup

WEEKLY SUMMARY REPORT

PHOTOGRAPHS



Comment: Partially demolished transload facility



Comment: Placing 3" minus backfill in SMA-2



Comment: Barge loading



Comment: Placing 3" minus backfill in SMA-2

WEEKLY SUMMARY REPORT

PHOTOGRAPHS



Comment: Placing EMNR material in SMA-1



Comment: Placing 3" minus backfill in SMA-2 with rock box



Comment: Placing 3" minus backfill in SMA-2 with rock box



Comment: SMA-1 intertidal cap slope



PROJECT NO.: 130388-01.02

REPORT PERIOD: December 26 to December 30, 2016

REPORT NO.: 046

PREPARED BY: Jason Cornetta

PROJECT NAME/LOCATION: Port Gamble Bay Cleanup

WEEKLY SUMMARY REPORT

Report Submitted to:		Contractor Name and Contact:	
To:	Arthur Kapell, Celina Abercrombie, WA Dept. of Ecology	General:	Orion Marine Contractors Inc. (OMCI)
cc:	Linda Berry-Maraist, PR/OPG John Laplante, PE, Clay Patmont, Ross Pickering, PE, Jason Cornetta, Anchor QEA, LLC	Subcontractors:	Zimmer Sand Pit New Shine Quarry Pyramid Materials MJ Trucking Harbor Offshore

1. Structure Demolition and Pile Extraction

- Demolition and removal of conex boxes at the transload area bulkhead and restoring area to pre-construction conditions

2. Creosote Processing and off Site Disposal

- Extracted piling were processed in the creosote processing area for off-site disposal

3. Former Landfill Shoreline Debris Removal

- No Activity

4. Intertidal Excavation and Capping

- Pier 4 area capping with high fines 3" minus material and type 2 armor

5. Stockpile Management

- No Activity

6. Subtidal Capping, EMNR, RMC Placement, and 2:1 slope backfill in SMA-2

- Placement of 3" minus backfill and habitat substrate in SMA-2 (2:1 slope areas) with the 1901 spud barge and 9299 American Crane, and the 1201 spud barge and 9260 American Crane. Areas above -10 MLLW are receiving 12" of habitat substrate and areas below -10 MLLW are receiving 6" of habitat substrate.
- Placement of high fines content 3" minus backfill at the Pier 4 cap area (from -10 to +5 MLLW), with the 1901 spud barge and 9299 American Crane, and land-based equipment.
- Placement of type 2 armor in the SMA-2 intertidal cap area to touch-up and tie-in the toe of slope and the 3" minus backfill.
- Placement of type 2 armor in the Pier 4 capping and backfill area.

7. Subtidal Dredging

- No Activity – Subtidal dredging is complete.

8. Environmental Controls



WEEKLY SUMMARY REPORT

PROJECT NO.: 130388-01.02

REPORT PERIOD: December 26 to December 30, 2016

REPORT NO.: 046

PREPARED BY: Jason Cornetta

PROJECT NAME/LOCATION: Port Gamble Bay Cleanup

- Water quality monitoring: No water quality monitoring was performed this week. Monitoring was scheduled for 12/30/16 since there were high winds and small craft advisories on Monday 12/26/16 through Thursday 12/29/16. On Friday 12/30/16 the water quality team attempted to monitor in lighter winds but encountered large waves upon reaching open water and could not perform the monitoring.
- The final round of mussel cage retrieval is scheduled for the week of 1/3/17, weather dependent.
- The final round of archeological monitoring is scheduled for the week of 1/9/17, for the remaining intertidal excavation in SMA-1.

9. Problems Encountered and Corrective Actions

- None.

10. Health and Safety Observations

- Daily health and safety tool box talks performed.
- No health and safety incidents.

11. Other on Site Activities

- Subtidal and Intertidal Capping, EMNR, RMC, and backfill materials were imported and stockpiled on Site.
- Armoring erosion areas in accordance with the Revised Coastal Engineering Evaluation of Shoreline Erosion Memorandum

12. Anticipated Work for Next Week

- Continue capping and backfill material importing and stockpiling.
- Continue placing 3" minus backfill in 2h:1v slope areas in SMA-2
- Continue placing habitat substrate on completed 3" minus backfill areas in SMA-2
- Begin placing 3" minus backfill and armor in intertidal cap repair area of SMA-1
- Begin conveyor removal and demolition of log transfer dock
- Begin shoreline debris removal in Area 1

13. Changes and Modifications

- No Changes or Modifications required

14. Quantities (See Attached Tracking Tables)

15. Photos

WEEKLY SUMMARY REPORT


PHOTOGRAPHS




Comment: Placing 3" minus backfill in SMA-2



Comment: Placing armor rock in erosion area 1 (pocket beach)

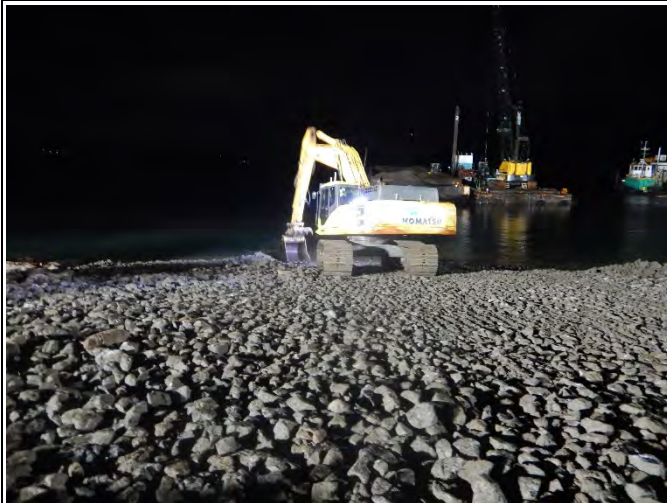

Comment: Placing armor rock in erosion area 3 (pocket beach)

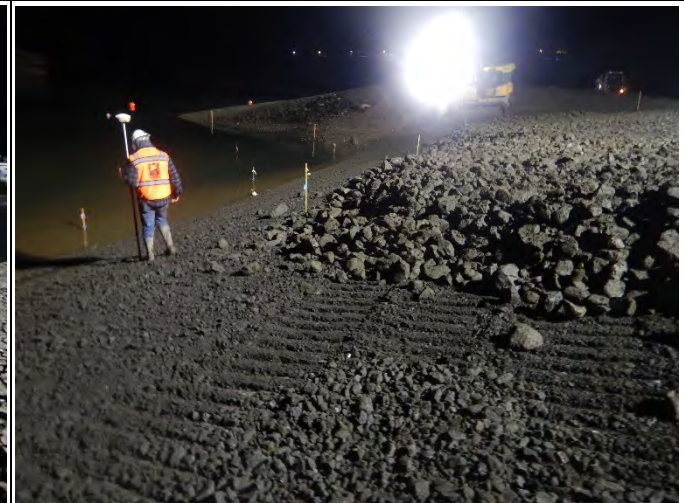

Comment: Pier 4 capping

WEEKLY SUMMARY REPORT

PHOTOGRAPHS



Comment: Erosion Area 1 – north of Eastern Wharf



Comment: Erosion Area 3 – west of transload area



Comment: Pier 4 capping area



Comment: Completed Pier 4 cap area



PROJECT NO.: 130388-01.02

REPORT PERIOD: January 2 to January 7, 2016

REPORT NO.: 047

PREPARED BY: Jason Cornetta

PROJECT NAME/LOCATION: Port Gamble Bay Cleanup

WEEKLY SUMMARY REPORT

Report Submitted to:		Contractor Name and Contact:	
To:	Arthur Kapell, Celina Abercrombie, WA Dept. of Ecology	General:	Orion Marine Contractors Inc. (OMCI)
cc:	Linda Berry-Maraist, PR/OPG John Laplante, PE, Clay Patmont, Ross Pickering, PE, Jason Cornetta, Anchor QEA, LLC	Subcontractors:	Zimmer Sand Pit New Shine Quarry Pyramid Materials MJ Trucking Harbor Offshore

1. Structure Demolition and Pile Extraction

- Completed removal of capping material barge loading conveyor and demolition of log transfer dock, removal of pilings associated with the log transfer dock

2. Creosote Processing and off Site Disposal

- Extracted piling were processed in the creosote processing area for off-site disposal

3. Former Landfill Shoreline Debris Removal

- Completed debris removal at Area 1

4. Intertidal Excavation and Capping

- Completed Pier 4 area capping with type 2 armor

5. Stockpile Management

- No Activity

6. Subtidal Capping, EMNR, RMC Placement, and 2:1 slope backfill in SMA-2

- Placement of 3" minus backfill and habitat substrate in SMA-2 (2:1 slope areas) with the 1201 spud barge and 9260 American Crane. Areas above -10 MLLW are receiving 12" of habitat substrate and areas below -10 MLLW are receiving 6" of habitat substrate.
- Placement of 3" minus backfill SMA-1 (intertidal cap and slope repair area) with the 1901 spud barge and 9299 American Crane.
- Placement of type 2 armor in the SMA-2 intertidal cap area to touch-up and tie-in the toe of slope and the 3" minus backfill.
- Placement of type 2 armor in the Pier 4 capping and backfill area.

7. Subtidal Dredging

- No Activity – Subtidal dredging is complete.

8. Environmental Controls



PROJECT NO.: 130388-01.02

REPORT PERIOD: January 2 to January 7, 2016

REPORT NO.: 047

PREPARED BY: Jason Cornetta

PROJECT NAME/LOCATION: Port Gamble Bay Cleanup

WEEKLY SUMMARY REPORT

- Water quality monitoring: Water quality monitoring was performed in accordance with the Ecology-approved Water Quality Monitoring Plan (Appendix E 401 Water Quality Memorandum) and the Water Quality Monitoring Plan (Attachment 2 of Appendix E to the BODR). Water quality monitoring was performed for:
 - Limited monitoring was conducted for capping in SMA-2 on January 5, 2017.
 - No confirmed turbidity exceedances were measured during monitoring activities.
- The final round of mussel cage retrieval was conducted on January 5, 2017. Mussel cages were retrieved from SMA-1, SMA-2, and reference areas (21 cages), plus 3 additional cages from the August deployment.
- The final round of archeological monitoring is scheduled for the week of January 8, 2017, for the remaining intertidal excavation in SMA-1.

9. Problems Encountered and Corrective Actions

- None.

10. Health and Safety Observations

- Daily health and safety tool box talks performed.
- No health and safety incidents.

11. Other on Site Activities

- Subtidal and Intertidal Capping, EMNR, RMC, and backfill materials were imported and stockpiled on Site.
- Continued armoring erosion areas in accordance with the Revised Coastal Engineering Evaluation of Shoreline Erosion Memorandum. Lower elevation portions of Area 1 and Area 3 were armored the using water-based crane and spud barge to place armor at elevations not accessible with the land-based equipment.

12. Anticipated Work for Next Week

- Continue capping and backfill material importing and stockpiling.
- Continue placing habitat substrate on completed 3" minus backfill areas in SMA-2
- Continue placing type 2 armor in intertidal cap repair area of SMA-1
- Final removal of remaining pilings and driver inspection/sweep
- Final SMA-1 intertidal excavation and capping at the log transfer dock demolition area.

13. Changes and Modifications

- No Changes or Modifications required

14. Quantities (See Attached Tracking Tables)

15. Photos

WEEKLY SUMMARY REPORT

PHOTOGRAPHS



Comment: Placing 3" minus backfill in SMA-1



Comment: Area 1 beach cleanup



Comment: Placing habitat substrate in Pier 4 cap and 3" minus backfill areas



Comment: Area 1 beach cleanup



WEEKLY SUMMARY REPORT

PROJECT NO.: 130388-01.02

REPORT PERIOD: January 2 to January 7, 2016

REPORT NO.: 047

PREPARED BY: Jason Cornetta

PROJECT NAME/LOCATION: Port Gamble Bay Cleanup

PHOTOGRAPHS



Comment: Debris pile from beach cleanup Area 1



Comment: Removal of asphalt debris in Area 1



PROJECT NO.: 130388-01.02

REPORT PERIOD: January 9 to January 13, 2016

REPORT NO.: 048

PREPARED BY: Jason Cornetta

PROJECT NAME/LOCATION: Port Gamble Bay Cleanup

WEEKLY SUMMARY REPORT

Report Submitted to:		Contractor Name and Contact:	
To:	Arthur Kapell, Celina Abercrombie, WA Dept. of Ecology	General:	Orion Marine Contractors Inc. (OMCI)
cc:	Linda Berry-Maraist, PR/OPG John Laplante, PE, Clay Patmont, Ross Pickering, PE, Jason Cornetta, Anchor QEA, LLC	Subcontractors:	Zimmer Sand Pit New Shine Quarry Pyramid Materials MJ Trucking Harbor Offshore

1. Structure Demolition and Pile Extraction

- Removal of remaining pilings associated with the log transfer dock and diver assisted removal of remaining pilings in SMA-1, SMA-2, and SMA-3.

2. Creosote Processing and off Site Disposal

- Extracted piling were processed in the creosote processing area for off-site disposal.

3. Former Landfill Shoreline Debris Removal

- All activities complete, Ecology approved remaining lower portion of Area 1 cleanup on 1/10/17.

4. Intertidal Excavation and Capping

- Completed SMA-1 intertidal excavation and capping at the former log transfer dock area. There was additional excavation in this area to remove wood waste encountered below the planned excavation limits.

5. Stockpile Management

- No Activity

6. Subtidal Capping, EMNR, RMC Placement, and 2:1 slope backfill in SMA-2

- Placement of type 2 armor in SMA-1 (intertidal cap and slope repair area) with the 1901 spud barge and 9299 American Crane.
- Placement of habitat substrate in the Pier 4 capping and backfill area.

7. Subtidal Dredging

- No Activity – Subtidal dredging is complete.

8. Environmental Controls

- Water quality monitoring: Water quality monitoring was performed in accordance with the Ecology-approved Water Quality Monitoring Plan (Appendix E 401 Water Quality Memorandum) and the Water Quality Monitoring Plan (Attachment 2 of Appendix E to the BODR). Water quality monitoring was performed for:



PROJECT NO.: 130388-01.02

REPORT PERIOD: January 9 to January 13, 2016

REPORT NO.: 048

PREPARED BY: Jason Cornetta

PROJECT NAME/LOCATION: Port Gamble Bay Cleanup

WEEKLY SUMMARY REPORT

- Limited monitoring was conducted for pile pulling in SMA-2, intertidal excavation and capping in SMA-1, and subtidal capping in SMA-1 on January 12, 2017.
- No confirmed turbidity exceedances were measured during monitoring activities for pile pulling in SMA-2 or intertidal excavation and capping in SMA-1.
- A confirmed turbidity exceedance was measured during monitoring activities for subtidal capping in SMA-1 on January 12, 2016.
- No confirmed turbidity exceedances were measured during subsequent monitoring for SMA-1 subtidal or intertidal capping conducted on January 12, 2017 and January 13, 2017.
- In-water work activities ended on January 14, 2017.
- The final round of archeological monitoring was conducted on January 16, 2017, no items of significance were observed.

9. Problems Encountered and Corrective Actions

- Additional intertidal excavation was conducted in SMA-1 to remove wood waste encountered below the planned excavation limits. The encountered wood waste material was removed within the remaining SMA-1 intertidal excavation area. A layer of wood waste was observed extending to the north beneath the previously completed intertidal excavation and cap area (approximately 8 feet or greater below the existing cap). This layer is isolated by sand backfill and/or an existing sand deposit, both vertically and horizontally. Following consultation with Ecology this material was left in place. Additional information regarding the location of the wood waste layer remaining below the SMA-1 intertidal cap will be provided in a follow-up memorandum and included as part of the Season 2 Cleanup Action Report.

10. Health and Safety Observations

- Daily health and safety tool box talks performed.
- No health and safety incidents.

11. Other on Site Activities

- Subtidal and Intertidal Capping, EMNR, RMC, and backfill materials were imported and stockpiled on Site.
- Intertidal cap repairs at end of SMA-1 Jetty area.

12. Anticipated Work for Next Week

- Demobilize construction equipment
- Processing and off-site disposal of creosote
- Processing and off-site recycling of concrete

13. Changes and Modifications

- No Changes or Modifications required

14. Quantities (See Attached Tracking Tables)


15. Photos

WEEKLY SUMMARY REPORT

PHOTOGRAPHS



Comment: Over-excavation of wood waste in SMA-1

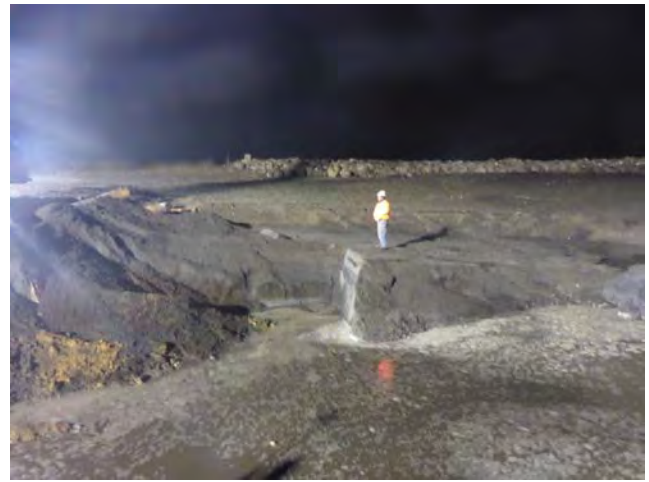

Comment: Wood waste chasing in SMA-1 intertidal excavation



Comment: Processing creosote pilings for off-site disposal



Comment: Removal of remaining pilings (diver-assisted)

WEEKLY SUMMARY REPORT

PHOTOGRAPHS



Comment: Placing armor in final section of SMA-1 intertidal cap



Comment: Placing habitat substrate in final section of SMA-1 intertidal cap

Appendix G

Archaeological Monitoring Report – Season 2



March 2017
Port Gamble Bay Cleanup Project



Archaeological Monitoring Report, Season 2

Pope Resources, LP/OPG Properties, LLC

March 2017
Port Gamble Bay Cleanup Project

Archaeological Monitoring Report, Season 2

Prepared for
Pope Resources, LP/OPG Properties, LLC
19950 7th Avenue NE, Suite 200
Poulsbo, Washington 98370

Prepared by
Anchor QEA, LLC
720 Olive Way, Suite 1900
Seattle, Washington 98101

TABLE OF CONTENTS

1	Introduction	1
2	Archaeological Monitoring Methods.....	4
3	Results.....	6
3.1	Debris Removal at Landfill 4	6
3.2	Intertidal Excavation in SMA-1.....	7
3.3	Remaining Intertidal Excavation in SMA-2.....	8
3.4	Subtidal Dredging in SMA-1.....	9
3.5	Remaining Subtidal Dredging in SMA-2.....	10
4	Recommendations.....	11
5	References	12

TABLES

Table 1	Archaeological Monitoring Activity, Seasons 1 and 2	5
---------	---	---

FIGURES

Figure 1	Vicinity Map	2
Figure 2	Area of Potential Effects	3
Figure 3	Overview of Landfills 4a and 4b.....	6
Figure 4	Brick from Landfill 4b.....	7
Figure 5	Conditions in SMA-1.....	8
Figure 6	Typical Sediments from Subtidal Dredging in SMA-1.....	9

ABBREVIATIONS

APE	Area of Potential Effects
Ecology	Washington State Department of Ecology
MTCA	Model Toxics Control Act
NRHP	National Register of Historic Places
PR/OPG	Pope Resources, LP/Olympic Property Group, LLC
Project	Port Gamble Bay Cleanup Project
SMA	Sediment Management Area
USACE	U.S. Army Corps of Engineers
WAC	Washington Administrative Code

1 Introduction

The Washington State Department of Ecology (Ecology) required that Pope Resources, LP/Olympic Property Group, LLC (PR/OPG), undertake environmental cleanup of Port Gamble Bay (Figure 1) in accordance with the requirements of Consent Decree 13-2-02720-0 between Ecology and PR/OPG, entered in December 2013. Cleanup of the site was performed from 2015 to 2017, consistent with the requirements of the Model Toxics Control Act (MTCA), Chapter 70.105D of the Revised Code of Washington (as administered by Ecology under the MTCA Cleanup Regulation), and Chapter 173 340 of the Washington Administrative Code (WAC). Cleanup actions also complied with the WAC Sediment Management Standards, Chapter 173-204.

Dredging, capping, removing creosote-treated piles and remnant creosote-treated structures, and other actions were performed within the Area of Potential Effects (APE) to accomplish the Port Gamble Bay Cleanup Project (Project; Figure 2). Project activities that required archaeological monitoring occurred in two Sediment Management Areas (SMAs) and two existing upland landfill locations. The Project was constructed in two seasons: Season 1 (June 2015 through January 2016) and Season 2 (June 2016 through January 2017). For a detailed description of the Project, see the *Cultural Resources Survey Report* (Bundy 2014) and *Archaeological Monitoring Plan and Inadvertent Discovery Plan* (Bundy 2015). For a report of monitoring during Season 1, see the *Archaeological Monitoring Report, Port Gamble Bay Cleanup Project (NWS-2013-1270), Season 1* (Bundy 2016).

The Project required a Nationwide Permit 38 from the U.S. Army Corps of Engineers (USACE), which was issued in 2015 with subsequent modifications (NWS-2013-1270). USACE must comply with Section 106 of the National Historic Preservation Act. Section 106 requires federal agencies to consider the effects of their undertakings on historic properties. A historic property is a prehistoric or historic building, site, object, structure, or district that is eligible for listing in the National Register of Historic Places (NRHP).

Several NRHP-eligible archaeological sites and built environment properties are located within the Project's APE. None is within the area of ground disturbance, and USACE has determined that none will be adversely affected by the Project. Two sites that have been determined not eligible for the NRHP are located within the area of ground disturbance. One site within SMA-1 and SMA-2, 45KP274, consisted of eight clusters of piles (many of which were removed during construction). The second site, located south of SMA-2, 45KP275, contains a widespread scatter of historic debris in the intertidal zone.

USACE required archaeological monitoring of some of the cleanup activities—intertidal and subtidal dredging, and upland debris removal. This report describes archaeological monitoring activities conducted during Season 2.




Publish Date: 2017/02/03 10:54 AM | User: hhayward
 Filepath: K:\Projects\0388-Pope Resources\Port Gamble Sediment Cleanup RI-FS\Port Gamble Sediment Cleanup RI-FS\Archaeological Monitoring Plan\0388-RP-001 (VMAP).dwg F1



Figure 1
Vicinity Map

Archaeological Monitoring Report, Season 2
 Port Gamble Bay Cleanup Project

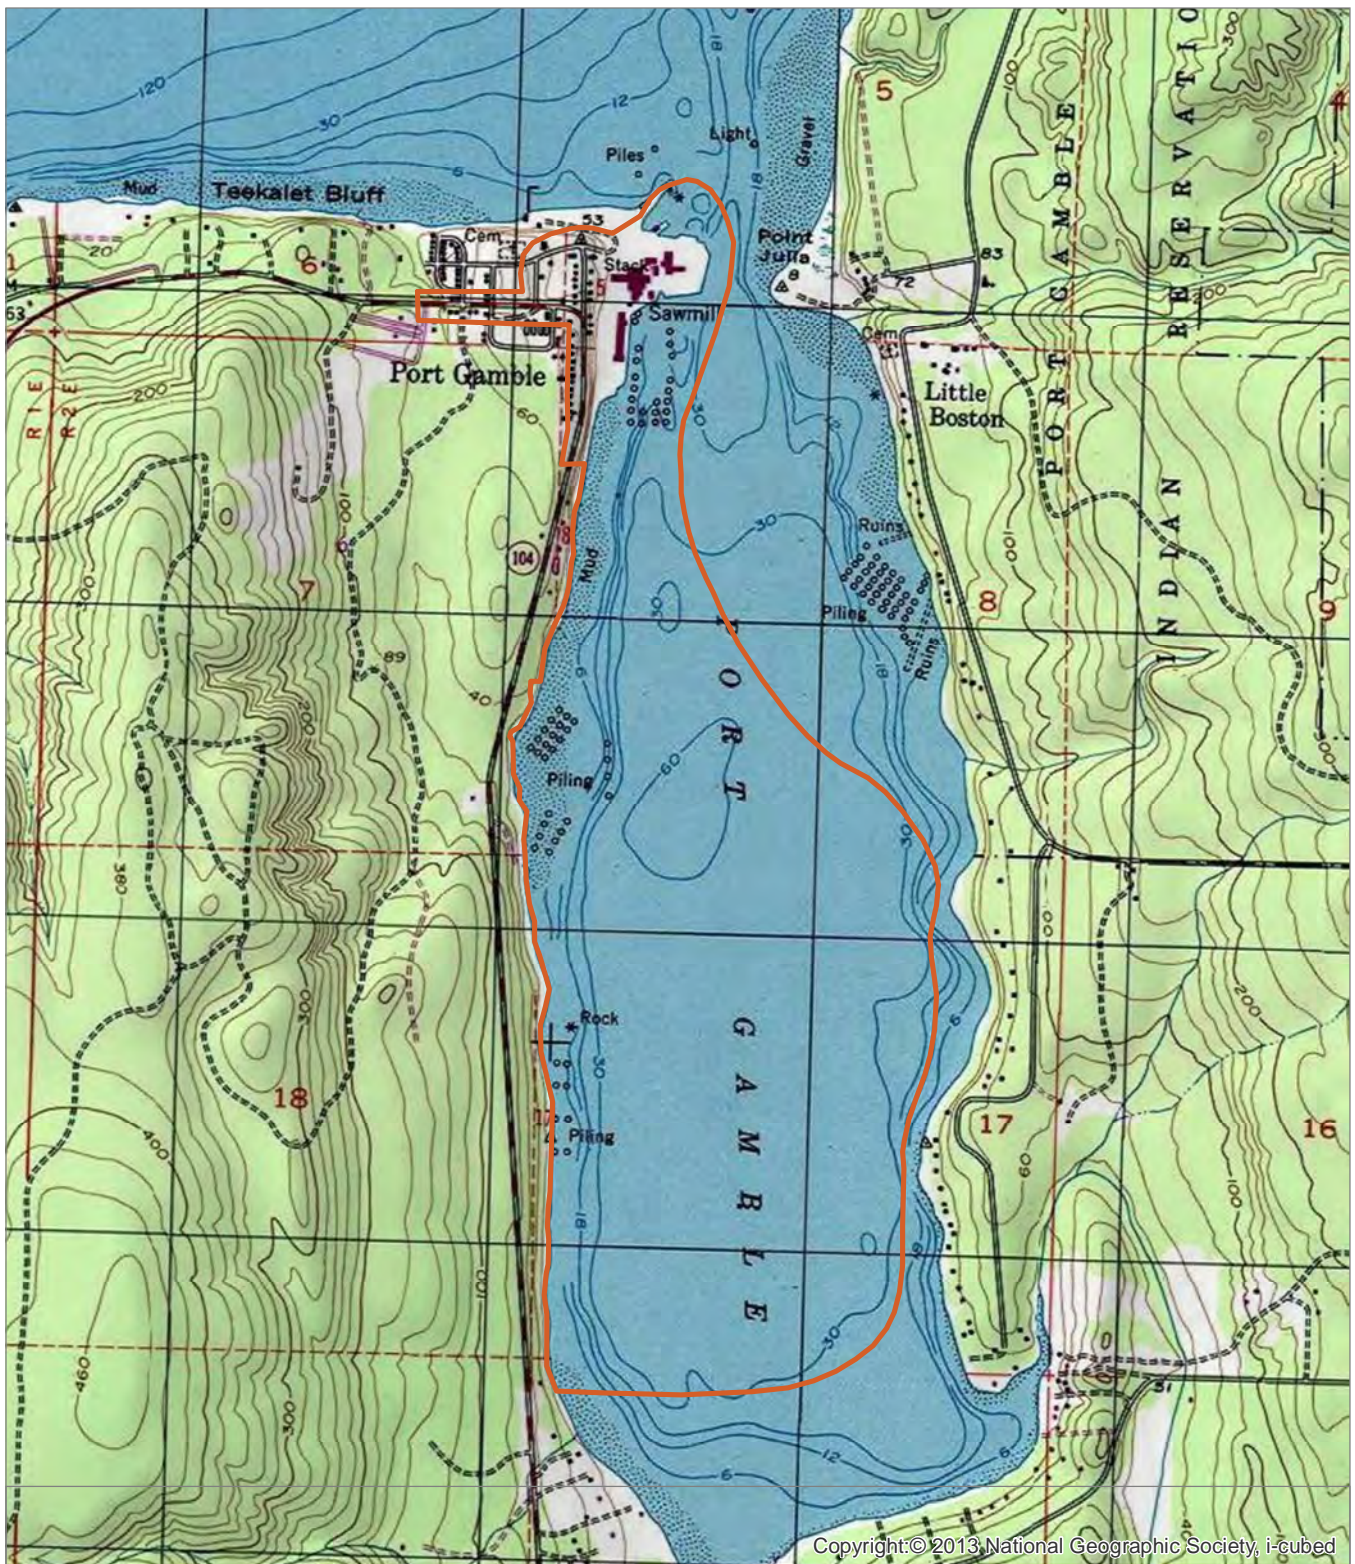

Copyright: © 2013, National Geographic Society, i-cubed

USGS 7.5' Quadrangle
Port Gamble

 Area of Potential Effects



Publish Date: 2017/02/16, 2:08 PM | User: bbundy
 Filepath: C:\Users\bbundy\Documents\GIS\Projects\PortGamble\PtGamble_ArchMonReportS2_Fig2.mxd



Figure 2
Area of Potential Effects
 Archaeological Monitoring Report, Season 2
 Port Gamble Bay Cleanup Project

2 Archaeological Monitoring Methods

Methods used for archaeological monitoring are described in detail in the *Archaeological Monitoring Plan and Inadvertent Discovery Plan* (Bundy 2015), and are briefly summarized here.

Archaeological monitoring was directly supervised by Dr. Barbara Bundy, who meets the Secretary of Interior's Professional Qualifications Standards for archaeology. Dr. Bundy and field technicians Alicia Toney and Lindsey Hudson conducted the monitoring.

Intertidal excavation and subtidal dredging in SMA-1 and SMA-2, and debris removal at Landfill 4, were monitored. Monitoring of subtidal and intertidal dredging was phased, with an intensive monitoring phase, followed by a routine monitoring phase if no significant cultural materials were observed during excavation activities.

For intensive monitoring, all sediments in the upland portion of the site that could be safely observed were visually inspected by the archaeological monitor on the first 3 days of each of the following two events: intertidal excavation in SMA-1 and subtidal dredging in SMA-1. For subtidal dredging, this meant examining 3 days of stockpiles from work in 1 day, because excavated materials were stockpiled on the barge during the first 3 days of dredging, preventing access until they were transferred to the upland portion of the site. Debris removal at Landfill 4 was completely monitored.

Because no significant cultural materials were encountered during intensive monitoring of either event in SMA-1, routine monitoring began for both events and continued to the end of the construction season. Intensive monitoring of intertidal excavation in SMA-2 and subtidal dredging in SMA-2 had been completed in Season 1 and was not repeated.

For routine monitoring, all sediments in the upland portion of the site that could be safely observed were visually inspected by the archaeological monitor 1 day per week (once every 7 days).

Due to tides, construction sequencing, and the holidays, work was often not continuous. For example, 5 days of intertidal excavation might occur over 2 calendar weeks. Intertidal excavation and subtidal dredging sometimes occurred simultaneously, in which case they were monitored on the same days. Monitored days were selected by coordinating with the construction team to determine maximum visibility of sediments during each 7-day period. Table 1 shows the days where monitoring occurred in both seasons.

Field notes were maintained and are on file at Anchor QEA. Status updates were provided by email to USACE, Department of Archaeology and Historic Preservation, Ecology, Department of Natural Resources, and affected tribes during monitoring.

Table 1
Archaeological Monitoring Activity, Seasons 1 and 2

Event	Date Completed	Related Email Update
SEASON 1		
Contractor Training	October 7, 2015	October 12, 2015
SMA-2: Intertidal Excavation, Intensive Monitoring	October 7 – 9, 2015	October 12, 2015
SMA-2: Intertidal Excavation, Routine Monitoring	October 30, 2015	November 5, 2015
	November 5, 2015	November 16, 2015
	November 19, 2015	November 23, 2015
	December 3, 2015	December 9, 2015
	December 10, 2015	December 15, 2015
	December 17, 2015	December 22, 2015
	December 28, 2015	December 29, 2015
	January 6, 2016	January 7, 2016
SMA-2: Subtidal Dredging, Intensive Monitoring	November 10, 2015	November 16, 2015
SMA-2: Subtidal Dredging, Routine Monitoring	November 19, 2015	November 23, 2015
	December 3, 2015	December 9, 2015
	December 10, 2015	December 15, 2015
	December 17, 2015	December 22, 2015
	December 28, 2015	December 29, 2015
	January 6, 2016	January 7, 2016
SEASON 2		
Landfill 4: Debris Removal	July 22, 25, 26, and 27, 2016	July 28, 2016
SMA-1: Intertidal Excavation, Intensive Monitoring	July 28, 2016	July 28, 2016
	August 1 and 2, 2016	August 8, 2016
SMA-1: Intertidal Excavation, Routine Monitoring	August 24, 2016	August 29, 2016
	September 8, 2016	September 19, 2016
SMA-1: Subtidal Dredging, Intensive Monitoring	October 18 and 19, 2016	October 25, 2016
SMA-1: Subtidal Dredging, Routine Monitoring	October 27, 2016	November 2, 2016
	October 31, 2016	November 2, 2016
	November 7, 2016	November 23, 2016
	November 17, 2016	November 23, 2016
SMA-2: Subtidal Dredging, Routine Monitoring	October 18, 2016	October 25, 2016
	October 27, 2016	November 2, 2016
	October 31, 2016	November 2, 2016
	November 7, 2016	November 23, 2016
	November 17, 2016	November 23, 2016
	December 2, 2016	December 6, 2016
SMA-2: Intertidal Excavation, Routine Monitoring	January 16, 2017	January 23, 2017

3 Results

No significant archaeological materials were identified during monitoring, and no intact features were identified. Many historic and modern artifacts were observed. Unlike in Season 1, very few diagnostic items were observed, and most were modern. This is probably because much of the work was in SMA-1, which contained mostly engineered fill (unlike SMA-2, which contained some areas where domestic demolition debris had been deposited in the mid-20th century). No precontact archaeological materials were observed.

3.1 Debris Removal at Landfill 4

Landfills 4a and 4b are within the boundary of the non-NRHP-eligible site 45KP275. The entire removal of debris was observed on July 22, 25, 26, and 27, 2016 (Figure 3). Materials observed included the remains of a barge (previously recorded and determined not NRHP-eligible), sparse bricks, small concrete chunks, and occasional small pieces of bottle glass. Bricks appeared to be structural. One partial brick read "CLAYBU" and possibly originally read "CLAYBURN," which is the name of a company that produced bricks from 1901 to 1931 in Clayburn Village near Abbotsford, British Columbia (Figure 4). Bricks were reportedly used for ballast in ships arriving at the mill. A few pieces of heavily rusted metal were also observed. Debris appeared to have been deposited on the beach from the water. No additional debris was observed in the sloping bluff above the site to the west between the beach and State Route 104.

Figure 3
Overview of Landfills 4a and 4b



Figure 4
Brick from Landfill 4b



3.2 Intertidal Excavation in SMA-1

During the cultural resources survey for the Project in 2014 (Bundy 2014), historic-age clusters of piles were noted in the SMA-1 intertidal area, and were included in 45KP275. The site has been determined not eligible for listing in the NRHP. The location of the SMA-2 shoreline is shown as intertidal and subtidal on early historic maps, and was gradually filled to its current position beginning in the late 19th century (Bundy 2014).

Monitoring revealed that the fill in this portion of the mill site appears to be primarily construction or engineered fill, rather than the demolition debris found in some portions of SMA-2 (Figure 5). Very few items were observed, and they were primarily either modern debris or non-diagnostic materials such as wire, rebar, and lumber. A deposit of firebrick was observed (visible in Figure 5, behind the cluster of piles), but was determined not NRHP-eligible.

Figure 5
Conditions in SMA-1



3.3 Remaining Intertidal Excavation in SMA-2

Intertidal excavation in SMA-2 was primarily conducted in Season 1, but a remaining portion was completed in Season 2. Routine monitoring resumed, which consisted of examining excavated sediments. Sediments were consistent with those observed toward the end of Season 1 in that historic and modern debris was sparse, essentially limited to pieces of milled lumber and occasional small fragments of plastic or metal. No significant artifacts or features were observed.

3.4 Subtidal Dredging in SMA-1

Subtidal sediments from dredging in SMA-1 were observed as they were stockpiled on the mill site, because it was not possible to observe directly from the dredging barge due to health and safety considerations. Observed sediments were of two types: subtidal silty sand with fragments of modern shell, and wood waste mixed with sandy silt. The latter was notable for the degree to which wood chips appeared intact, with a landscaping mulch-like appearance. Both types of sediments contained sparse evidence of historic activity such as metal cable, PVC pipe, glass, fabric, and metal fragments. Figure 6 shows both types of sediments.

Figure 6
Typical Sediments from Subtidal Dredging in SMA-1



3.5 Remaining Subtidal Dredging in SMA-2

Subtidal dredging in SMA-2 was primarily conducted in Season 1, but a remaining portion was completed in Season 2. Sediments were the same as described for the Season 1 dredge materials and for SMA-1: a mix of subtidal silty sands, and sediments dominated by wood waste.

4 Recommendations

It is recommended that USACE determine that no historic properties were observed during archaeological monitoring in Season 2.

For future projects, archaeological monitoring is not recommended at the following locations on the mill site:

- Along the shoreline (intertidal zone) of the mill site
- In water in SMA-1 and SMA-2
- Outside of a 50-meter buffer around the site boundary of 45KP252

Season 1 and Season 2 archaeological monitoring, as well as previous cultural resources research and archaeological monitoring, has indicated that there is little potential for significant archaeological sites in these locations.

5 References

- Bundy, B.E., 2016. *Archaeological Monitoring Report, Port Gamble Bay Cleanup Project (NWS-2013-1270), Season 1*. Report on file at the Department of Archaeology and Historic Preservation, Olympia, Washington.
- Bundy, B.E., 2015. *Archaeological Monitoring Plan and Inadvertent Discovery Plan*. Port Gamble Bay Cleanup. Report on file at the Department of Archaeology and Historic Preservation, Olympia, Washington.
- Bundy, B.E., 2014. *Cultural Resources Survey Report*. Port Gamble Bay Cleanup. Report on file at the Department of Archaeology and Historic Preservation, Olympia, Washington.

Appendix H

As-built Construction Drawings


RECORD DRAWINGS

PORT GAMBLE BAY CLEANUP

POPE RESOURCES LP / OPG PROPERTIES LLC

LOCATION MAP

VICINITY MAP

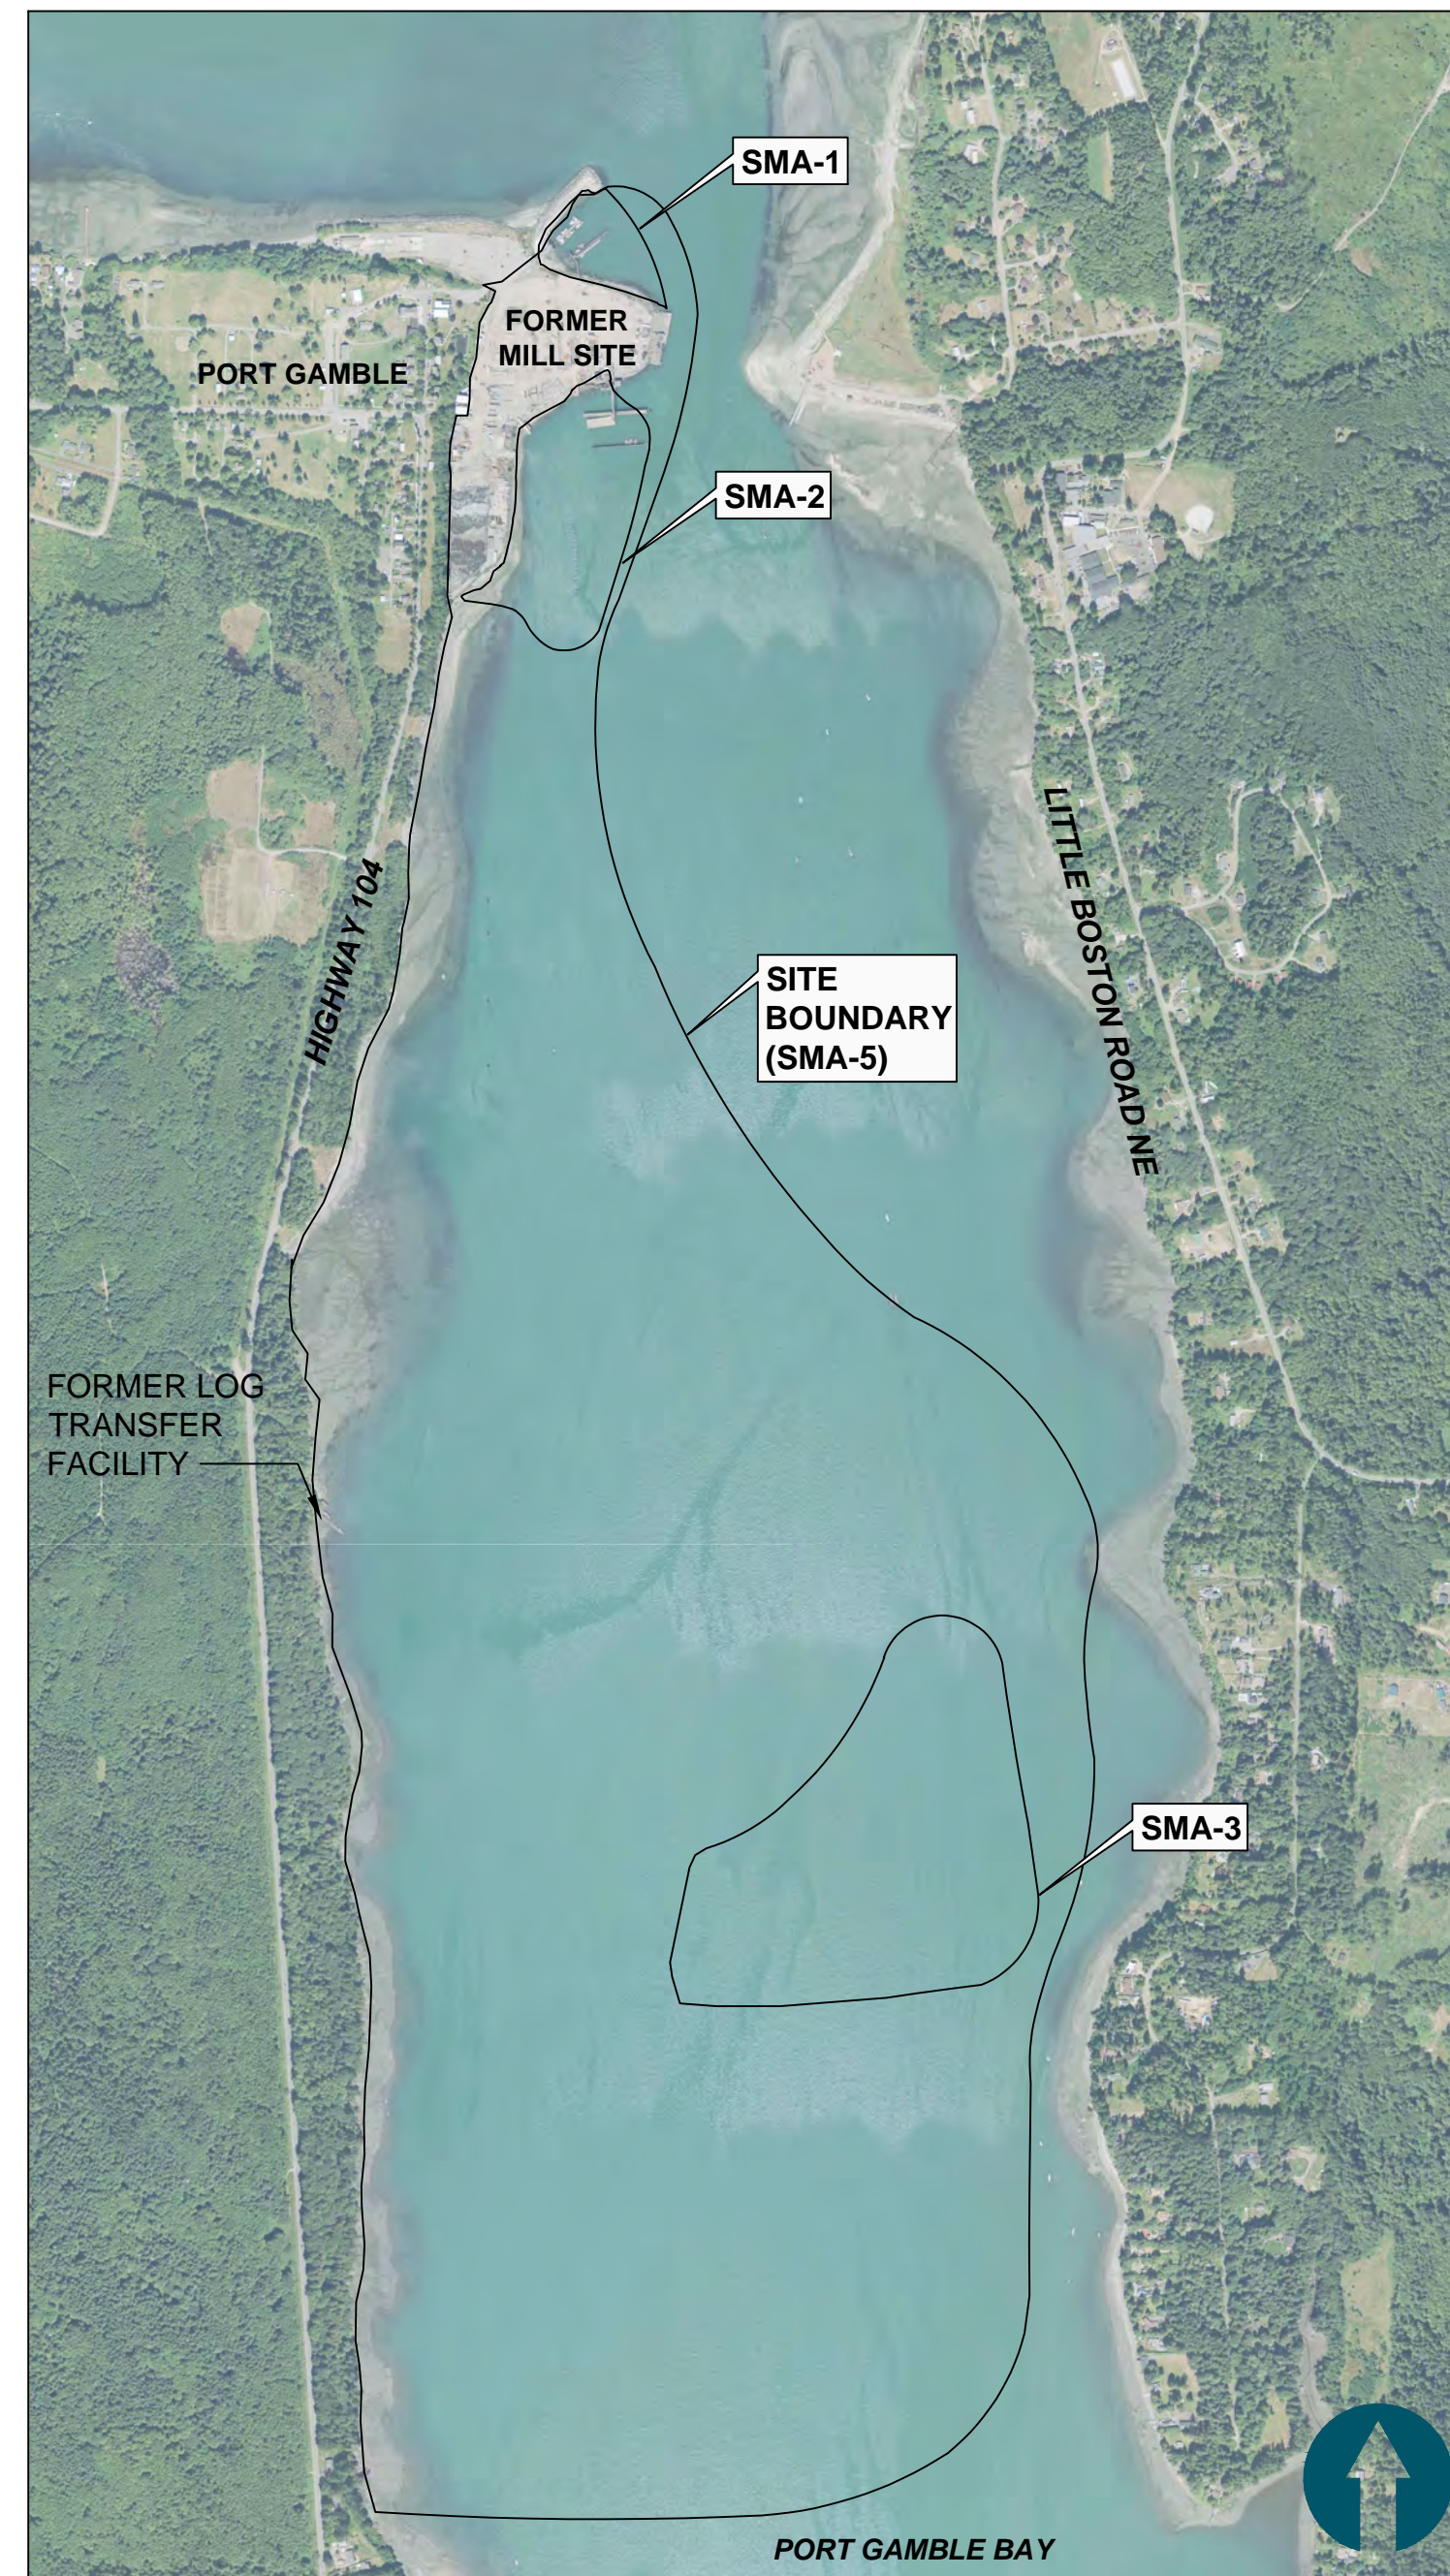

DRAWING INDEX		
SHEET	SHEET TITLE	SHEET DESCRIPTION
1	T-01	COVER SHEET
2	T-02	GENERAL NOTES AND ABBREVIATIONS
3	G-01	SITE LAYOUT AND SHEET INDEX
4	G-02	PRE-CONSTRUCTION CONDITIONS (1 OF 2)
5	G-03	PRE-CONSTRUCTION CONDITIONS (2 OF 2)
6	G-04	SITE STAGING AND ACCESS
7	G-05	STAGING AND STOCKPILING
8	G-06	VESSEL NAVIGATION LANES
9	D-01	DEMOLITION PLAN (1 OF 2) STRUCTURES AND PILING
10	D-02	DEMOLITION PLAN (2 OF 2) STRUCTURES AND PILING
11	C-01	POST-DREDGE/EXCAVATION PLAN (SMA-1)
12	C-02	POST-DREDGE/EXCAVATION CROSS SECTIONS (SMA-1)
13	C-03	POST-DREDGE/EXCAVATION PLAN (SMA-2)
14	C-04	POST-DREDGE/EXCAVATION CROSS SECTIONS (SMA-2) 1 OF 2
15	C-05	POST-DREDGE/EXCAVATION CROSS SECTIONS (SMA-2) 2 OF 2
16	C-06	POST-RESIDUALS COVER AND CAPPING CONDITIONS (SMA-1)
17	C-07	POST-RESIDUALS COVER AND CAPPING CROSS SECTIONS (SMA-1)
18	C-08	POST-CAPPING CONDITIONS (SMA-2)
19	C-09	POST-CAPPING CROSS SECTIONS (SMA-2) 1 OF 2
20	C-10	POST-CAPPING CROSS SECTIONS (SMA-2) 2 OF 2
21	C-11	POST-CONSTRUCTION CONDITIONS (SMA-3)
22	C-12	TESC DETAILS
23	C-13	MISCELLANEOUS DETAILS
24	C-14	CAP DETAILS

K:\Projects\0388-Pope Resources\Port Gamble Sediment Cleanup_RFP\Construction Plans\As-Built\0388-T-01 (Cover).dwg T-01
Jan 04, 2018 9:48am chawett



POPE RESOURCES LP / OPG PROPERTIES LLC



REVISIONS				
REV	DATE	BY	APP'D	DESCRIPTION
1	11/6/2017	CH	JL	RECORD DRAWINGS

DESIGNED BY: R. PICKERING
 DRAWN BY: C. HEWETT
 CHECKED BY: J. LAPLANTE
 APPROVED BY: J. LAPLANTE
 SCALE: AS NOTED
 DATE: OCTOBER 2017

**PORT GAMBLE BAY CLEANUP
 RECORD DRAWINGS**

COVER SHEET

T-01

SHEET NO. 1 OF 24

RECORD DRAWINGS

ONE INCH
 AT FULL SIZE, IF NOT ONE
 INCH SCALE ACCORDINGLY

SMA-1 DREDGE CONTROL POINTS

Table with 6 columns: POINT #, NORTHING, EASTING, POINT #, NORTHING, EASTING. Contains 45 rows of control point data for SMA-1.

SMA-2 DREDGE CONTROL POINTS

Table with 9 columns: POINT #, NORTHING, EASTING, POINT #, NORTHING, EASTING, POINT #, NORTHING, EASTING. Contains 105 rows of control point data for SMA-2.

SMA-1 CAPPING CONTROL POINTS

Table with 6 columns: POINT #, NORTHING, EASTING, POINT #, NORTHING, EASTING. Contains 26 rows of capping control point data for SMA-1.

SMA-2 CAPPING CONTROL POINTS


Table with 9 columns: POINT #, NORTHING, EASTING, POINT #, NORTHING, EASTING, POINT #, NORTHING, EASTING. Contains 355 rows of capping control point data for SMA-2.

ABBREVIATIONS

Table with 2 columns: ABBRV, ABBREVIATION. Lists standard surveying and construction abbreviations such as APPROX., BLDG, BMP, CONC, CONT, CP, CY, DWG, E, EL, ELEV, EX, FT, IN, MAX, MH, MIN, MISC, MHHW, MLLW, N, NAD, NAVD, NO., OC, OHP, PR/OPG, ROW, S, SD, SF, SHT, SMA, SPEC, STA, STD, STRUCT, TESC, TYP, W, WSDOT.

SIGNIFICANT REVISIONS WERE MADE TO THE DREDGING AND CAPPING AREAS DURING CONSTRUCTION. SEE DRAWINGS C-01, C-03, C-06, AND C-08 FOR FINAL CONFIGURATION OF DREDGING AND CAPPING AREAS

DETAIL AND SECTION REFERENCING:

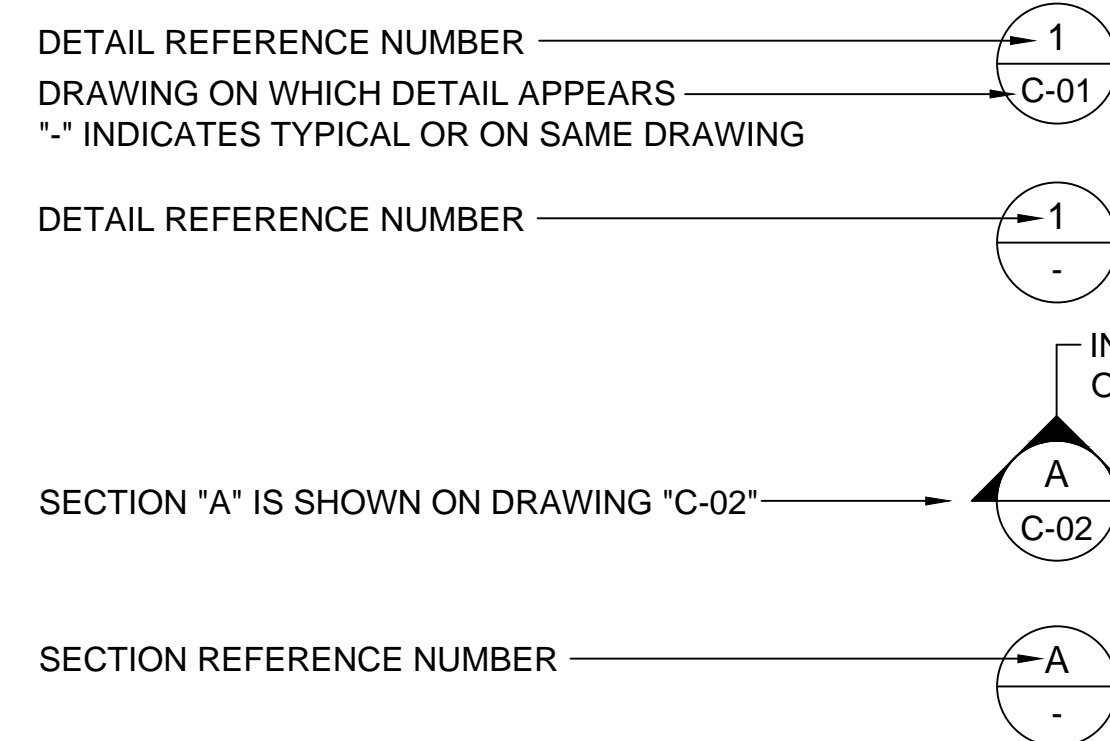

GENERAL SURVEY NOTES

- 1. HORIZONTAL DATUM: WASHINGTON STATE PLANE NORTH ZONE, NAD 83, U.S. FEET.
2. VERTICAL DATUM: MEAN LOWER LOW WATER (MLLW).
3. PRE-CONSTRUCTION UPLAND SURVEY BY TRIAD ASSOCIATES, DATED JULY, 2012. DATUM CHANGED FROM NAVD88 TO MLLW WITH THE FOLLOWING EQUATION, NAVD88 + 2.12 FEET = MLLW. PRE-CONSTRUCTION BATHYMETRY BY ETRAC, DATED AUGUST 27, 2014, AND ECOLOGY, DATED 2014.
4. POST-DREDGE BATHYMETRY FROM ORION, DATED NOVEMBER, 2016, TO JANUARY, 2017.
5. POST-CONSTRUCTION BATHYMETRY FROM ETRAC, DATED JANUARY 19, 2017.
6. THE ABOVE SURVEYS WERE MERGED BY ANCHOR QEA TO PROVIDE A CONTINUOUS EXISTING ELEVATIONS DATA SET.
7. MEAN HIGHER HIGH WATER IS AT ELEVATION 10.30 FEET MLLW

RECORD DRAWINGS



POPE RESOURCES LP / OPG PROPERTIES LLC



Table with 5 columns: REV, DATE, BY, APP'D, DESCRIPTION. Contains one revision entry dated 11/6/2017.

DESIGNED BY: R. PICKERING
DRAWN BY: C. HEWETT
CHECKED BY: J. LAPLANTE
APPROVED BY: J. LAPLANTE
SCALE: N/A
DATE: OCTOBER 2017


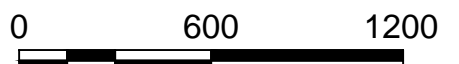
PORT GAMBLE BAY CLEANUP RECORD DRAWINGS

GENERAL NOTES AND ABBREVIATIONS

T-02

K:\Projects\0388-Pope Resources\Port Gamble Sediment Cleanup RFP\Construction Plans\As-built\0388-C-01 (Record Conditions).dwg G-01
Jan 04, 2018 9:49am chewett




 NORTH
 SCALE IN FEET
 ONE INCH = 600 FEET
 AT FULL SIZE, IF NOT ONE INCH SCALE ACCORDINGLY

NOTES:
 1. HORIZONTAL DATUM: WASHINGTON STATE PLANE NORTH ZONE, NAD83, US FEET.

RECORD DRAWINGS



POPE RESOURCES LP / OPG PROPERTIES LLC

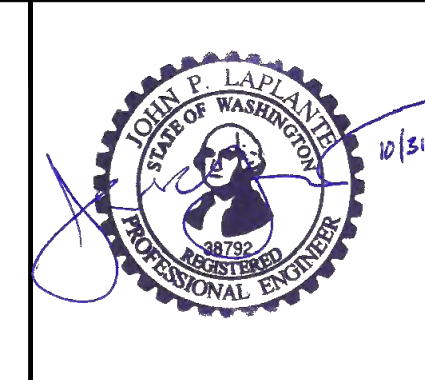

REVISIONS				
REV	DATE	BY	APP'D	DESCRIPTION
1	11/6/2017	CH	JL	RECORD DRAWINGS

DESIGNED BY: R. PICKERING
 DRAWN BY: C. HEWETT
 CHECKED BY: J. LAPLANTE
 APPROVED BY: J. LAPLANTE
 SCALE: 1" = 600'
 DATE: OCTOBER 2017

**PORT GAMBLE BAY CLEANUP
RECORD DRAWINGS**


SITE LAYOUT AND SHEET INDEX

G-01

SHEET NO. **3** OF **24**

SIGNIFICANT QUANTITIES OF INTERTIDAL AND SUBTIDAL PILES WERE ENCOUNTERED DURING CONSTRUCTION THAT ARE NOT SHOWN ON THESE DRAWINGS

BASELINE CONTROL POINTS		
POINT #	NORTHING	EASTING
BL1	315542.8	1210833.3
BL2	315740.4	1211040.6
BL3	316483.1	1211055.2
BL4	316775.8	1211543.0
BL5	316824.6	1211819.4
BL6	317019.7	1211863.4
BL7	317133.1	1211356.2
BL8	317290.9	1211230.8
BL9	317483.9	1211180.3
BL10	317799.5	1211526.9

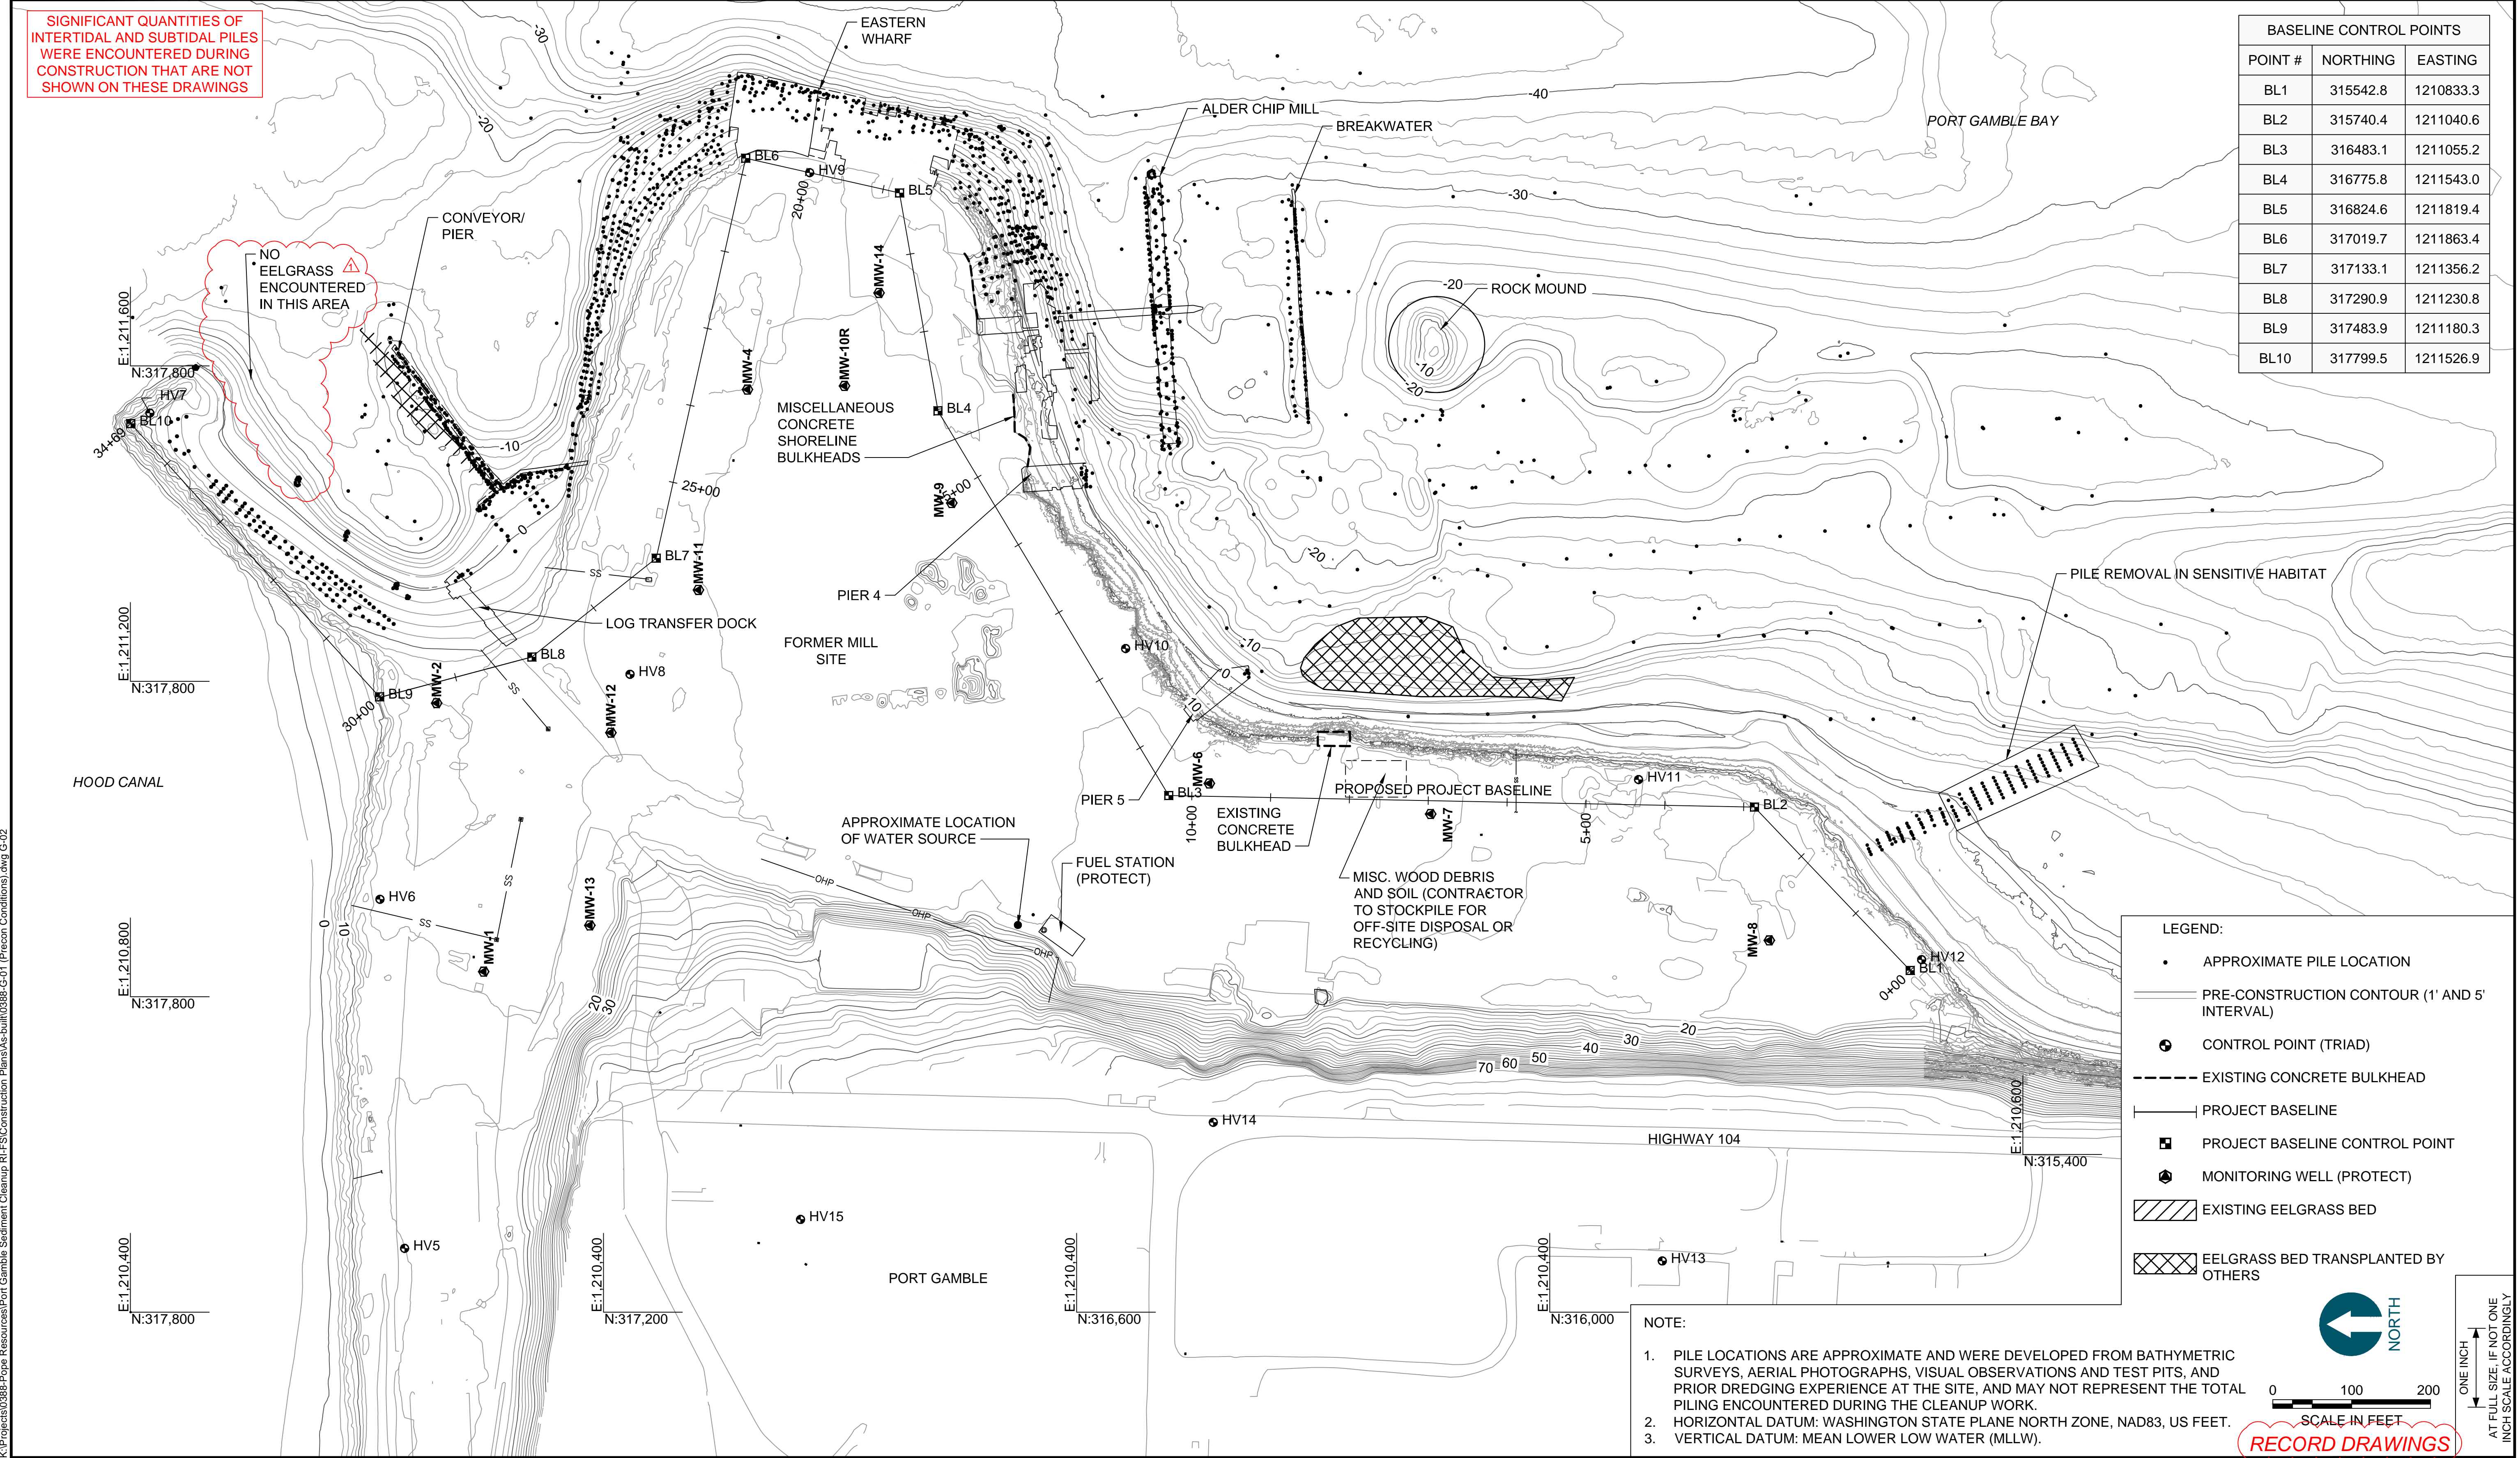

LEGEND:

- APPROXIMATE PILE LOCATION
- PRE-CONSTRUCTION CONTOUR (1' AND 5' INTERVAL)
- ⊕ CONTROL POINT (TRIAD)
- EXISTING CONCRETE BULKHEAD
- PROJECT BASELINE
- PROJECT BASELINE CONTROL POINT
- ⊙ MONITORING WELL (PROTECT)
- ▨ EXISTING EELGRASS BED
- ▩ EELGRASS BED TRANSPLANTED BY OTHERS

NOTE:

1. PILE LOCATIONS ARE APPROXIMATE AND WERE DEVELOPED FROM BATHYMETRIC SURVEYS, AERIAL PHOTOGRAPHS, VISUAL OBSERVATIONS AND TEST PITS, AND PRIOR DREDGING EXPERIENCE AT THE SITE, AND MAY NOT REPRESENT THE TOTAL PILING ENCOUNTERED DURING THE CLEANUP WORK.
2. HORIZONTAL DATUM: WASHINGTON STATE PLANE NORTH ZONE, NAD83, US FEET.
3. VERTICAL DATUM: MEAN LOWER LOW WATER (MLLW).

NORTH

SCALE IN FEET

0 100 200

ONE INCH = 100 FEET

AT FULL SIZE, IF NOT ONE INCH SCALE ACCORDINGLY

RECORD DRAWINGS

K:\Projects\0388-Pope Resources\Port Gamble\Sttlement\Cleanup R\F\SI\Construction Plans\As-built\0388-C-01 (Precon Conditions).dwg G-02



POPE RESOURCES LP / OPG PROPERTIES LLC



REVISIONS				
REV	DATE	BY	APP'D	DESCRIPTION
1	11/8/2017	CH	JL	RECORD DRAWINGS

DESIGNED BY: R. PICKERING
 DRAWN BY: C. HEWETT
 CHECKED BY: J. LAPLANTE
 APPROVED BY: J. LAPLANTE
 SCALE: 1" = 100'
 DATE: OCTOBER 2017


**PORT GAMBLE BAY CLEANUP
RECORD DRAWINGS**

PRE-CONSTRUCTION CONDITIONS (1 OF 2)

G-02

SHEET NO. 4 OF 24

SIGNIFICANT QUANTITIES OF INTERTIDAL AND SUBTIDAL PILES WERE ENCOUNTERED DURING CONSTRUCTION THAT ARE NOT SHOWN ON THESE DRAWINGS. REVISION CLOUDS AROUND PILES INDICATES ADDITIONAL PILING TARGET LOCATIONS ADDED BY DEPARTMENT OF ECOLOGY.

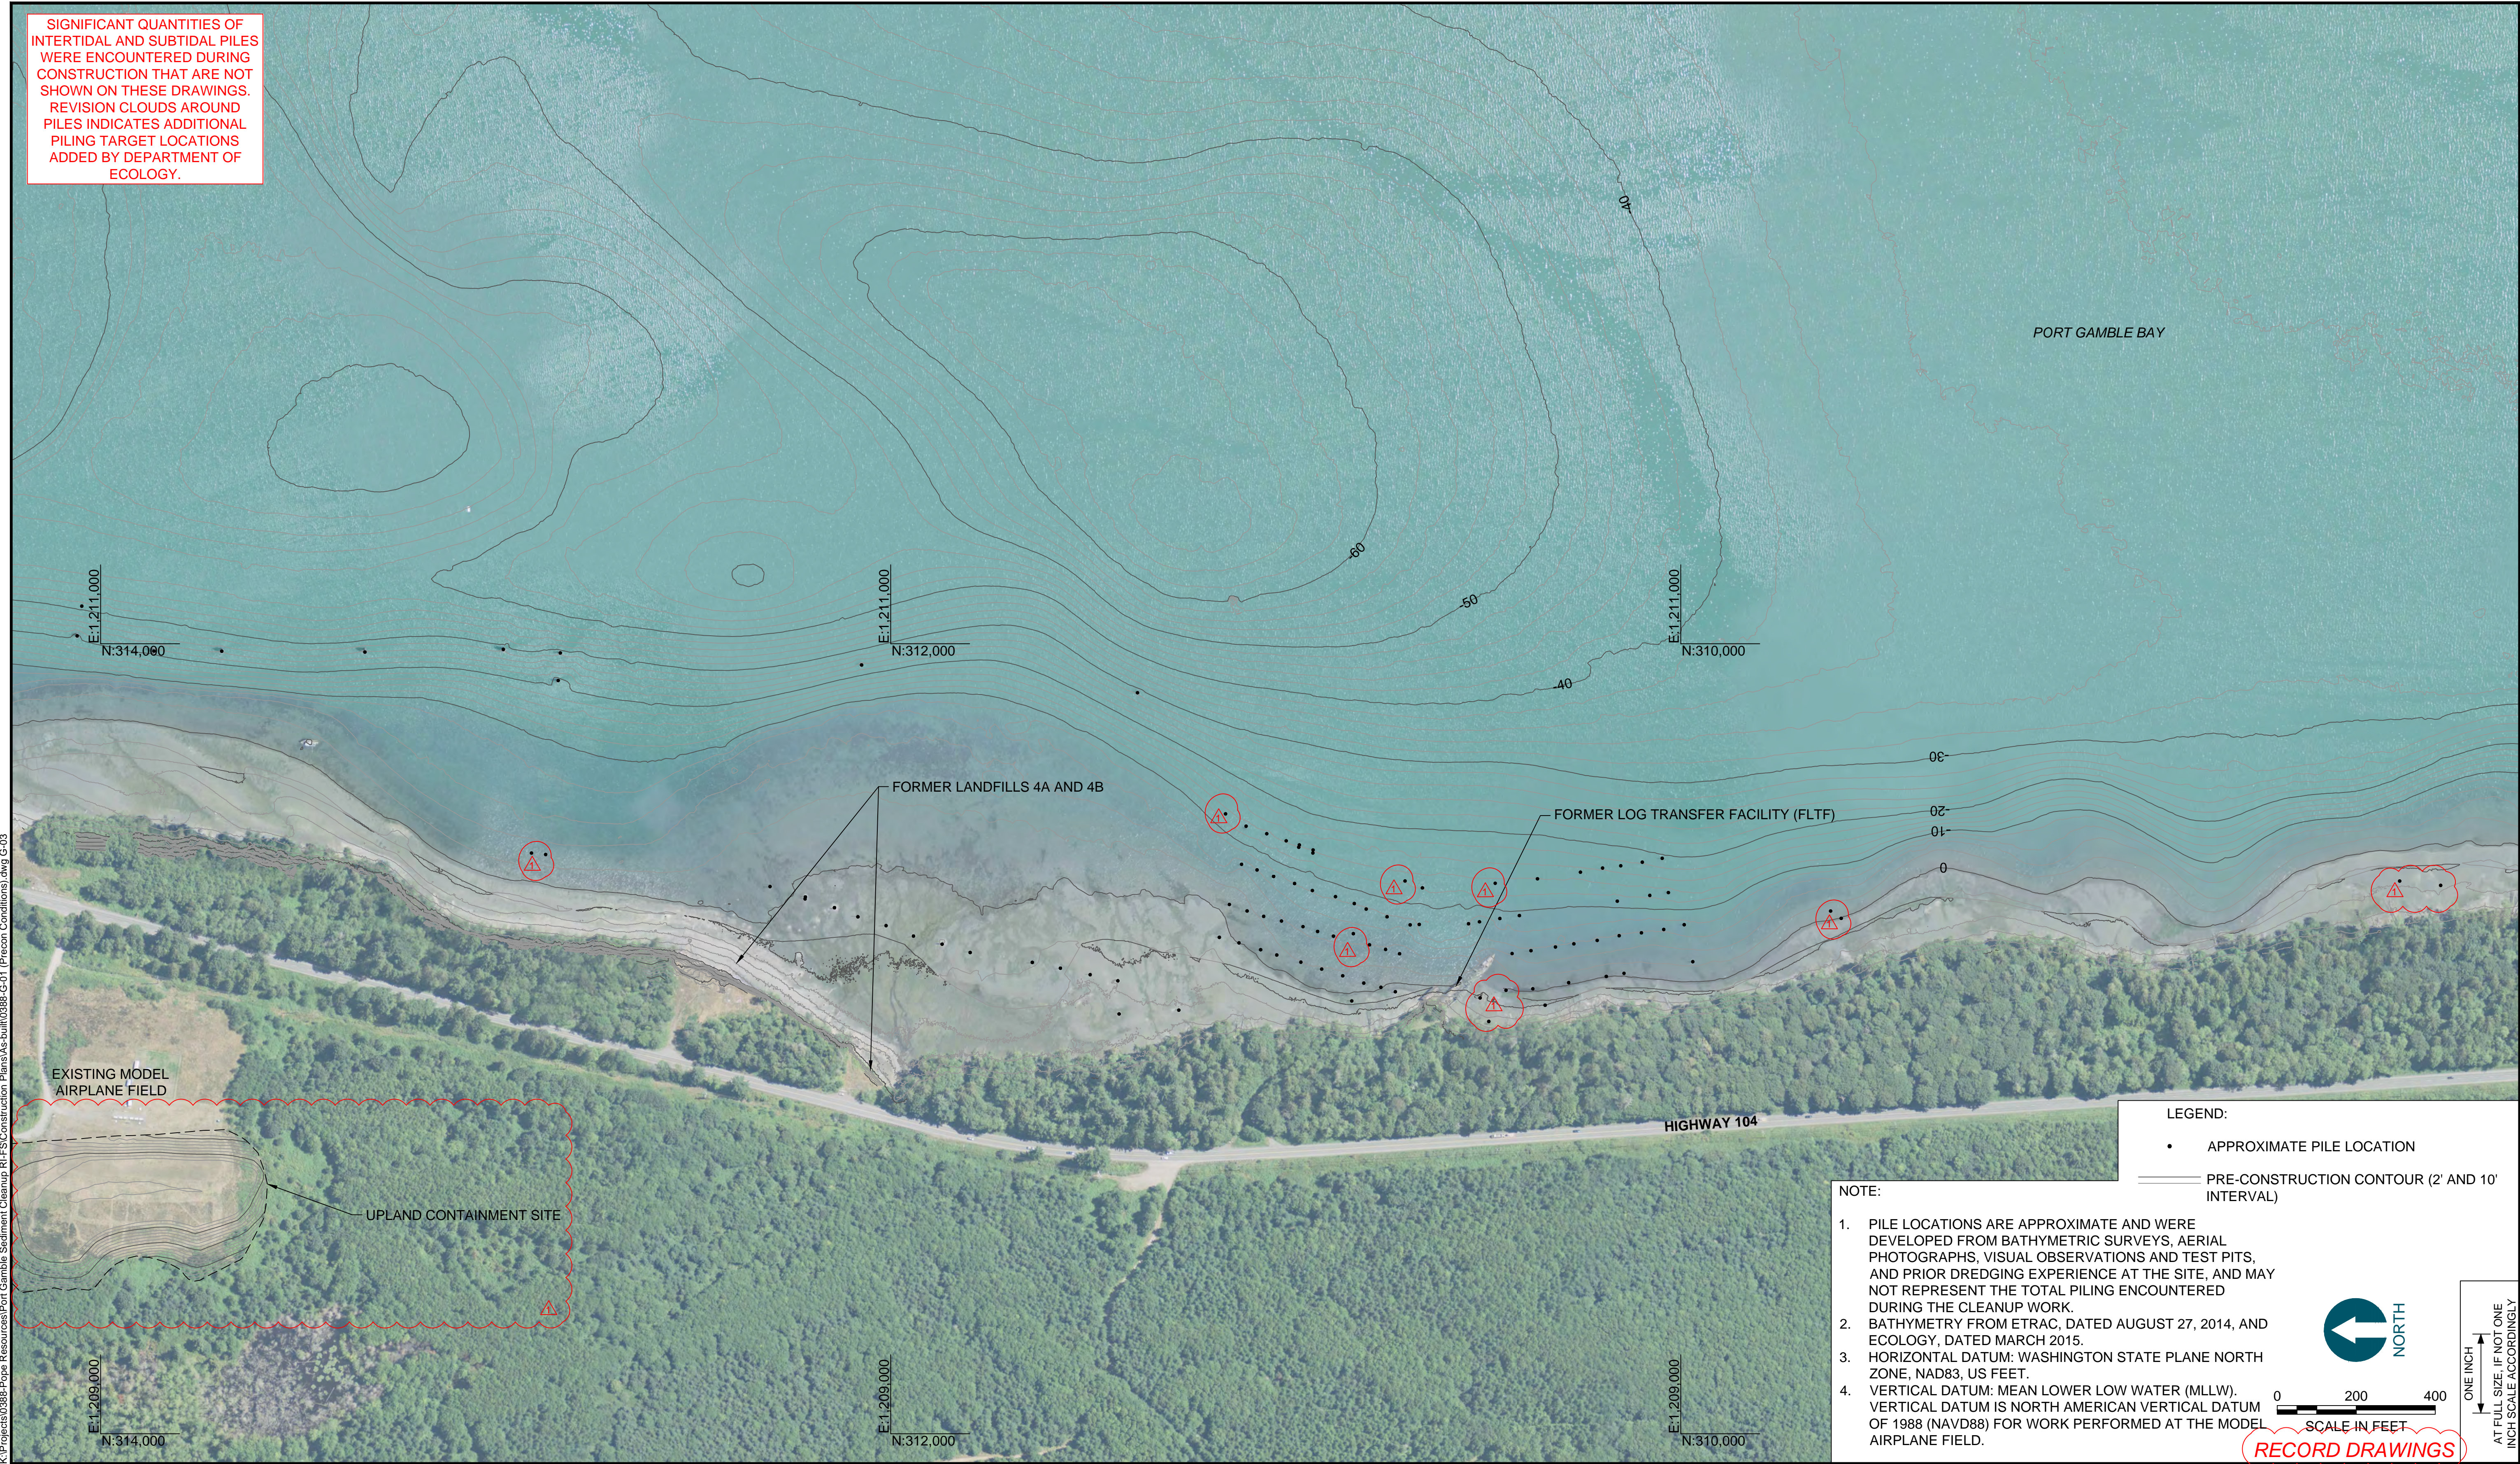

LEGEND:
 • APPROXIMATE PILE LOCATION
 — PRE-CONSTRUCTION CONTOUR (2' AND 10' INTERVAL)

NOTE:
 1. PILE LOCATIONS ARE APPROXIMATE AND WERE DEVELOPED FROM BATHYMETRIC SURVEYS, AERIAL PHOTOGRAPHS, VISUAL OBSERVATIONS AND TEST PITS, AND PRIOR DREDGING EXPERIENCE AT THE SITE, AND MAY NOT REPRESENT THE TOTAL PILING ENCOUNTERED DURING THE CLEANUP WORK.
 2. BATHYMETRY FROM ETRAC, DATED AUGUST 27, 2014, AND ECOLOGY, DATED MARCH 2015.
 3. HORIZONTAL DATUM: WASHINGTON STATE PLANE NORTH ZONE, NAD83, US FEET.
 4. VERTICAL DATUM: MEAN LOWER LOW WATER (MLLW). VERTICAL DATUM IS NORTH AMERICAN VERTICAL DATUM OF 1988 (NAVD88) FOR WORK PERFORMED AT THE MODEL AIRPLANE FIELD.


SCALE IN FEET: 0 200 400
 NORTH
 ONE INCH AT FULL SIZE, IF NOT ONE INCH SCALE ACCORDINGLY

RECORD DRAWINGS

K:\Projects\0388-Pope Resources\Port Gamble Sediment Cleanup RLES\Construction Plans\As-Built\0388-C-01 (Precon Conditions).dwg G-03
 Jan 04, 2018 9:50am chewart



POPE RESOURCES LP / OPG PROPERTIES LLC

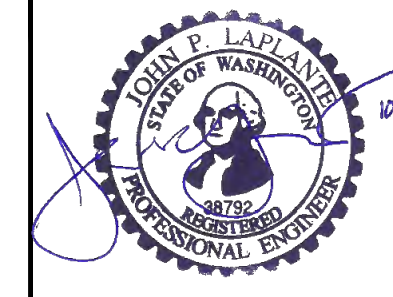

REVISIONS				
REV	DATE	BY	APP'D	DESCRIPTION
1	11/6/2017	CH	JL	RECORD DRAWINGS

DESIGNED BY: R. PICKERING
 DRAWN BY: C. HEWETT
 CHECKED BY: J. LAPLANTE
 APPROVED BY: J. LAPLANTE
 SCALE: 1" = 200'
 DATE: OCTOBER 2017


**PORT GAMBLE BAY CLEANUP
 RECORD DRAWINGS**

PRE-CONSTRUCTION CONDITIONS (2 OF 2)

G-03

SHEET NO. 5 OF 24

K:\Projects\0388-Pope Resources\Port Gamble Sludgment Cleanup R\F\Construction Plans\As-built\0388-G-04 (Staging and access).dwg G-04

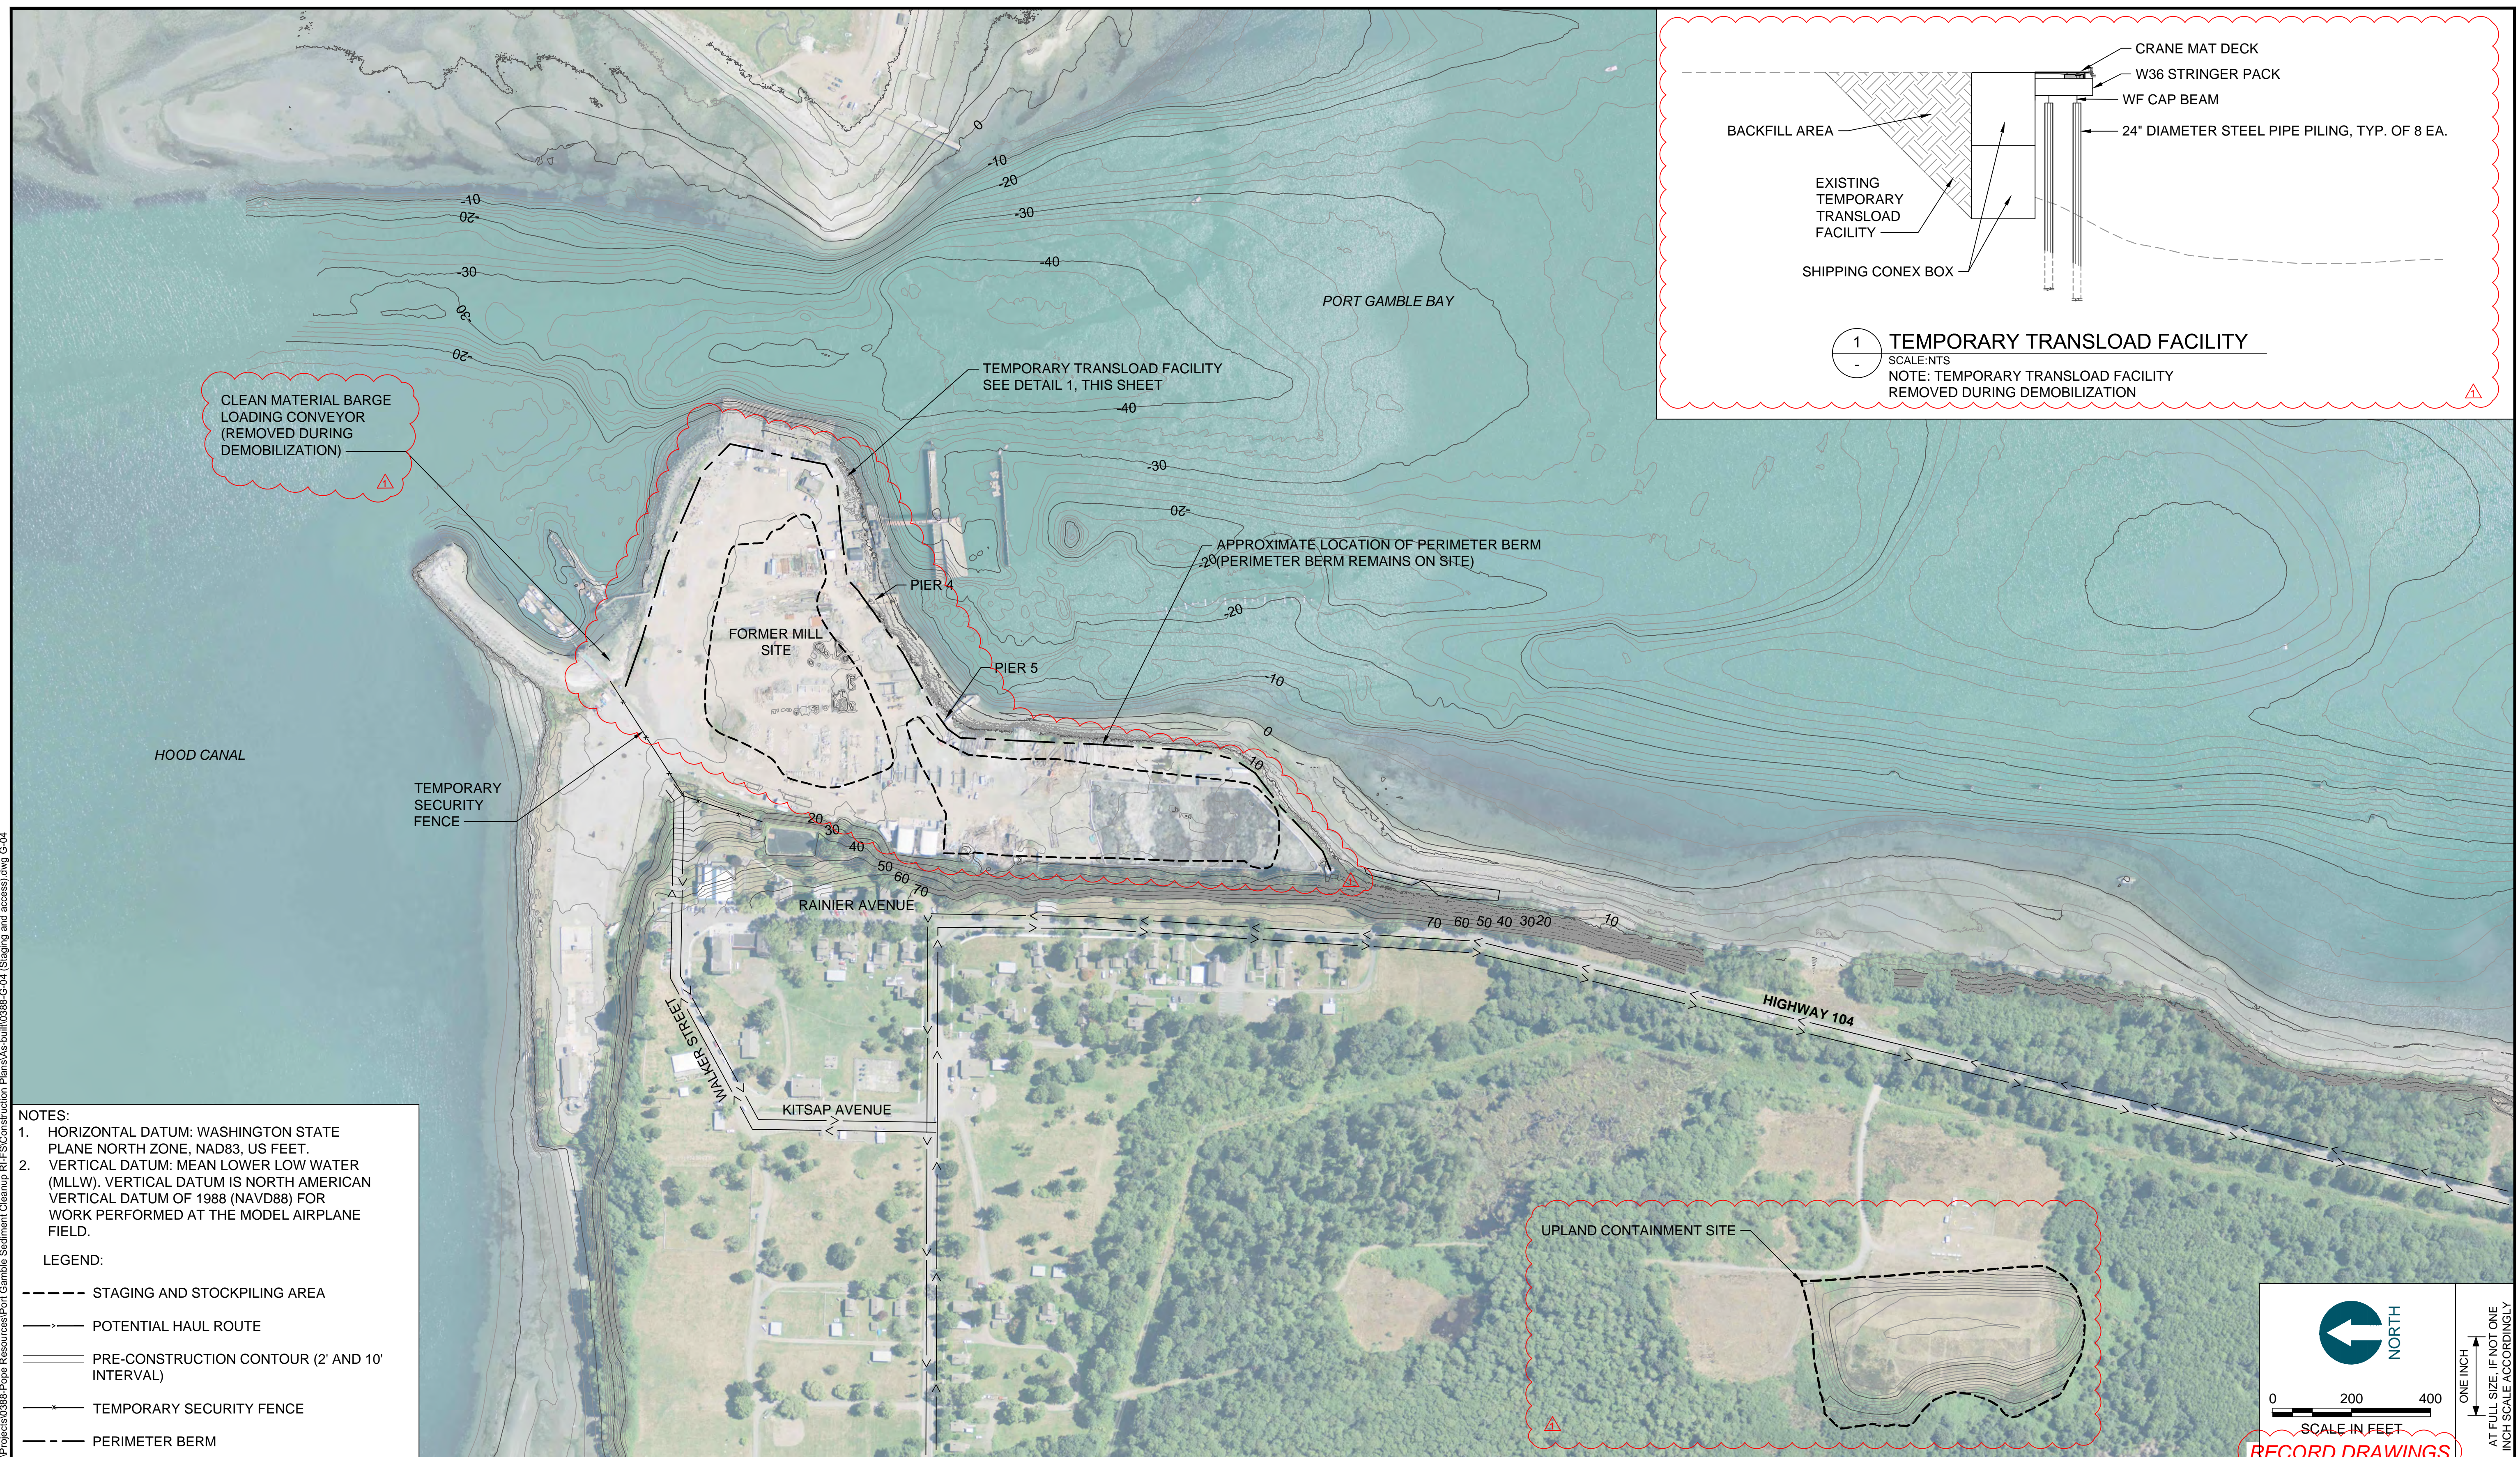


NOTES:
 1. HORIZONTAL DATUM: WASHINGTON STATE PLANE NORTH ZONE, NAD83, US FEET.
 2. VERTICAL DATUM: MEAN LOWER LOW WATER (MLLW). VERTICAL DATUM IS NORTH AMERICAN VERTICAL DATUM OF 1988 (NAVD88) FOR WORK PERFORMED AT THE MODEL AIRPLANE FIELD.

LEGEND:
 - - - - STAGING AND STOCKPILING AREA
 ———— POTENTIAL HAUL ROUTE
 ———— PRE-CONSTRUCTION CONTOUR (2' AND 10' INTERVAL)
 ———— TEMPORARY SECURITY FENCE
 - - - - PERIMETER BERM



POPE RESOURCES LP / OPG PROPERTIES LLC

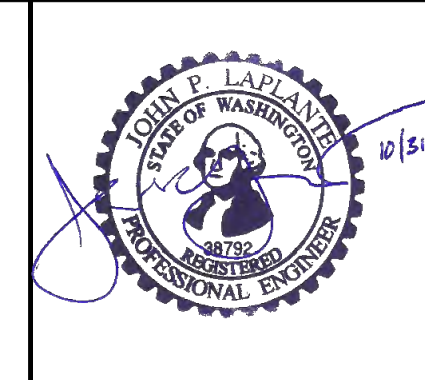

REVISIONS				
REV	DATE	BY	APP'D	DESCRIPTION
1	11/6/2017	CH	JL	RECORD DRAWINGS

DESIGNED BY: R. PICKERING
 DRAWN BY: C. HEWETT
 CHECKED BY: J. LAPLANTE
 APPROVED BY: J. LAPLANTE
 SCALE: 1" = X'
 DATE: OCTOBER 2017



**PORT GAMBLE BAY CLEANUP
 RECORD DRAWINGS**
SITE STAGING AND ACCESS

G-04
 SHEET NO. 6 OF 24

SCALE IN FEET
 0 200 400
 NORTH
 ONE INCH
 AT FULL SIZE, IF NOT ONE
 INCH SCALE ACCORDINGLY

RECORD DRAWINGS

THE PRECONSTRUCTION SURFACE WITHIN STOCKPILE AREAS CONTAINED EXPOSED HARDSCAPE. FOLLOWING REMOVAL OF THE STOCKPILES, ADDITIONAL AREAS OF UNDERLYING HARDSCAPE WERE IDENTIFIED AND ADDITIONAL UNKNOWN AREAS OF HARDSCAPE MAY EXIST.

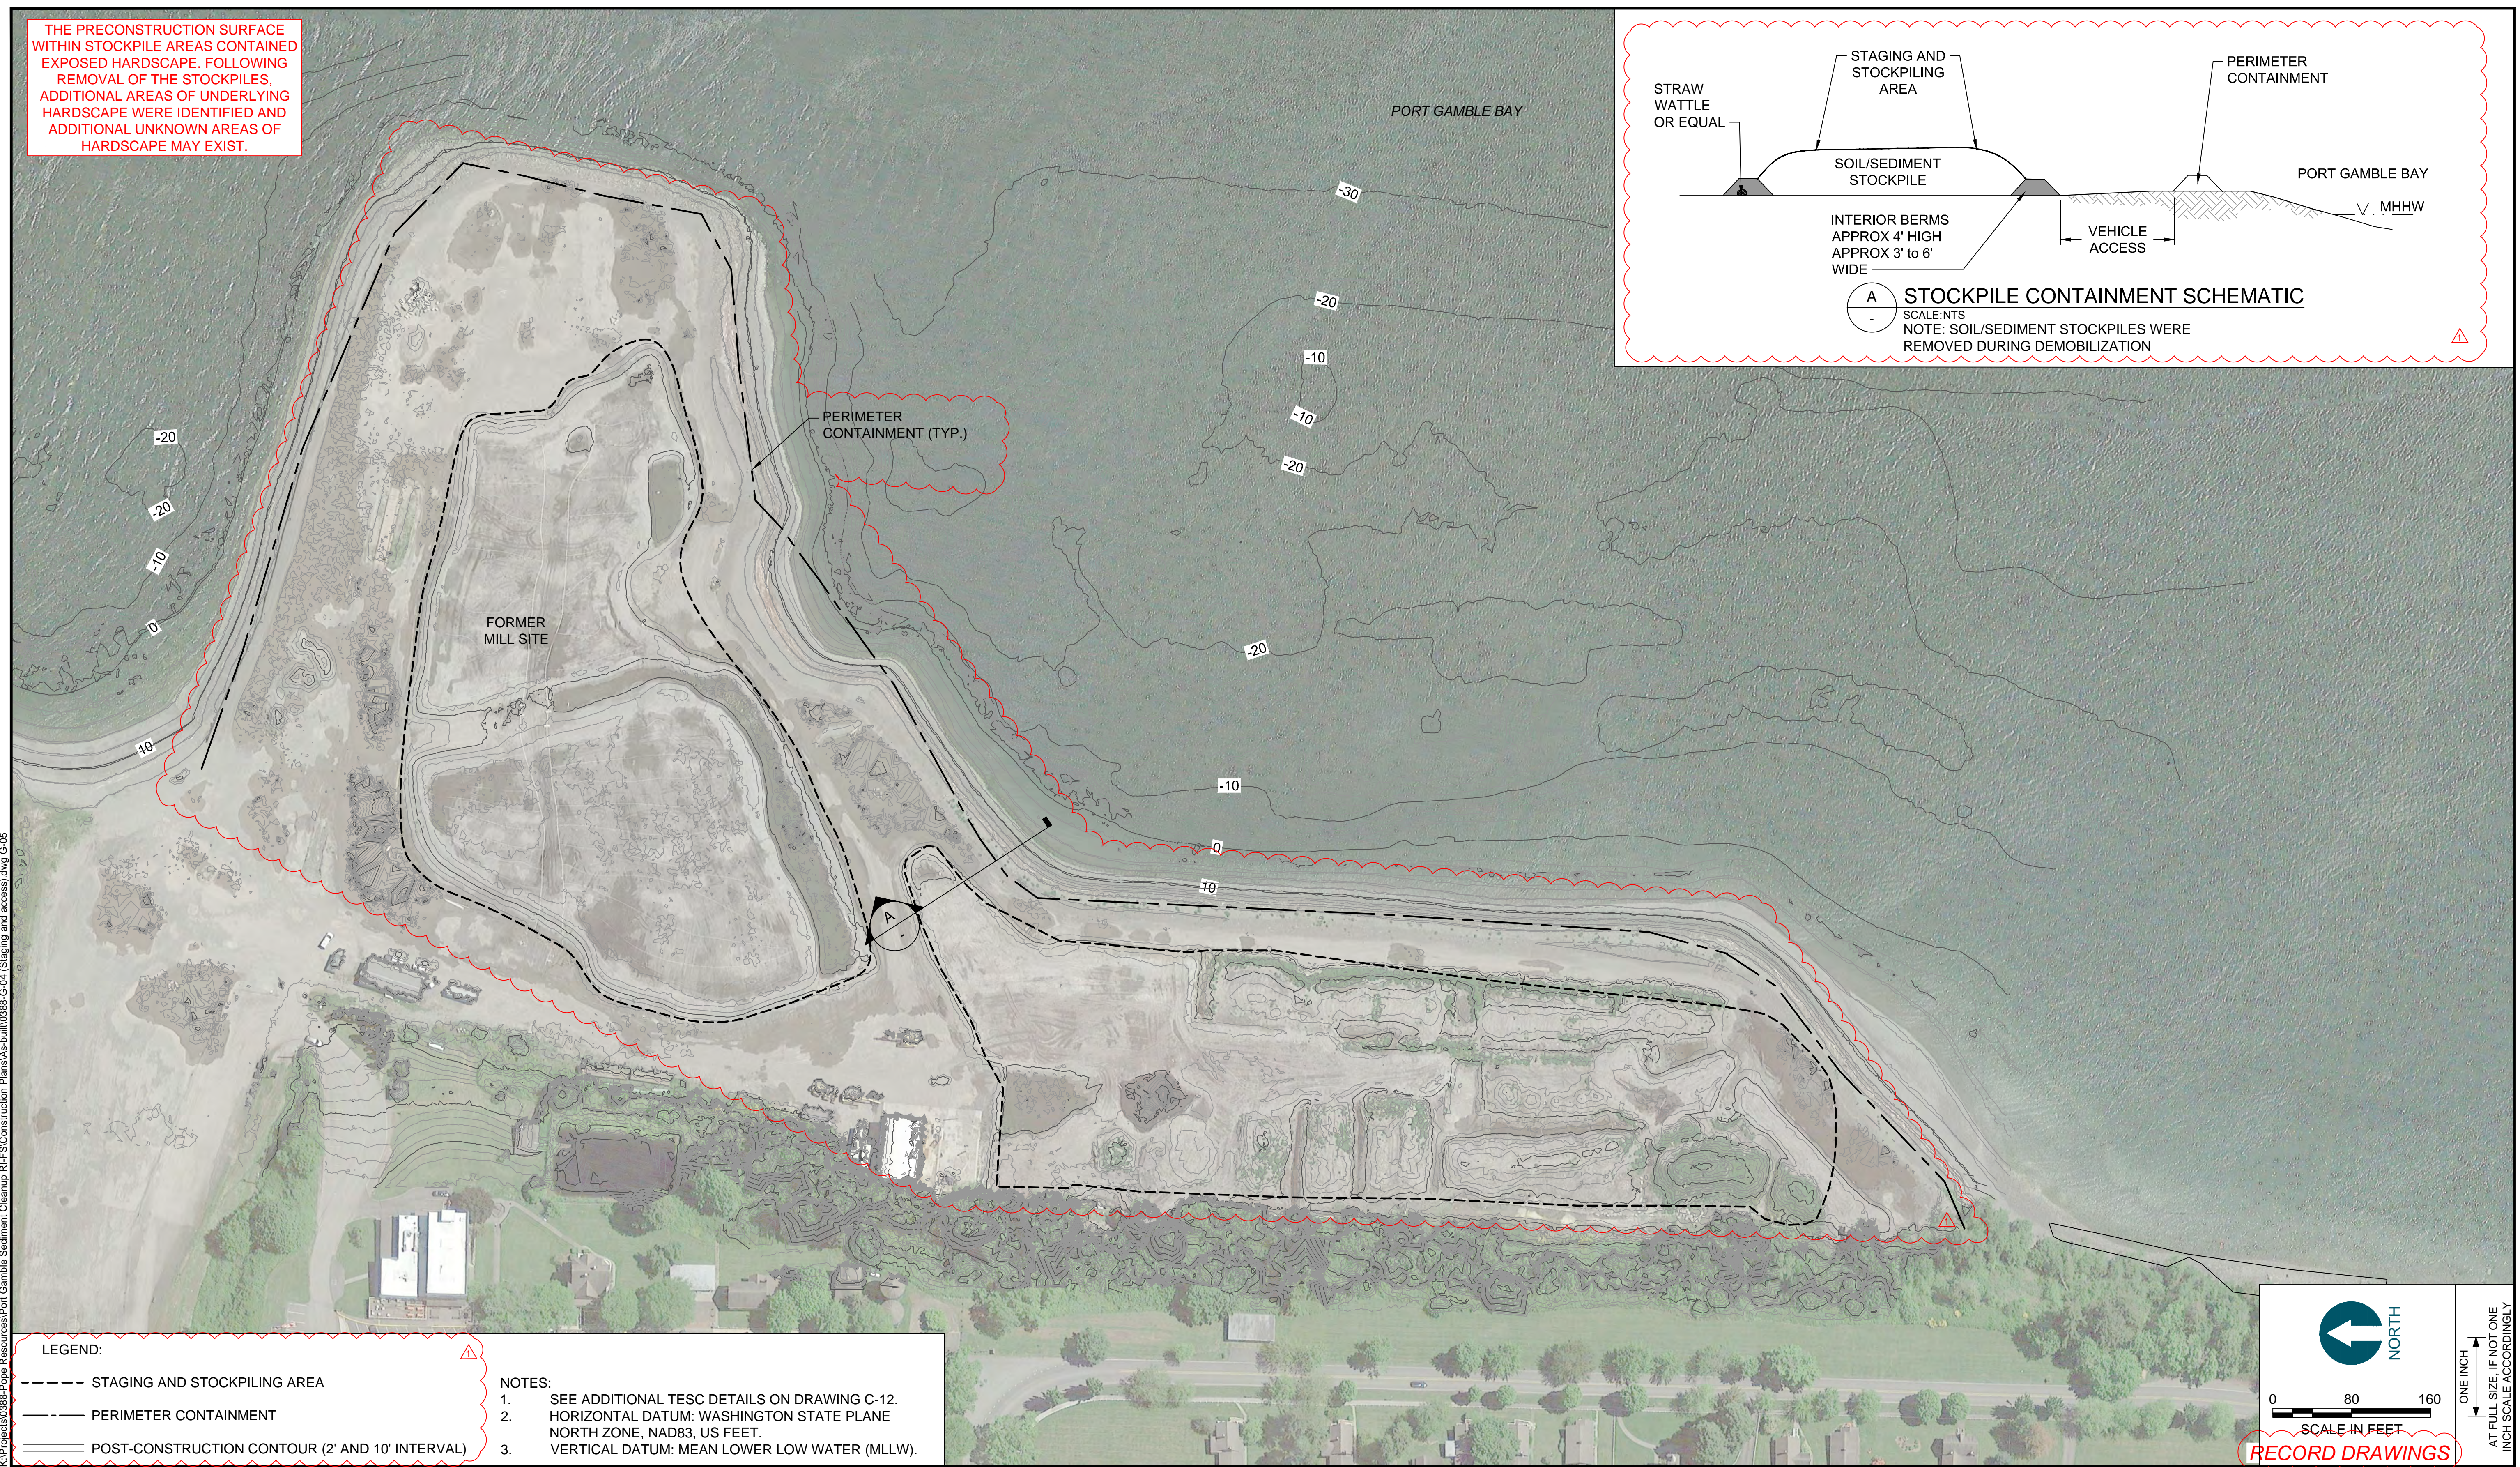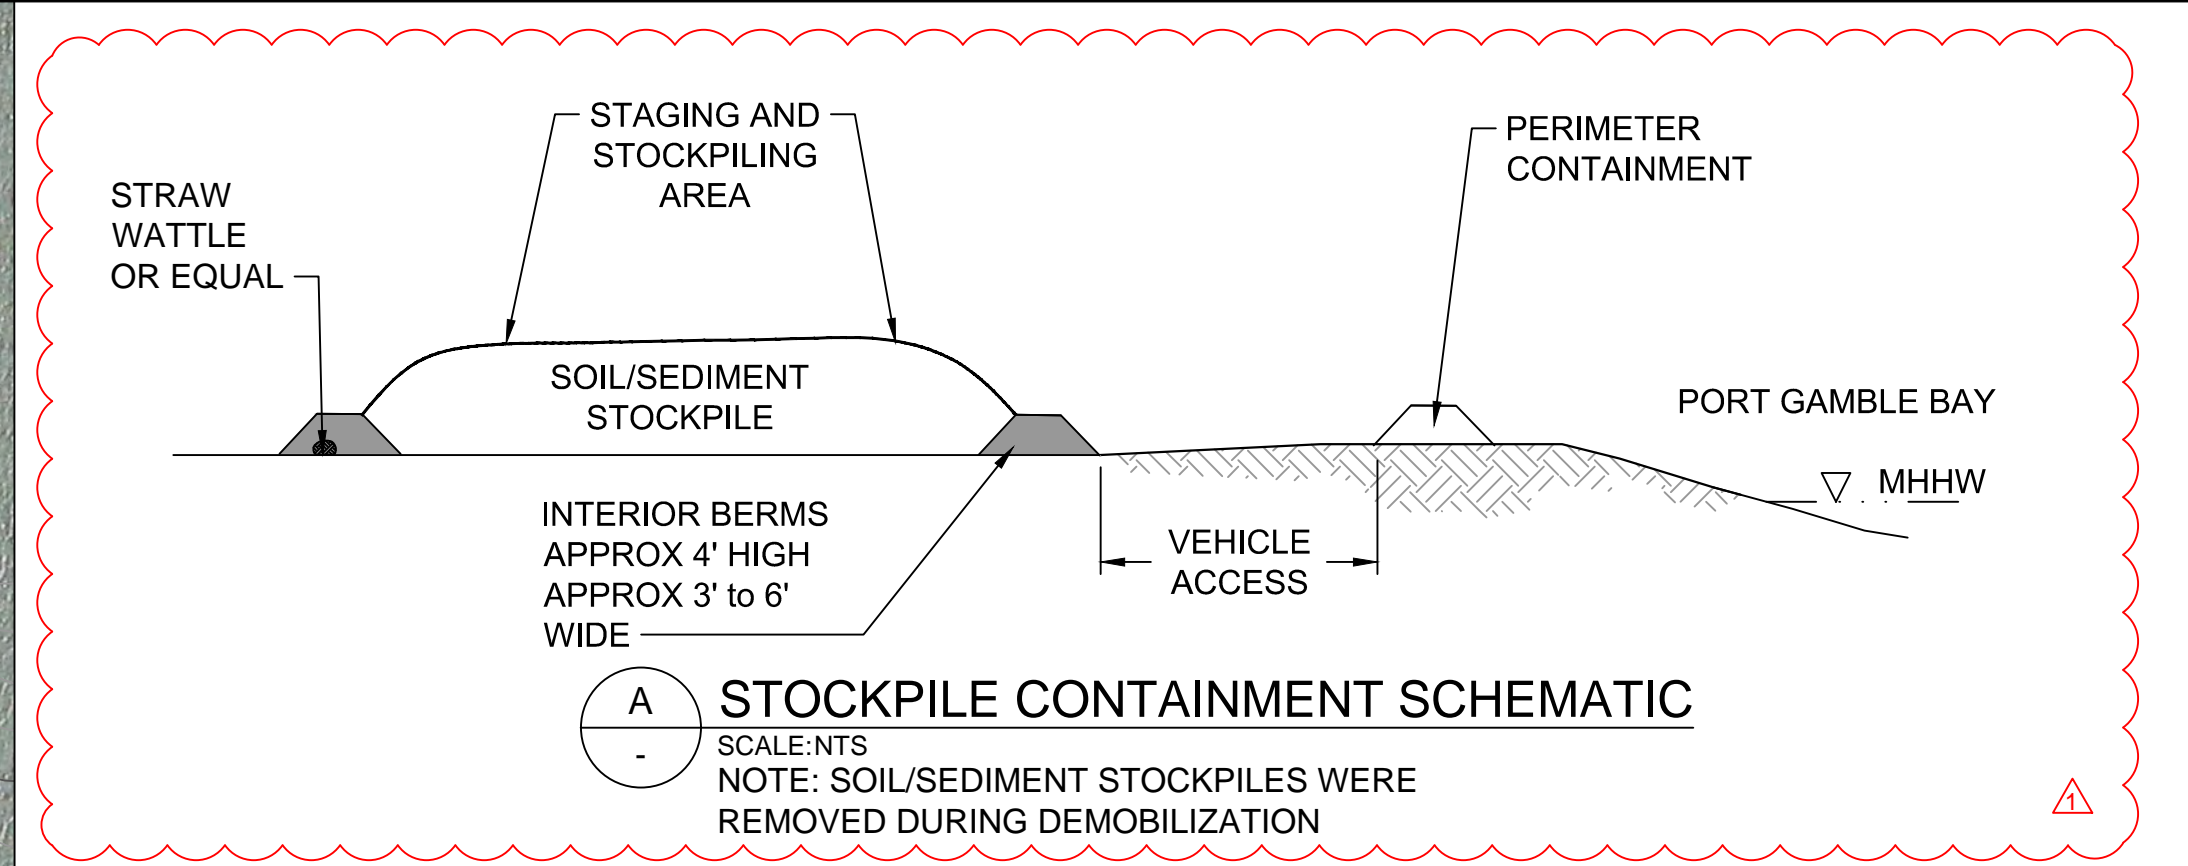

LEGEND:

- STAGING AND STOCKPILING AREA
- PERIMETER CONTAINMENT
- POST-CONSTRUCTION CONTOUR (2' AND 10' INTERVAL)

NOTES:

1. SEE ADDITIONAL TESC DETAILS ON DRAWING C-12.
2. HORIZONTAL DATUM: WASHINGTON STATE PLANE NORTH ZONE, NAD83, US FEET.
3. VERTICAL DATUM: MEAN LOWER LOW WATER (MLLW).

NORTH

0 80 160


SCALE IN FEET

RECORD DRAWINGS

ONE INCH
AT FULL SIZE, IF NOT ONE
INCH SCALE ACCORDINGLY



POPE RESOURCES LP / OPG PROPERTIES LLC

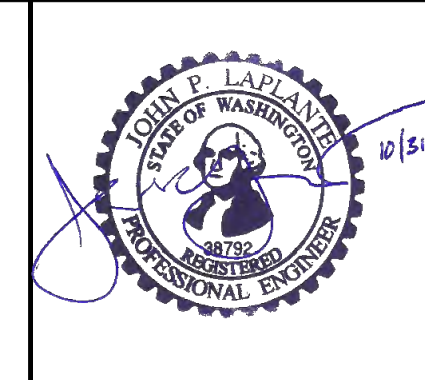

REVISIONS				
REV	DATE	BY	APP'D	DESCRIPTION
1	11/6/2017	CH	JL	RECORD DRAWINGS

DESIGNED BY: R. PICKERING
 DRAWN BY: C. HEWETT
 CHECKED BY: J. LAPLANTE
 APPROVED BY: J. LAPLANTE
 SCALE: 1" = X'
 DATE: OCTOBER 2017

**PORT GAMBLE BAY CLEANUP
 RECORD DRAWINGS**

STAGING AND STOCKPILING


G-05

SHEET NO. 7 OF 24

K:\Projects\0388-Pope Resources\Port Gamble Sediment Cleanup RFP\Construction Plans\As-Built\0388-C-04 (Staging and access).dwg G-05
 Jan 04, 2018 9:51am chewet

NO CHANGES TO THIS DRAWING

K:\Projects\0388-Pope Resources\Port Gamble Sediment Cleanup RFP\Construction Plans\As-built\0388-G-06 (Nav Lanes).dwg G-06

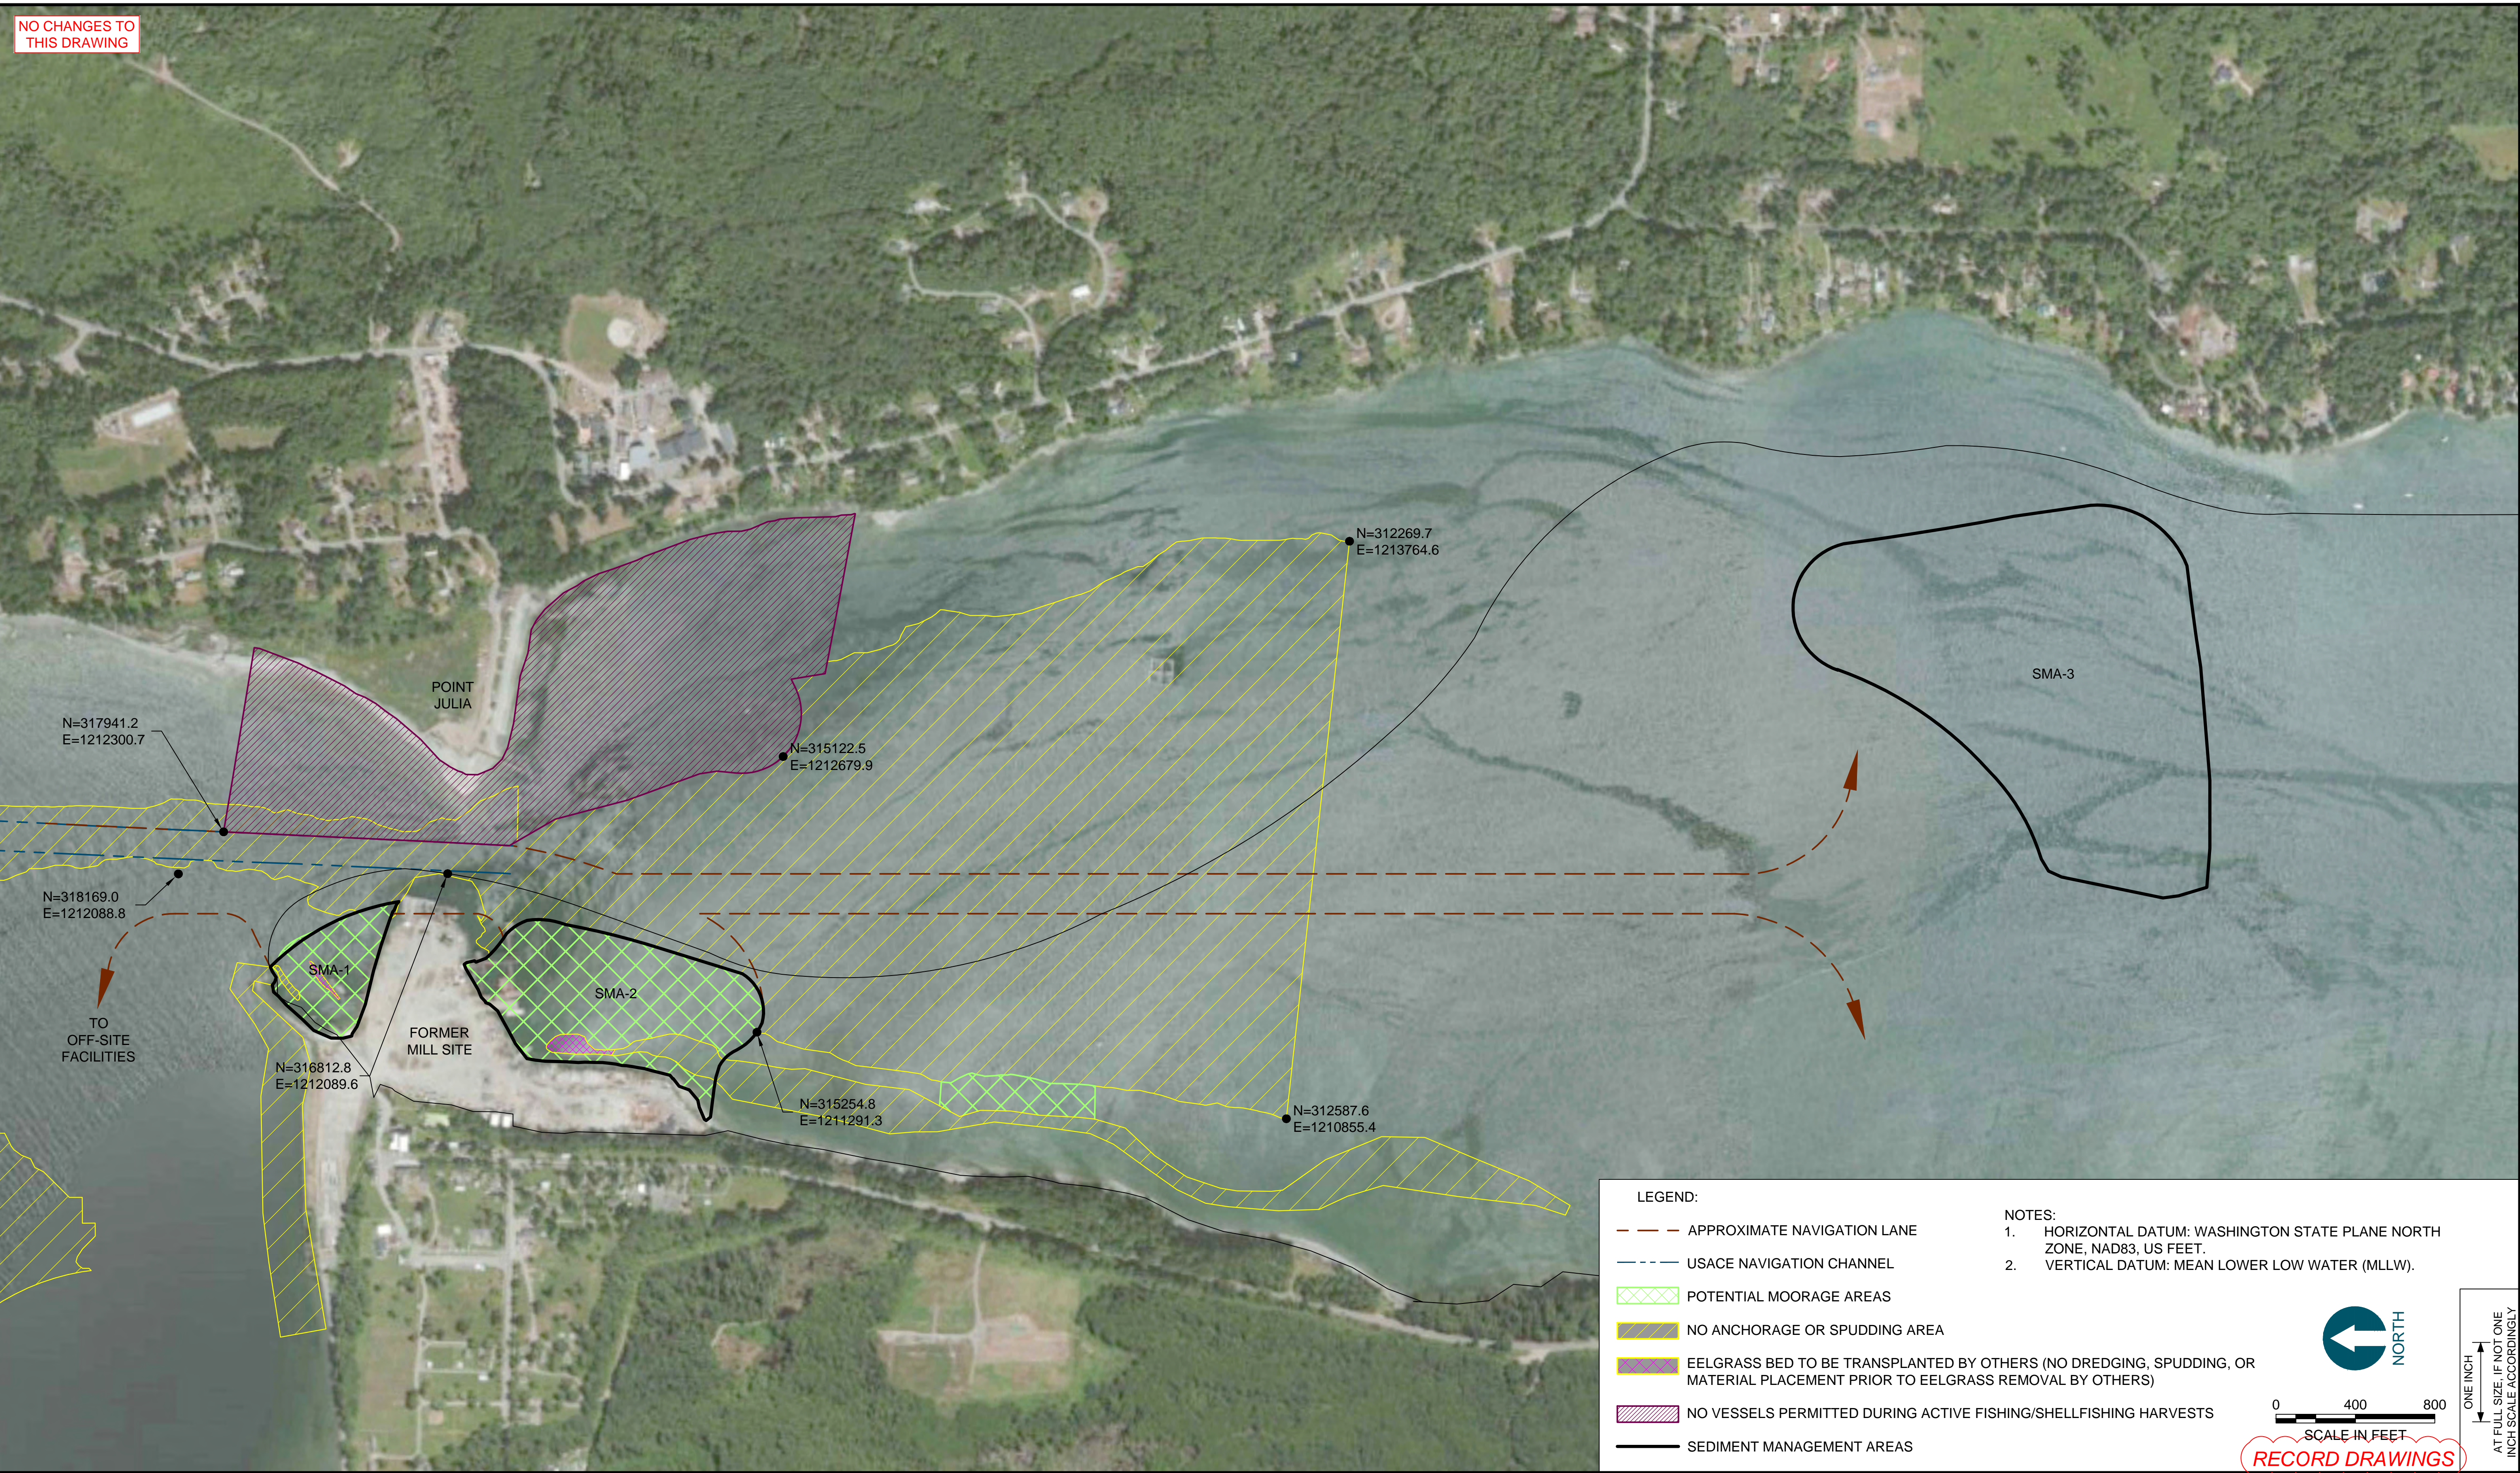

LEGEND:

- - - - - APPROXIMATE NAVIGATION LANE
- - - - - USACE NAVIGATION CHANNEL
- [Green Hatched Box] POTENTIAL MOORAGE AREAS
- [Yellow Hatched Box] NO ANCHORAGE OR SPUDDING AREA
- [Purple Hatched Box] EELGRASS BED TO BE TRANSPLANTED BY OTHERS (NO DREDGING, SPUDDING, OR MATERIAL PLACEMENT PRIOR TO EELGRASS REMOVAL BY OTHERS)
- [Pink Hatched Box] NO VESSELS PERMITTED DURING ACTIVE FISHING/SHELLFISHING HARVESTS
- [Black Outline] SEDIMENT MANAGEMENT AREAS

NOTES:

1. HORIZONTAL DATUM: WASHINGTON STATE PLANE NORTH ZONE, NAD83, US FEET.
2. VERTICAL DATUM: MEAN LOWER LOW WATER (MLLW).

SCALE IN FEET: 0 400 800

SCALE: 1" = 400'

DATE: OCTOBER 2017

RECORD DRAWINGS



POPE RESOURCES LP / OPG PROPERTIES LLC



REVISIONS				
REV	DATE	BY	APP'D	DESCRIPTION
1	11/6/2017	CH	JL	RECORD DRAWINGS

DESIGNED BY: R. PICKERING
 DRAWN BY: C. HEWETT
 CHECKED BY: J. LAPLANTE
 APPROVED BY: J. LAPLANTE
 SCALE: 1" = 400'
 DATE: OCTOBER 2017

**PORT GAMBLE BAY CLEANUP
RECORD DRAWINGS**

VESSEL NAVIGATION LANES

G-06

SHEET NO. 8 OF 24

Jan 04, 2018 9:51am chawett



PHOTO 1: LOG TRANSFER DOCK



PHOTO 2: EASTERN WHARF



PHOTO 3: CONVEYOR/PIER (FROM BING MAPS IMAGERY)



PHOTO 4: ALDER CHIP MILL

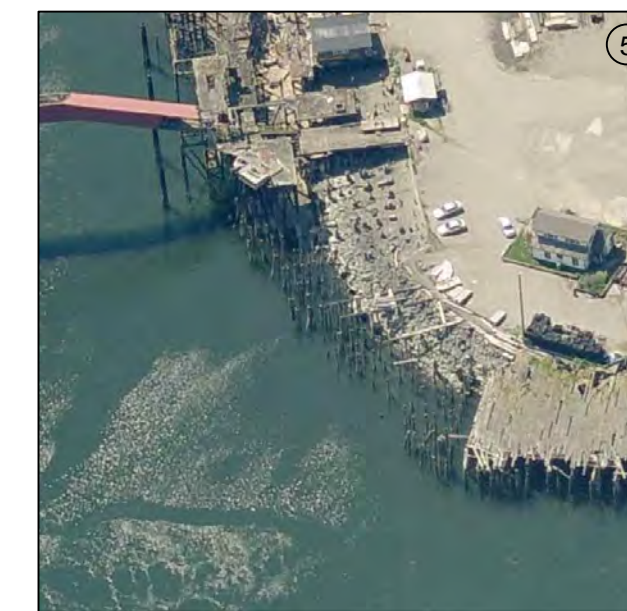


PHOTO 5: SHORELINE BETWEEN WHARF AND ALDER CHIP MILL



PHOTO 6: PIER 4



PHOTO 7: PIER 5 AND SHORELINE BULKHEADS



PHOTO 8: PIER 4 AND PIER 5




PHOTO 9: BREAKWATER

NOTES:

1. DEMOLISH AND DISPOSE ALL CREOSOTE DECKING, TIMBER STRUCTURES AND BULKHEADS. CONCRETE AND METAL MATERIAL MAY BE SALVAGED AND REUSED PER THE SPECIFICATIONS.
2. EXTRACT ALL CREOSOTE PILING PER THE SPECIFICATIONS OR AS APPROVED BY ECOLOGY.
3. PILE LOCATIONS ARE APPROXIMATE AND WERE DEVELOPED FROM BATHYMETRIC SURVEYS, AERIAL PHOTOGRAPHS, VISUAL OBSERVATIONS AND TEST PITS, AND PRIOR DREDGING EXPERIENCE AT THE SITE, AND MAY NOT REPRESENT THE TOTAL PILING ENCOUNTERED DURING THE CLEANUP WORK.
4. CONTAIN ALL DEBRIS DURING DEMOLITION WITH A FLOATING BOOM.
5. DO NOT CUT PILES WHILE ON THE WATER. PILES THAT NEED TO BE RE-SIZED AFTER PULLING SHALL ONLY BE CUT ON THE UPLAND PROPERTY.
6. DEMOLISH OR PERFORATE IMPERMEABLE SURFACES WITHIN THE STAGING AND STOCKPILE PERIMETER CONTAINMENT TO ALLOW FOR INFILTRATION OF INTERSTITIAL WATER FROM SEDIMENTS AND RAINFALL.
7. REMOVE SURFICIAL CONCRETE AND ASPHALT DEBRIS FROM INTERTIDAL AREAS DURING PILE DEMOLITION.
8. HORIZONTAL DATUM: WASHINGTON STATE PLANE NORTH ZONE, NAD83, US FEET.
9. VERTICAL DATUM: MEAN LOWER LOW WATER (MLLW).

SIGNIFICANT QUANTITIES OF INTERTIDAL AND SUBTIDAL PILES WERE ENCOUNTERED DURING CONSTRUCTION THAT ARE NOT SHOWN ON THESE DRAWINGS

ALL STRUCTURES AND PILING REMOVED PER THE DRAWINGS AND SPECIFICATIONS. SEE AERIAL ON DRAWING G-05 FOR POST-DEMOLITION CONDITIONS

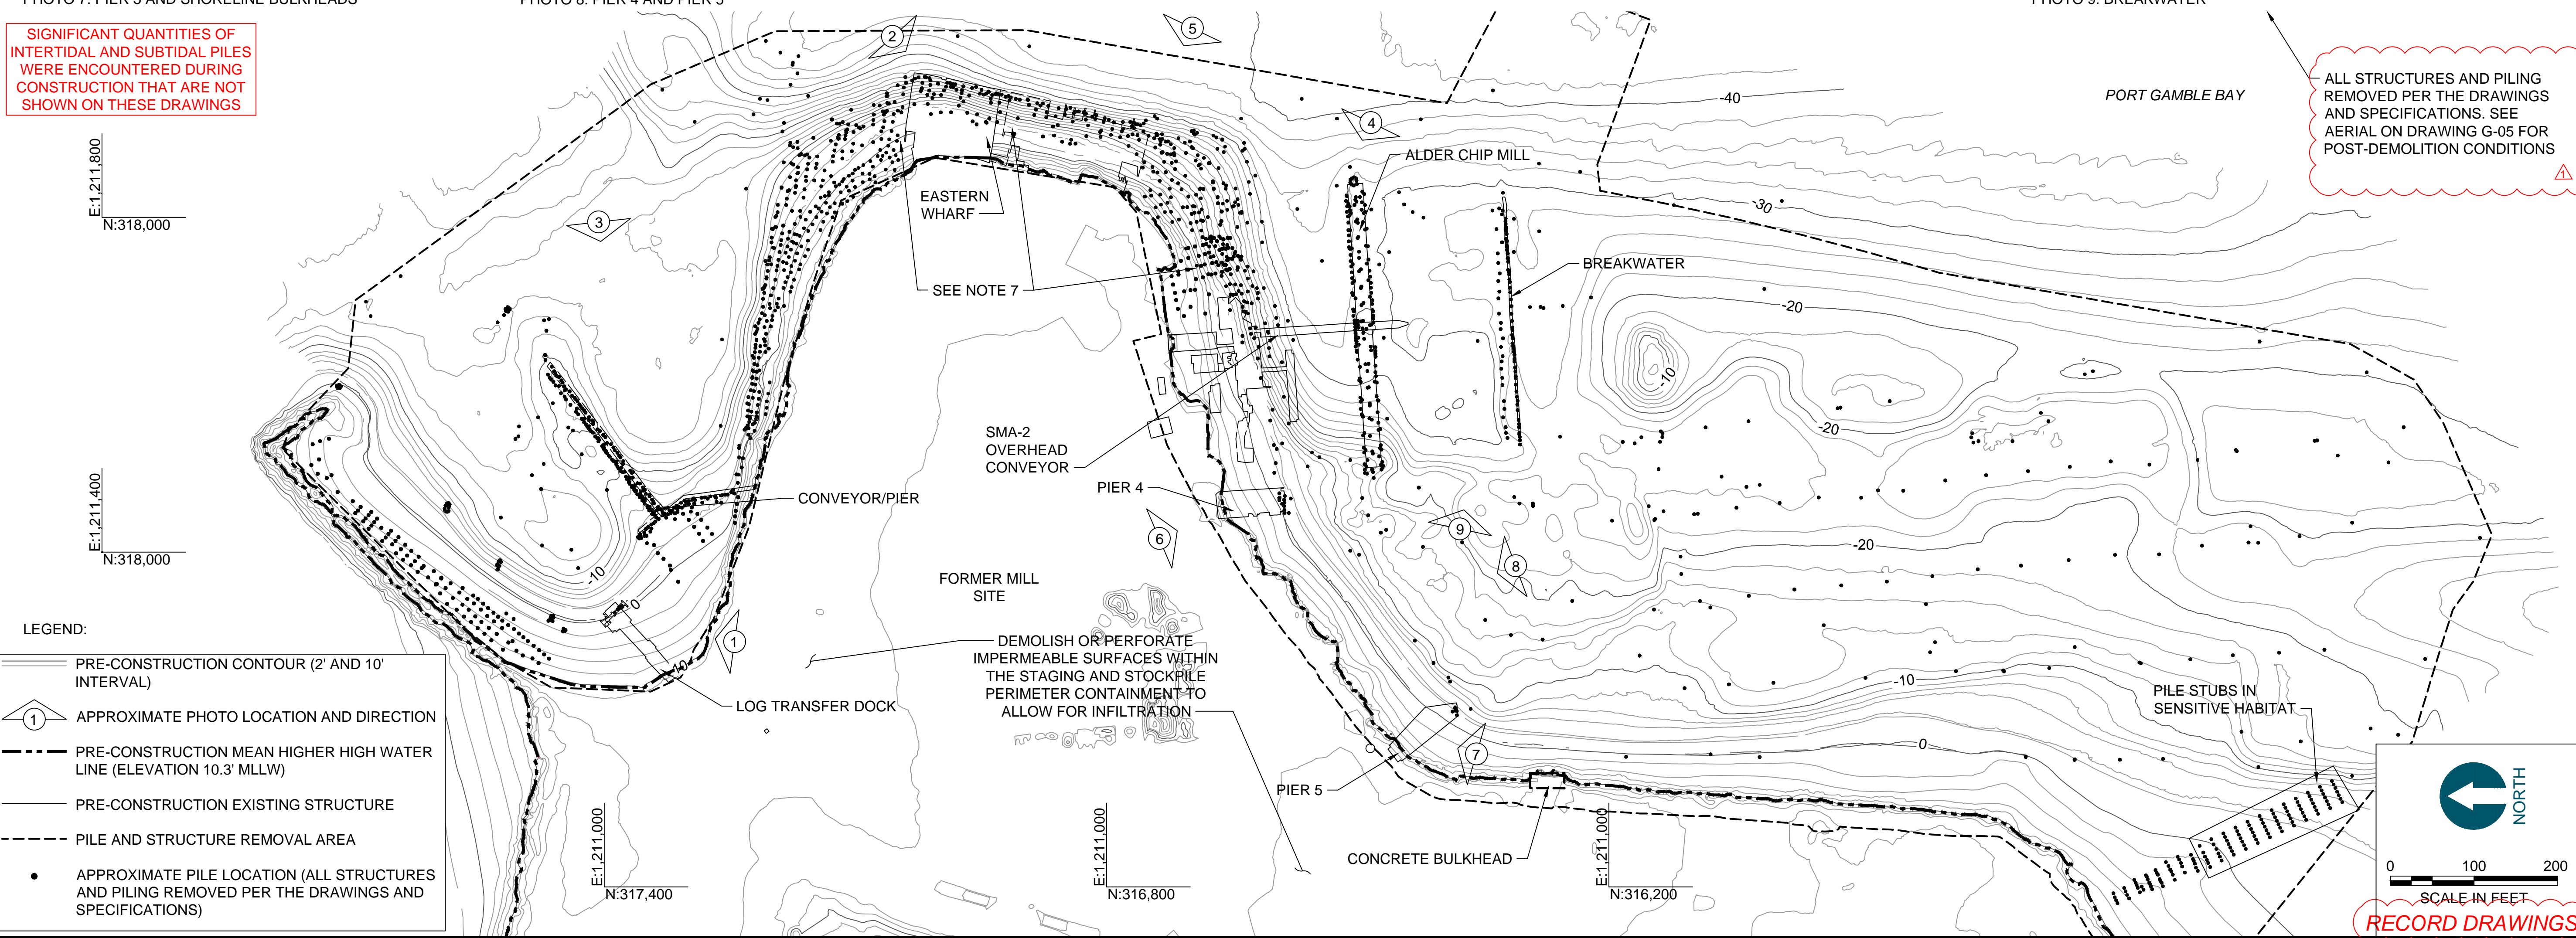

K:\Projects\0388-Pope Resources\Port Gamble\Staircase Cleanup\RFI\Construction Plans\As-built\0388-D-01 (Demolition Plan).dwg D-01

LEGEND:

- PRE-CONSTRUCTION CONTOUR (2' AND 10' INTERVAL)
- ① APPROXIMATE PHOTO LOCATION AND DIRECTION
- - - PRE-CONSTRUCTION MEAN HIGHER HIGH WATER LINE (ELEVATION 10.3' MLLW)
- PRE-CONSTRUCTION EXISTING STRUCTURE
- - - PILE AND STRUCTURE REMOVAL AREA
- APPROXIMATE PILE LOCATION (ALL STRUCTURES AND PILING REMOVED PER THE DRAWINGS AND SPECIFICATIONS)


SCALE IN FEET
0 100 200
SCALE: 1" = 100'
DATE: OCTOBER 2017

SCALE IN INCH
ONE INCH
AT FULL SIZE, IF NOT ONE INCH SCALE ACCORDINGLY

RECORD DRAWINGS



POPE RESOURCES LP / OPG PROPERTIES LLC

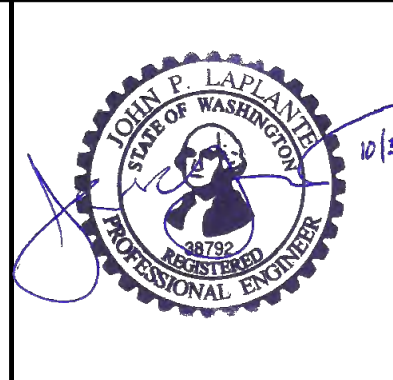

REVISIONS				
REV	DATE	BY	APP'D	DESCRIPTION
1	11/6/2017	CH	JL	RECORD DRAWINGS

DESIGNED BY: R. PICKERING
 DRAWN BY: C. HEWETT
 CHECKED BY: J. LAPLANTE
 APPROVED BY: J. LAPLANTE
 SCALE: 1" = 100'
 DATE: OCTOBER 2017

PORT GAMBLE BAY CLEANUP
 RECORD DRAWINGS

DEMOLITION PLAN (1 OF 2)
 STRUCTURES AND PILING

D-01

SHEET NO. 9 OF 24


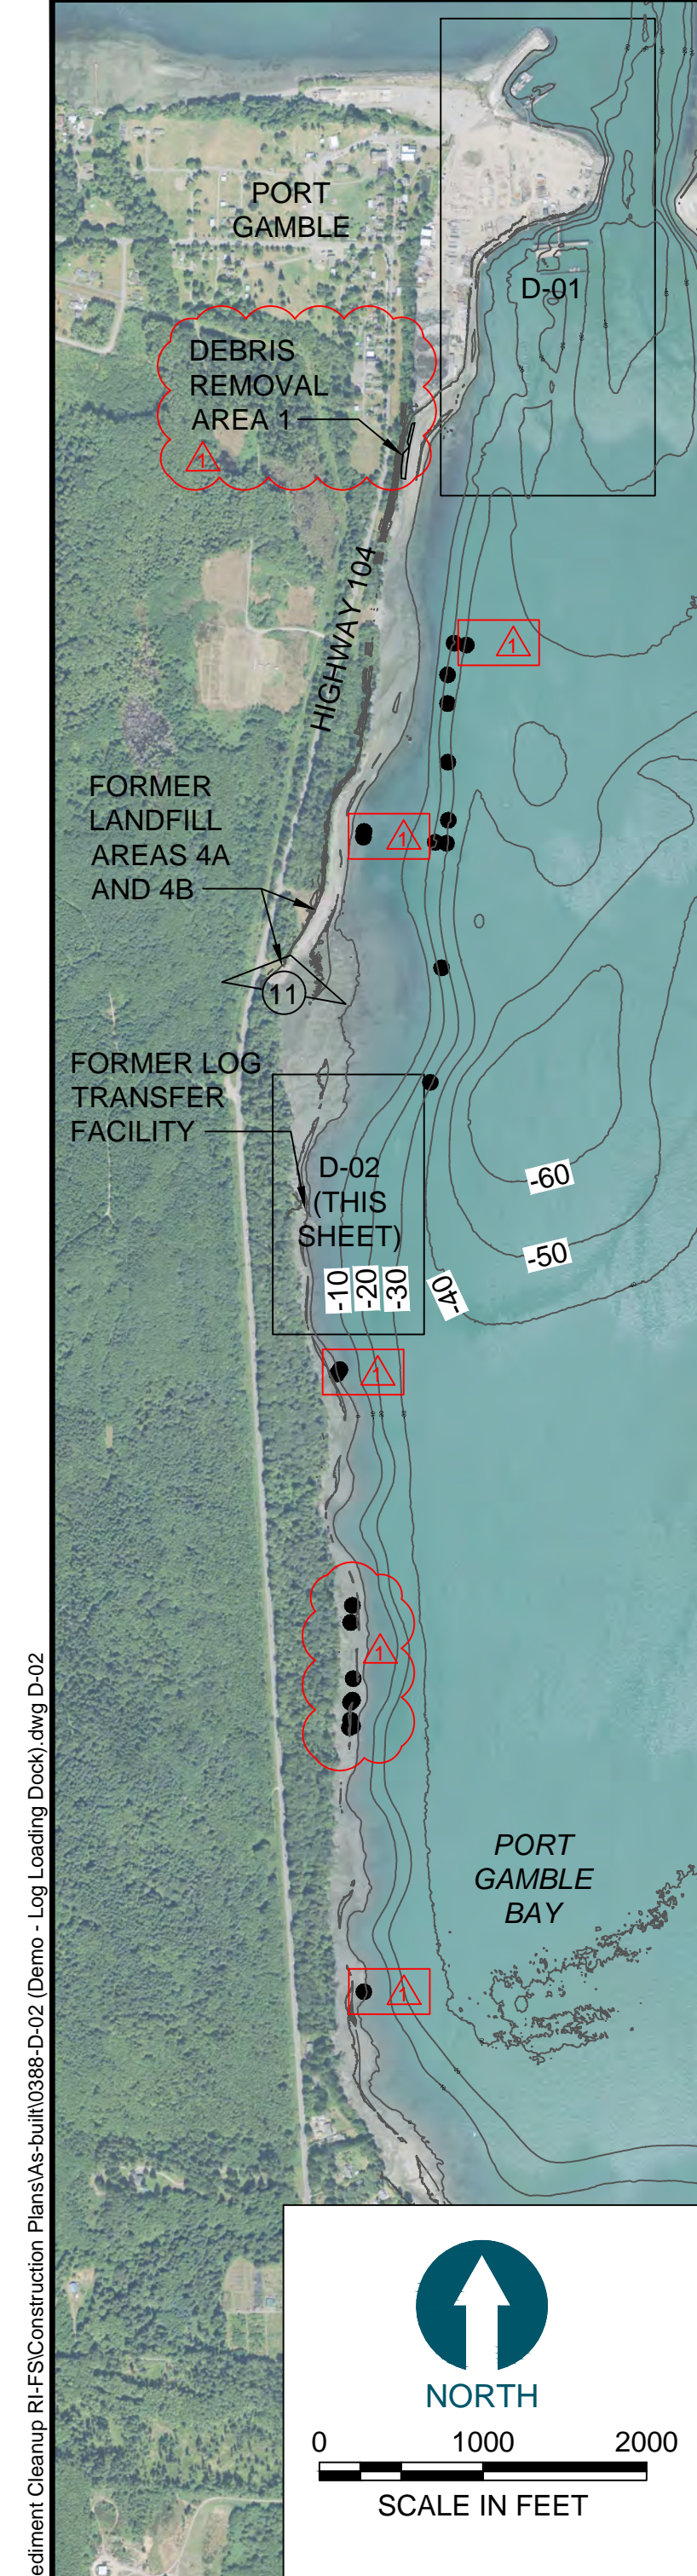


PHOTO 10: FORMER LOG TRANSFER FACILITY (FROM BING MAPS IMAGERY)




PHOTO 11: LANDFILL 4A AND 4B SURFICIAL BEACH DEBRIS

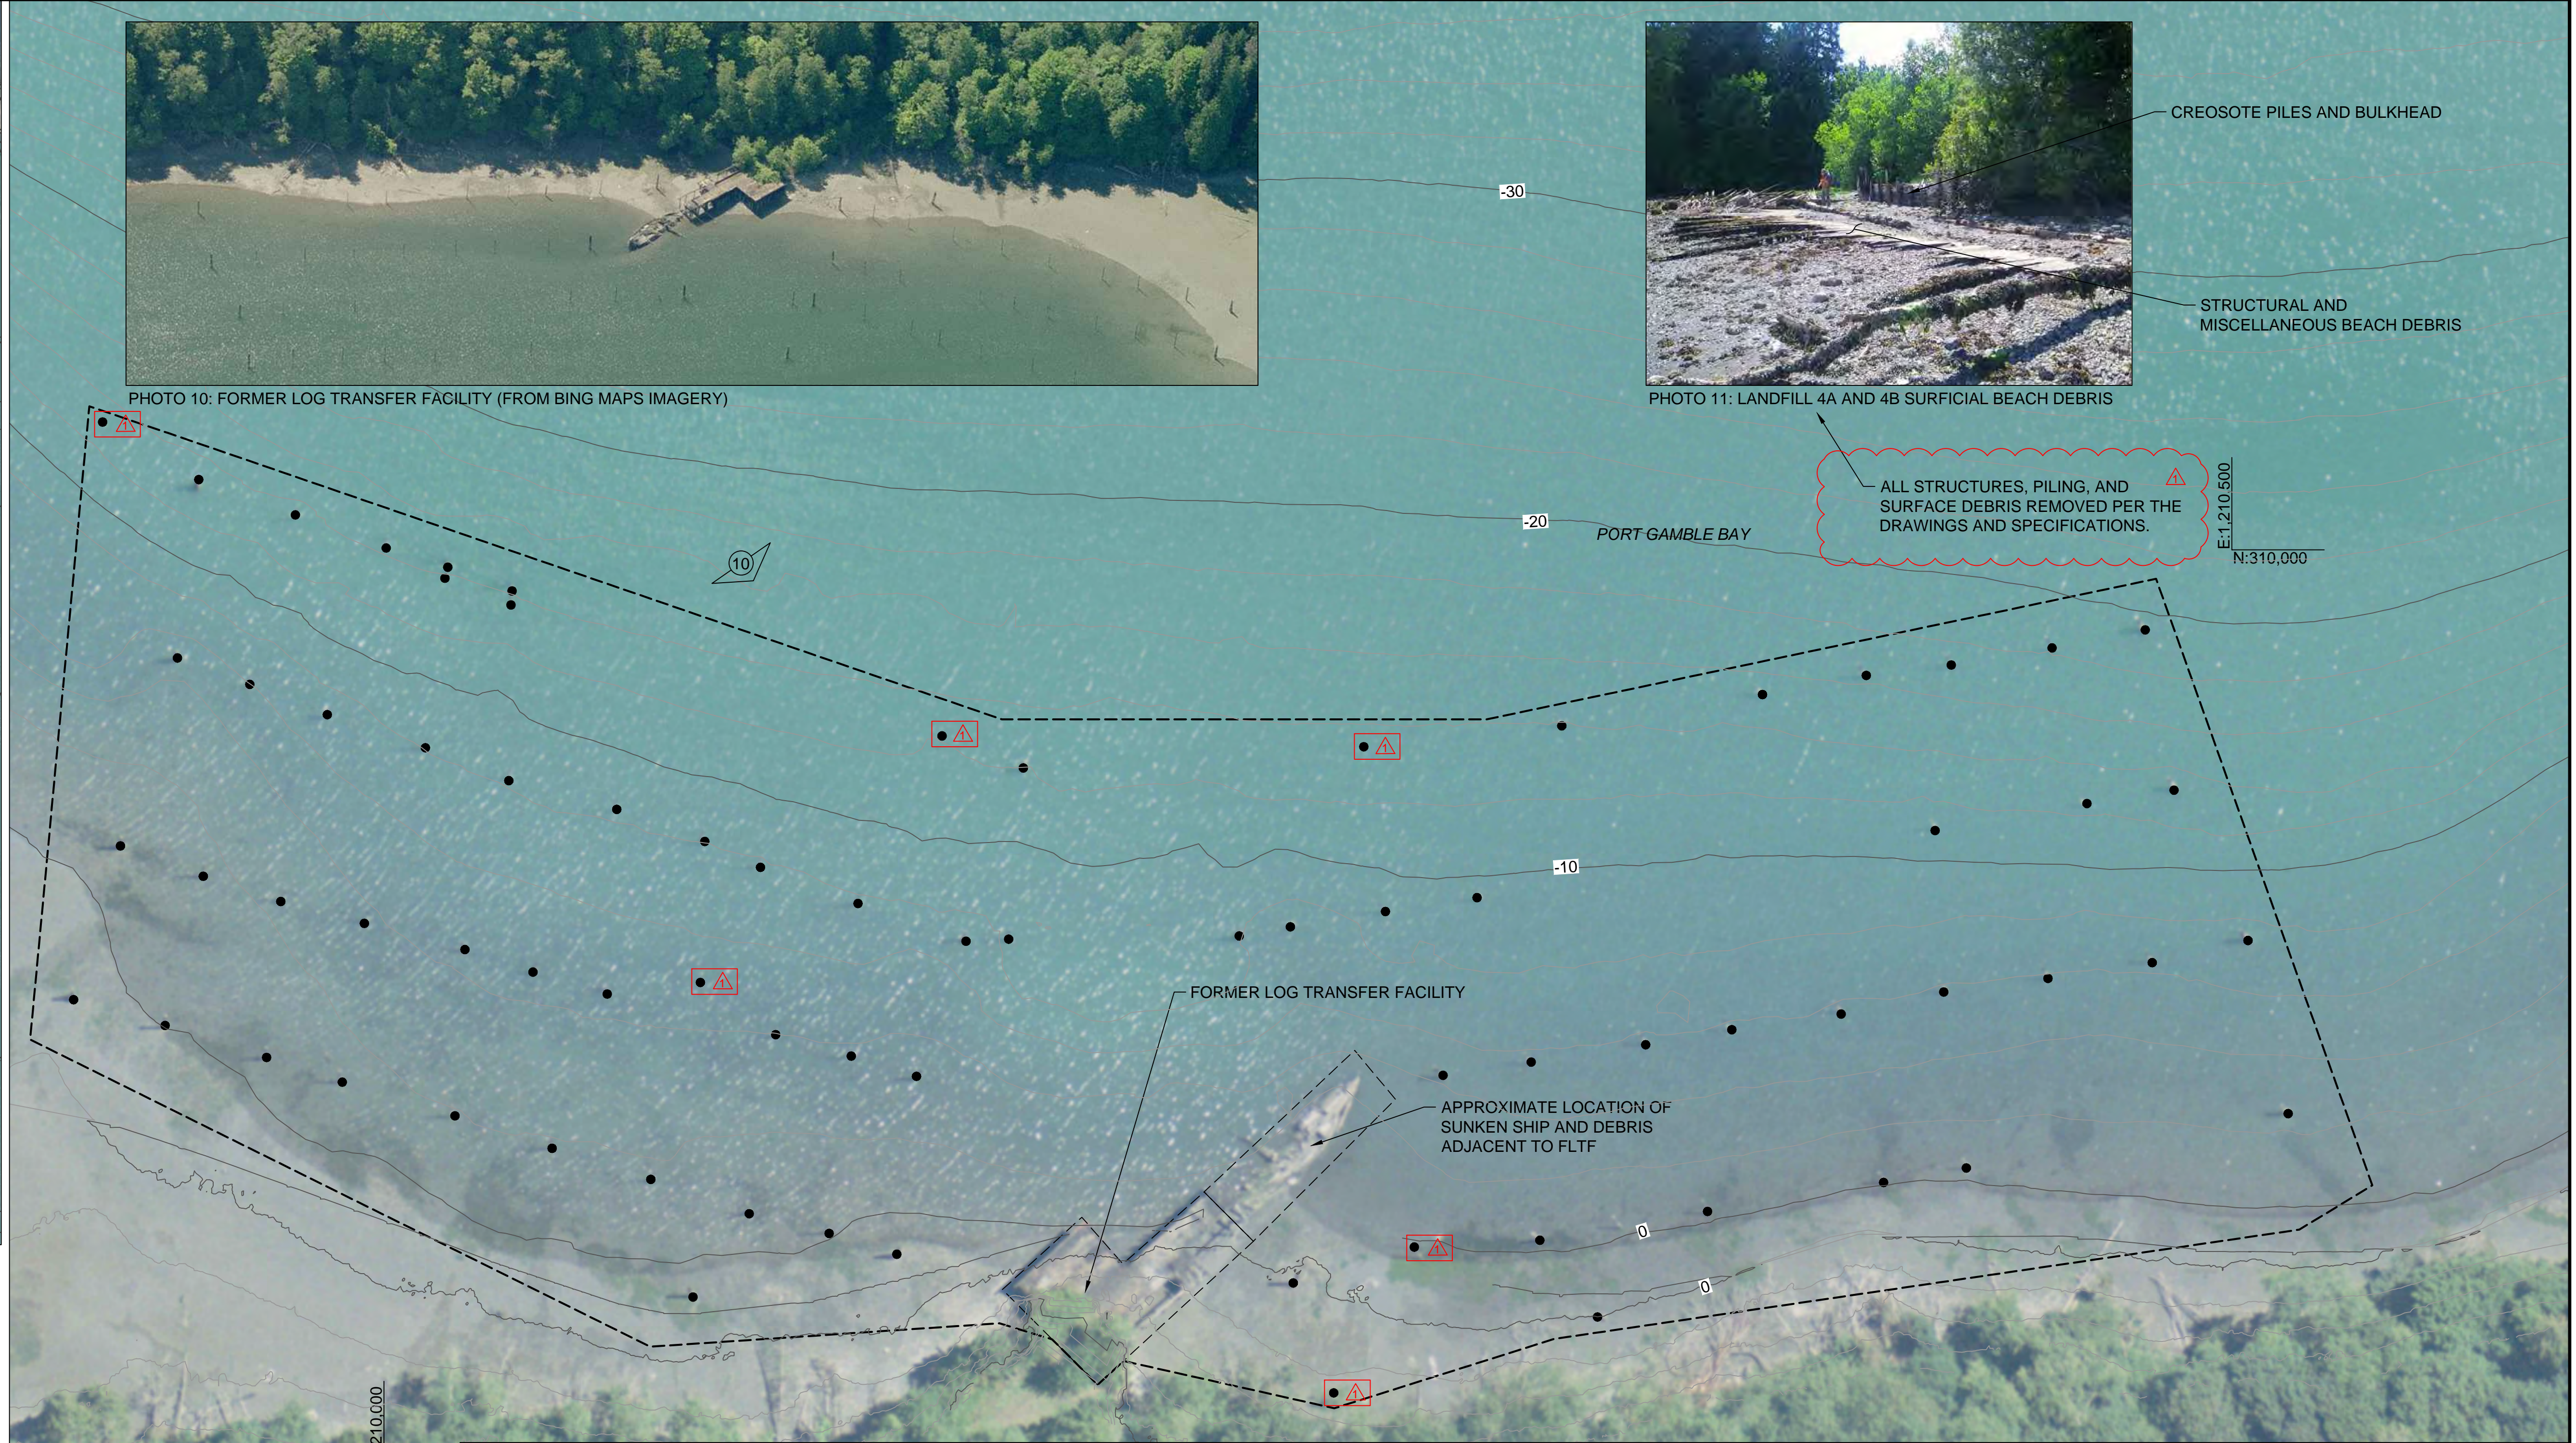


SIGNIFICANT QUANTITIES OF INTERTIDAL AND SUBTIDAL PILES WERE ENCOUNTERED DURING CONSTRUCTION THAT ARE NOT SHOWN ON THESE DRAWINGS. REVISION CLOUD AROUND PILES INDICATES ADDITIONAL PILING TARGET LOCATIONS ADDED BY DEPARTMENT OF ECOLOGY.

- LEGEND:**
- PILE AND STRUCTURE REMOVAL AREA
 - APPROXIMATE PILE LOCATION (ALL STRUCTURES AND PILING REMOVED PER THE PLANS AND SPECIFICATIONS)
 - PRE-CONSTRUCTION CONTOUR (2' AND 10' INTERVAL)

- NOTES:**
1. DEMOLISH AND DISPOSE ALL CREOSOTE DECKING, TIMBER STRUCTURES AND BULKHEADS. CONCRETE AND METAL MATERIAL MAY BE SALVAGED AND REUSED PER THE SPECIFICATIONS.
 2. EXTRACT ALL CREOSOTE PILING PER THE SPECIFICATIONS OR AS APPROVED BY ECOLOGY.
 3. PILE LOCATIONS ARE APPROXIMATE AND WERE DEVELOPED FROM BATHYMETRIC SURVEYS, AERIAL PHOTOGRAPHS, VISUAL OBSERVATIONS AND TEST PITS, AND PRIOR DREDGING EXPERIENCE AT THE SITE, AND MAY NOT REPRESENT THE TOTAL PILING ENCOUNTERED DURING THE CLEANUP WORK.
 4. CONTAIN ALL DEBRIS DURING DEMOLITION WITH A FLOATING BOOM.
 5. DO NOT CUT PILES WHILE ON THE WATER. PILES THAT NEED TO BE RE-SIZED AFTER PULLING SHALL ONLY BE CUT ON THE UPLAND PROPERTY.
 6. REMOVE AND DISPOSE SUNKEN SHIP AND RELATED DEBRIS ADJACENT TO THE FORMER LOG TRANSFER FACILITY.
 7. REMOVE AND DISPOSE ALL SURFICIAL BEACH DEBRIS, CREOSOTE TIMBER, AND PILING WITHIN FORMER LANDFILL 4A AND 4B BEACH AREAS.
 8. BATHYMETRY FROM ETRAC, DATED AUGUST 27, 2014, AND ECOLOGY, DATED MARCH 2015.
 9. HORIZONTAL DATUM: WASHINGTON STATE PLANE NORTH ZONE, NAD83, US FEET.
 10. VERTICAL DATUM: MEAN LOWER LOW WATER (MLLW).

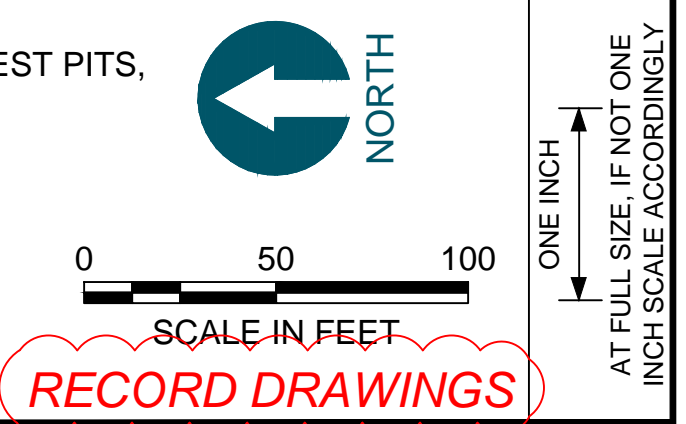

POPE RESOURCES LP / OPG PROPERTIES LLC

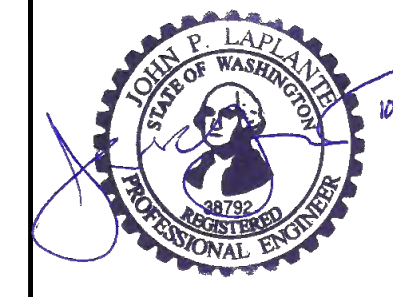

REVISIONS				
REV	DATE	BY	APP'D	DESCRIPTION
1	11/6/2017	CH	JL	RECORD DRAWINGS

DESIGNED BY: R. PICKERING
 DRAWN BY: C. HEWETT
 CHECKED BY: J. LAPLANTE
 APPROVED BY: J. LAPLANTE
 SCALE: 1" = 50'
 DATE: OCTOBER 2017


**PORT GAMBLE BAY CLEANUP
 RECORD DRAWINGS**

**DEMOLITION PLAN (2 OF 2)
 STRUCTURES AND PILING**

D-02

SHEET NO. 10 OF 24

K:\Projects\0388-Pope Resources\Port Gamble Sediment Cleanup RFP\Construction Plans\As-built\0388-D-02 (Demo - Log Loading Deck).dwg D-02 Jan 04, 2018 9:52am chewett

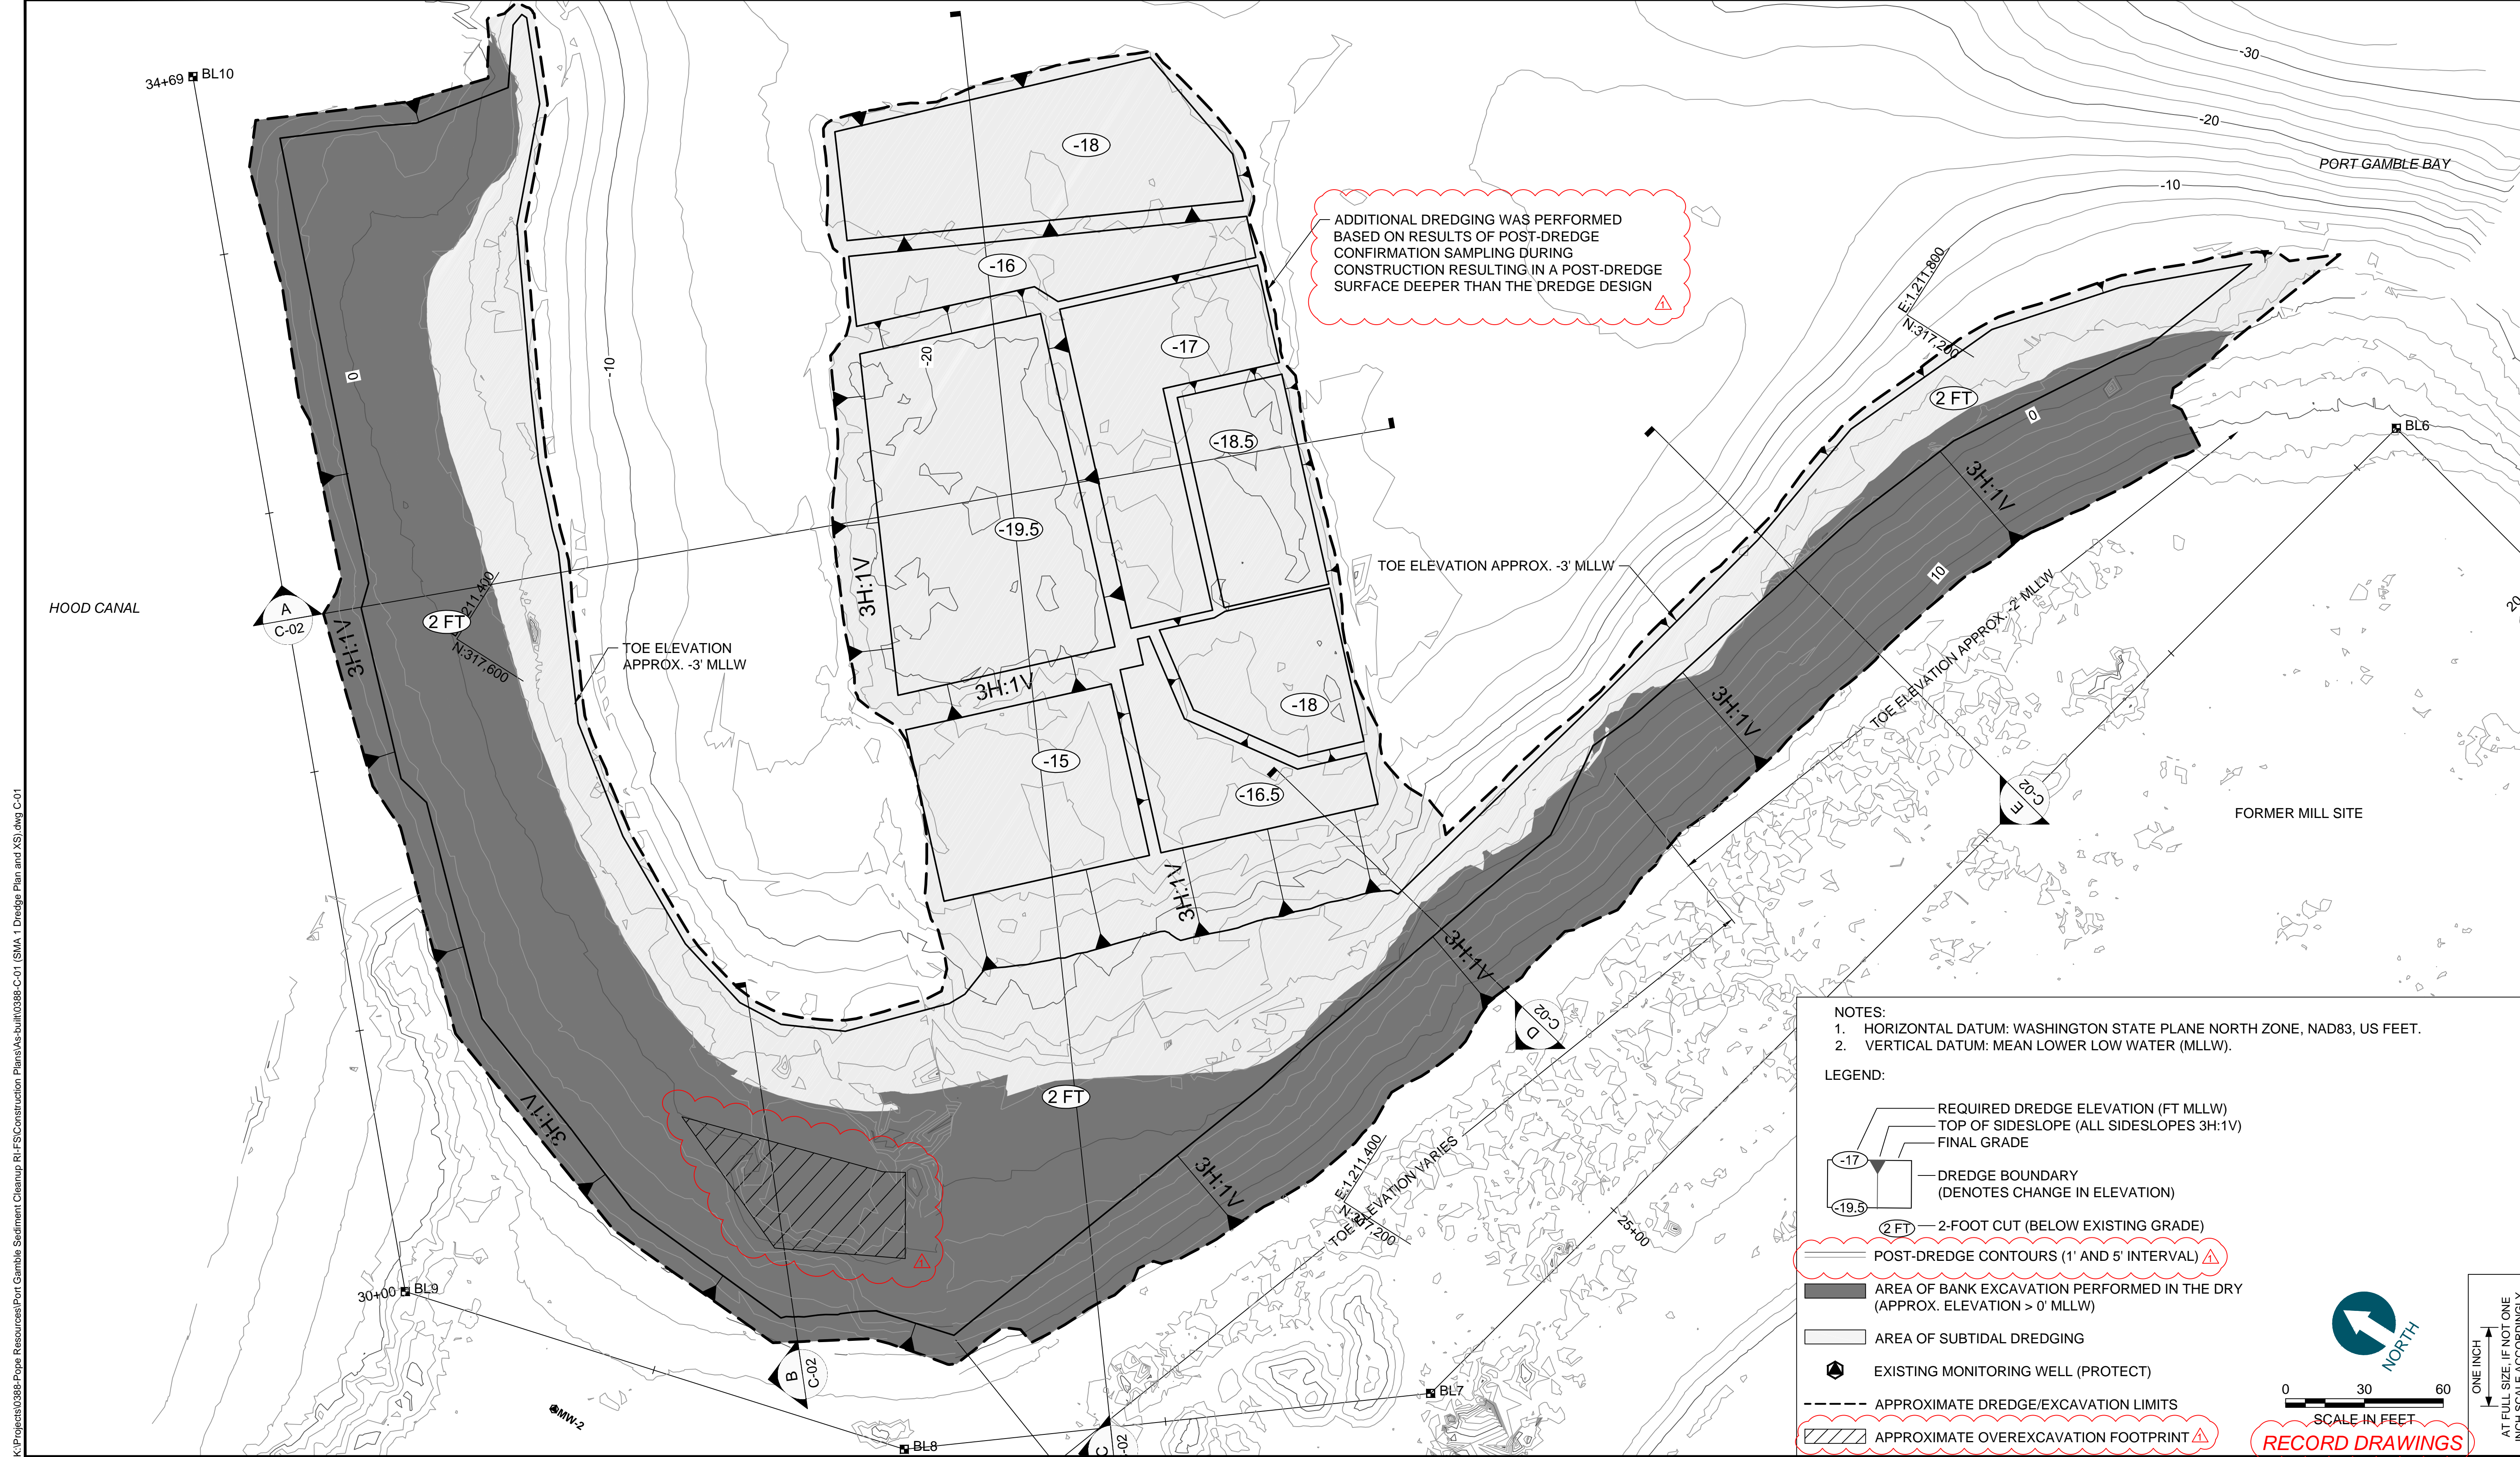

ADDITIONAL DREDGING WAS PERFORMED BASED ON RESULTS OF POST-DREDGE CONFIRMATION SAMPLING DURING CONSTRUCTION RESULTING IN A POST-DREDGE SURFACE DEEPER THAN THE DREDGE DESIGN

- NOTES:
- HORIZONTAL DATUM: WASHINGTON STATE PLANE NORTH ZONE, NAD83, US FEET.
 - VERTICAL DATUM: MEAN LOWER LOW WATER (MLLW).

- LEGEND:
- REQUIRED DREDGE ELEVATION (FT MLLW)
 - TOP OF SIDESLOPE (ALL SIDESLOPES 3H:1V)
 - FINAL GRADE
 - -17 □ -19.5 — DREDGE BOUNDARY (DENOTES CHANGE IN ELEVATION)
 - ② FT — 2-FOOT CUT (BELOW EXISTING GRADE)
 - POST-DREDGE CONTOURS (1' AND 5' INTERVAL)
 - AREA OF BANK EXCAVATION PERFORMED IN THE DRY (APPROX. ELEVATION > 0' MLLW)
 - AREA OF SUBTIDAL DREDGING
 - ⊕ EXISTING MONITORING WELL (PROTECT)
 - - - APPROXIMATE DREDGE/EXCAVATION LIMITS
 - ▨ APPROXIMATE OVEREXCAVATION FOOTPRINT

SCALE IN FEET
0 30 60

SCALE: 1" = 30'

DATE: OCTOBER 2017


ONE INCH
AT FULL SIZE, IF NOT ONE
INCH SCALE ACCORDINGLY

RECORD DRAWINGS

K:\Projects\0388-Port Gamble Sediment Cleanup RFP\Construction Plans\As-Built\0388-C-01 (SMA-1 Dredge Plan and XS).dwg C-01



POPE RESOURCES LP / OPG PROPERTIES LLC

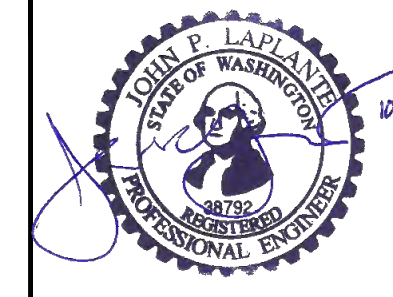

REVISIONS				
REV	DATE	BY	APP'D	DESCRIPTION
1	11/6/2017	CH	JL	RECORD DRAWINGS

DESIGNED BY: R. PICKERING
 DRAWN BY: C. HEWETT
 CHECKED BY: J. LAPLANTE
 APPROVED BY: J. LAPLANTE
 SCALE: 1" = 30'
 DATE: OCTOBER 2017


**PORT GAMBLE BAY CLEANUP
RECORD DRAWINGS**

**POST-DREDGE/EXCAVATION PLAN
(SMA-1)**


C-01

SHEET NO. 11 OF 24


K:\Projects\0388-Port Gamble Sewer Treatment Plant\Construction Plans\As-Built\0388-C-01 (SMA-1 Dredge Plan and XS).dwg C-02

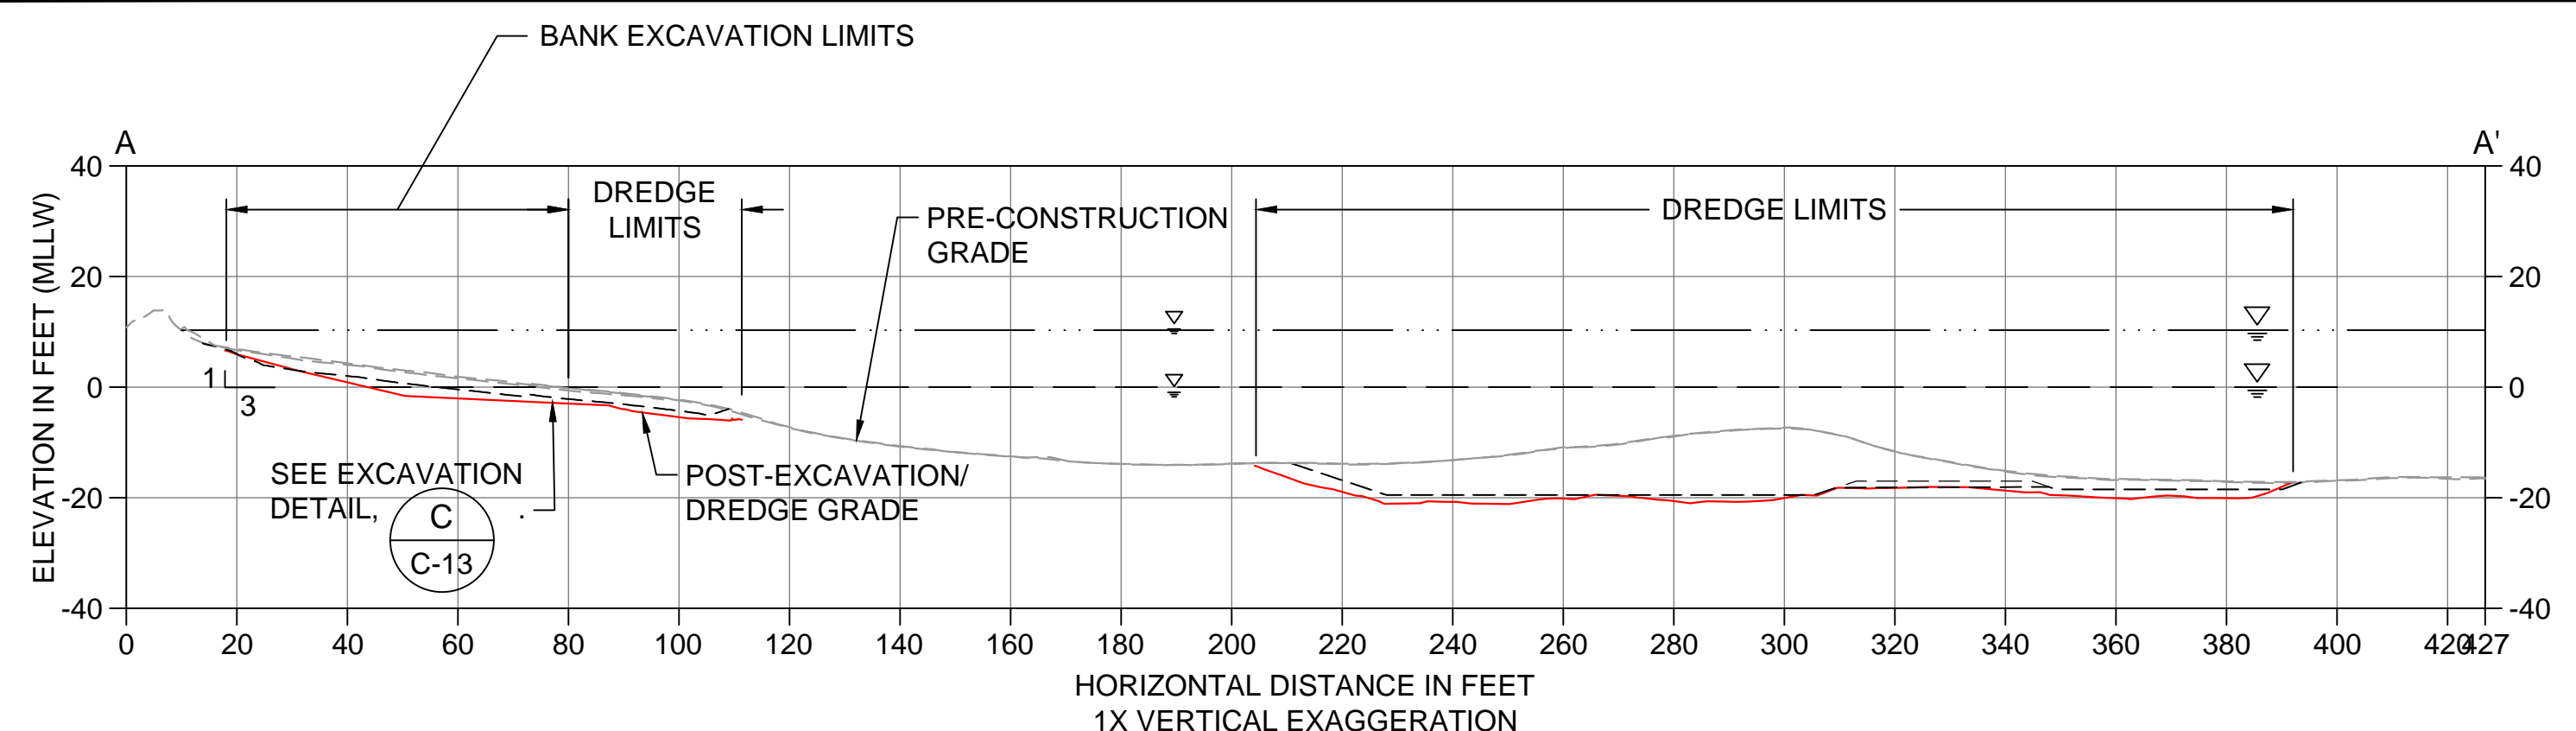


A DREDGE/EXCAVATION SECTION
C-01 SCALE: 1" = 30'

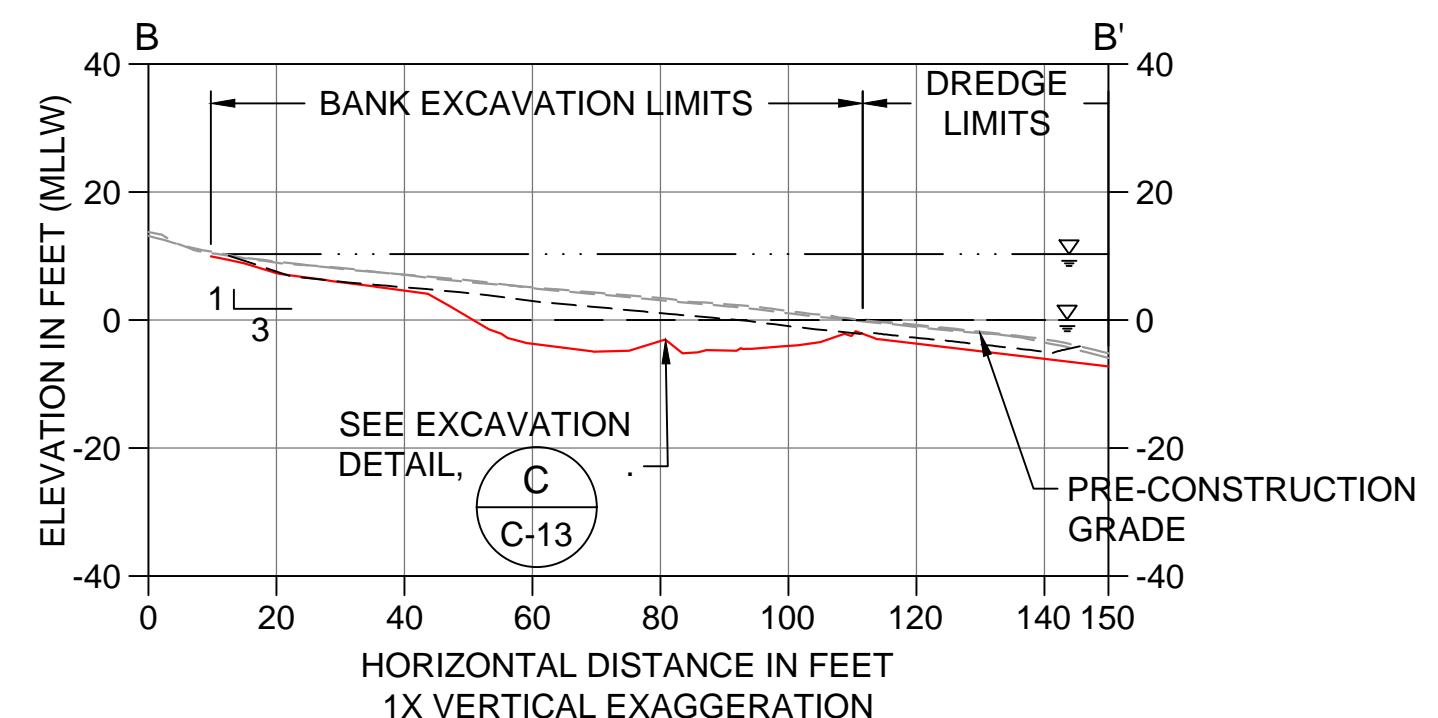


B DREDGE/EXCAVATION SECTION
C-01 SCALE: 1" = 30'

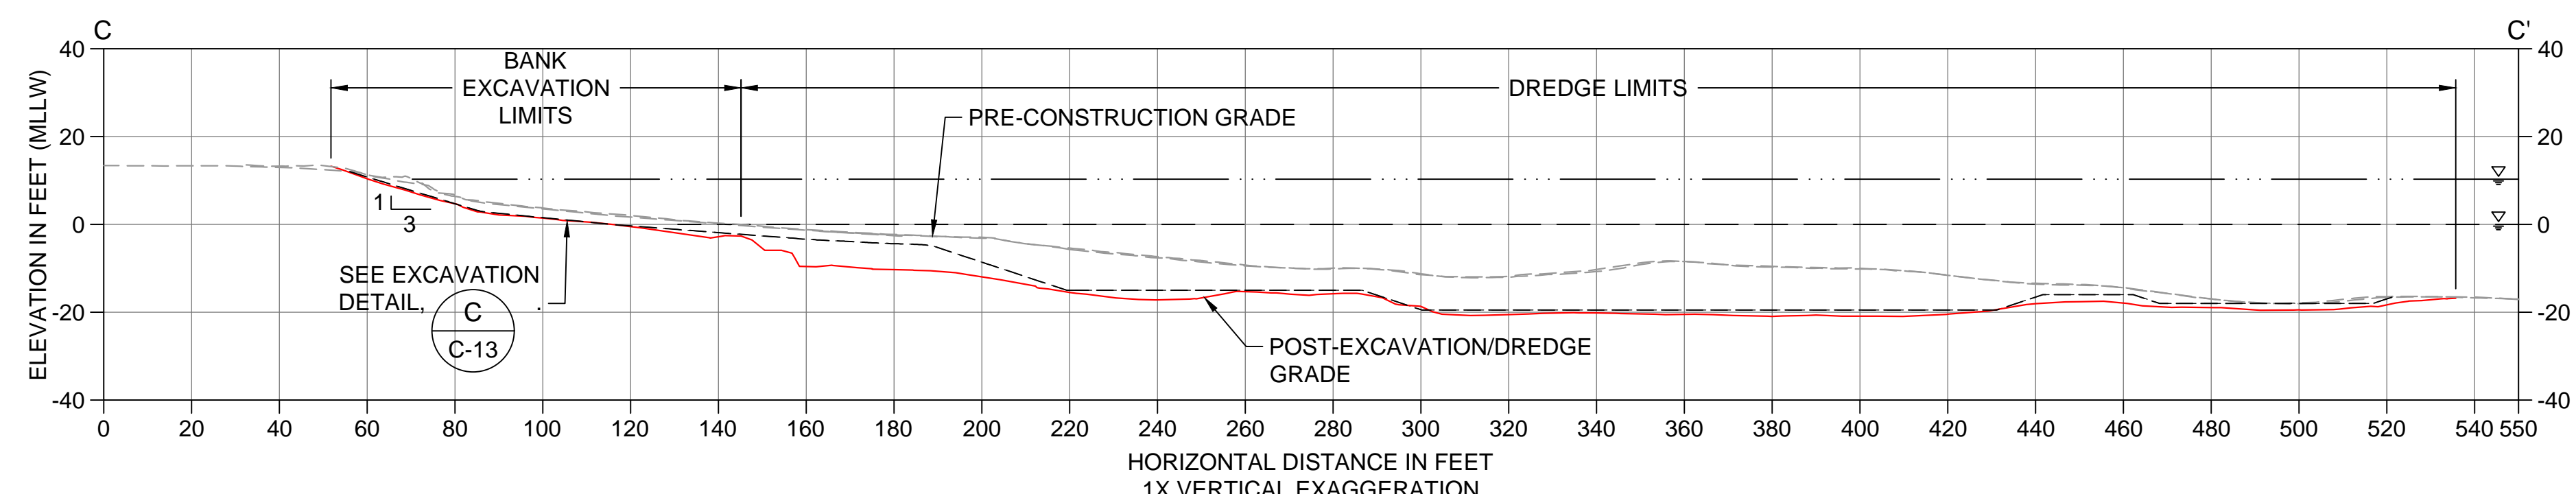


C DREDGE/EXCAVATION SECTION
C-01 SCALE: 1" = 30'

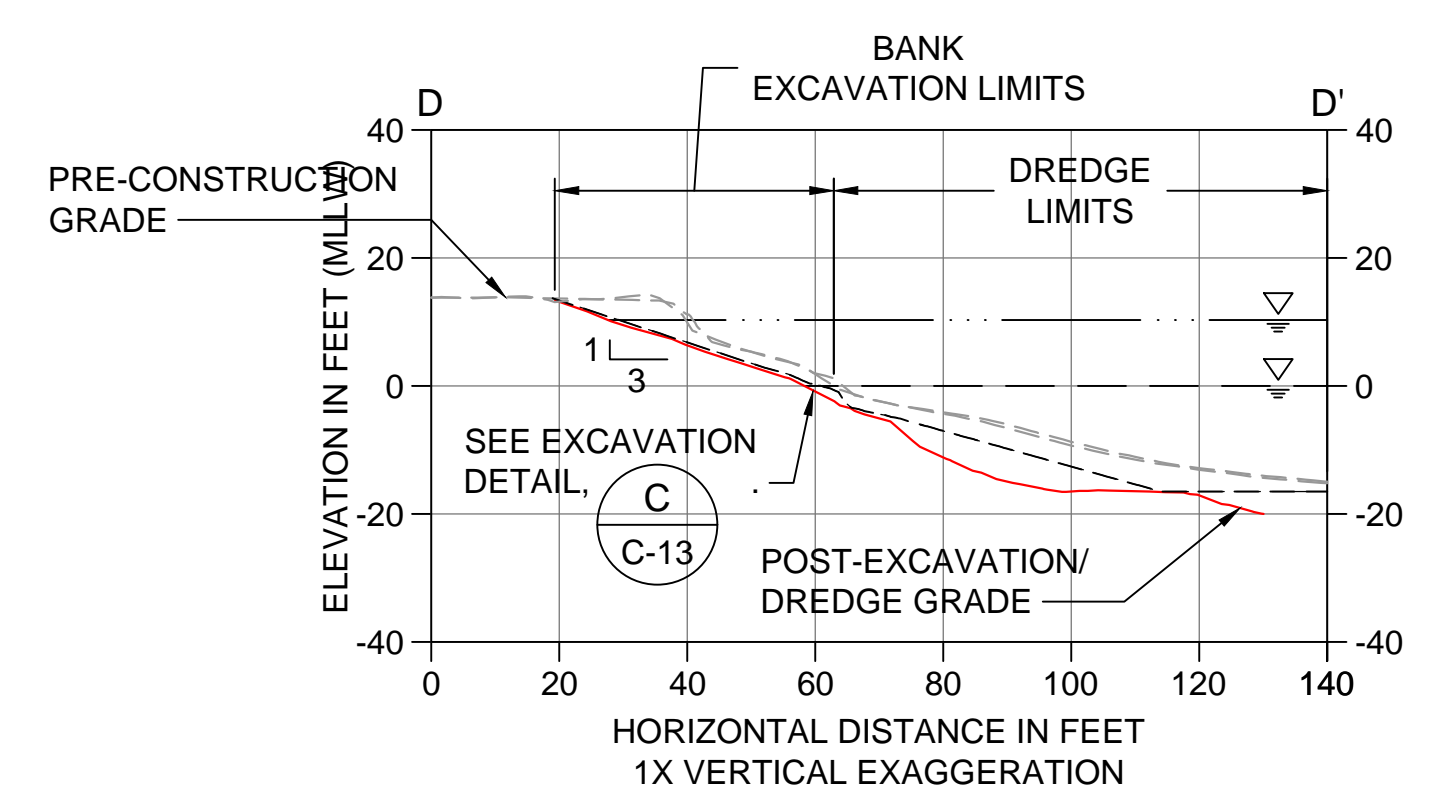

D DREDGE/EXCAVATION SECTION
C-01 SCALE: 1" = 30'

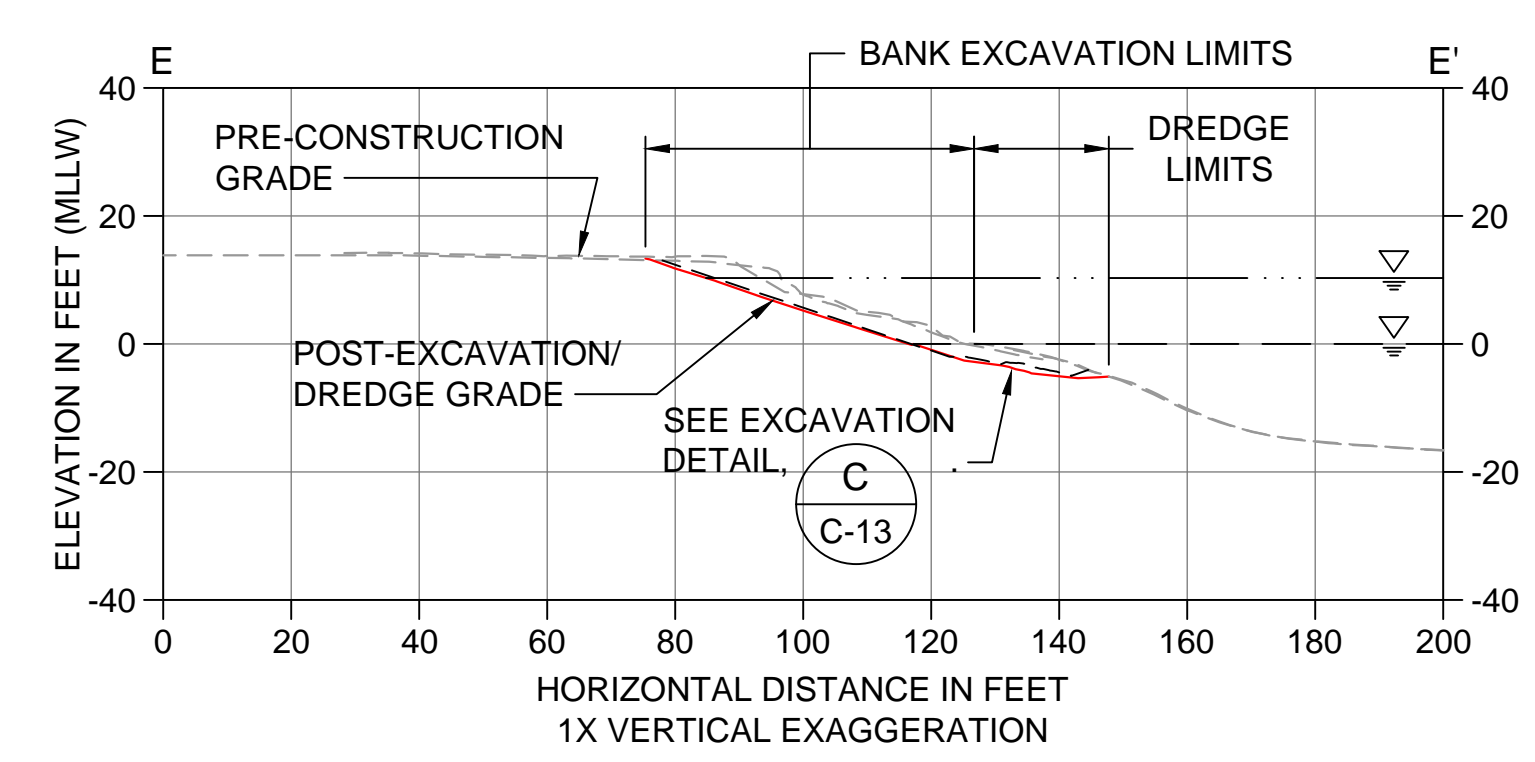


E DREDGE/EXCAVATION SECTION
C-01 SCALE: 1" = 30'

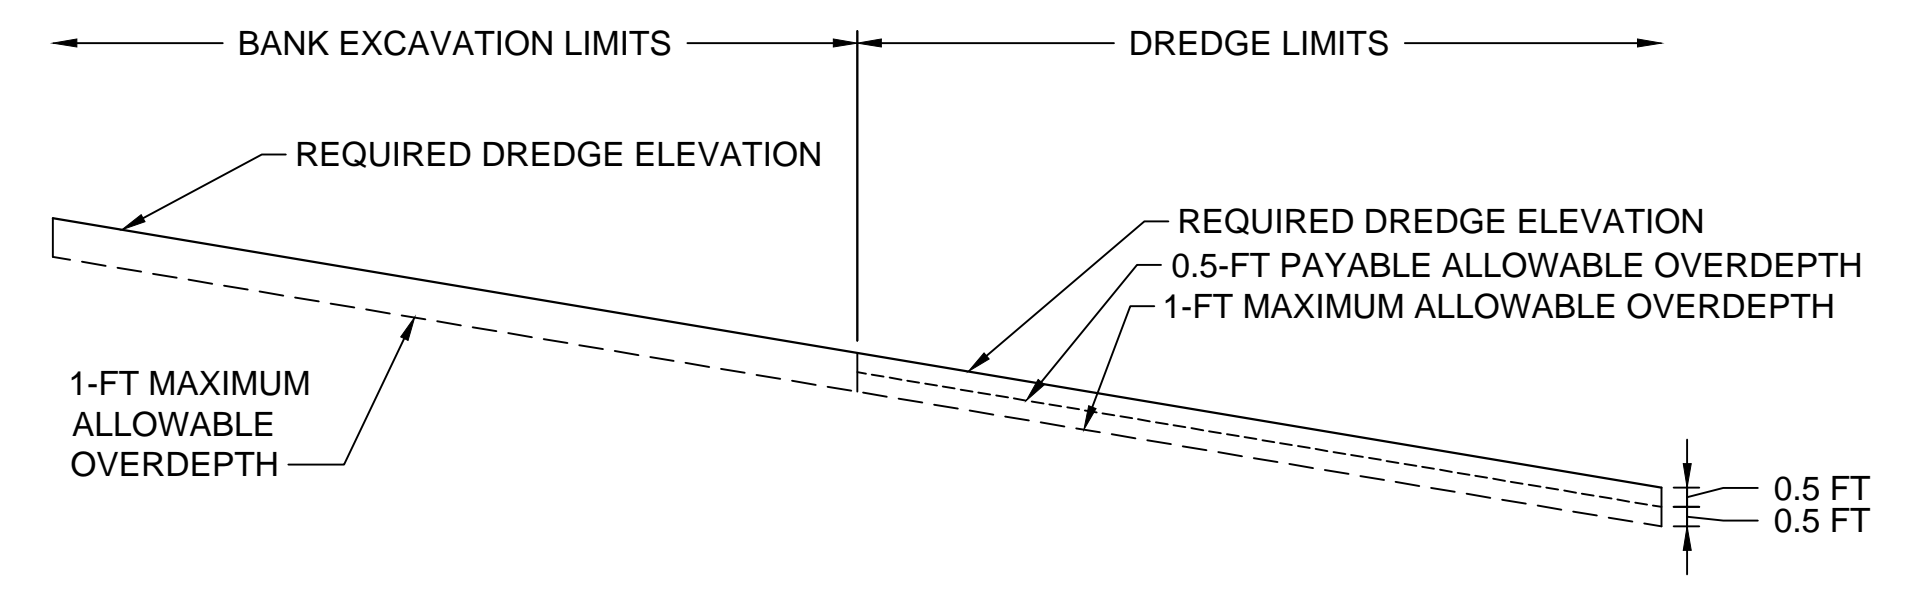

1 PAYABLE AND MAXIMUM ALLOWABLE OVERDEPTH DETAIL
SCALE: NTS


- LEGEND:**
- PRE-CONSTRUCTION GRADE
 - REQUIRED DREDGE ELEVATION
 - POST-EXCAVATION AND -DREDGE CONDITIONS
 - MEAN HIGHER HIGH WATER LINE (ELEVATION 10.3' MLLW)
 - MEAN LOWER LOW WATER LINE (ELEVATION 0.0' MLLW)

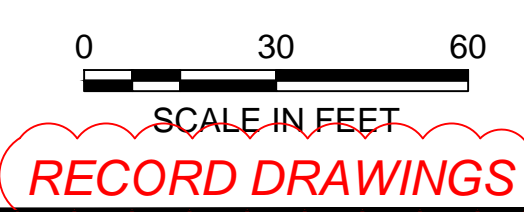

RECORD DRAWINGS



POPE RESOURCES LP / OPG PROPERTIES LLC

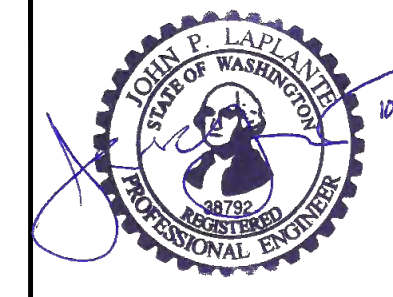

REVISIONS				
REV	DATE	BY	APP'D	DESCRIPTION
1	11/8/2017	CH	JL	RECORD DRAWINGS


DESIGNED BY: R. PICKERING
 DRAWN BY: C. HEWETT
 CHECKED BY: J. LAPLANTE
 APPROVED BY: J. LAPLANTE
 SCALE: 1" = 30'
 DATE: OCTOBER 2017

**PORT GAMBLE BAY CLEANUP
RECORD DRAWINGS**

**POST-DREDGE/EXCAVATION CROSS
SECTIONS (SMA-1)**

C-02

SHEET NO. 12 OF 24

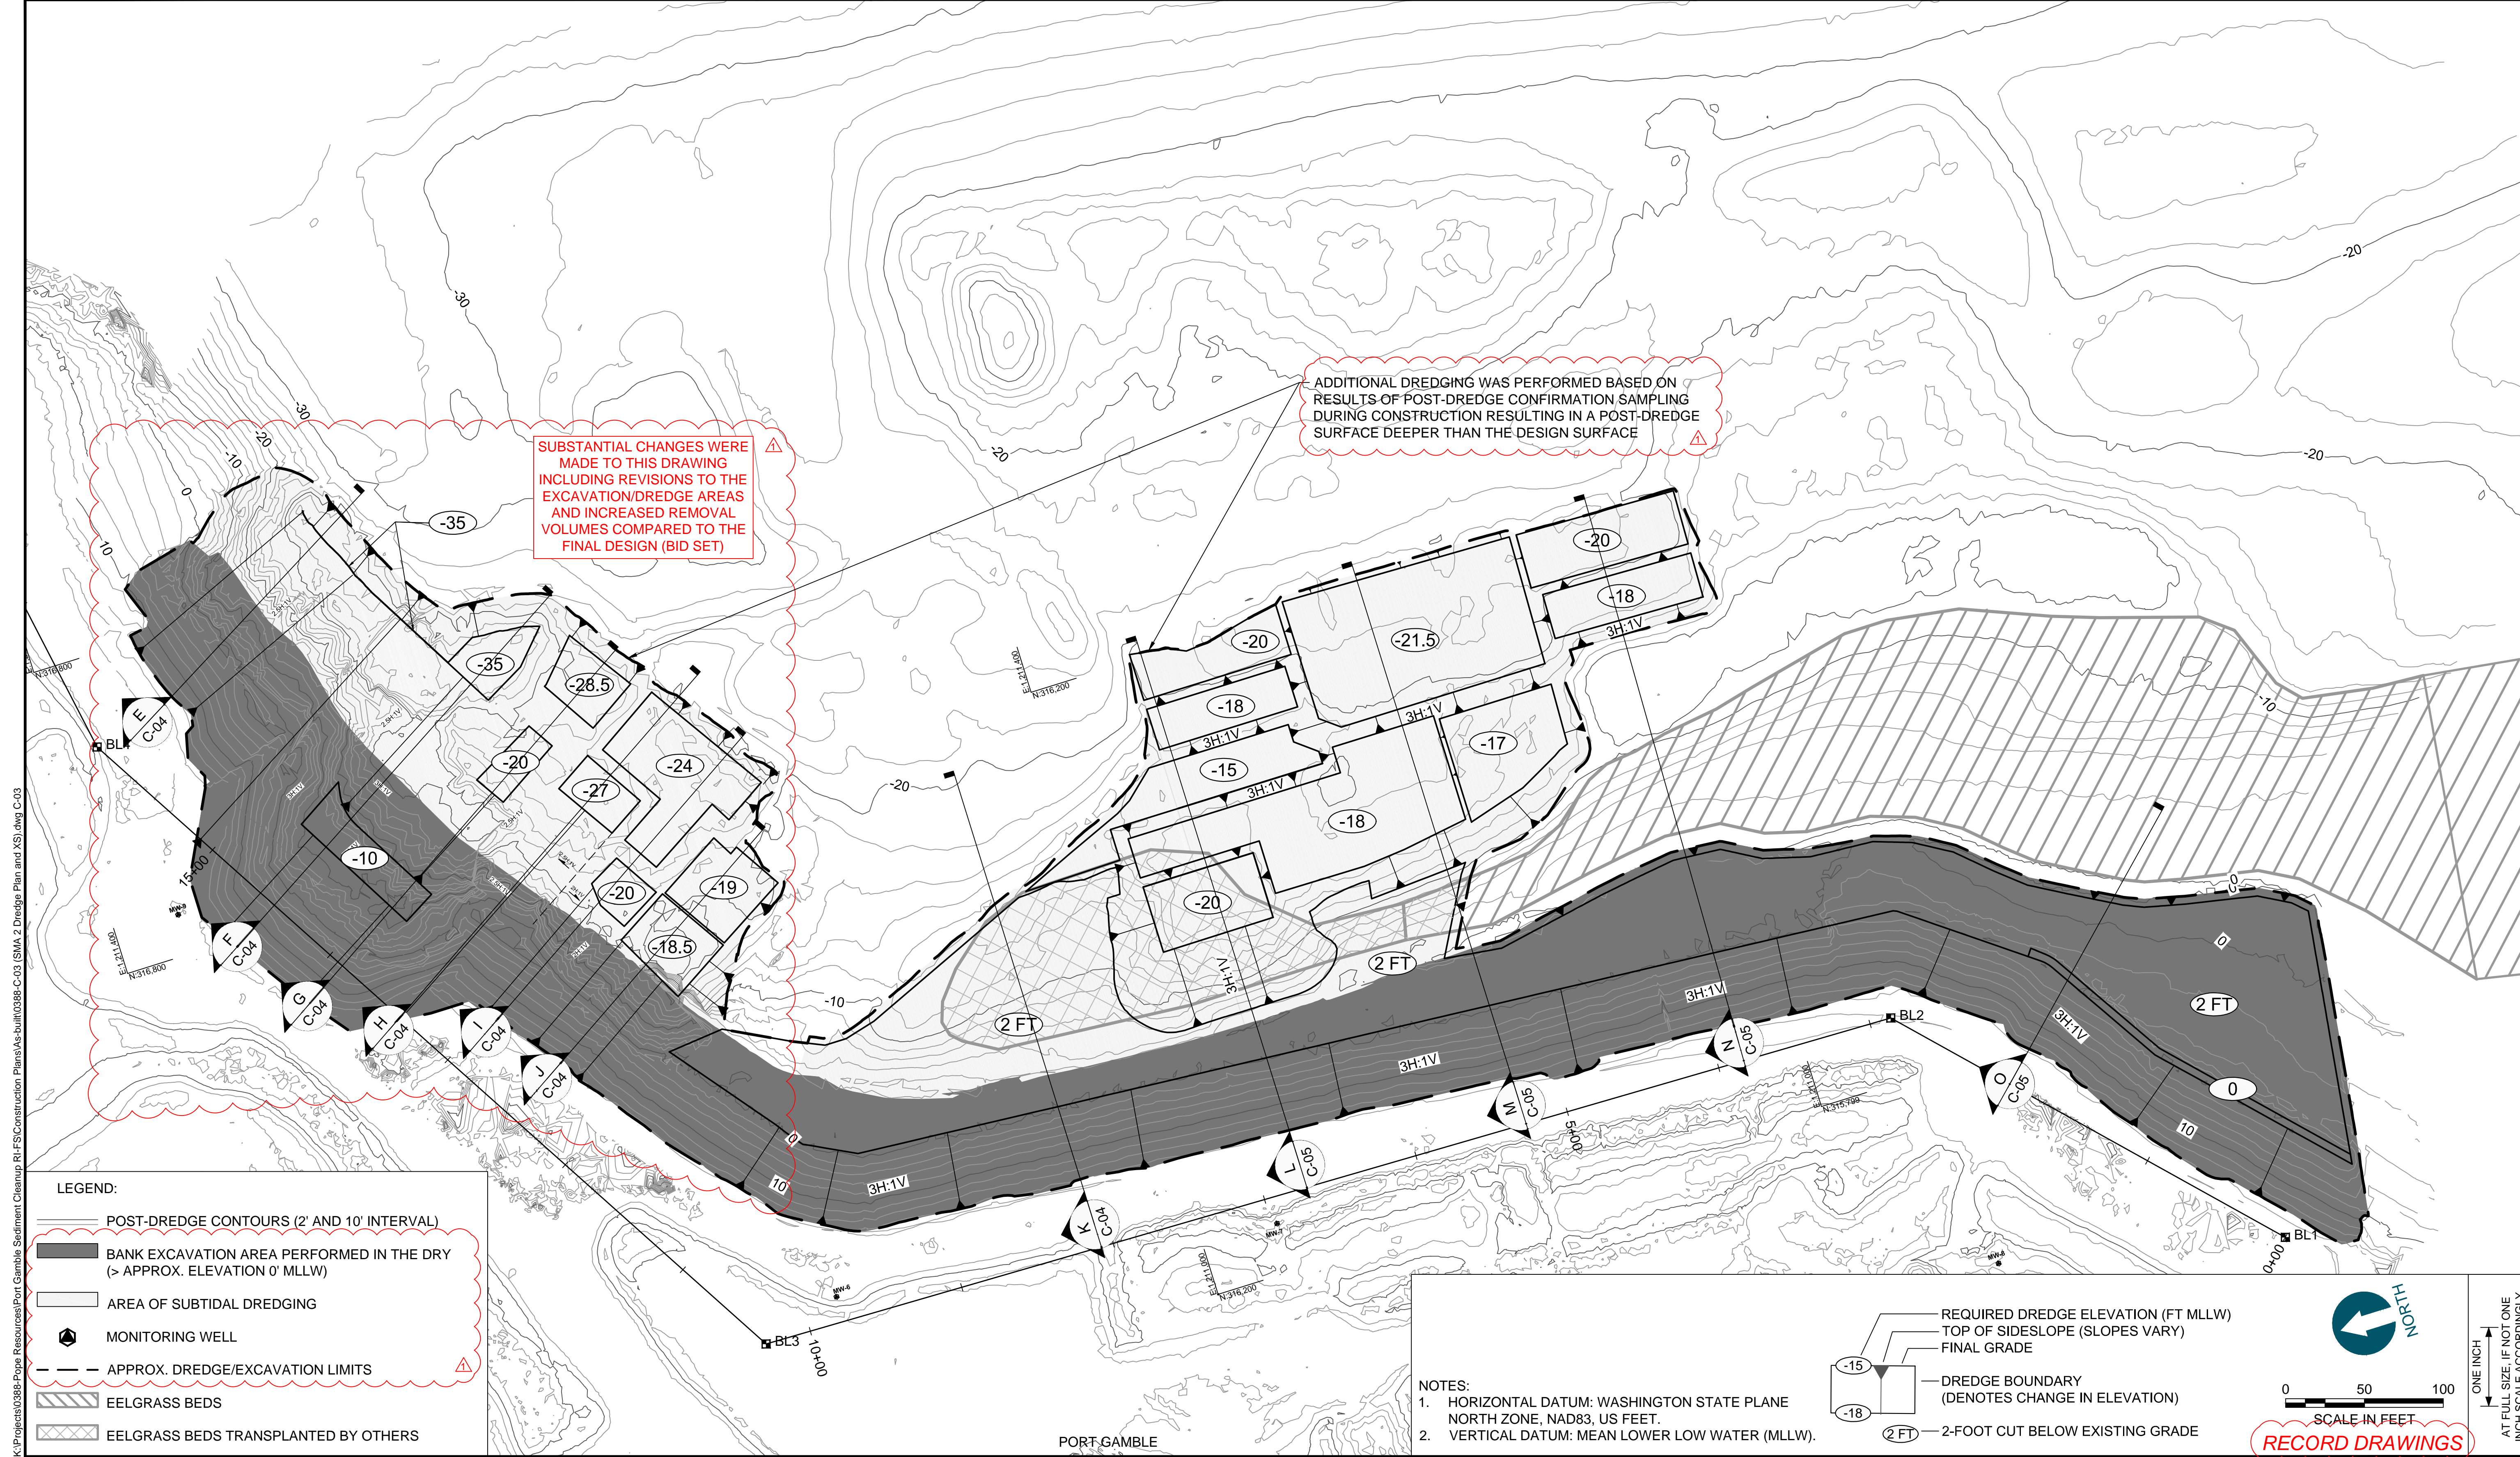


△
SUBSTANTIAL CHANGES WERE MADE TO THIS DRAWING INCLUDING REVISIONS TO THE EXCAVATION/DREDGE AREAS AND INCREASED REMOVAL VOLUMES COMPARED TO THE FINAL DESIGN (BID SET)

△
ADDITIONAL DREDGING WAS PERFORMED BASED ON RESULTS OF POST-DREDGE CONFIRMATION SAMPLING DURING CONSTRUCTION RESULTING IN A POST-DREDGE SURFACE DEEPER THAN THE DESIGN SURFACE

- LEGEND:**
- POST-DREDGE CONTOURS (2' AND 10' INTERVAL)
 - BANK EXCAVATION AREA PERFORMED IN THE DRY (> APPROX. ELEVATION 0' MLLW)
 - AREA OF SUBTIDAL DREDGING
 - MONITORING WELL
 - APPROX. DREDGE/EXCAVATION LIMITS
 - EELGRASS BEDS
 - EELGRASS BEDS TRANSPLANTED BY OTHERS

- NOTES:**
1. HORIZONTAL DATUM: WASHINGTON STATE PLANE NORTH ZONE, NAD83, US FEET.
 2. VERTICAL DATUM: MEAN LOWER LOW WATER (MLLW).

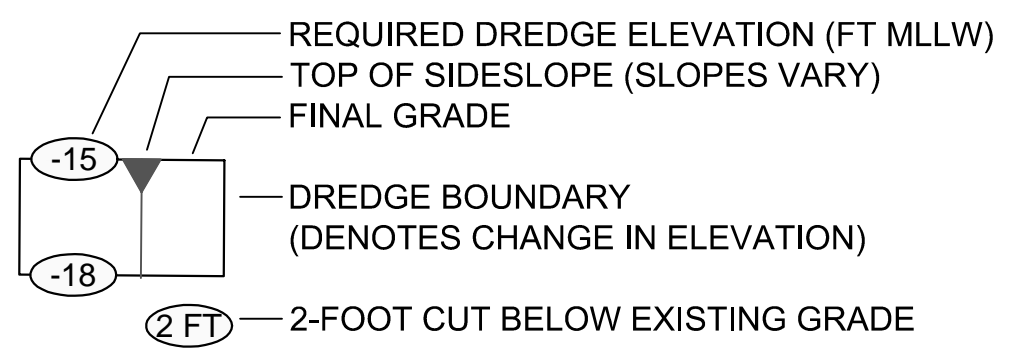

RECORD DRAWINGS


SCALE IN FEET

 ONE INCH = 50 FEET
 AT FULL SIZE, IF NOT ONE INCH SCALE ACCORDINGLY

K:\Projects\03888-Port Gamble Sludges\Construction Plans\As-Built\0388-C-03 (SMA-2) Dredge Plan and XS.dwg C-03
 Jan 04, 2018 9:55am chewett



POPE RESOURCES LP / OPG PROPERTIES LLC

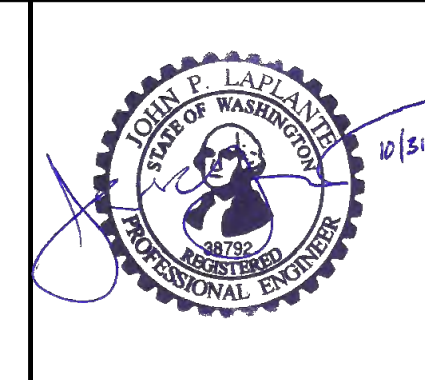

REVISIONS				
REV	DATE	BY	APP'D	DESCRIPTION
1	11/6/2017	CH	JL	RECORD DRAWINGS

DESIGNED BY: R. PICKERING
 DRAWN BY: C. HEWETT
 CHECKED BY: J. LAPLANTE
 APPROVED BY: J. LAPLANTE
 SCALE: 1" = 50'
 DATE: OCTOBER 2017


**PORT GAMBLE BAY CLEANUP
 RECORD DRAWINGS**

POST-DREDGE/EXCAVATION PLAN (SMA-2)


C-03

SHEET NO. 13 OF 24


K:\Projects\0388-Port Gamble Sluiceway Construction Plans\As-Built\0388-C-03 (SMA-2 Dredge Plan and XS).dwg C-04

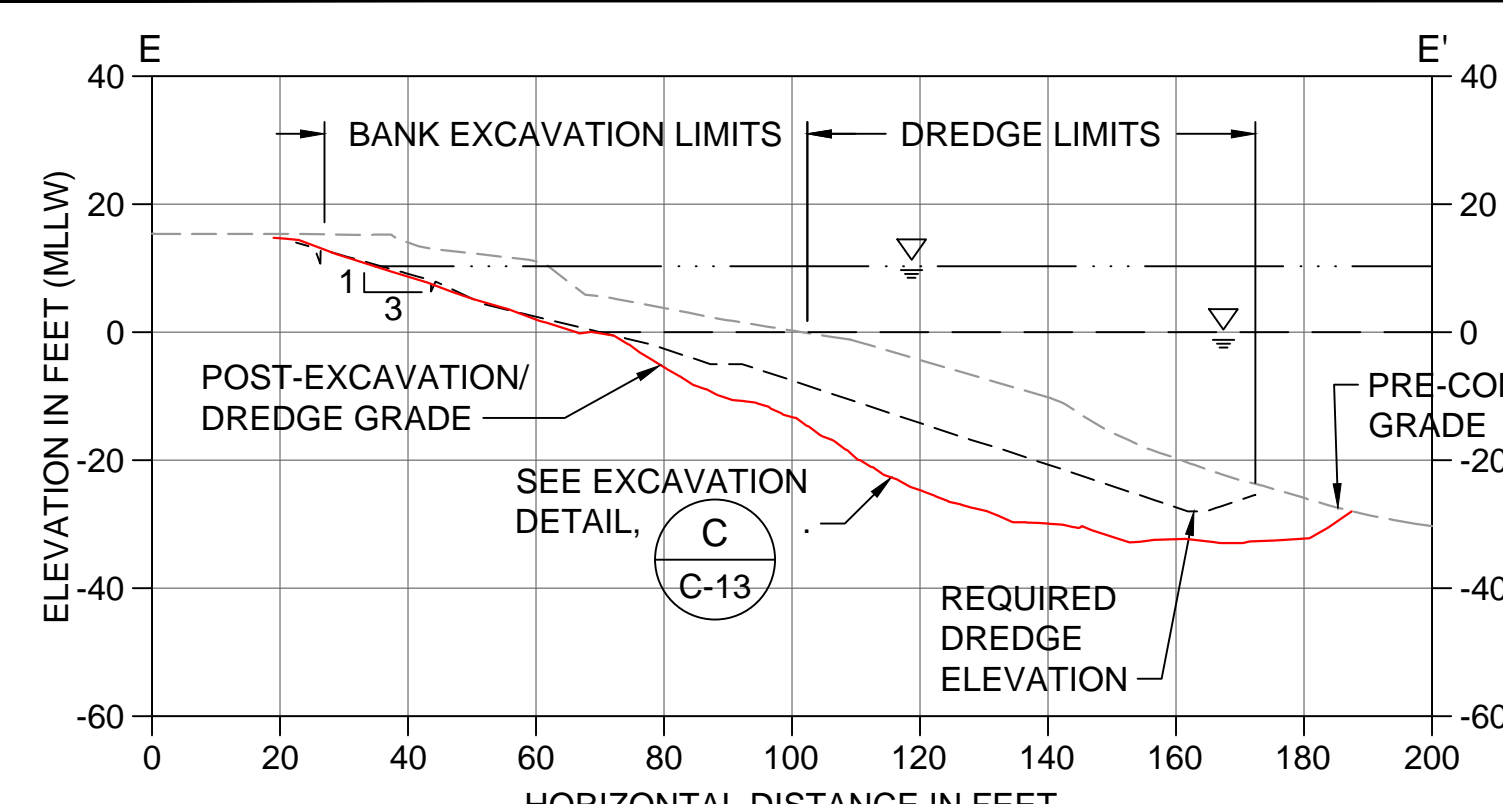


E DREDGE/EXCAVATION SECTION
C-03 SCALE: 1" = 30'

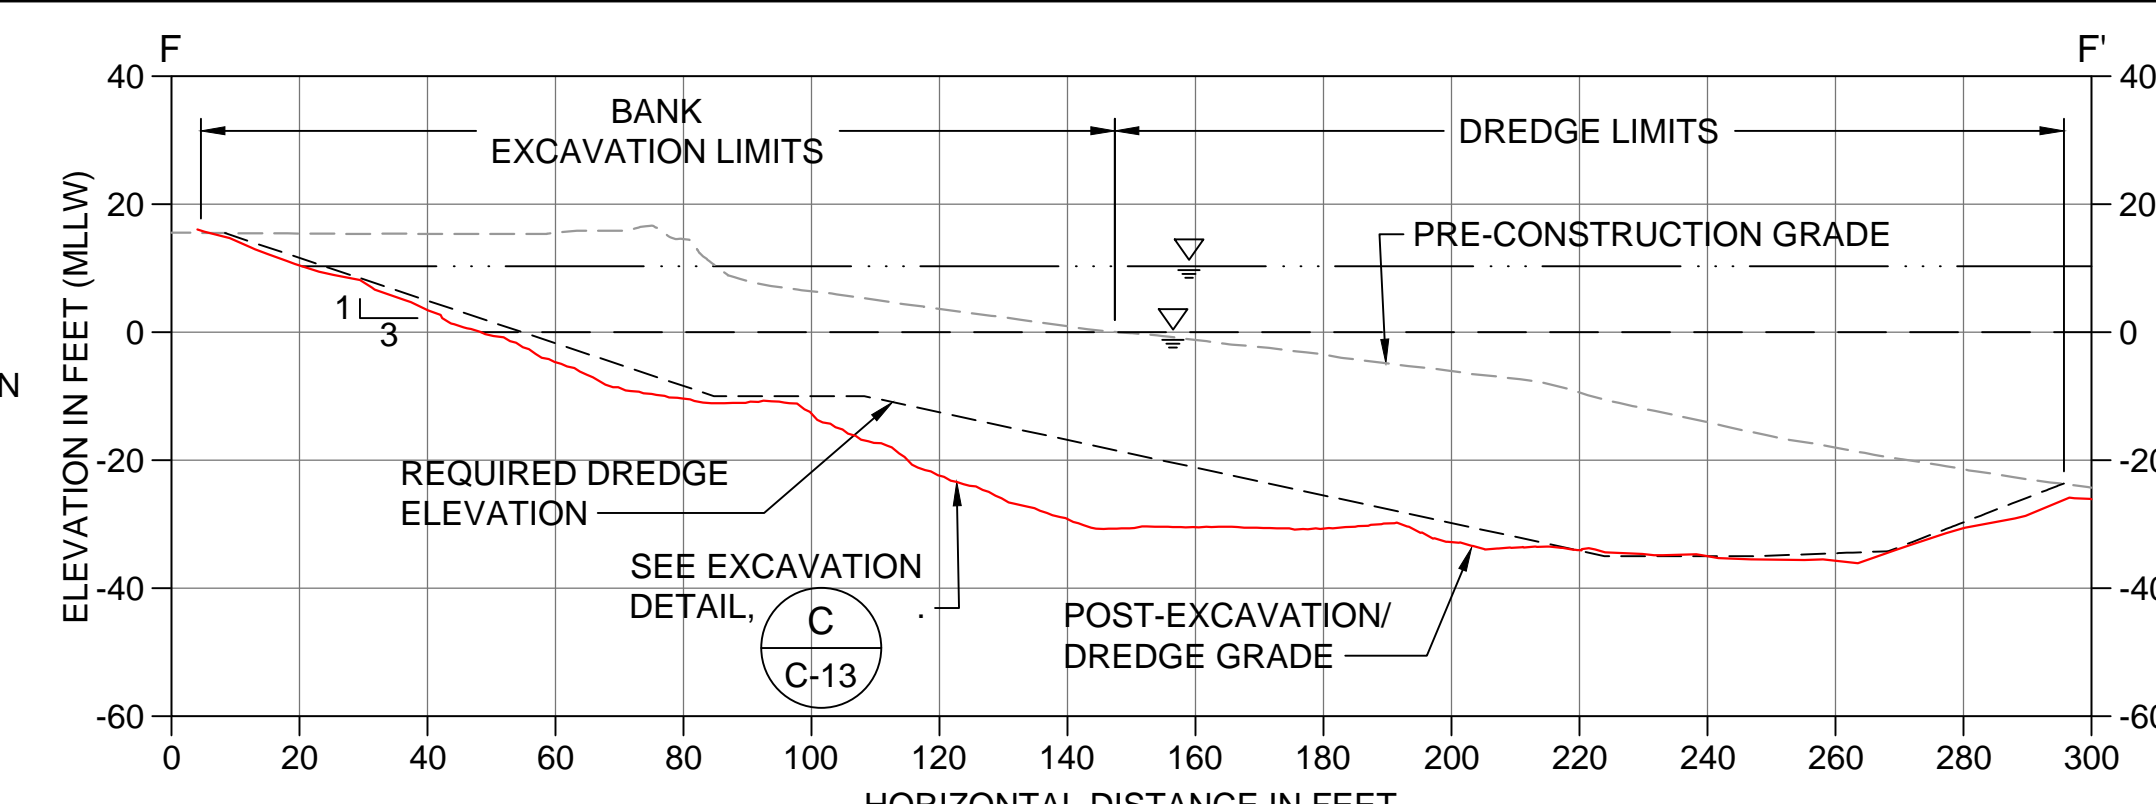


F DREDGE/EXCAVATION SECTION
C-03 SCALE: 1" = 30'

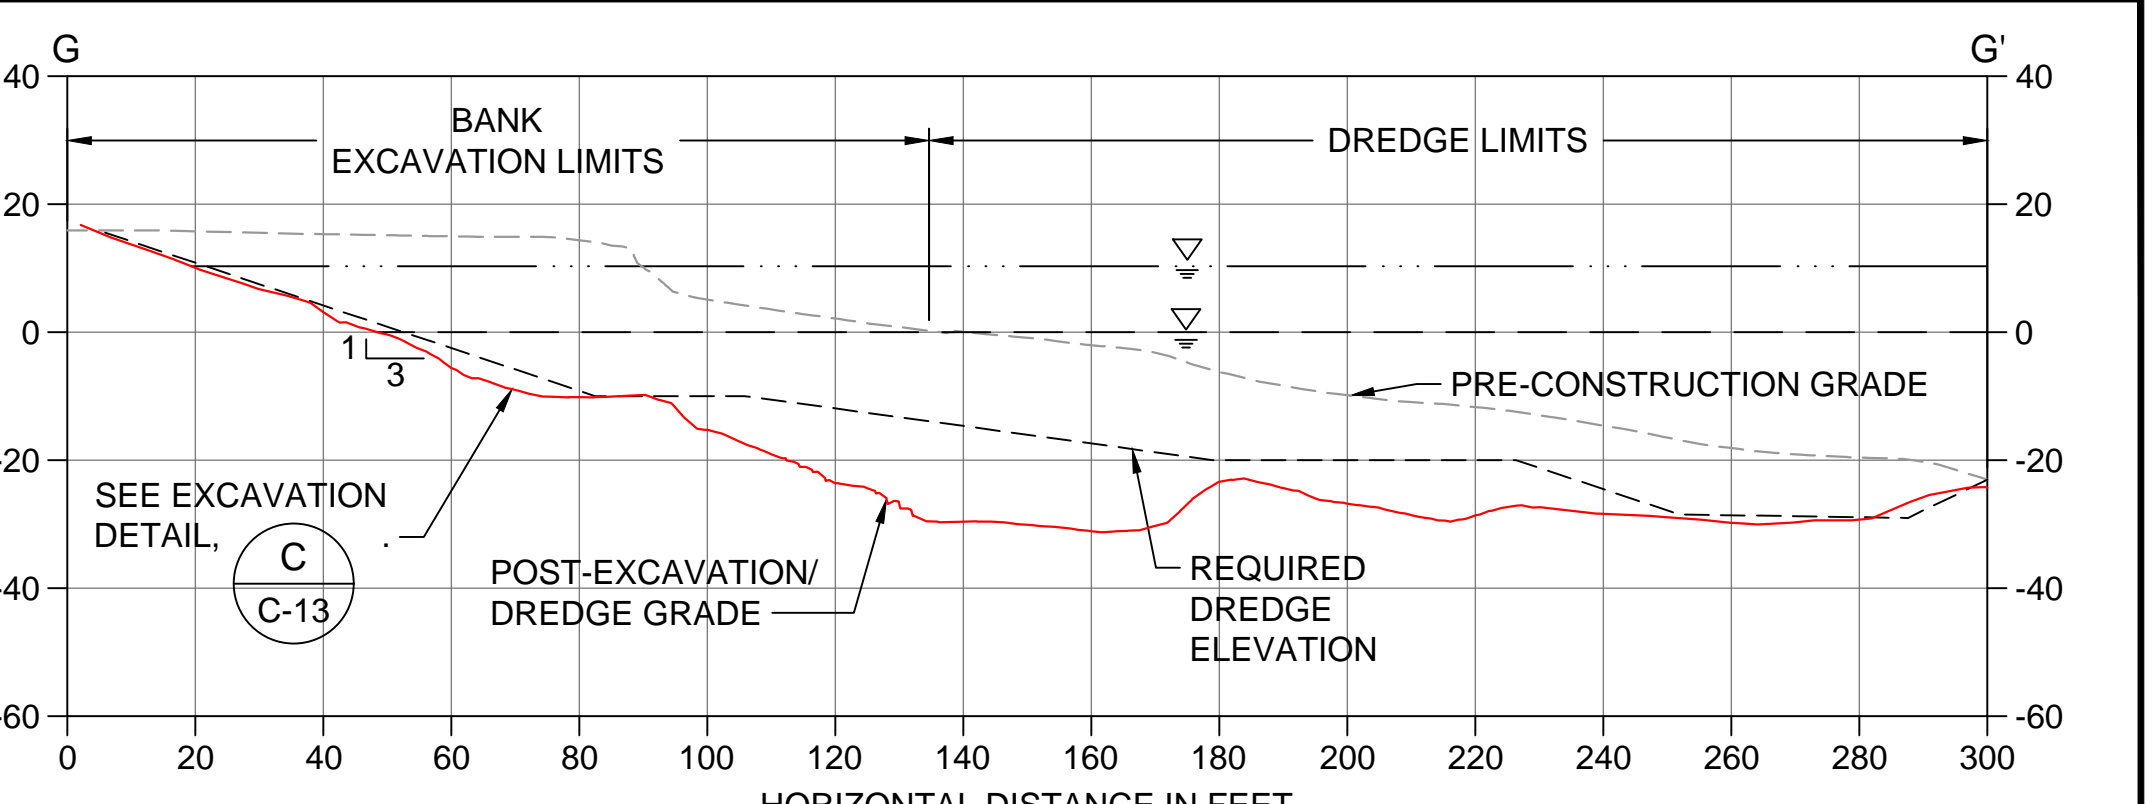


G DREDGE/EXCAVATION SECTION
C-03 SCALE: 1" = 30'

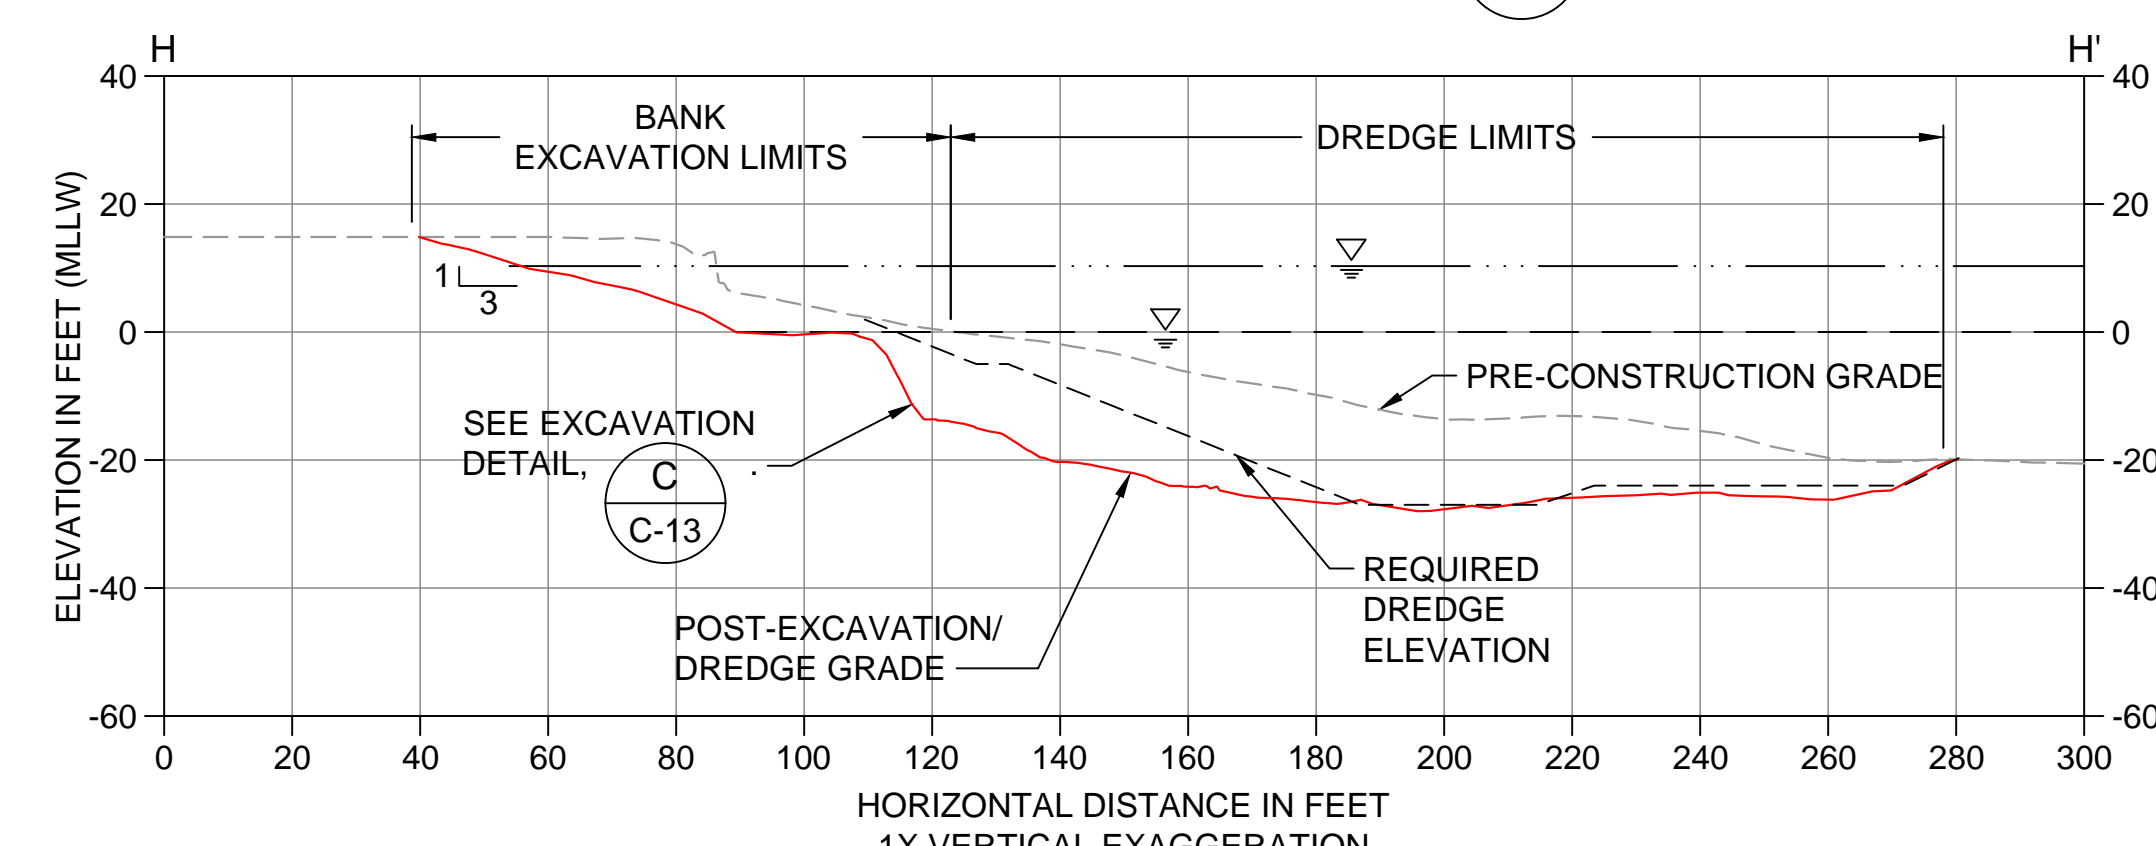


H DREDGE/EXCAVATION SECTION
C-03 SCALE: 1" = 30'

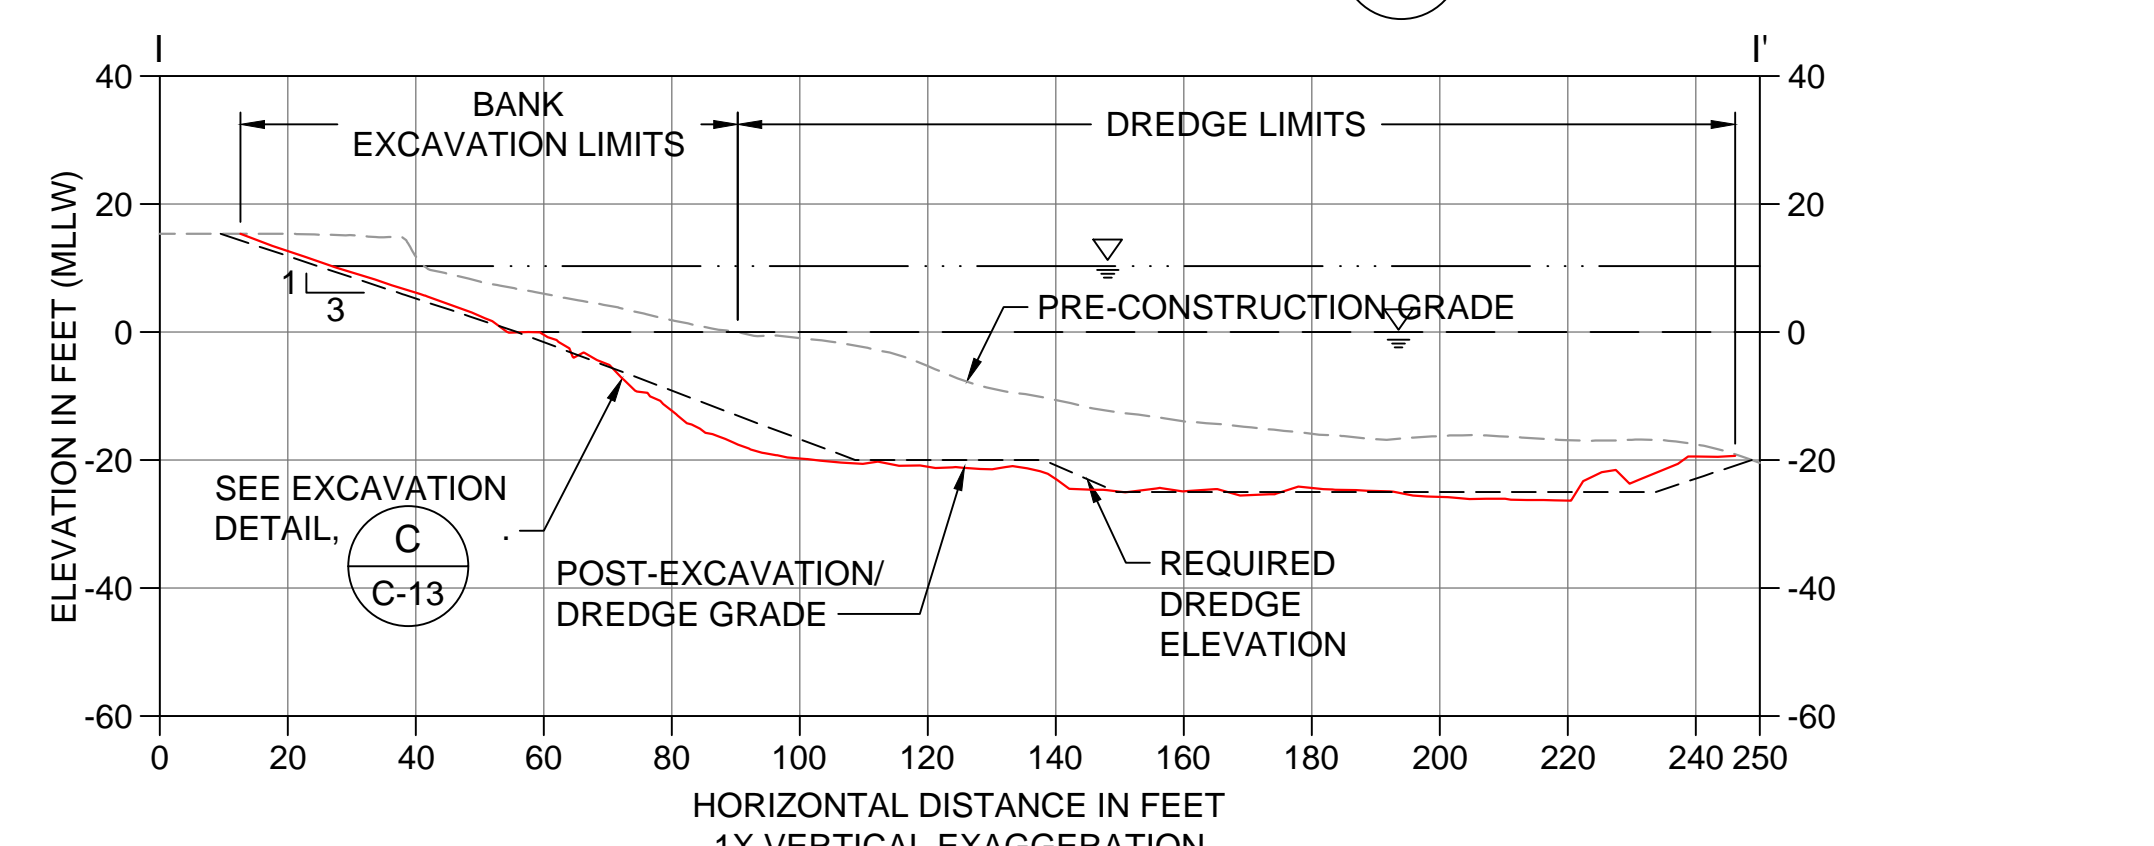

I DREDGE/EXCAVATION SECTION
C-03 SCALE: 1" = 30'

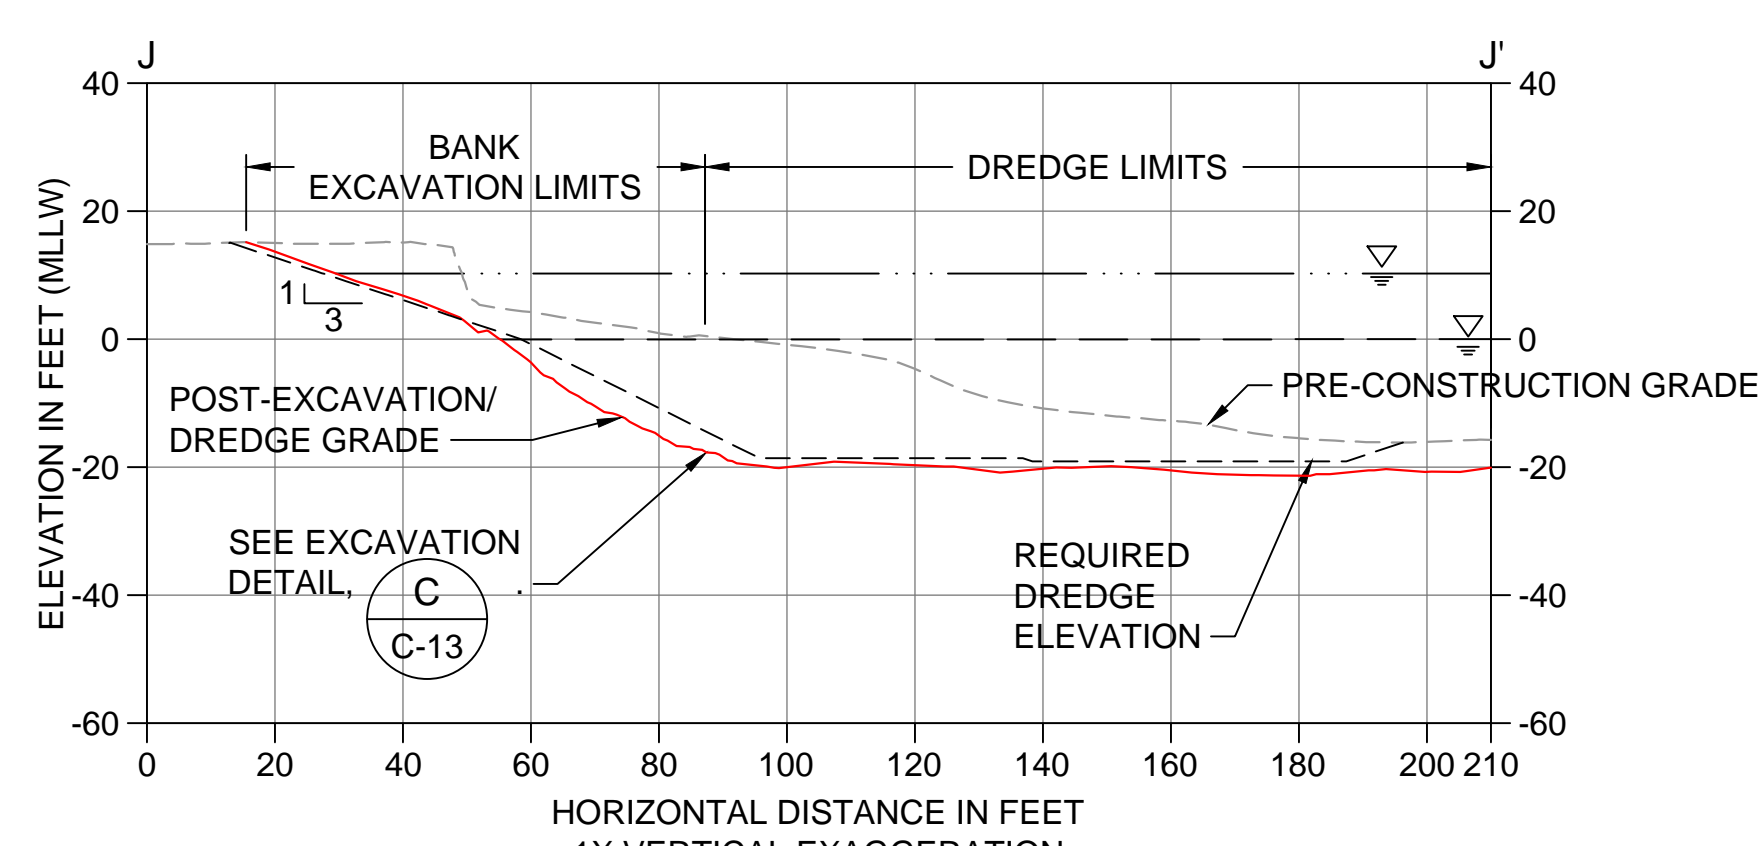


J DREDGE/EXCAVATION SECTION
C-03 SCALE: 1" = 30'

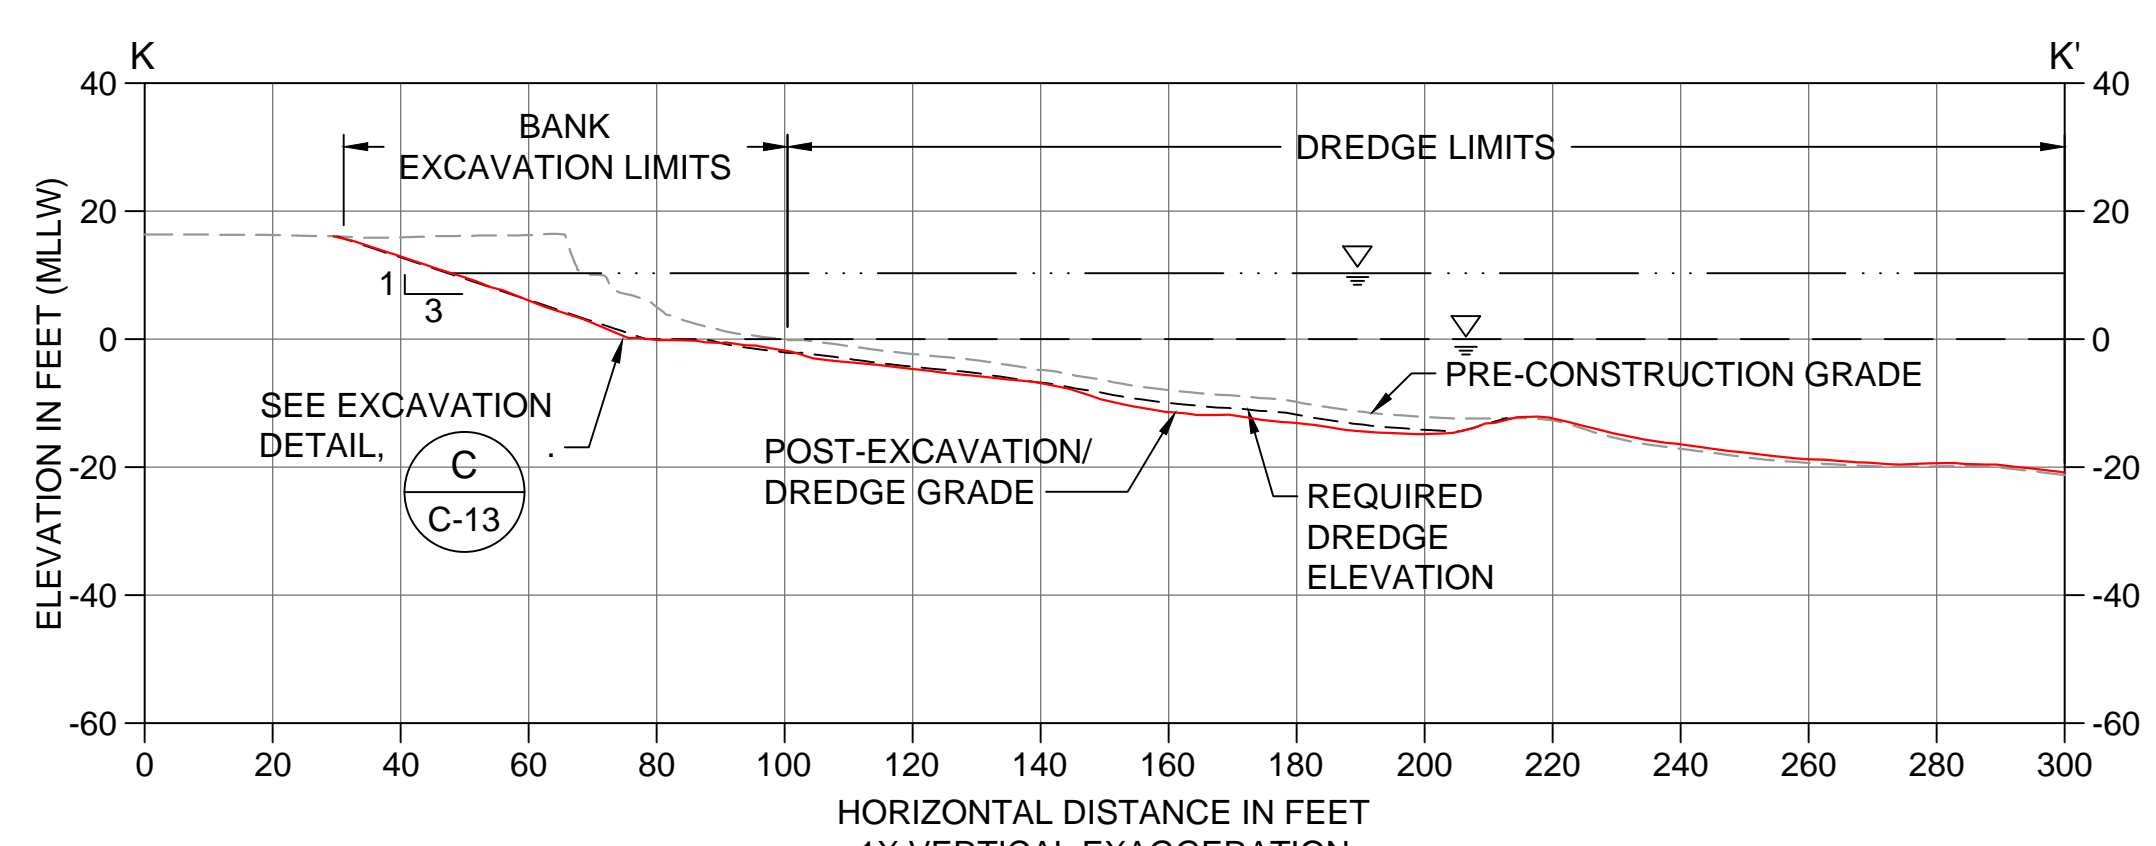

K DREDGE/EXCAVATION SECTION
C-03 SCALE: 1" = 30'

SUBSTANTIAL CHANGES WERE MADE TO THIS DRAWING INCLUDING REVISIONS TO THE EXCAVATION/DREDGE AREAS AND INCREASED REMOVAL VOLUMES COMPARED TO THE FINAL DESIGN (BID SET)

- LEGEND:**
- PRE-CONSTRUCTION GRADE
 - REQUIRED DREDGE ELEVATION
 - POST-DREDGE AND -EXCAVATION CONDITIONS
 - MEAN HIGHER HIGH WATER LINE (ELEVATION 10.3' MLLW)
 - MEAN LOWER LOW WATER LINE (ELEVATION 0.0' MLLW)

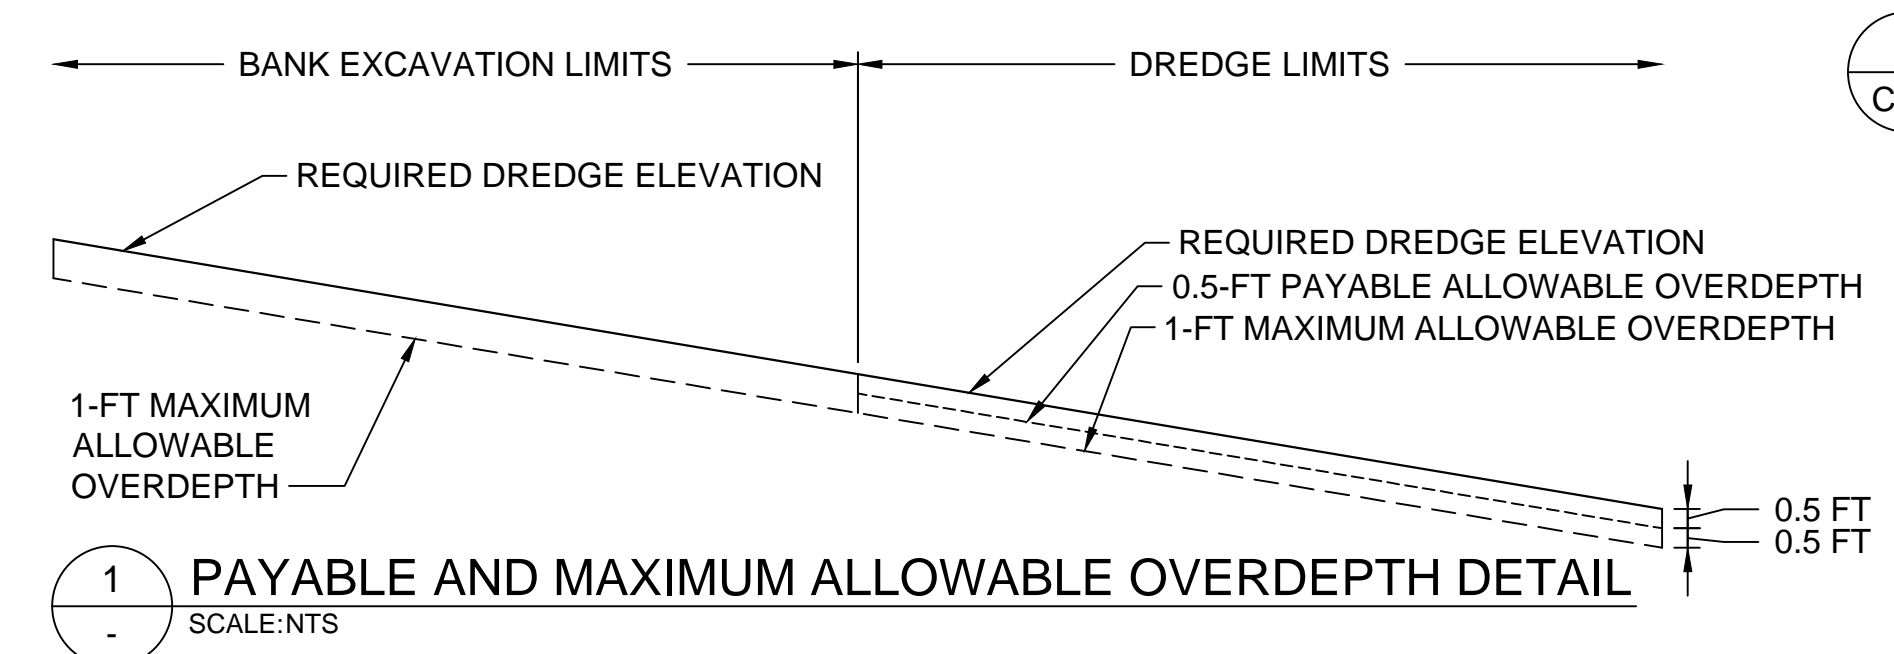

1 PAYABLE AND MAXIMUM ALLOWABLE OVERDEPTH DETAIL
SCALE: NTS

0 30 60
SCALE IN FEET
RECORD DRAWINGS



POPE RESOURCES LP / OPG PROPERTIES LLC



REVISIONS				
REV	DATE	BY	APP'D	DESCRIPTION
1	11/8/2017	CH	JL	RECORD DRAWINGS

DESIGNED BY: R. PICKERING
 DRAWN BY: C. HEWETT
 CHECKED BY: J. LAPLANTE
 APPROVED BY: J. LAPLANTE
 SCALE: 1" = 30'
 DATE: OCTOBER 2017


**PORT GAMBLE BAY CLEANUP
RECORD DRAWINGS**

**POST-DREDGE/EXCAVATION CROSS SECTIONS
(SMA-2) 1 OF 2**


C-04

SHEET NO. 14 OF 24


K:\Projects\0388-Port Gamble Sediment Cleanup\RFI\Construction Plans\As-Built\0388-C-03 (SMA-2 Dredge Plan and XS).dwg C-05

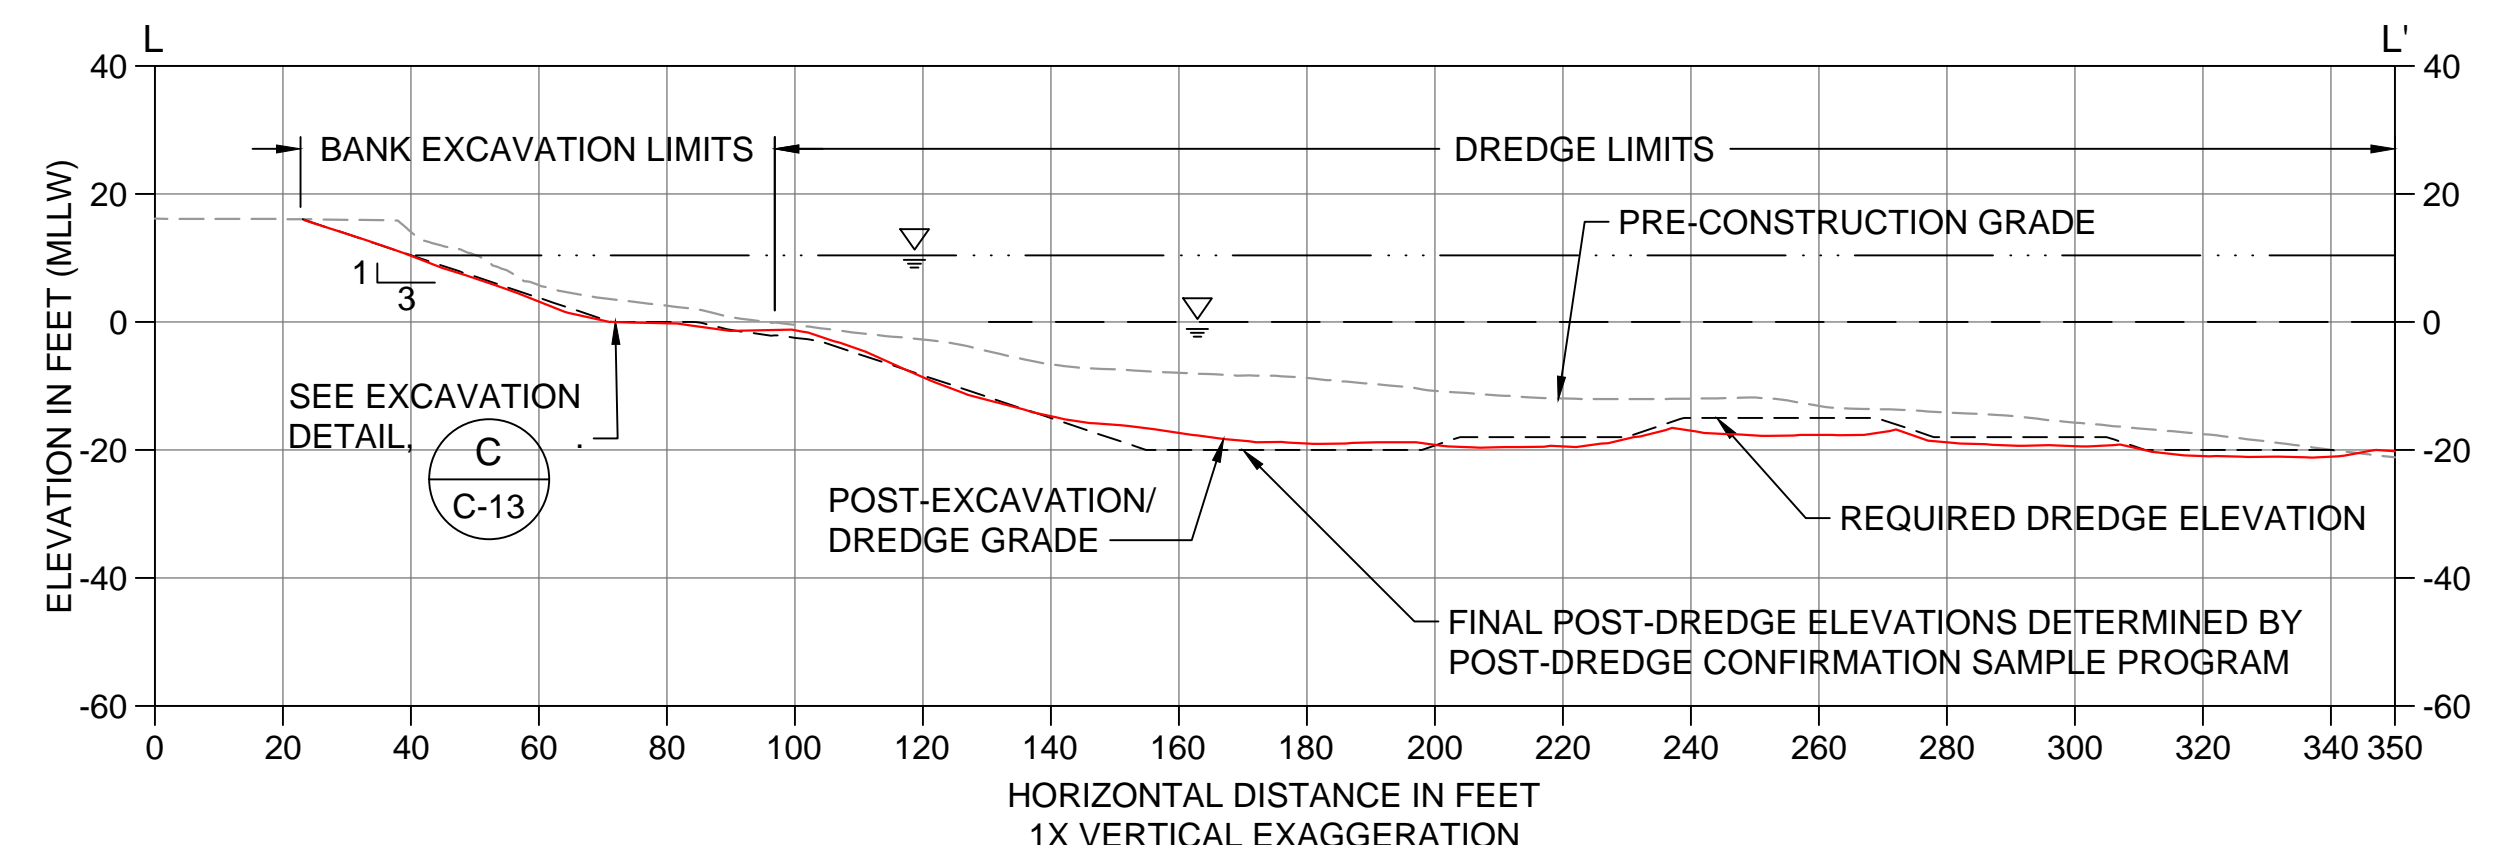


L DREDGE/EXCAVATION SECTION
SCALE: 1" = 30'

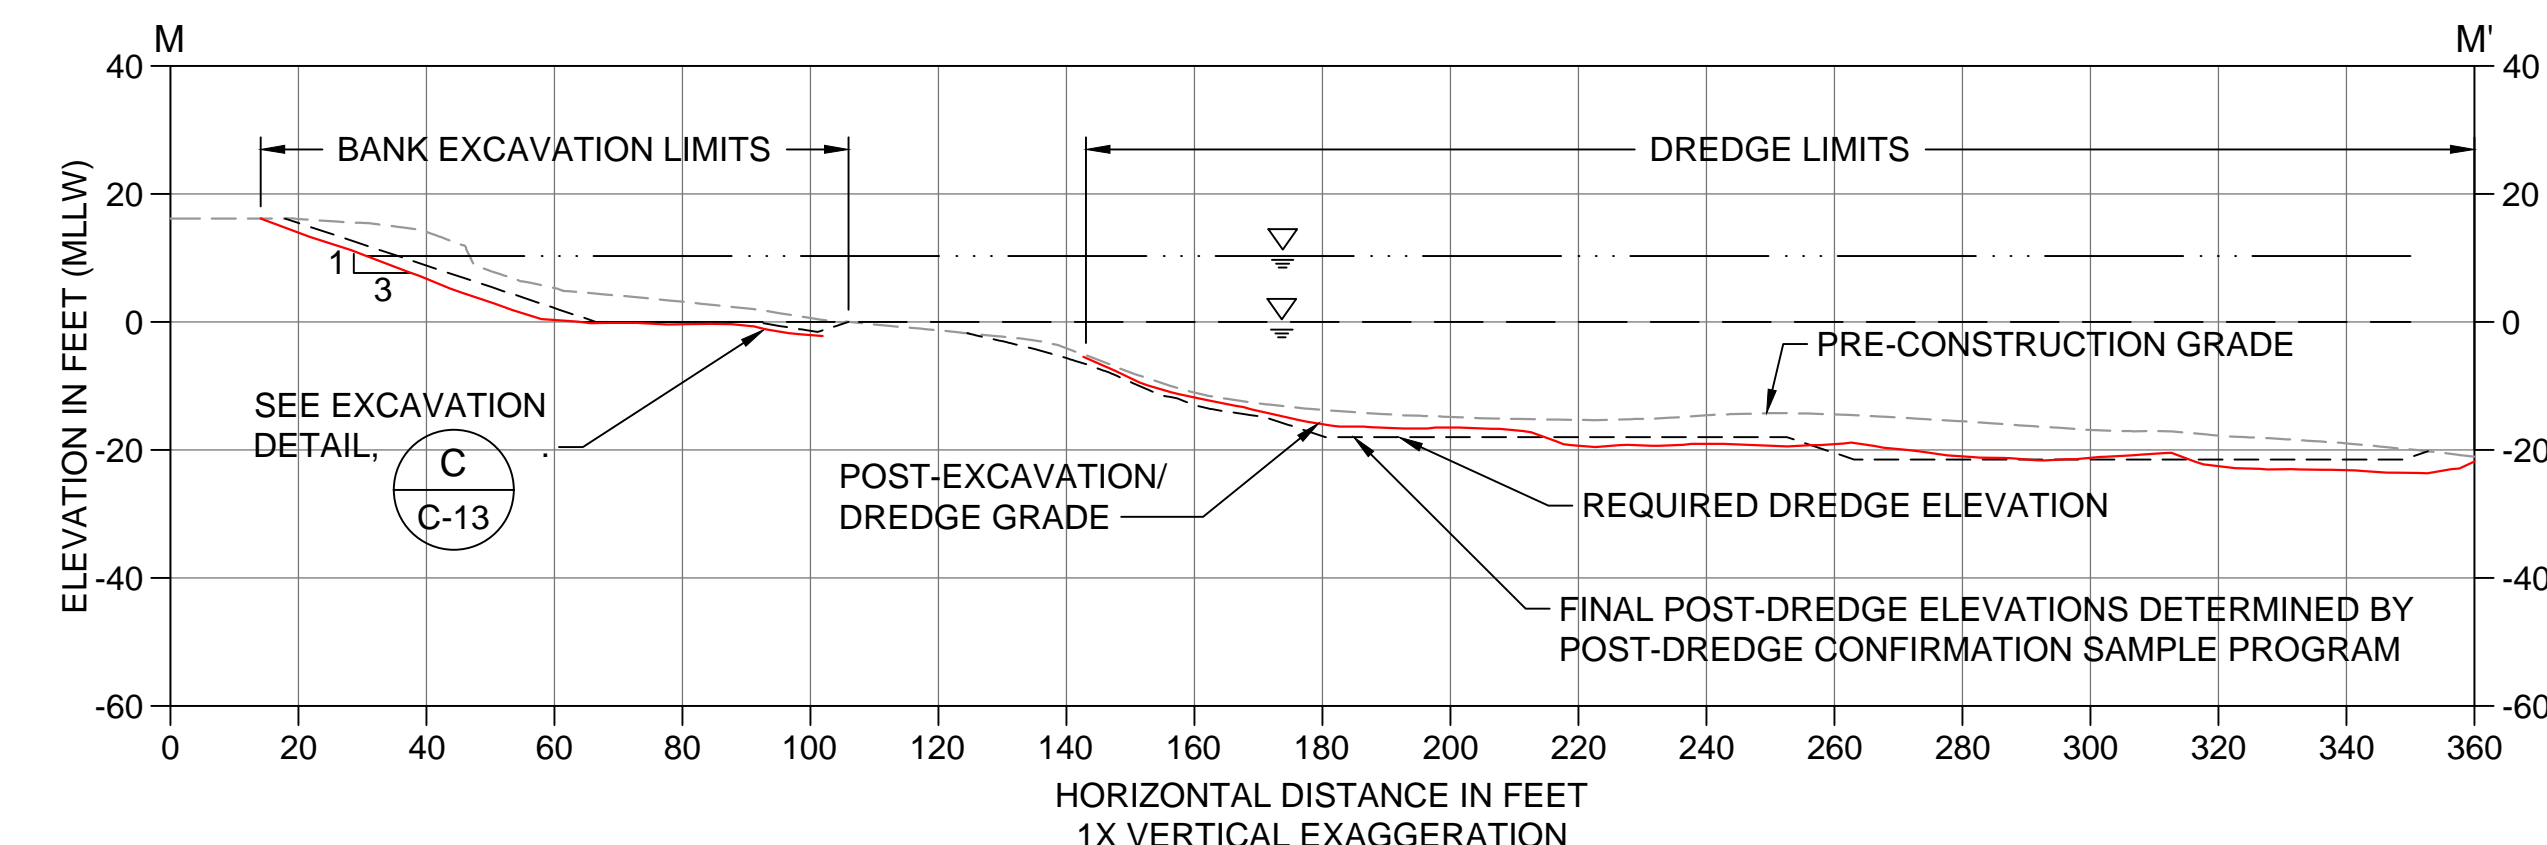

M DREDGE/EXCAVATION SECTION
SCALE: 1" = 30'

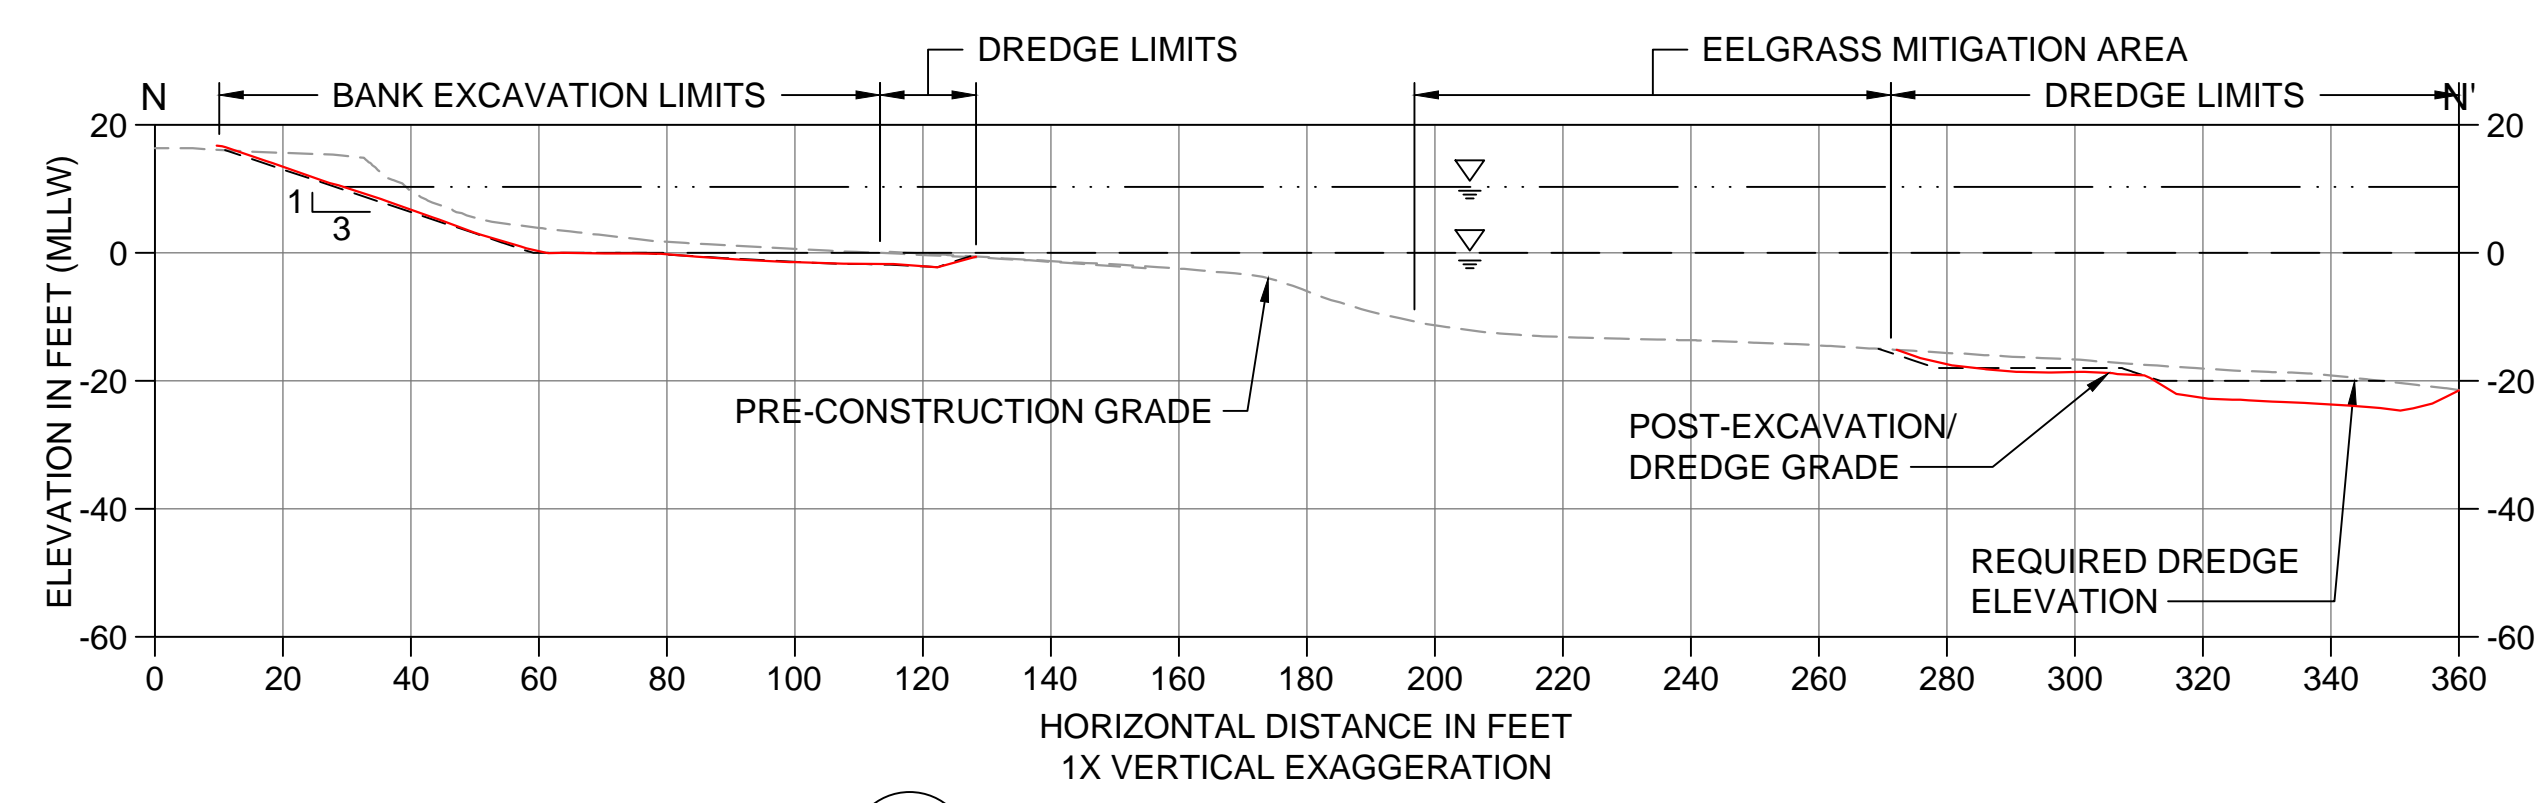


N DREDGE/EXCAVATION SECTION
SCALE: 1" = 30'

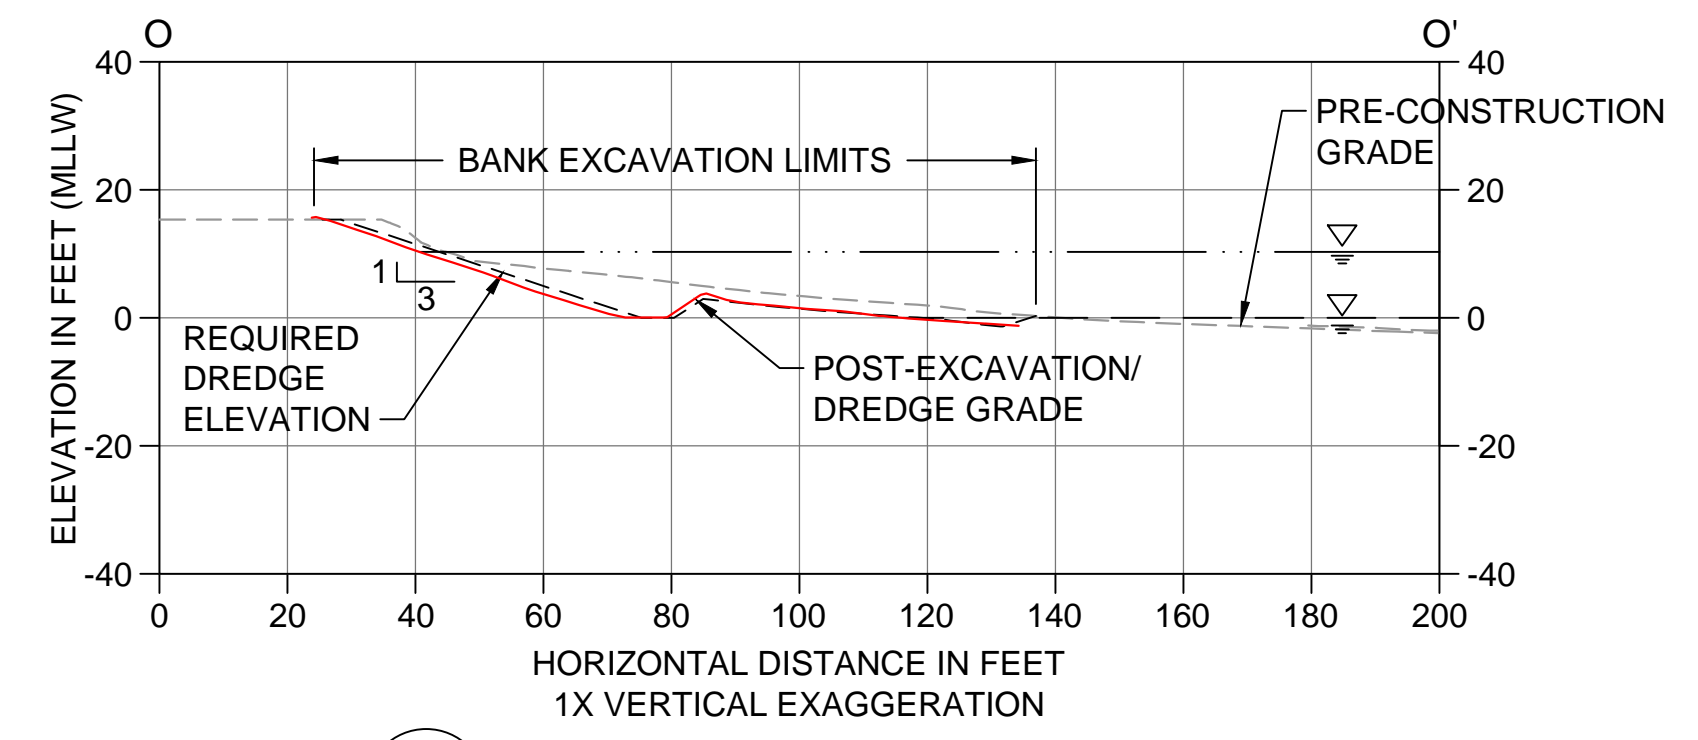

O DREDGE/EXCAVATION SECTION
SCALE: 1" = 30'

- LEGEND:**
- PRE-CONSTRUCTION GRADE
 - REQUIRED DREDGE ELEVATION
 - POST-DREDGE AND -EXCAVATION CONDITIONS
 - MEAN HIGHER HIGH WATER LINE (ELEVATION 10.3' MLLW)
 - MEAN LOWER LOW WATER LINE (ELEVATION 0.0' MLLW)

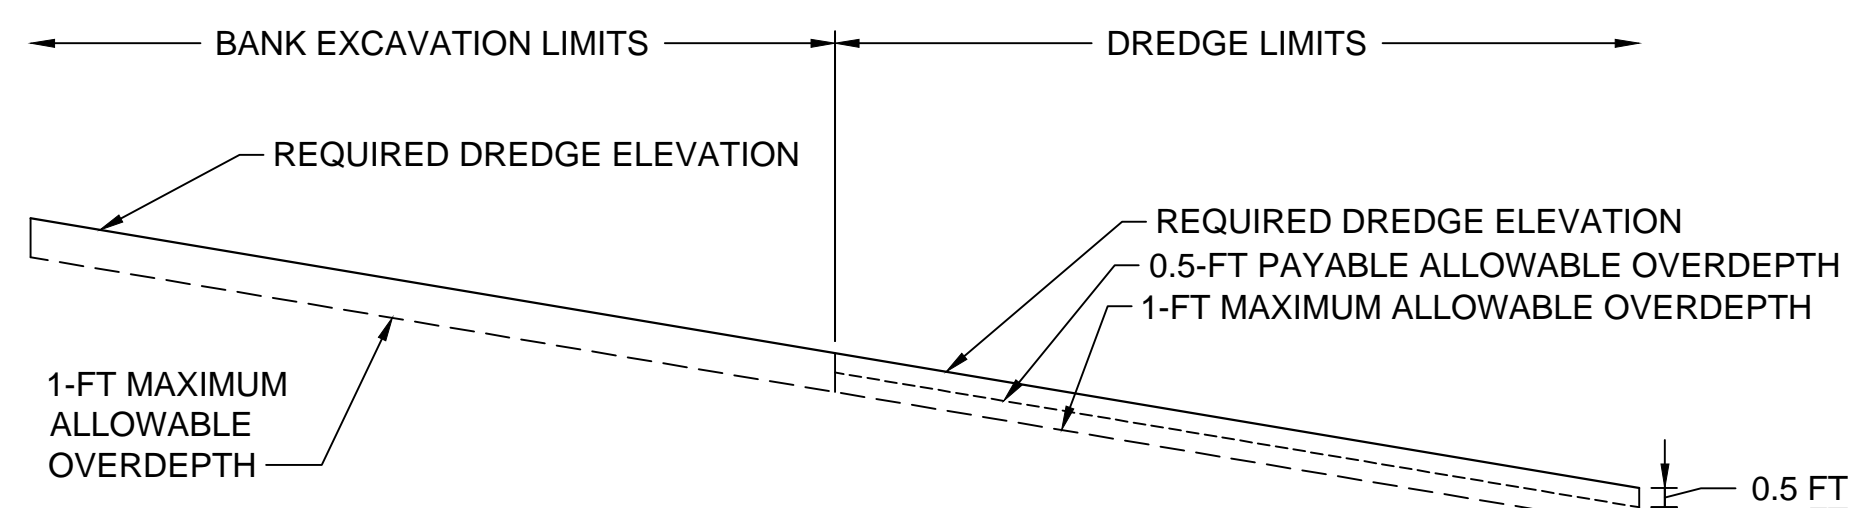


1 PAYABLE AND MAXIMUM ALLOWABLE OVERDEPTH DETAIL
SCALE: NTS

0 30 60
SCALE IN FEET
RECORD DRAWINGS



POPE RESOURCES LP / OPG PROPERTIES LLC

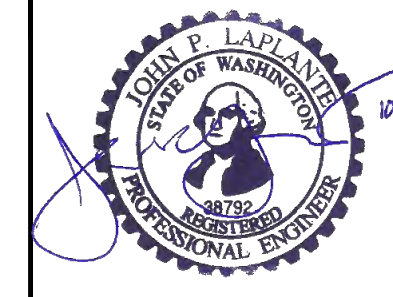

REVISIONS				
REV	DATE	BY	APP'D	DESCRIPTION
1	11/6/2017	CH	JL	RECORD DRAWINGS

DESIGNED BY: R. PICKERING
DRAWN BY: C. HEWETT
CHECKED BY: J. LAPLANTE
APPROVED BY: J. LAPLANTE
SCALE: 1" = 30'
DATE: OCTOBER 2017

**PORT GAMBLE BAY CLEANUP
RECORD DRAWINGS**

**POST-DREDGE/EXCAVATION CROSS SECTIONS
(SMA-2) 2 OF 2**

C-05

SHEET NO. 15 OF 24

ONE INCH
AT FULL SIZE, IF NOT ONE
INCH SCALE ACCORDINGLY

HOOD CANAL

FORMER MILL SITE UPLANDS

34+69 BL10

30+00 BL9

MW-2

N:317,400

BL8

BL7

MW-11

MW-4

MW-10R

MW-14

BL5

BL6

SUBSTANTIAL CHANGES WERE MADE TO THIS DRAWING INCLUDING REVISIONS TO THE CAPPING AND BACKFILL AREAS AND INCREASED MATERIAL PLACEMENT VOLUMES COMPARED TO THE FINAL DESIGN (BID SET)

- NOTES:
1. HORIZONTAL DATUM: WASHINGTON STATE PLANE NORTH ZONE, NAD83, US FEET.
 2. VERTICAL DATUM: MEAN LOWER LOW WATER (MLLW).

LEGEND

- POST-WORK CONTOURS (1' AND 5' INTERVAL)
- MONITORING WELL (PROTECT)
- INTERTIDAL CAP AREA, TYPE 1 (SEE DETAIL F ON SHEET C-17)
- INTERTIDAL CAP AREA, TYPE 2 (SEE DETAIL G ON SHEET C-17)
- INTERTIDAL CAP AREA, TYPE 3 (SEE DETAIL H ON SHEET C-17)
- ANGULAR BACKFILL AREA
- EMNR PLACEMENT AREA
- POST-DREDGE RESIDUALS COVER MANAGEMENT AREA
- SUBTIDAL CAP AREA (SEE DETAIL I ON SHEET C-17)
- EROSION AREA ARMORING
- POST-PILE REMOVAL HABITAT SUBSTRATE COVER

0 40 80
SCALE IN FEET

RECORD DRAWINGS


NORTH

ONE INCH
AT FULL SIZE, IF NOT ONE INCH SCALE ACCORDINGLY

K:\Projects\0388-Pope Resources\Port Gamble\Stairment Cleanup\RFI\Construction Plans\As-built\0388-C-07 (SMA 1 Capping Plan) dwg C-07



POPE RESOURCES LP / OPG PROPERTIES LLC

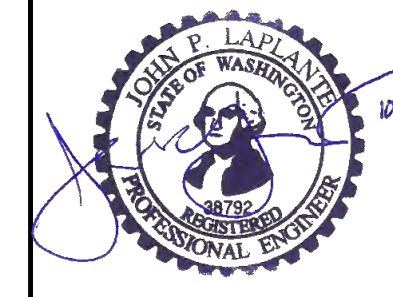

REVISIONS				
REV	DATE	BY	APP'D	DESCRIPTION
1	11/6/2017	CH	JL	RECORD DRAWINGS

DESIGNED BY: R. PICKERING
 DRAWN BY: C. HEWETT
 CHECKED BY: J. LAPLANTE
 APPROVED BY: J. LAPLANTE
 SCALE: 1" = 40'
 DATE: OCTOBER 2017


**PORT GAMBLE BAY CLEANUP
RECORD DRAWINGS**

**POST-RESIDUALS COVER AND CAPPING
CONDITIONS (SMA-1)**


C-06

SHEET NO. 16 OF 24


STUBSTANTIAL CHANGES WERE MADE TO THIS DRAWING INCLUDING REVISIONS TO THE CAPPING AND BACKFILL AREAS AND INCREASED MATERIAL PLACEMENT VOLUMES COMPARED TO THE FINAL DESIGN (BID SET)

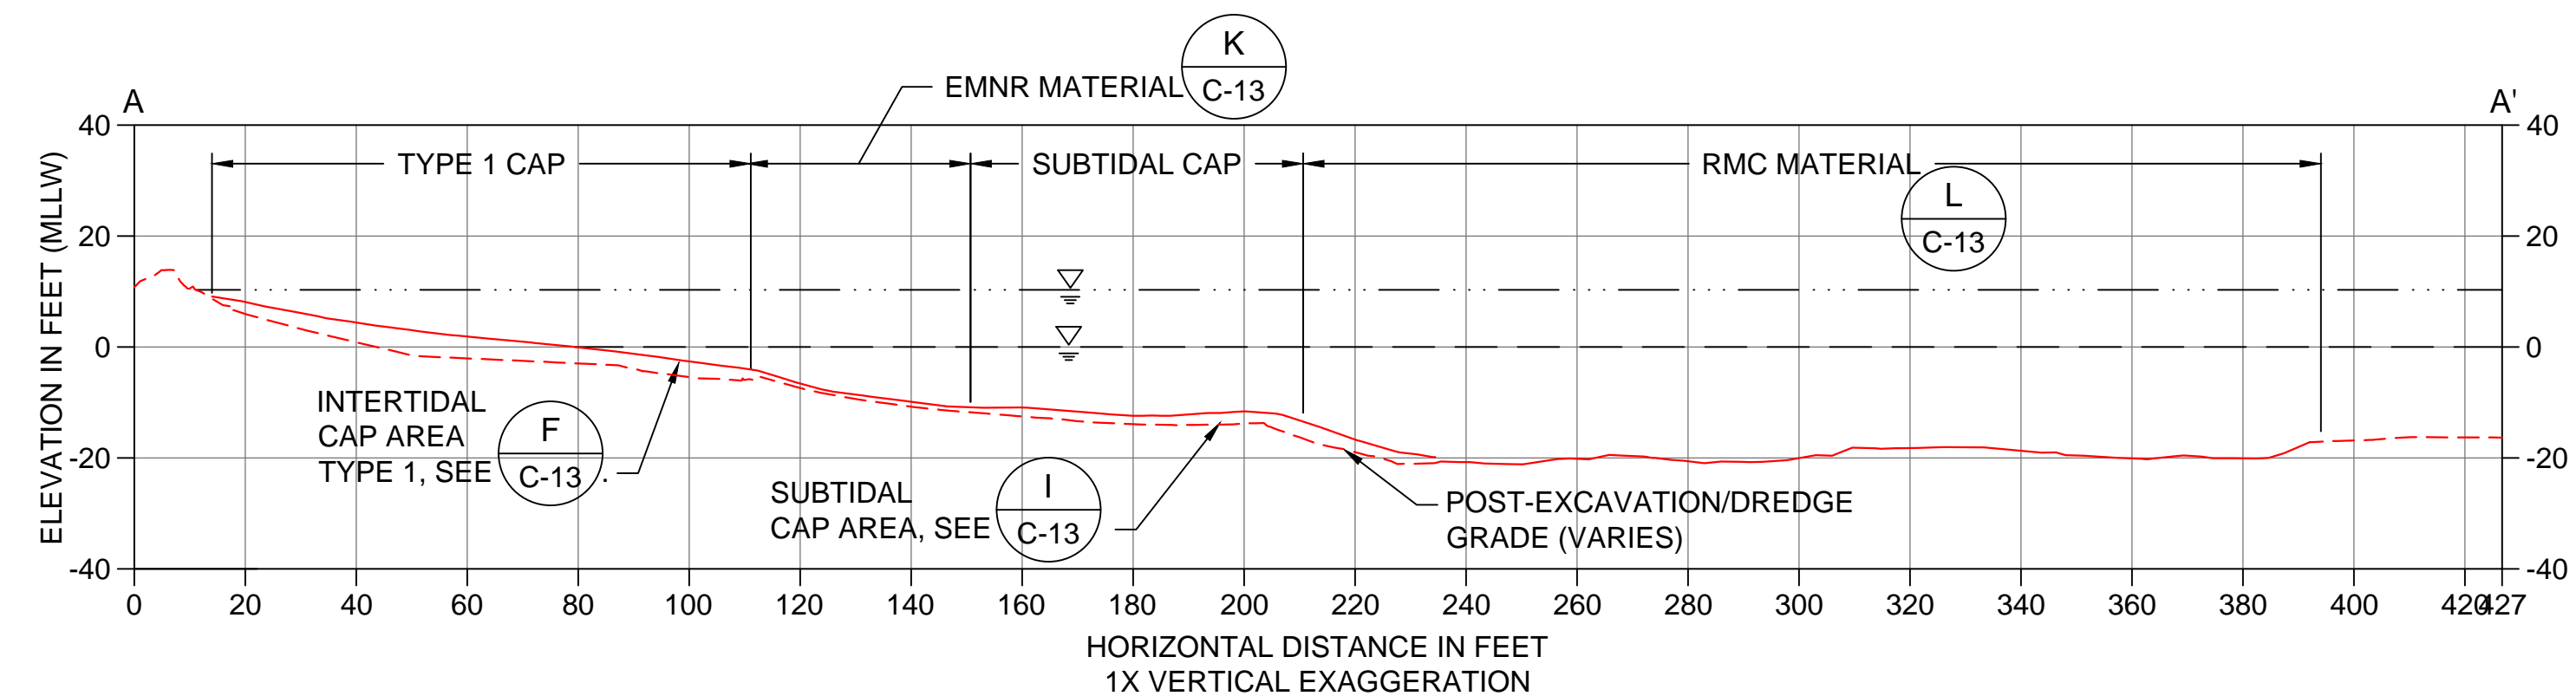


A CAPPING SECTION
C-07 SCALE: 1" = 30'

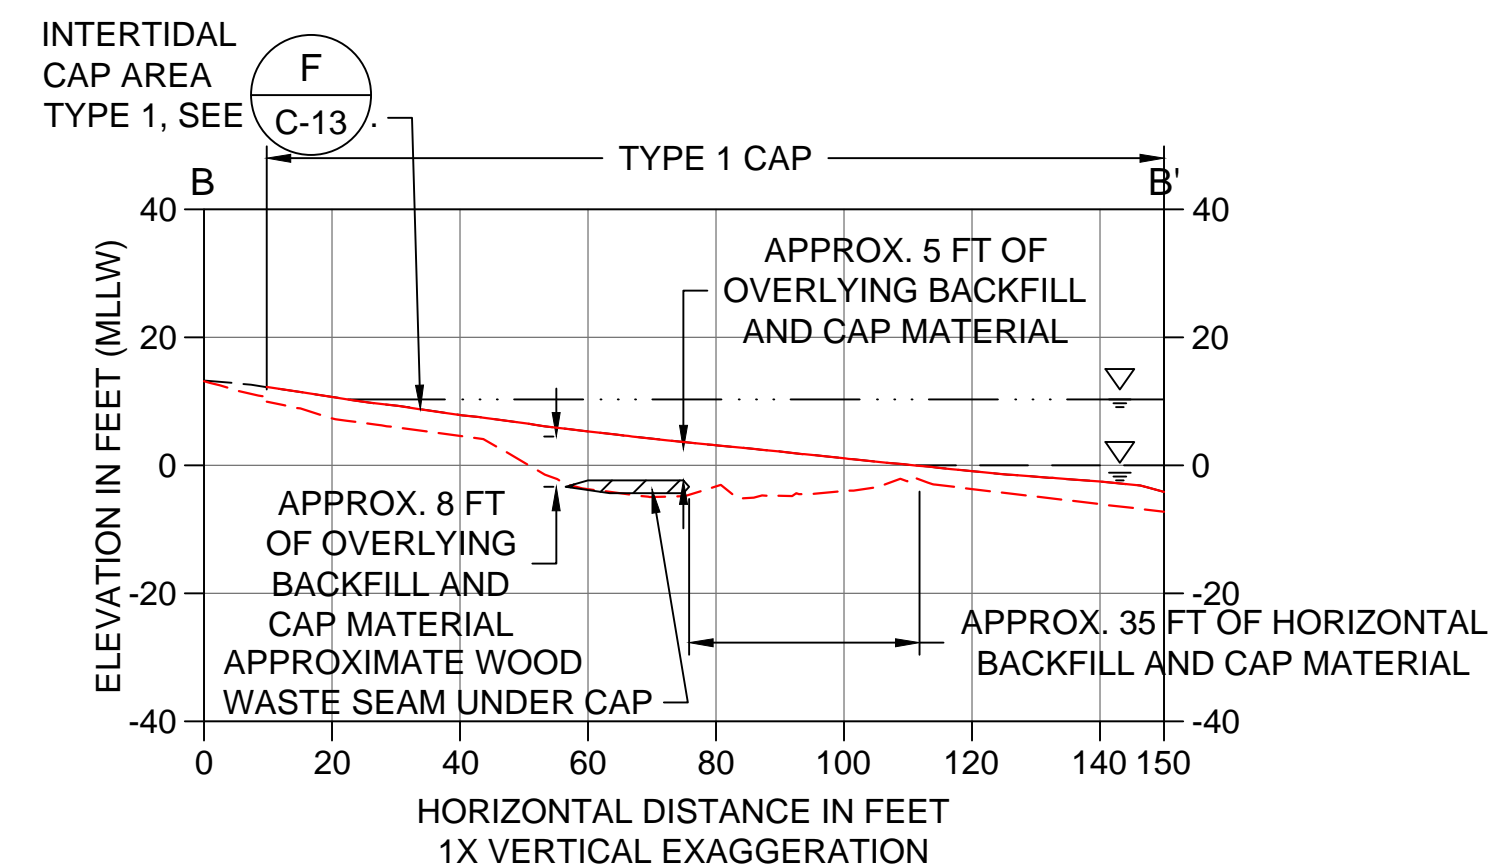


B CAPPING SECTION
C-07 SCALE: 1" = 30'

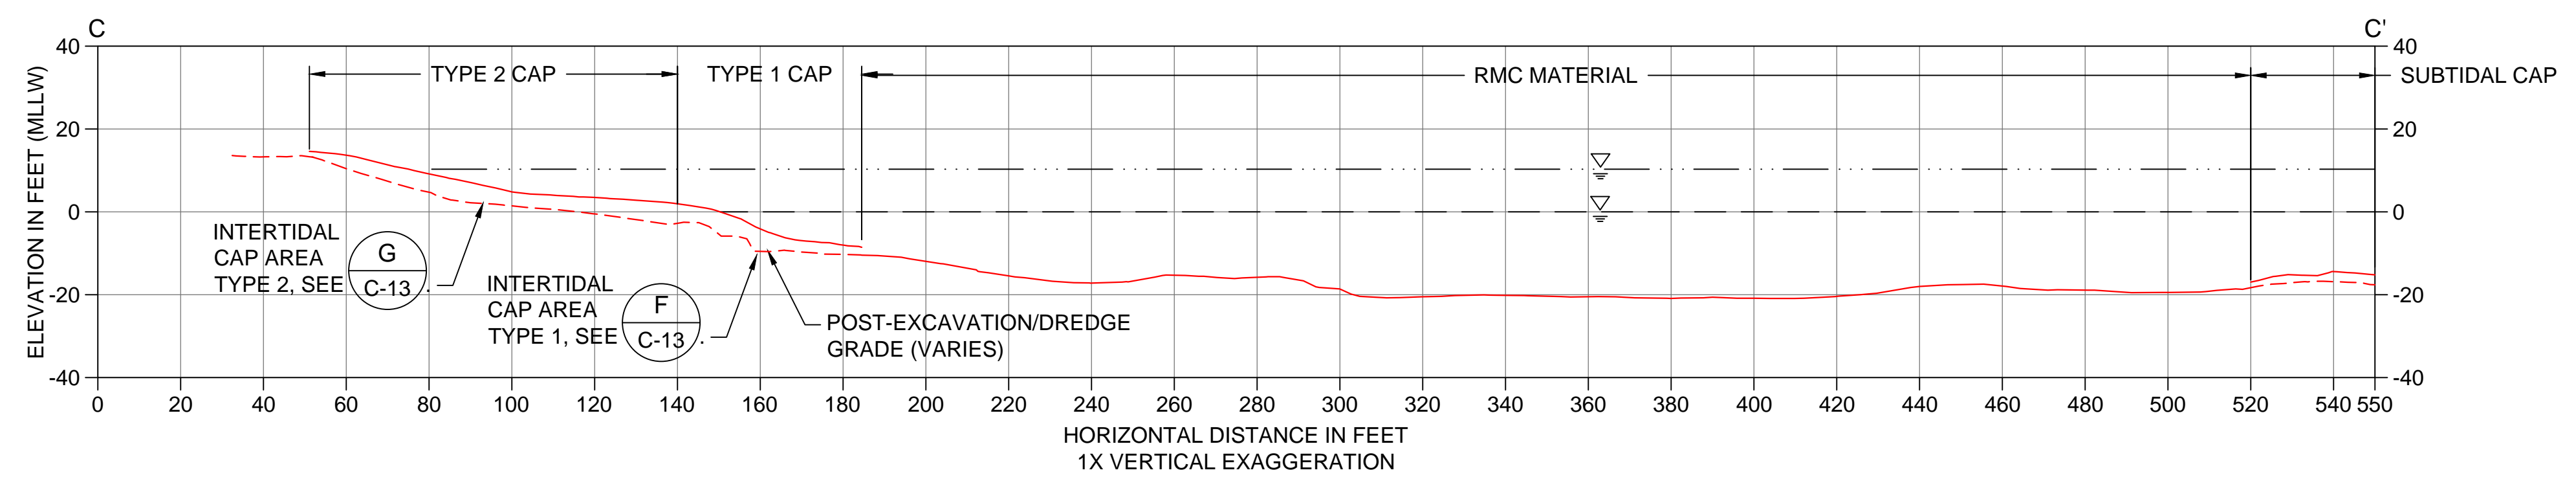

C CAPPING SECTION
C-07 SCALE: 1" = 30'

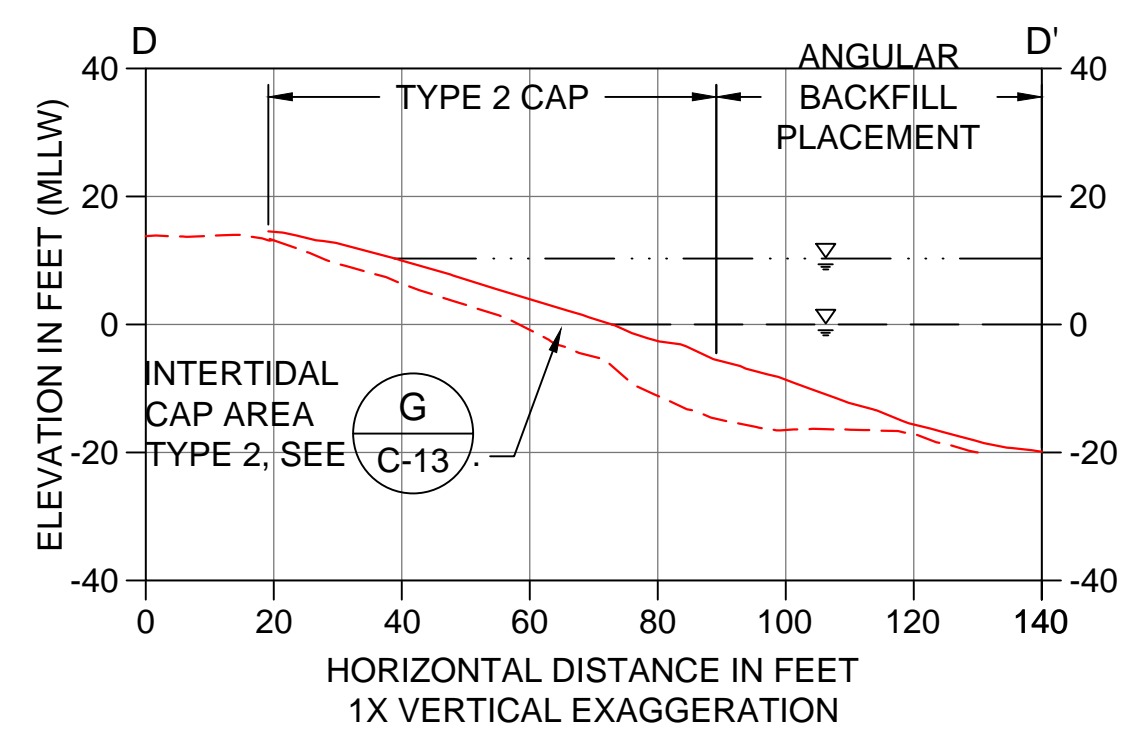

D CAPPING SECTION
C-07 SCALE: 1" = 30'

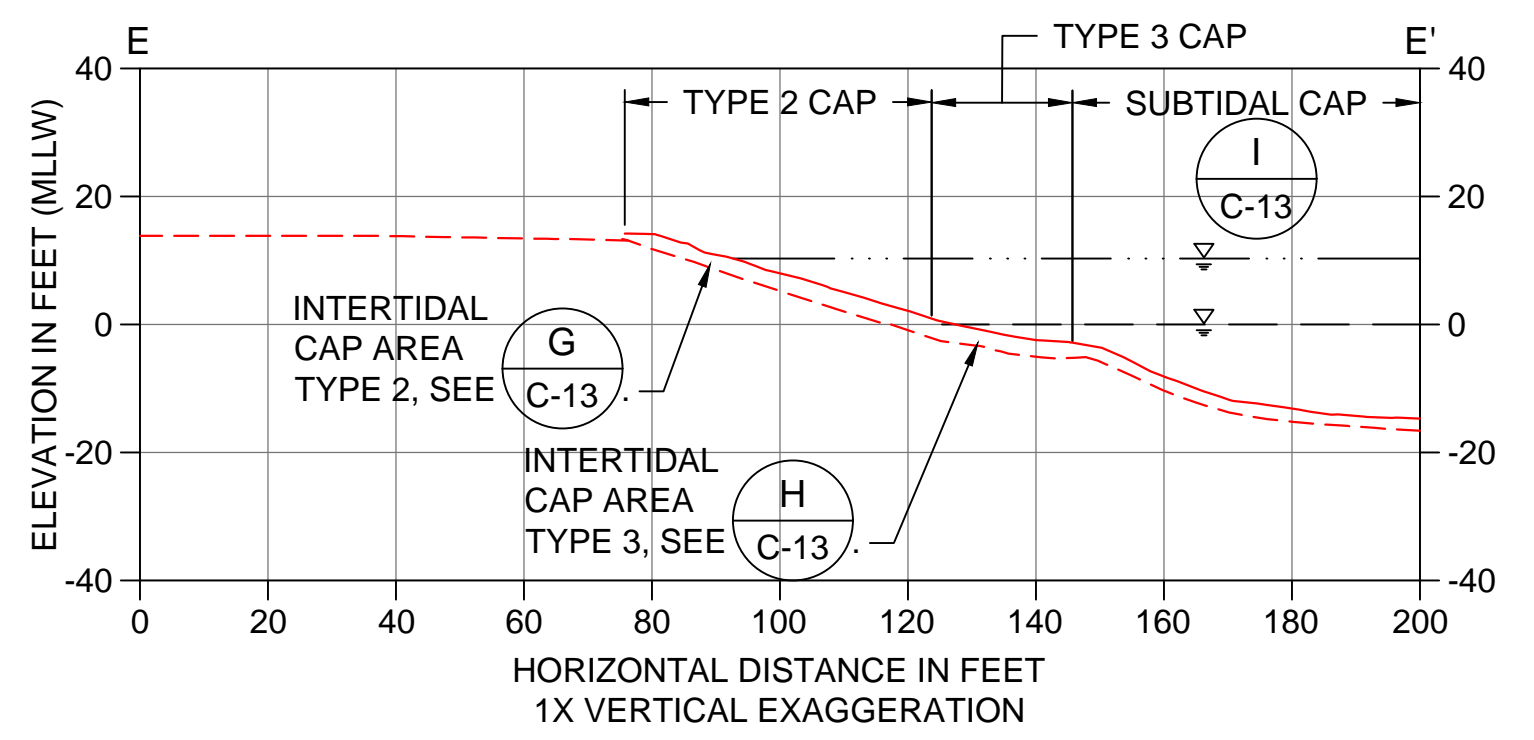

E CAPPING SECTION
C-07 SCALE: 1" = 30'

LEGEND:


- - - - - POST-DREDGE AND -EXCAVATION AS-BUILT SURVEY
- — — — INTERTIDAL AND SUBTIDAL CAP/RMC AS-BUILT SURVEY
- · - · - MEAN HIGHER HIGH WATER LINE (ELEVATION 10.3' MLLW)
- - - - - MEAN LOWER LOW WATER LINE (ELEVATION 0.0' MLLW)

0 30 60
SCALE IN FEET
RECORD DRAWINGS

K:\Projects\0388-Pope Resources\Port Gamble Sediment Cleanup R\F\Construction Plans\As-Built\0388-C-07 (SMA 1 Capping Plan) dwg C-08
Jan 04, 2018 9:55am chewett



POPE RESOURCES LP / OPG PROPERTIES LLC

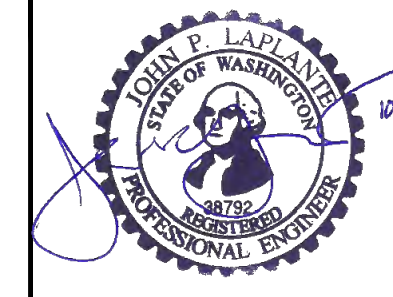

REVISIONS				
REV	DATE	BY	APP'D	DESCRIPTION
1	11/6/2017	CH	JL	RECORD DRAWINGS

DESIGNED BY: R. PICKERING
DRAWN BY: C. HEWETT
CHECKED BY: J. LAPLANTE
APPROVED BY: J. LAPLANTE
SCALE: 1" = 30'
DATE: OCTOBER 2017

**PORT GAMBLE BAY CLEANUP
RECORD DRAWINGS**

**POST-RESIDUALS COVER AND CAPPING CROSS
SECTIONS (SMA-1)**

C-07

SHEET NO. 17 OF 24