

# AS-BUILT SURVEY



NE 1/4 SW 1/4 SEC. 7  
TOWNSHIP 22 NORTH, RANGE 5 EAST W.M.  
KING COUNTY, WASHINGTON

- LEGEND:**
- EDGE OF WATER
  - ASPHALT SURFACE
  - GRAVEL SURFACE
  - FENCE
  - IE
  - CMP
  - SET LATH ON RIGHT OF WAY AUGUST 8, 2011
  - LIMITS OF DISTURBED AREA

**NOTES AND COMMENTS:**

- 1.) THE MAPPING SHOWN HEREON WITHIN THE LIMITS OF THE DISTURBED AREA REFLECTS THE RESULTS OF A FIELD SURVEY PERFORMED IN AUGUST 2011.
- 2.) THE REMAINDER OF THE MAP REFLECTS A FIELD SURVEY PERFORMED BY PLS, INC. MAY 20, 2009. FOR CLARITY PURPOSES ONLY THE CONTOURS AND A FEW MAJOR FEATURES ARE DISPLAYED HEREON.
- 3.) **HORIZONTAL DATUM:** THE OVERALL HORIZONTAL DATUM FOR THIS PROJECT IS NAD 83/91, WASHINGTON COORDINATE SYSTEM, NORTH ZONE, BASED ON GPS MEASUREMENTS USING THE WASHINGTON STATE REFERENCE NETWORK.
- 4.) **VERTICAL DATUM:** THE VERTICAL DATUM FOR THIS SURVEY IS NAVD 88, BASED ON GPS MEASUREMENTS USING THE WASHINGTON STATE REFERENCE NETWORK. REFERENCE TIED TO KING COUNTY BENCHMARK ID 3973 WITH A PUBLISHED ELEVATION OF 297.74 FEET.
- 5.) **FIELD SURVEY METHODOLOGY:** FIELD MEASUREMENTS FOR THIS TOPOGRAPHIC SURVEY WERE PERFORMED USING A 5-SECOND OR BETTER ELECTRONIC TOTAL STATION.
- 6.) **INSTRUMENT CALIBRATION:** ALL MEASURING INSTRUMENTS EMPLOYED IN THIS SURVEY HAVE BEEN MAINTAINED IN ACCORDANCE WITH MANUFACTURER'S SPECIFICATIONS.
- 7.) THIS SURVEY WAS PREPARED FOR THE EXCLUSIVE USE OF THE CLIENT NAMED HEREON. ITS USE DOES NOT EXTEND TO ANY UNNAMED PERSON OR PERSONS WITHOUT THE EXPRESS RECERTIFICATION BY THIS SURVEYOR NAMING SUCH PARTY.
- 8.) **KING COUNTY TAX PARCEL NUMBER:** 7757800265
- 9.) **UTILITY INVERT ELEVATIONS AND PIPE / FLOW LINE DIAMETERS SHOWN HEREON ARE BASED ON OBSERVATIONS FROM THE TOP OF THE UTILITY STRUCTURE AND ARE APPROXIMATE ONLY. FOR SAFETY REASONS NO PHYSICAL ENTRY INTO THE UTILITY STRUCTURE WAS PERFORMED DURING THE COURSE OF THIS SURVEY.**
- 10.) **NO EFFORT WAS MADE OR REQUESTED TO SURVEY THE PROPERTY BOUNDARY FOR THIS SITE. A BOUNDARY HAS BEEN GRAPHICALLY SHOWN BASED ON GENERAL INFORMATION FROM KING COUNTY MAP AND TAX ASSESSOR MAP, AND IS APPROXIMATE ONLY.**
- 11.) **THE GRAPHIC SIZE AND LOCATION OF SOME PHYSICAL FEATURES SUCH AS FENCES AND UTILITY STRUCTURES MAY BE SLIGHTLY EXAGGERATED FOR CLARITY PURPOSES.**

S. 218TH ST.

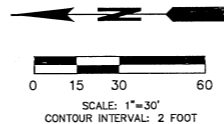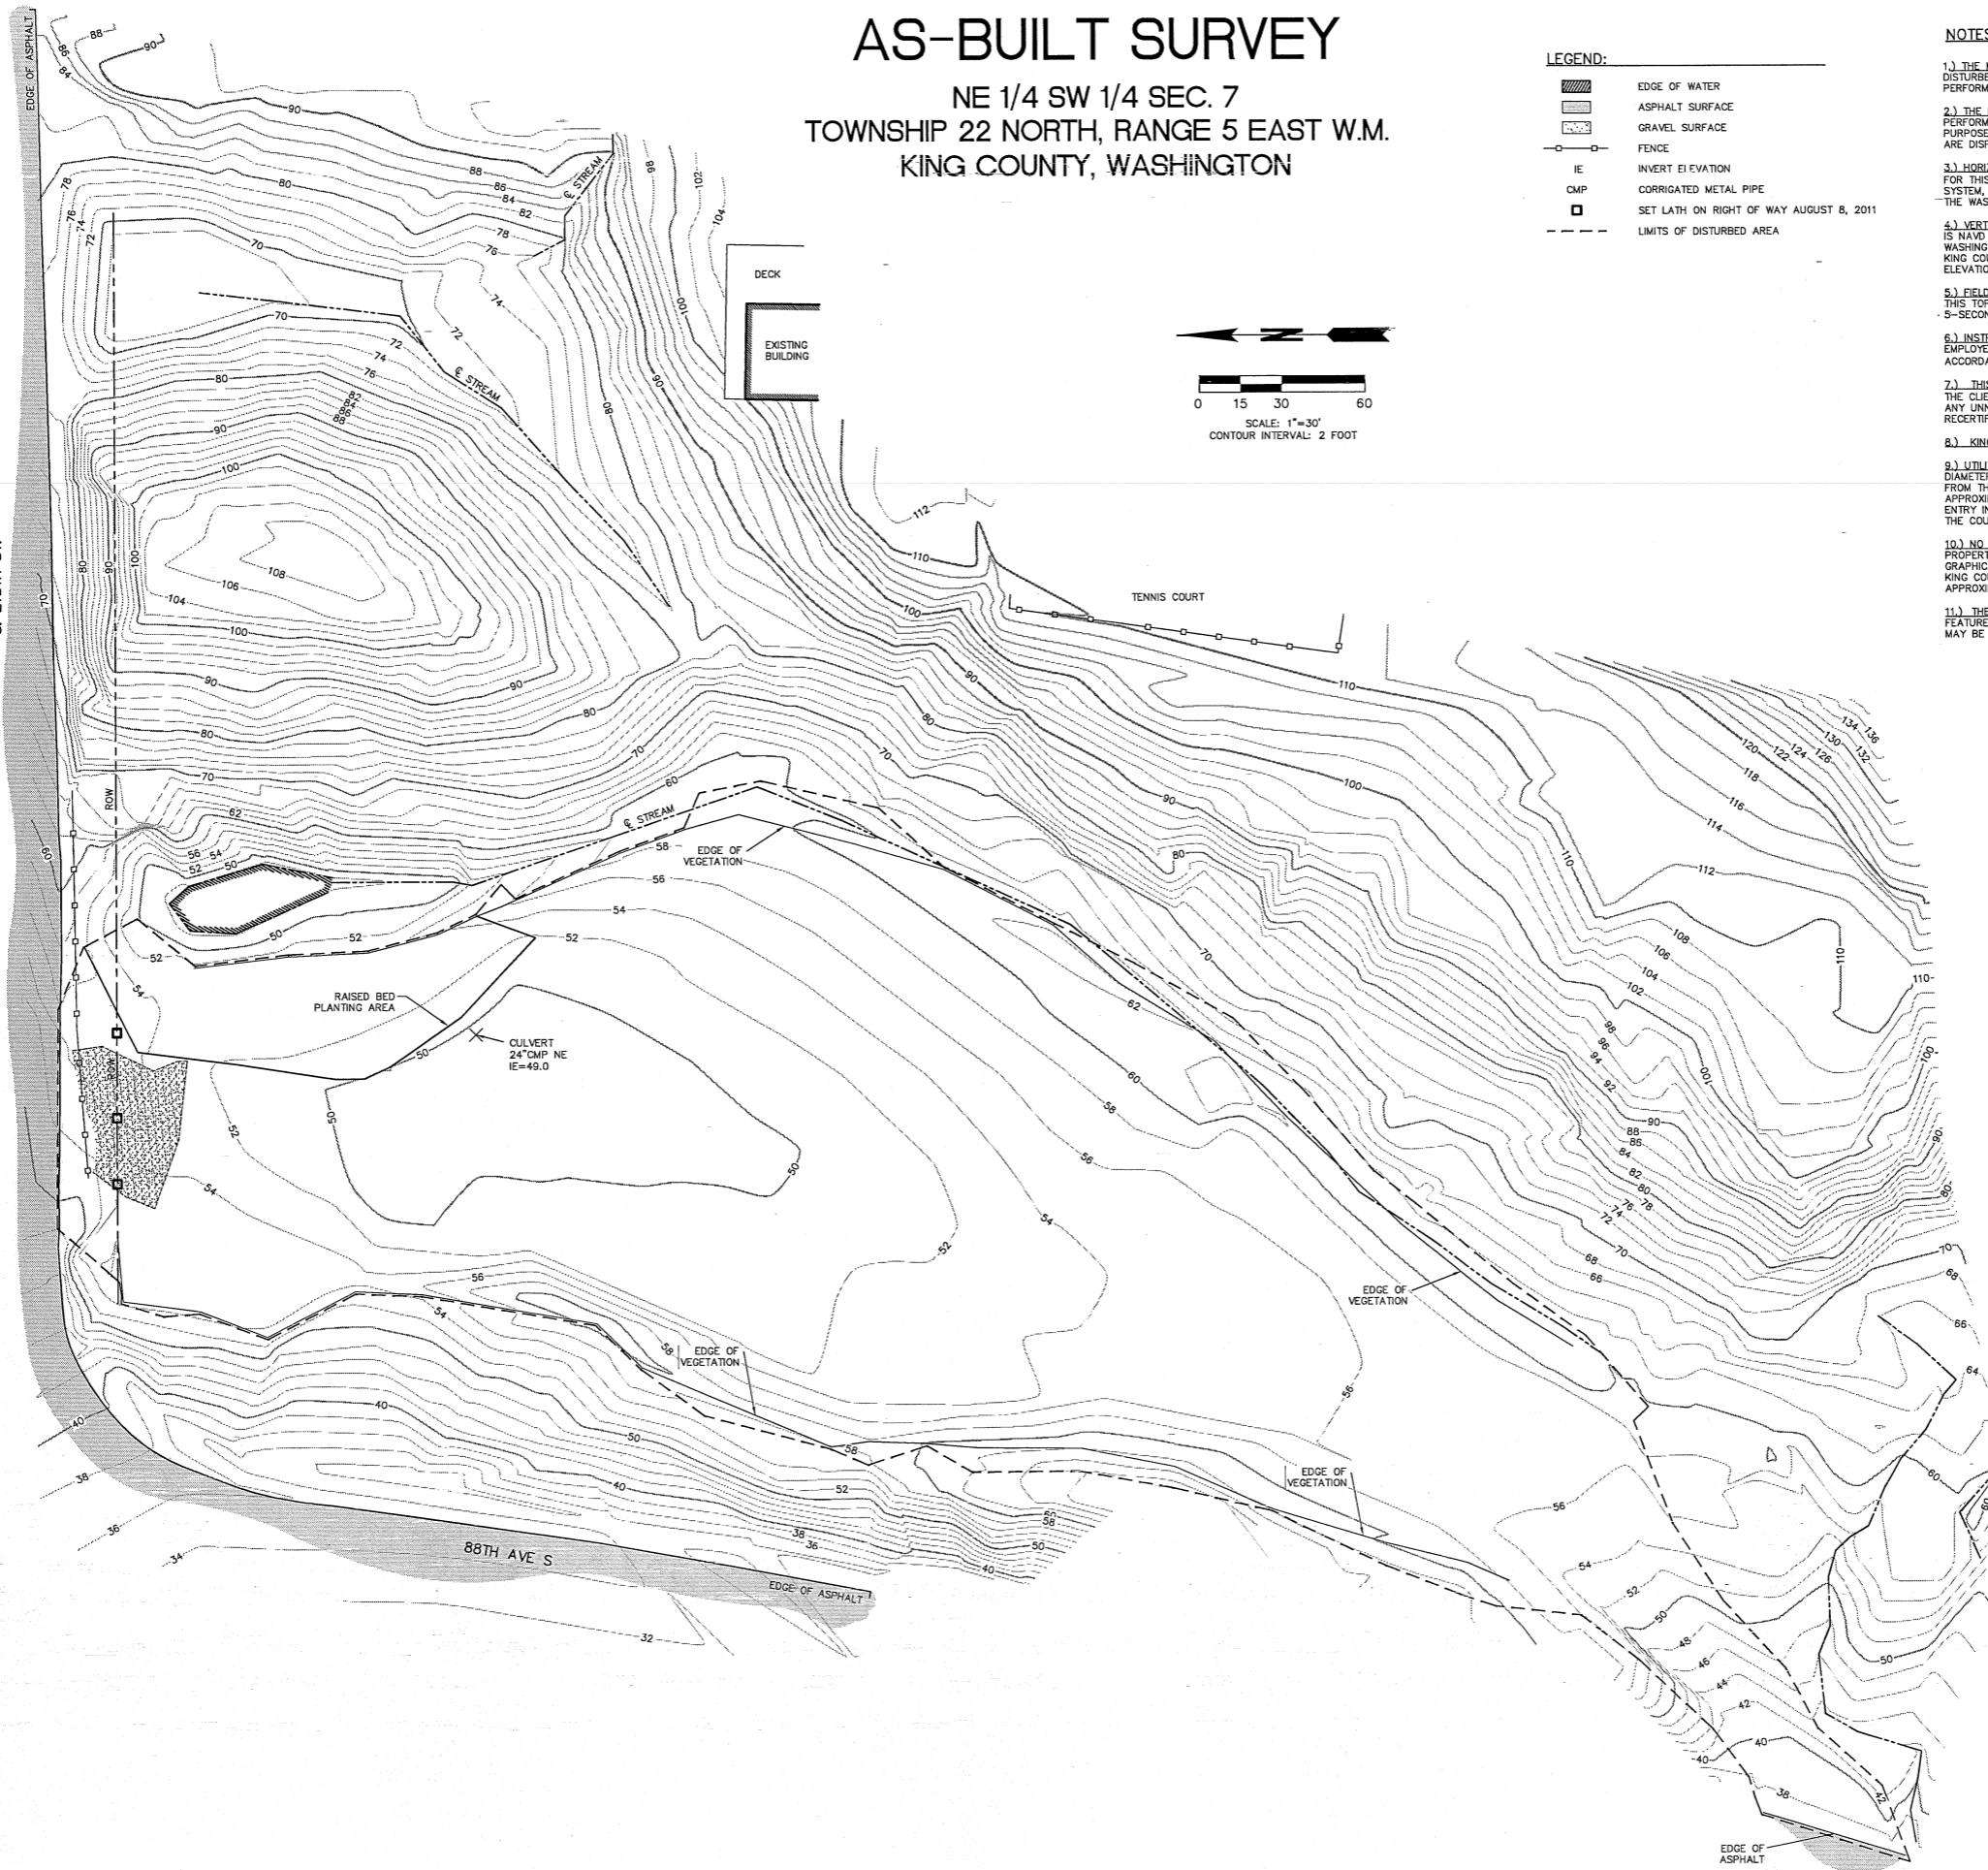

FARALLON CONSULTING, LLC  
975 5TH AVE NW  
ISSAQUAH, WA 98027



NO.	DATE	DESCRIPTION

SHEET TITLE: <b>AS-BUILT SURVEY</b>	CLIENT: <b>FARALLON CONSULTING, LLC</b>
DRAWN BY: BPM	CHECKED BY: BVP
SCALE: 1" = 30'	DATE: AUG 8, 2011
JOB NO: 11-048	
DRAWING NAME: 11-048 TOPO.DWG	
SHEET 1 of 1	

**PLS, Inc.**  
 Professional Land Surveyors  
 317 NW Gilman Boulevard, #29  
 Issaquah, Washington 98027  
 (425) 313-9378 (fax) 313-9379