

## **APPENDIX B**

### **Boring & Test Pit Logs**

Soil Classification		Terms Describing Relative Density and Consistency	
		Density	SPT <sup>(2)</sup> blows/foot
Coarse-Grained Soils - More than 50% (1) Retained on No. 200 Sieve	Gravels - More than 50% (1) of Coarse Fraction Retained on No. 4 Sieve	Well-graded gravel and gravel with sand, little to no fines	Very Loose 0 to 4
	Gravels - More than 50% (1) of Coarse Fraction Retained on No. 4 Sieve	Poorly-graded gravel and gravel with sand, little to no fines	Loose 4 to 10
	Gravels - More than 50% (1) of Coarse Fraction Retained on No. 4 Sieve	Silty gravel and silty gravel with sand	Medium Dense 10 to 30
	Gravels - More than 50% (1) of Coarse Fraction Retained on No. 4 Sieve	Clayey gravel and clayey gravel with sand	Dense 30 to 50
	Gravels - More than 50% (1) of Coarse Fraction Retained on No. 4 Sieve	Well-graded sand and sand with gravel, little to no fines	Very Dense >50
	Sands - 50% (1) or More of Coarse Fraction Passes No. 4 Sieve	Well-graded sand and sand with gravel, little to no fines	
Fine-Grained Soils - 50% (1) or More Passes No. 200 Sieve	Sands - 50% (1) or More of Coarse Fraction Passes No. 4 Sieve	Poorly-graded sand and sand with gravel, little to no fines	
	Sands - 50% (1) or More of Coarse Fraction Passes No. 4 Sieve	Silty sand and silty sand with gravel	
	Sands - 50% (1) or More of Coarse Fraction Passes No. 4 Sieve	Clayey sand and clayey sand with gravel	
	Silts and Clays Liquid Limit Less than 50	Silt, sandy silt, gravelly silt, silt with sand or gravel	
	Silts and Clays Liquid Limit Less than 50	Clay of low to medium plasticity; silty, sandy, or gravelly clay, lean clay	
	Silts and Clays Liquid Limit Less than 50	Organic clay or silt of low plasticity	
Highly Organic Soils	Silts and Clays Liquid Limit 50 or More	Elastic silt, clayey silt, silt with micaceous or diatomaceous fine sand or silt	
	Silts and Clays Liquid Limit 50 or More	Clay of high plasticity, sandy or gravelly clay, fat clay with sand or gravel	
	Silts and Clays Liquid Limit 50 or More	Organic clay or silt of medium to high plasticity	
		Peat, muck and other highly organic soils	

Component Definitions	
Descriptive Term	Size Range and Sieve Number
Boulders	Larger than 12"
Cobbles	3" to 12"
Gravel	3" to No. 4 (4.75 mm)
Coarse Gravel	3" to 3/4"
Fine Gravel	3/4" to No. 4 (4.75 mm)
Sand	No. 4 (4.75 mm) to No. 200 (0.075 mm)
Coarse Sand	No. 4 (4.75 mm) to No. 10 (2.00 mm)
Medium Sand	No. 10 (2.00 mm) to No. 40 (0.425 mm)
Fine Sand	No. 40 (0.425 mm) to No. 200 (0.075 mm)
Silt and Clay	Smaller than No. 200 (0.075 mm)

Estimated Percentage		Moisture Content
Percentage by Weight	Modifier	
<5	Trace	Dry - Absence of moisture, dusty, dry to the touch
5 to 15	Slightly (sandy, silty, clayey, gravelly)	Slightly Moist - Perceptible moisture
15 to 30	Sandy, silty, clayey, gravelly	Moist - Damp but no visible water
30 to 49	Very (sandy, silty, clayey, gravelly)	Very Moist - Water visible but not free draining
		Wet - Visible free water, usually from below water table

Symbols	
Sampler Type	Description
2.0" OD Split-Spoon Sampler (SPT)	Continuous Push
Bulk sample	Non-Standard Sampler
Grab Sample	3.0" OD Thin-Wall Tube Sampler (including Shelby tube)
	Portion not recovered

(1) Percentage by dry weight	(5) Combined USCS symbols used for fines between 5% and 15% as estimated in General Accordance with Standard Practice for Description and Identification of Soils (ASTM D-2488)
(2) (SPT) Standard Penetration Test (ASTM D-1586)	
(3) In General Accordance with Standard Practice for Description and Identification of Soils (ASTM D-2488)	
(4) Depth of groundwater	ATD = At time of drilling BGS = below ground surface

Classifications of soils in this report are based on visual field and/or laboratory observations, which include density/consistency, moisture condition, grain size, and plasticity estimates and should not be construed to imply field or laboratory testing unless presented herein. Visual-manual and/or laboratory classification methods of ASTM D-2487 and D-2488 were used as an identification guide for the Unified Soil Classification System.



## Exploration Log Key

DATE:	PROJECT NO.
DESIGNED BY:	
DRAWN BY:	FIGURE NO.
REVISED BY:	B-1

## **Boring and Monitoring Well Logs**

# LOG OF BORING BORING B-1

PROJECT: **Vashon Transfer Station Pavement Investigation**    DATE: **7-6-2017**  
 BORING LOCATION: **See Figure 2**    START: **8:05 AM**  
 BORING METHOD: **Hollow-Stem Auger**    FINISH: **8:45 AM**  
 DRILLER: **Holocene Drilling**    LOGGER: **Tim Hyden**  
 DEPTH TO - Water: **N/A**    Caving: **N/A**    DATE CHECKED: **N/A**

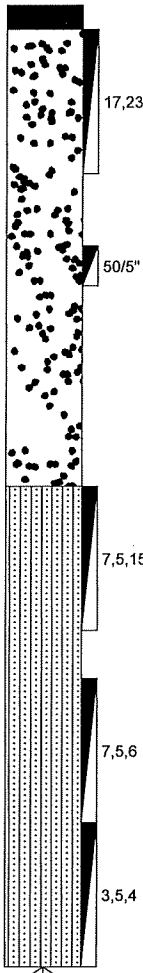
ELEVATION/ DEPTH	SOIL SYMBOLS SAMPLER SYMBOLS AND FIELD TEST DATA	USCS	Description	Moist (%)	-200 (%)	Remarks
0		GP	Asphalt Pavement Light Brown, Very Dense, Poorly Graded Sandy Gravel, Moist.			13" Recovery.    8" Recovery.  Small Piece of Plastic at 4'.
2		SM	Gray with Some Mottling, Loose to Medium Dense Predominantly Fine Silty Sand with Some Gravel, Wet.			17" Recovery   18" Recovery. Plastic in Sampler.  17" Recovery.
4						
6						
8						
10						
12						
14						

FIGURE 3

## LOG OF BORING BORING B-2

PROJECT: **Vashon Transfer Station Pavement Investigation**    DATE: **7-6-2017**  
 BORING LOCATION: **See Figure 2**    START: **8:50 AM**  
 BORING METHOD: **Hollow-Stem Auger**    FINISH: **9:45 AM**  
 DRILLER: **Holocene Drilling**    LOGGER: **Tim Hyden**  
 DEPTH TO - Water: **N/A**    Caving: **N/A**    DATE CHECKED: **N/A**




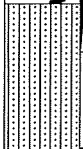
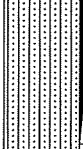

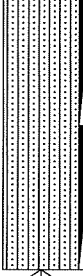

ELEVATION/ DEPTH	SOIL SYMBOLS SAMPLER SYMBOLS AND FIELD TEST DATA	USCS	Description	Moist (%)	-200 (%)	Remarks
0			Asphalt Pavement			
0 to 1.7		GP	Light Brown, Medium Dense to Very Dense, Poorly Graded Sandy Gravel, Moist.			17" Recovery.
1.7 to 3.3						14" Recovery.
3.3 to 5.0		SM	Gray with Some Mottling, Medium Dense, Fine Silty Sand with Some Gravel, Non-Plastic, Wet.			17" Recovery.
5.0 to 6.7			Gray and Reddish Brown with Some Mottling, Very Loose to Loose, Fine Silty Sand with a Trace of Gravel, Low Plasticity to Non-Plastic, Wet.			14" Recovery.
6.7 to 7.9						Organics and Paper Refuse at 8'.
7.9 to 9.1						12" Recovery. Plastic, Wood, Glass and Paper Intermixed in Sampler.
9.1 to 10.0						
10.0 to 14.0						

FIGURE 4

# LOG OF BORING

## BORING B-3

PROJECT: **Vashon Transfer Station Pavement Investigation**  
 BORING LOCATION: **See Figure 2**  
 BORING METHOD: **Hollow-Stem Auger**  
 DRILLER: **Holocene Drilling**  
 DEPTH TO - Water: **N/A**

DATE: **7-6-2017**  
 START: **9:50 AM**  
 FINISH: **10:30 AM**  
 LOGGER: **Tim Hyden**  
 DATE CHECKED: **N/A**

Caving: **N/A**



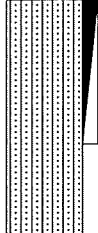
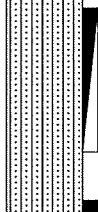
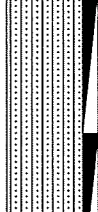
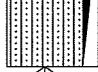
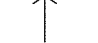
ELEVATION/ DEPTH	SOIL SYMBOLS SAMPLER SYMBOLS AND FIELD TEST DATA	USCS	Description	Moist (%)	-200 (%)	Remarks
0			Asphalt Pavement			
1.8		GP	Light Brown to Gray, Very Dense, Poorly Graded Sandy Gravel, Moist.			18" Recovery.
3.6		SM	Gray Mottled with Iron Staining, Medium Dense, Fine Silty Sand with Some Gravel, Non-plastic, Moist to Wet.			16" Recovery.
5.4			Gray with Minor Iron Staining, Loose, Fine Silty Sand with a Trace of Gravel, Non-plastic, Moist to Wet.			13" Recovery.
6.7						14" Recovery. Charcoal and Plastic in Sampler.
8.1						9" Recovery. Approx 30% by Volume (Charcoal, Plastic, Paper, Wood Fragments)
9.0						
10						
12						
14						

FIGURE 5

# LOG OF BORING BORING B-4

PROJECT: **Vashon Transfer Station Pavement Investigation**    DATE: **7-6-2017**  
 BORING LOCATION: **See Figure 2**    START: **10:35**  
 BORING METHOD: **Hollow-Stem Auger**    FINISH: **11:25 AM**  
 DRILLER: **Holocene Drilling**    LOGGER: **Tim Hyden**  
 DEPTH TO - Water: **N/A**    Caving: **N/A**    DATE CHECKED: **N/A**

ELEVATION/ DEPTH	SOIL SYMBOLS SAMPLER SYMBOLS AND FIELD TEST DATA	USCS	Description	Moist (%)	-200 (%)	Remarks
0			Asphalt Pavement			
2		GM	Gray, Very Dense, Silty, Sandy Gravel, Non-plastic, Moist.			18" Recovery
4		SM	Gray with Occasional Iron Staining, Medium Dense, Fine Silty Sand with Trace of Gravel, Non-plastic, Moist to Wet.			18" Recovery
6			Gray with Occasional Iron Staining, Loose, Fine Silty Sand with Trace of Gravel, Non-plastic, Moist to Wet.			8" Recovery. Trace Charcoal and Organics
8						7" Recovery. Charcoal, Wood Debris, Plastic in Sampler.
10						
12						
14						

FIGURE 6

## LOG OF BORING BORING B-5

PROJECT: **Vashon Transfer Station Pavement Investigation**    DATE: **7-6-2017**  
 BORING LOCATION: **See Figure 2**    START: **11:30 AM**  
 BORING METHOD: **Hollow-Stem Auger**    FINISH: **12:30 PM**  
 DRILLER: **Holocene Drilling**    LOGGER: **Tim Hyden**  
 DEPTH TO - Water: **N/A**    Caving: **N/A**    DATE CHECKED: **N/A**







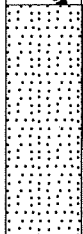
ELEVATION/ DEPTH	SOIL SYMBOLS SAMPLER SYMBOLS AND FIELD TEST DATA	USCS	Description	Moist (%)	-200 (%)	Remarks
0			Asphalt Pavement			
0 to 2.21	 27,21,14	GP	Gray, Sandy, Poorly Graded Gravel, Moist.			16" Recovery.
2.21 to 3.32	 9,32,27	SP	Gray with Minor Iron Staining, Medium Dense to Very Dense, Gravelly Poorly Graded Sand with Silt, Non-plastic, Wet.			14" Recovery.
3.32 to 5.12	 9,12,13	SM	Gray with Minor Iron Staining, Medium Dense, Fine Silty Sand with Trace of Gravel, Non-plastic, Wet.			14" Recovery.
5.12 to 8.10	 8,12,10					14" Recovery.
8.10 to 9.10	 9,10,11					16" Recovery.
9.10 to 10.00						
10 to 14						






FIGURE 7

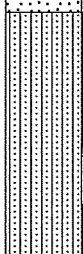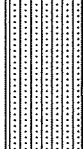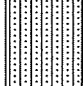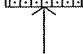


# KEY TO SYMBOLS

Symbol Description


## Strata symbols

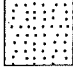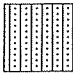	Asphalt Pavement
	Poorly graded gravel
	Poorly graded sand
	Silty sand
	Silty gravel

## Misc. Symbols

 Boring terminated

## Soil Samplers

 Standard penetration test

## Notes:

1. Holocene Drilling completed five exploratory borings on July 6, 2017.
2. A Brainard-Kilman BK-81 truck-mounted drill rig was used to advance the 4.25-inch I.D. hollow stem auger.
3. SPT testing was performed using an automatic hammer.

FIGURE 8

KING COUNTY MATERIALS LABORATORY  
GEOTECHNICAL BORING LOG

VASHON ISLAND TRANSFER STATION PAVEMENT INVESTIGATION



**King County Vashon Island Landfill - 090057**

**Environmental Exploration Log**

Project Address & Site Specific Location

Coordinates (SPN NAD83 ft)

Exploration Number

Vashon Island, East side of South Slope

E:1228104 N:162678

**B-06**

Contractor

Equipment

Sampling Method

Ground Surface (GS) Elev. (NAVD88)

Holt Services, Inc

Rotary drill rig

Rotary core

365.183'

Operator

Exploration Method(s)

Work Start/Completion Dates

Top of Casing Elev. (NAVD88)

Depth to Water (Below GS)

Pete

Sonic

4/4/2018

NA

No Water Encountered

Depth (feet)	Elev. (feet)	Exploration Completion and Notes	Sample Type/ID	Analytical Sample Number & Lab Test(s)	Field Tests	Material Type	Description	Depth (ft)
365		Gravel and topsoil surface restoration.			PID= 52.7		Dry to slightly moist, brown, Topsoil; fine to medium sand, fine subrounded gravel, numerous organics (root mass, grass)	
		3/8-inch Bentonite chip backfill 1-25 ft bgs			PID= 151		<b>Fill</b> Slightly moist, brown, gravelly, silty SAND (SM); fine to medium sand, fine subrounded to subangular gravel.	
5	360		S1		PID= 41.2			5
					CH4= 0%			
					PID= 204			
10	355				PID= 98.1			10
			S2		PID= 224			15
15	350				PID= 970			
					CH4= 0%		<b>Vashon Advance Outwash/Unit B</b> Moist, brown, SAND (SP); fine to medium sand, fine subrounded gravel.	20
20	345				PID= 146			
			S3		PID= 98.9			
					PID= 25.0			
25	340				CH4= 0%		Bottom of exploration at 25 ft. bgs.	25

**Legend**

- No Soil Sample Recovery
- Continuous core 4" ID

Water Level

No Water Encountered

See Exploration Log Key for explanation of symbols

Logged by: MML  
Approved by: JJS

**Exploration Log B-06**

Sheet 1 of 1

ASPECT STANDARD EXPLORATION LOG TEMPLATE \\BSERVER1\ASPECT\LOCAL\PROJECTS\GINT\PROJECTS\KVC VASHON\_AUGUST 2016 AND LATER.GPJ October 3, 2018



**King County Vashon Island Landfill - 090057**

**Environmental Exploration Log**

Project Address & Site Specific Location

Coordinates (SPN NAD83 ft)

Exploration Number

Vashon Island, South east corner of South Slope

E:1227949 N:162513

**B-07**

Contractor

Equipment

Sampling Method

Ground Surface (GS) Elev. (NAVD88)

Holt Services, Inc

Rotary drill rig

Rotary core

322.485'

Operator

Exploration Method(s)

Work Start/Completion Dates

Top of Casing Elev. (NAVD88)

Depth to Water (Below GS)

Pete

Sonic

4/4/2018

NA

No Water Encountered

Depth (feet)	Elev. (feet)	Exploration Completion and Notes	Sample Type/ID	Analytical Sample Number & Lab Test(s)	Field Tests	Material Type	Description	Depth (ft)
		Gravel and topsoil surface restoration.					Dry to slightly moist, brown, Topsoil; fine to medium sand, fine subrounded gravel, numerous organics (root mass, grass)	
320		3/8-inch Bentonite chip backfill 1-25 ft bgs			PID= 131.1		<b>Fill</b> Moist, brown, slightly gravelly, silty SAND (SM); fine to medium sand, fine subrounded to subangular gravel, rare root fibers.	5
5			S1		PID= 108.3			
315					PID= 21.9			
10					CH4= 0%		<b>Landfill Debris</b> Very moist, black to gray, silty, sandy, gravelly Fill; plastic scraps, paper, cardboard, glass, garbage bags, etc.	10
310			S2		PID= 86.5			
15					PID= 123.5		Moist, brown SAND (SP); trace silt, fine to medium sand, trace root fibers, 5-10% debris (plastic scraps, garbage bags, glass).	15
305			S3		PID= 18.7			
20					CH4= 0%		<b>Vashon Advance Outwash/Unit B</b> Moist, brown, SAND (SP); fine to medium sand, fine subrounded gravel.	20
300					PID= 13.5			
25					PID= 20.1		Bottom of exploration at 25 ft. bgs.	25
295					CH4= 0%			

**Legend**

- No Soil Sample Recovery
- Continuous core 4" ID

Water Level

No Water Encountered

See Exploration Log Key for explanation of symbols

Logged by: MML  
Approved by: JJS

**Exploration Log B-07**

Sheet 1 of 1

ASPECT STANDARD EXPLORATION LOG TEMPLATE \\BSERVER1\ASPECT\LOCAL\PROJECTS\GINT\PROJECTS\KVC VASHON\_AUGUST 2016 AND LATER.GPJ October 3, 2018



**King County Vashon Island Landfill - 090057**

**Environmental Exploration Log**

Project Address & Site Specific Location

Coordinates (SPN NAD83 ft)

Exploration Number

Vashon Island, South end of South Slope

E:1227832 N:162514

**B-08**

Contractor

Equipment

Sampling Method

Ground Surface (GS) Elev. (NAVD88)

Holt Services, Inc

Rotary drill rig

Rotary core

331.764'

Operator

Exploration Method(s)

Work Start/Completion Dates

Top of Casing Elev. (NAVD88)

Depth to Water (Below GS)

Pete

Sonic

4/4/2018

NA

No Water Encountered

Depth (feet)	Elev. (feet)	Exploration Completion and Notes	Sample Type/ID	Analytical Sample Number & Lab Test(s)	Field Tests	Material Type	Description	Depth (ft)
		Gravel and topsoil surface restoration.			PID= 62.8		Dry to slightly moist, brown, Topsoil; fine to medium sand, fine subrounded gravel, numerous organics (root mass, grass)	
330		3/8-inch Bentonite chip backfill 1-25 ft bgs			PID= 330		<b>Fill</b> Moist, brown, slightly gravelly, silty SAND (SM); fine to medium sand, fine subrounded to subangular gravel, rare root fibers.	
5			S1		PID= 362			
					CH4= 0.1%			
					PID= 50.7			
325					PID= 398		<b>Vashon Advance Outwash/Unit B</b> Moist, brown, gravelly SAND (SP); fine to medium sand, fine subrounded gravel.	
10					PID= 35.2			
					CH4= 0%			
					PID= 86.5		Sand becomes fine between 11 and 11.5 ft bgs.	
320					PID= 301			
15			S2		PID= 247		Sand becomes fine to coarse 15 to 16.5 ft bgs.	
					PID= 51.0		3-inch lens of brittle, slightly silty sand.	
20					CH4= 0%			
					PID= 78.5			
310			S3		PID= 69.6		1.5-inch silty sand lens.	
					CH4= 0%		Bottom of exploration at 25 ft. bgs.	
25								
305								

**Legend**

Continuous core 4" ID

Water Level

No Water Encountered

See Exploration Log Key for explanation of symbols

Logged by: MML  
Approved by: JJS

**Exploration Log B-08**

Sheet 1 of 1

ASPECT STANDARD EXPLORATION LOG TEMPLATE \\BSERVER1\ASPECT\LOCAL\PROJECTS\GINT\PROJECTS\K VASHON\_AUGUST 2016 AND LATER.GPJ October 3, 2018



**King County Vashon Island Landfill - 090057**

**Environmental Exploration Log**

Project Address & Site Specific Location

Coordinates (SPN NAD83 ft)

Exploration Number

Vashon Island, South end of South Slope

E:1227788 N:162585

**B-09**

Contractor

Equipment

Sampling Method

Ground Surface (GS) Elev. (NAVD88)

Holt Services, Inc

Rotary drill rig

Rotary core

358.793'

Operator

Exploration Method(s)

Work Start/Completion Dates

Top of Casing Elev. (NAVD88)

Depth to Water (Below GS)

Pete

Sonic

4/4/2018

NA

No Water Encountered

Depth (feet)	Elev. (feet)	Exploration Completion and Notes	Sample Type/ID	Analytical Sample Number & Lab Test(s)	Field Tests	Material Type	Description	Depth (ft)
5	355	Gravel and topsoil surface restoration. 3/8-inch Bentonite chip backfill 1-40 ft bgs	S1		PID= 132 PID= 213 PID= 95.6		<b>Fill</b> Moist, brown, gravelly, silty SAND (SM); fine to medium sand, fine to coarse subrounded to subangular gravel, rare root fibers, cobbles. Becomes brown gray. Grades to dark brown gray.	5
10	350				PID= 40.1 CH4= 0% PID= 91.5			10
15	345		S2		PID= 142.6			15
20	340				PID= 54.2 PID= 45.1 CH4= 0% PID= 38.4		<b>Alluvium</b> Moist, orange brown, gravelly, SAND (SP); trace silt, fine to medium sand, fine subround to subangular gravel. Grades to brown. Woody branches, and twigs between 17.5 to 18. <b>Vashon Advance Outwash/Unit B</b> Moist, gray brown, gravelly SAND (SP); fine to medium sand, fine subrounded gravel.	20
25	335		S3		PID= 149.1 PID= 144.9			25
30	330				PID= 36.3 PID= 108		Sand becomes fine between 29 to 29.5. Sand becomes fine to coarse; gravel becomes trace, fine, and subrounded.	30
35	325		S4		PID= 65.4 PID= 17.2			35
40	320				PID= 35.1 CH4= 0%		Sand becomes fine 39 to 40. Bottom of exploration at 40 ft. bgs.	40

**Legend**

Continuous core 4" ID

Water Level

No Water Encountered

See Exploration Log Key for explanation of symbols

Logged by: MML  
Approved by: JJS

**Exploration Log B-09**

Sheet 1 of 1

ASPECT STANDARD EXPLORATION LOG TEMPLATE \\BSERVER1\ASPECT\LOCAL\PROJECTS\GINT\PROJECTS\KVC VASHON\_AUGUST 2016 AND LATER.GPJ October 3, 2018



**King County Vashon Island Landfill - 090057**

**Environmental Exploration Log**

Project Address & Site Specific Location

Coordinates (SPN NAD83 ft)

Exploration Number

Vashon Island, Southwest corner of South Pond

E:1227715 N:162694

**B-10**

Contractor

Equipment

Sampling Method

Ground Surface (GS) Elev. (NAVD88)

Holt Services, Inc

Rotary drill rig

Rotary core

359.497'

Operator

Exploration Method(s)

Work Start/Completion Dates

Top of Casing Elev. (NAVD88)

Depth to Water (Below GS)

Pete

Sonic

4/3/2018

NA

No Water Encountered

Depth (feet)	Elev. (feet)	Exploration Completion and Notes	Sample Type/ID	Analytical Sample Number & Lab Test(s)	Field Tests	Material Type	Description	Depth (ft)
5	355	Gravel and topsoil surface restoration. 3/8-inch Bentonite chip backfill 1-30 ft bgs	S1		PID= 221		<b>Fill</b> Moist, brown, gravelly, silty SAND (SM); fine to medium sand, fine to coarse subrounded to subangular gravel, rare root fibers, cobbles.	5
10	350				PID= 150.8 PID= 116 CH4= 0%			10
15	345		S2		PID= 20.1 CH4= 0% PID= 8.1		<b>Vashon Advance Outwash/Unit B</b> Moist, brown, slightly gravelly SAND (SP); fine to medium sand, fine subrounded gravel.	15
20	340				PID= 10.7 PID= 3.8 CH4= 0%		Oxidized layer 0.5 inches thick.	20
25	335		S3		PID= 48.8 CH4= 0% PID= 22.1			25
30	330				PID= 12.1 PID= 23.5		Sand becomes silty and fine between 28 to 28.5.	30
							Bottom of exploration at 30 ft. bgs.	

**Legend**

- No Soil Sample Recovery
- Continuous core 4" ID

Water Level

No Water Encountered

See Exploration Log Key for explanation of symbols

Logged by: MML  
Approved by: JJS

**Exploration Log B-10**

Sheet 1 of 1

ASPECT STANDARD EXPLORATION LOG TEMPLATE \\BSERVER1\ASPECT\LOCAL\PROJECTS\GINT\PROJECTS\K VASHON\_AUGUST 2016 AND LATER.GPJ October 3, 2018



**King County Vashon Island Landfill - 090057**

**Environmental Exploration Log**

Project Address & Site Specific Location

Coordinates (SPN NAD83 ft)

Exploration Number

Vashon Island, Outside of fence on West Perimeter Road

E:1227868 N:163713

**B-11**

Contractor

Equipment

Sampling Method

Ground Surface (GS) Elev. (NAVD88)

Holt Services, Inc

Rotary drill rig

Rotary core

405.979'

Operator

Exploration Method(s)

Work Start/Completion Dates

Top of Casing Elev. (NAVD88)

Depth to Water (Below GS)

Pete

Sonic

4/5/2018

NA

No Water Encountered

Depth (feet)	Elev. (feet)	Exploration Completion and Notes	Sample Type/ID	Analytical Sample Number & Lab Test(s)	Field Tests	Material Type	Description	Depth (ft)
405		Gravel and topsoil surface restoration.			PID= 219		Dry to slightly moist, brown, silty, sandy Topsoil; fine to medium sand, fine subrounded gravel, numerous organics (root mass, grass)	
		3/8-inch Bentonite chip backfill 1-20 ft bgs					<b>Fill</b> Moist, brown, gravelly, silty SAND (SM); fine to medium sand, fine subrounded to subangular gravel, rare root fibers, rare scattered pieces of glass (<1%).	
5			S1		PID= 102		<b>Vashon Till/Unit A</b> Moist, brown, gravelly silty SAND (SM); fine to medium sand, fine to coarse subrounded to subangular gravel.	5
					PID= 176		Becomes gray.	
10					CH4= 0.1%			10
					PID= 240			
15			S2		PID= 271			15
					PID= 216			
					PID= 267			
20					CH4= 0%			20
							Bottom of exploration at 20 ft. bgs.	

**Legend**

- No Soil Sample Recovery
- Continuous core 4" ID

Water Level

No Water Encountered

See Exploration Log Key for explanation of symbols

Logged by: MML  
Approved by: JJS

**Exploration Log B-11**

Sheet 1 of 1

ASPECT STANDARD EXPLORATION LOG TEMPLATE \\BSERVER1\ASPECT\LOCAL\PROJECTS\GINT\PROJECTS\KVC VASHON\_AUGUST 2016 AND LATER.GPJ October 3, 2018



**King County Vashon Island Landfill - 090057**

**Environmental Exploration Log**

Project Address & Site Specific Location

Coordinates (SPN NAD83 ft)

Exploration Number

Vashon Island, Outside of fence on West Perimeter Road

E:1227829 N:163599

**B-12**

Contractor

Equipment

Sampling Method

Ground Surface (GS) Elev. (NAVD88)

Holt Services, Inc

Rotary drill rig

Rotary core

402.774'

Operator

Exploration Method(s)

Work Start/Completion Dates

Top of Casing Elev. (NAVD88)

Depth to Water (Below GS)

Pete

Sonic

4/5/2018

NA

No Water Encountered

Depth (feet)	Elev. (feet)	Exploration Completion and Notes	Sample Type/ID	Analytical Sample Number & Lab Test(s)	Field Tests	Material Type	Description	Depth (ft)
		Gravel and topsoil surface restoration.					Dry to slightly moist, brown, silty, sandy Topsoil; fine to medium sand, fine subrounded gravel, numerous organics (root mass, grass)	
		3/8-inch Bentonite chip backfill 1-20 ft bgs					<b>Fill</b> Moist, brown, gravelly, SAND (SP); fine to medium sand, fine subrounded to subangular gravel, rare root fibers, rare scattered pieces of glass (<1%).	
400			S1		PID= 209			
5					PID= 94.4		<b>Vashon Till/Unit A</b> Moist, brown, gravelly silty SAND (SM); fine to medium sand, fine to coarse subrounded to subangular gravel.	5
					PID= 915		Becomes gray.	
395					PID= 472			
10					CH4= 0%			10
					PID= 383			
390			S2		PID= 560			15
15					PID= 398		Includes cobbles.	
385					PID= 748			
20					CH4= 0.1%		Bottom of exploration at 20 ft. bgs.	20

**Legend**

- No Soil Sample Recovery
- Continuous core 4" ID

Water Level

No Water Encountered

See Exploration Log Key for explanation of symbols


Logged by: MML  
Approved by: JJS

**Exploration Log B-12**

Sheet 1 of 1

ASPECT STANDARD EXPLORATION LOG TEMPLATE \\BSERVER1\ASPECT\LOCAL\PROJECTS\GINT\PROJECTS\KVC VASHON\_AUGUST 2016 AND LATER.GPJ October 3, 2018



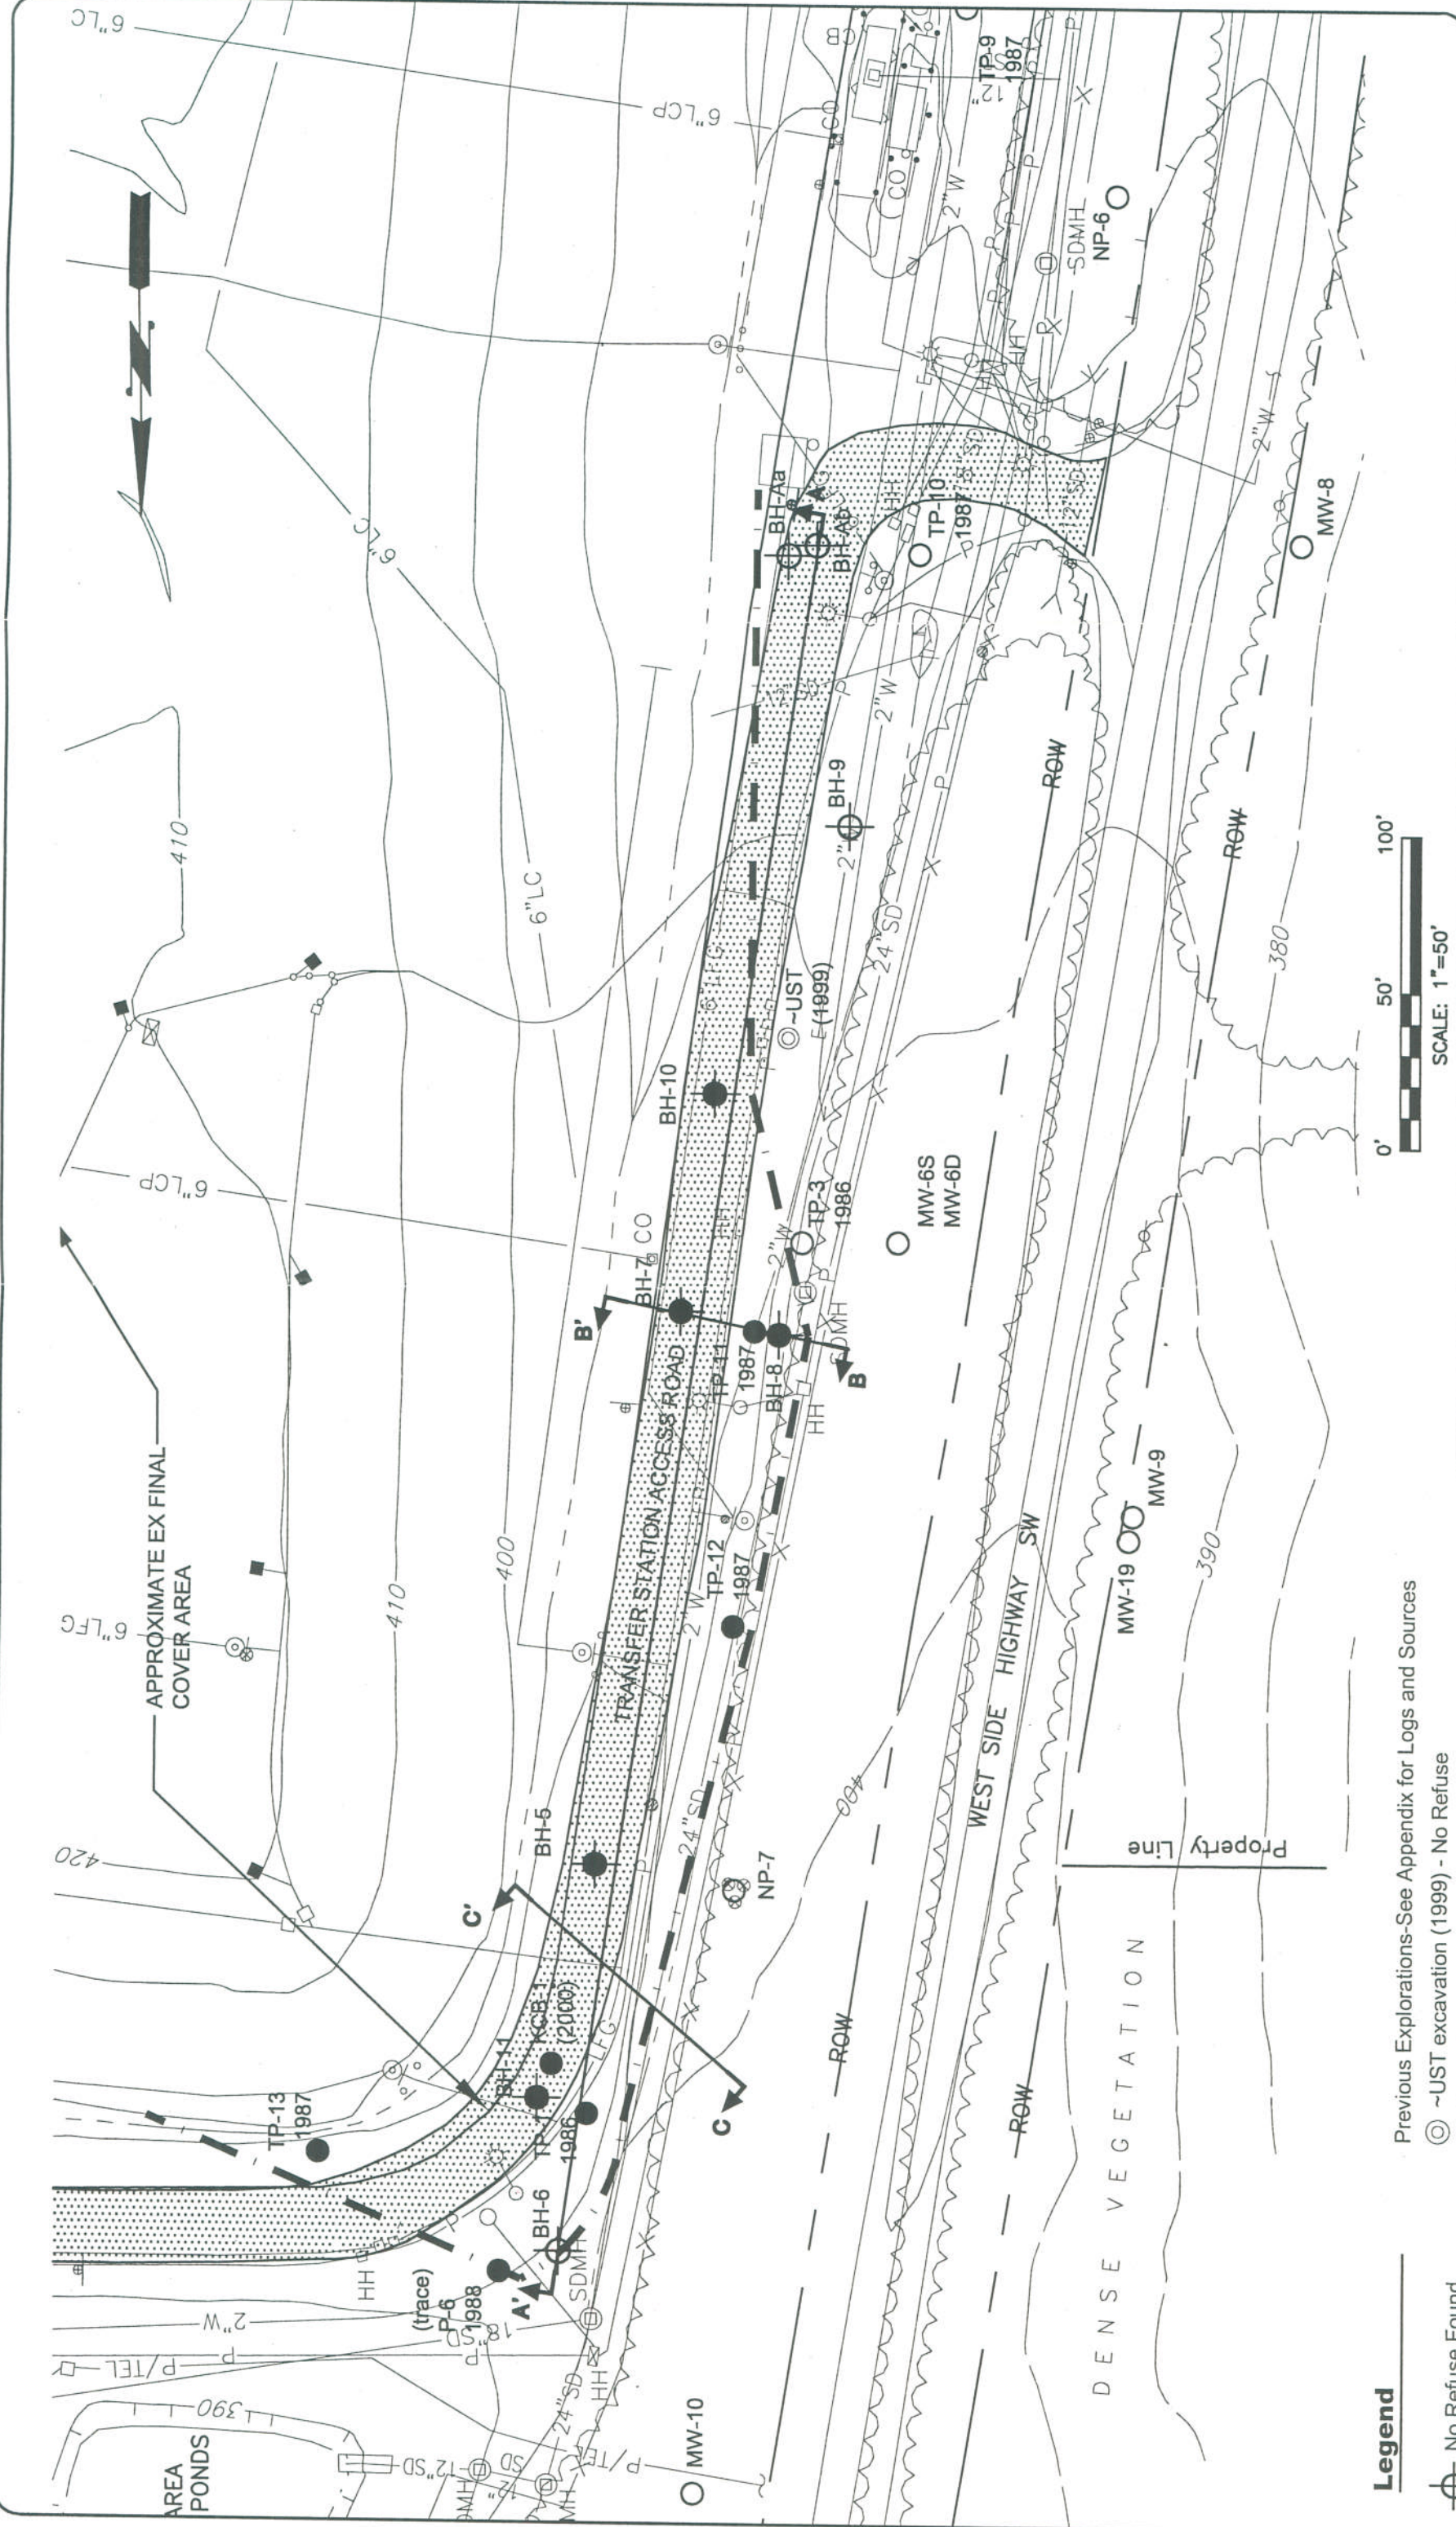

**Legend**

- ⊕ No Refuse Found (HWA, 2001)
- Refuse Found (HWA, 2001)
- No Refuse Found
- Refuse Found
- Interpreted Limits of Refuse (HWA, 2001)
- Geologic Cross Section

Previous Explorations-See Appendix for Logs and Sources  
 ⊕ ~UST excavation (1999) - No Refuse  
 ○ No Refuse Found  
 ● Refuse Found  
 — Interpreted Limits of Refuse (HWA, 2001)



**HWA**  
 GEOSCIENCES INC.

TRANSFER STATION  
 ACCESS ROAD ASSESSMENT  
 VASHON, WASHINGTON

SITE AND EXPLORATION PLAN

DRAWN BY PL  
 CHECKED BY SG  
 DATE

06.12.01

FIGURE NO.

**2**

PROJECT NO.

98158-4.01

## RELATIVE DENSITY OR CONSISTENCY VERSUS SPT N-VALUE

COHESIONLESS SOILS			COHESIVE SOILS		
Density	N (blows/ft)	Approximate Relative Density (%)	Consistency	N (blows/ft)	Approximate Undrained Shear Strength (psf)
Very Loose	0 to 4	0 - 15	Very Soft	0 to 2	<250
Loose	4 to 10	15 - 35	Soft	2 to 4	250 - 500
Medium Dense	10 to 30	35 - 65	Medium Stiff	4 to 8	500 - 1000
Dense	30 to 50	65 - 85	Stiff	8 to 15	1000 - 2000
Very Dense	over 50	85 - 100	Very Stiff Hard	15 to 30 over 30	2000 - 4000 >4000

## TEST SYMBOLS

%F	Percent Fines
AL	Atterberg Limits: PL = Plastic Limit LL = Liquid Limit
CBR	California Bearing Ratio
CN	Consolidation
DD	Dry Density (pcf)
DS	Direct Shear
GS	Grain Size Distribution
K	Permeability
MD	Moisture/Density Relationship (Proctor)
MR	Resilient Modulus
PID	Photoionization Device Reading
PP	Pocket Penetrometer Approx. Compressive Strength (tsf)
SG	Specific Gravity
TC	Triaxial Compression
TV	Torvane Approx. Shear Strength (tsf)
UC	Unconfined Compression

## USCS SOIL CLASSIFICATION SYSTEM

MAJOR DIVISIONS			GROUP DESCRIPTIONS		
Coarse Grained Soils	Gravel and Gravelly Soils	Clean Gravel (little or no fines)		GW Well-graded GRAVEL	
		Gravel with Fines (appreciable amount of fines)		GP Poorly-graded GRAVEL	
	More than 50% of Coarse Fraction Retained on No. 4 Sieve	Sand and Sandy Soils	Clean Sand (little or no fines)		SW Well-graded SAND
			Sand with Fines (appreciable amount of fines)		SP Poorly-graded SAND
More than 50% Retained on No. 200 Sieve Size	Silt and Clay	Liquid Limit Less than 50%		ML SILT	
		Liquid Limit 50% or More		CL Lean CLAY	
	50% or More Passing No. 200 Sieve Size	Silt and Clay	Liquid Limit Less than 50%		OL Organic SILT/Organic CLAY
			Liquid Limit 50% or More		MH Elastic SILT
		Liquid Limit 50% or More		CH Fat CLAY	
		Liquid Limit 50% or More		OH Organic SILT/Organic CLAY	
Highly Organic Soils				PT PEAT	

## SAMPLE TYPE SYMBOLS

	2.0" OD Split Spoon (SPT) (140 lb. hammer with 30 in. drop)
	Shelby Tube
	3-1/4" OD Split Spoon with Brass Rings
	Small Bag Sample
	Large Bag (Bulk) Sample
	Core Run
	Non-standard Penetration Test (3.0" OD split spoon)

## GROUNDWATER SYMBOLS

	Groundwater Level (measured at time of drilling)
	Groundwater Level (measured in well or open hole after water level stabilized)

## COMPONENT DEFINITIONS

COMPONENT	SIZE RANGE
Boulders	Larger than 12 in
Cobbles	3 in to 12 in
Gravel	3 in to No 4 (4.5mm)
Coarse gravel	3 in to 3/4 in
Fine gravel	3/4 in to No 4 (4.5mm)
Sand	No. 4 (4.5 mm) to No. 200 (0.074 mm)
Coarse sand	No. 4 (4.5 mm) to No. 10 (2.0 mm)
Medium sand	No. 10 (2.0 mm) to No. 40 (0.42 mm)
Fine sand	No. 40 (0.42 mm) to No. 200 (0.074 mm)
Silt and Clay	Smaller than No. 200 (0.074mm)

## COMPONENT PROPORTIONS

PROPORTION RANGE	DESCRIPTIVE TERMS
< 5%	Clean
5 - 12%	Slightly (Clayey, Silty, Sandy)
12 - 30%	Clayey, Silty, Sandy, Gravelly
30 - 50%	Very (Clayey, Silty, Sandy, Gravelly)

Components are arranged in order of increasing quantities.


NOTES: Soil classifications presented on exploration logs are based on visual and laboratory observation. Soil descriptions are presented in the following general order:

Density/consistency, color, modifier (if any) GROUP NAME, additions to group name (if any), moisture content. Proportion, gradation, and angularity of constituents, additional comments.  
(GEOLOGIC INTERPRETATION)

Please refer to the discussion in the report text as well as the exploration logs for a more complete description of subsurface conditions.

## MOISTURE CONTENT

DRY	Absence of moisture, dusty, dry to the touch.
MOIST	Damp but no visible water.
WET	Visible free water, usually soil is below water table.

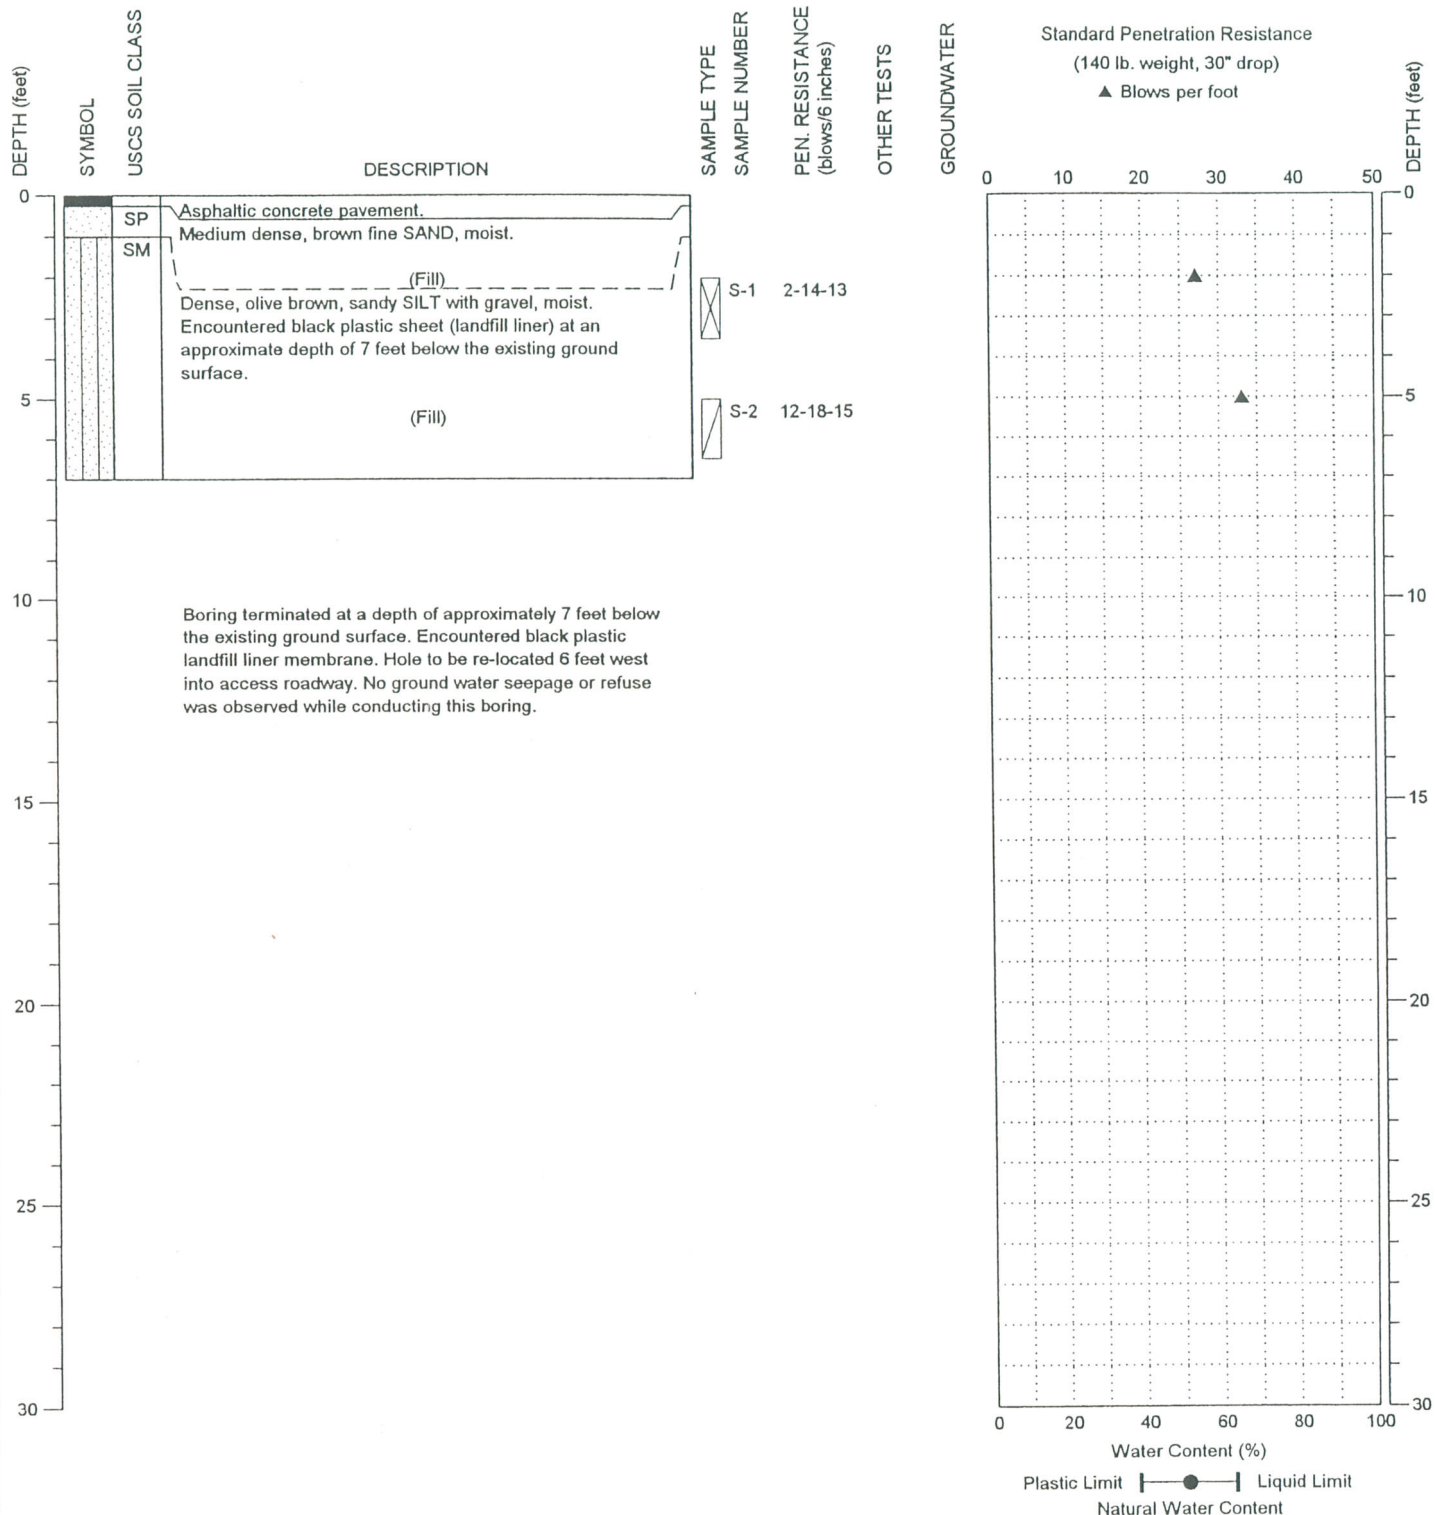

NOTE: This log of subsurface conditions applies only at the specified location and on the date indicated and therefore may not necessarily be indicative of other times and/or locations.




Vashon Island Landfill Access Road Evaluation  
 Vashon Island Landfill  
 King County, Washington

BORING:  
 BH- 4a  
 PAGE: 1 of 1

DRILLING COMPANY: Cascade Drilling, Inc.  
 DRILLING METHOD: CME-75, 4 1/4" HSA  
 SAMPLING METHOD: Autohammer  
 SURFACE ELEVATION: 385 ± feet

LOCATION: See Figure 2.  
 DATE STARTED: 6/4/2001  
 DATE COMPLETED: 6/4/2001  
 LOGGED BY: S. Nelson

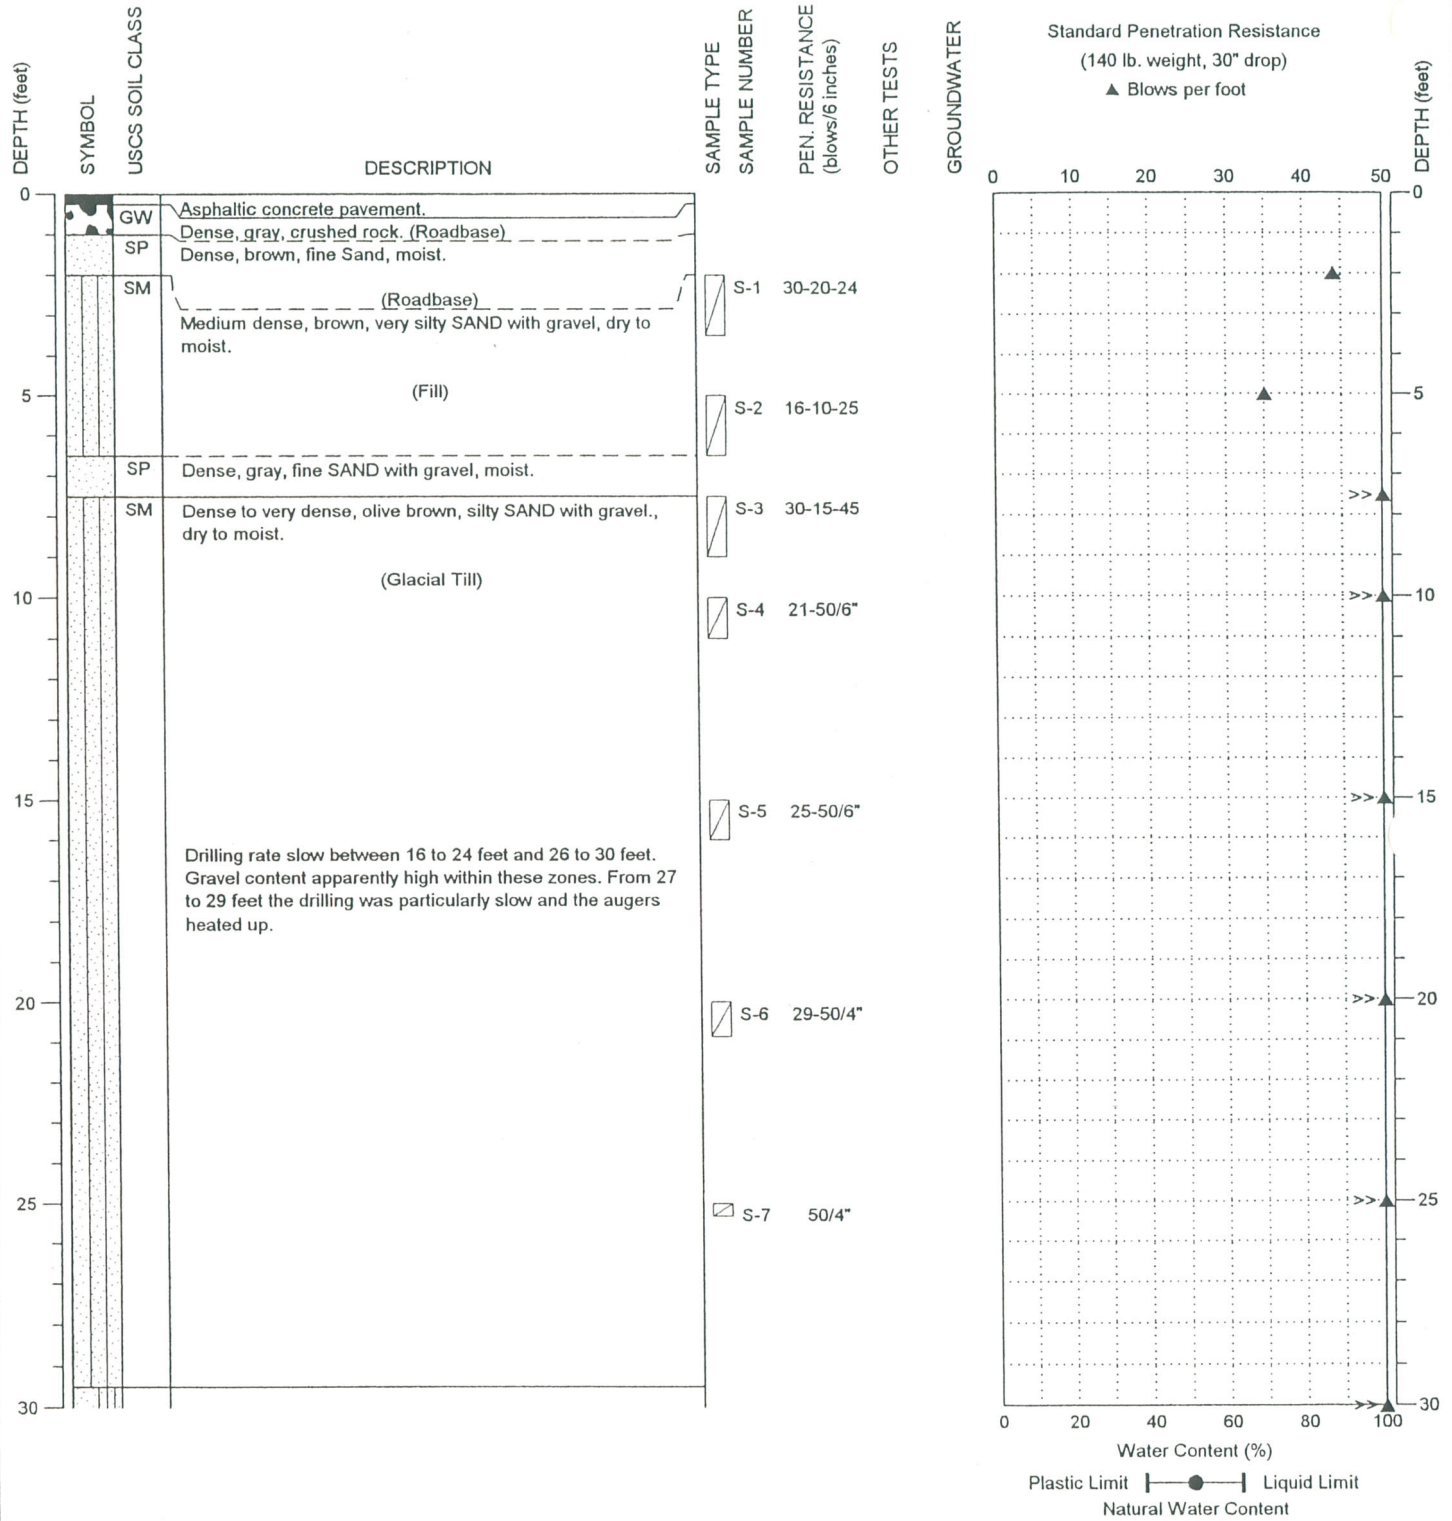

NOTE: This log of subsurface conditions applies only at the specified location and on the date indicated and therefore may not necessarily be indicative of other times and/or locations.




Vashon Island Landfill Access Road Evaluation  
 Vashon Island Landfill  
 King County, Washington

BORING:  
 BH- 4b  
 PAGE: 1 of 2

DRILLING COMPANY: Cascade Drilling, Inc.  
 DRILLING METHOD: CME-75, 4 1/4" HSA  
 SAMPLING METHOD: Autohammer  
 SURFACE ELEVATION: 385 ± feet

LOCATION: See Figure 2.  
 DATE STARTED: 6/4/2001  
 DATE COMPLETED: 6/4/2001  
 LOGGED BY: S. Nelson

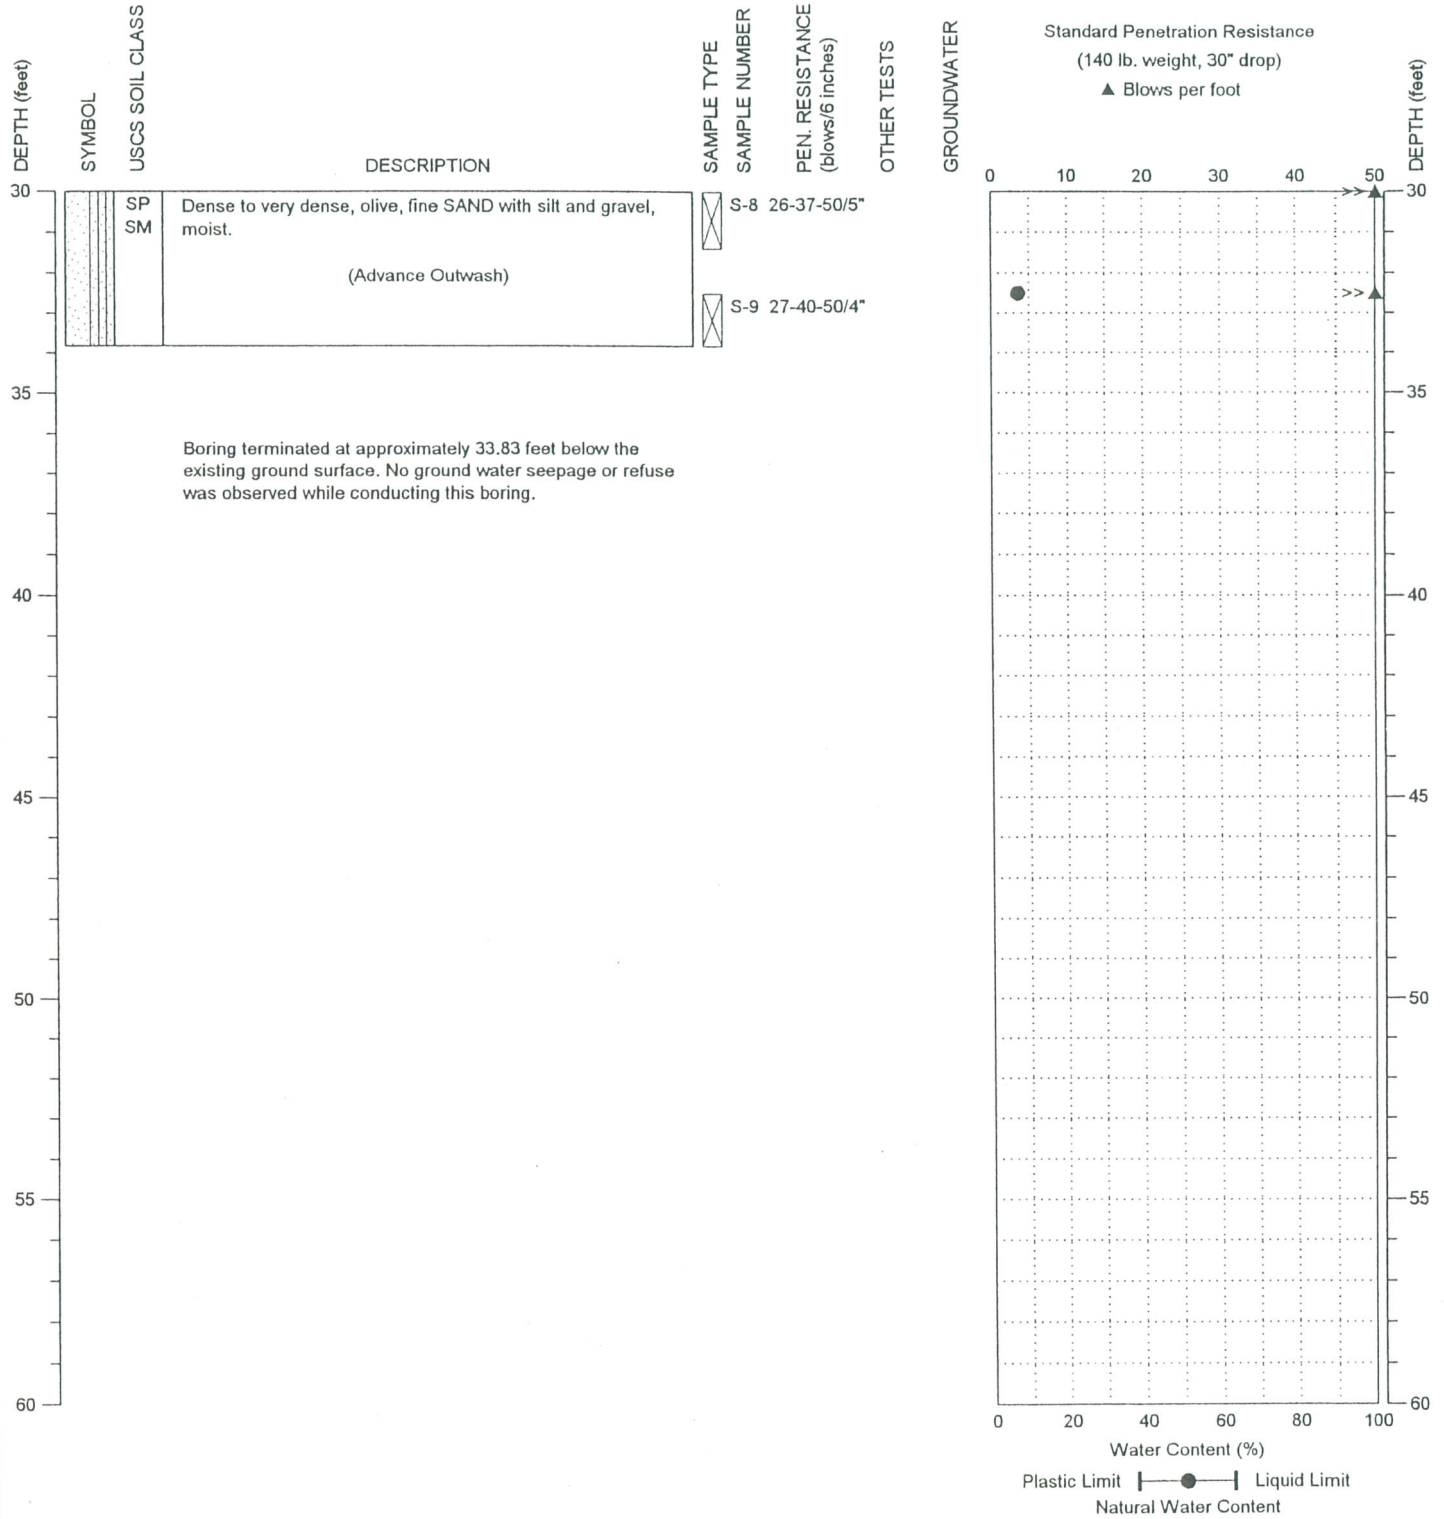

NOTE: This log of subsurface conditions applies only at the specified location and on the date indicated and therefore may not necessarily be indicative of other times and/or locations.



Vashon Island Landfill Access Road Evaluation  
 Vashon Island Landfill  
 King County, Washington

BORING:  
 BH- 4b


PAGE: 2 of 2

PROJECT NO.: 98158-4.1

FIGURE: A-3

DRILLING COMPANY: Cascade Drilling, Inc.  
 DRILLING METHOD: CME 75, 4 1/4" HSA  
 SAMPLING METHOD: Autohammer  
 SURFACE ELEVATION: 402 ± feet

LOCATION: See Figure 2.  
 DATE STARTED: 6/6/2001  
 DATE COMPLETED: 6/6/2001  
 LOGGED BY: S. Nelson

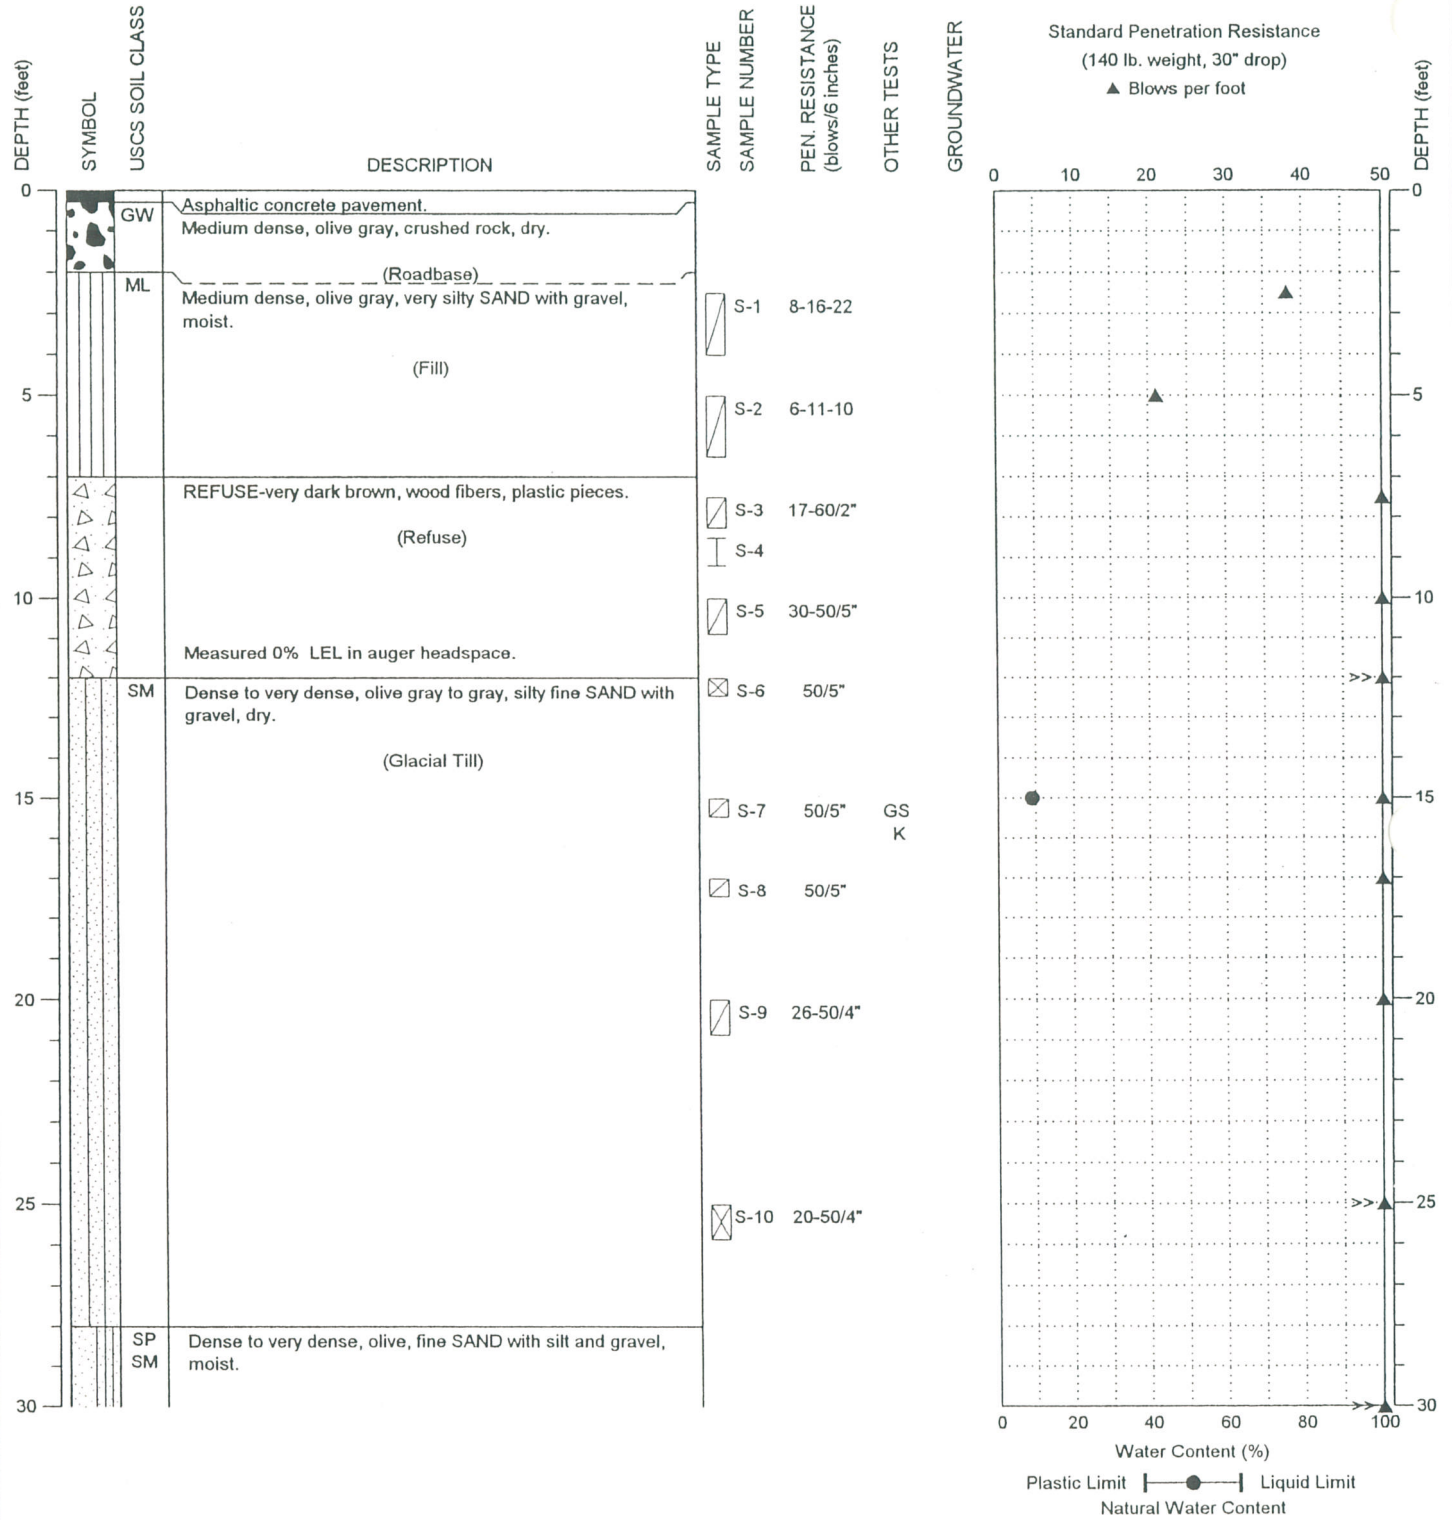

NOTE: This log of subsurface conditions applies only at the specified location and on the date indicated and therefore may not necessarily be indicative of other times and/or locations.




Vashon Island Landfill Access Road Evaluation  
 Vashon Island Landfill  
 King County, Washington

BORING:  
 BH- 5  
 PAGE: 1 of 2

DRILLING COMPANY: Cascade Drilling, Inc.  
 DRILLING METHOD: CME 75, 4 1/4" HSA  
 SAMPLING METHOD: Autohammer  
 SURFACE ELEVATION: 402 ± feet

LOCATION: See Figure 2.  
 DATE STARTED: 6/6/2001  
 DATE COMPLETED: 6/6/2001  
 LOGGED BY: S. Nelson

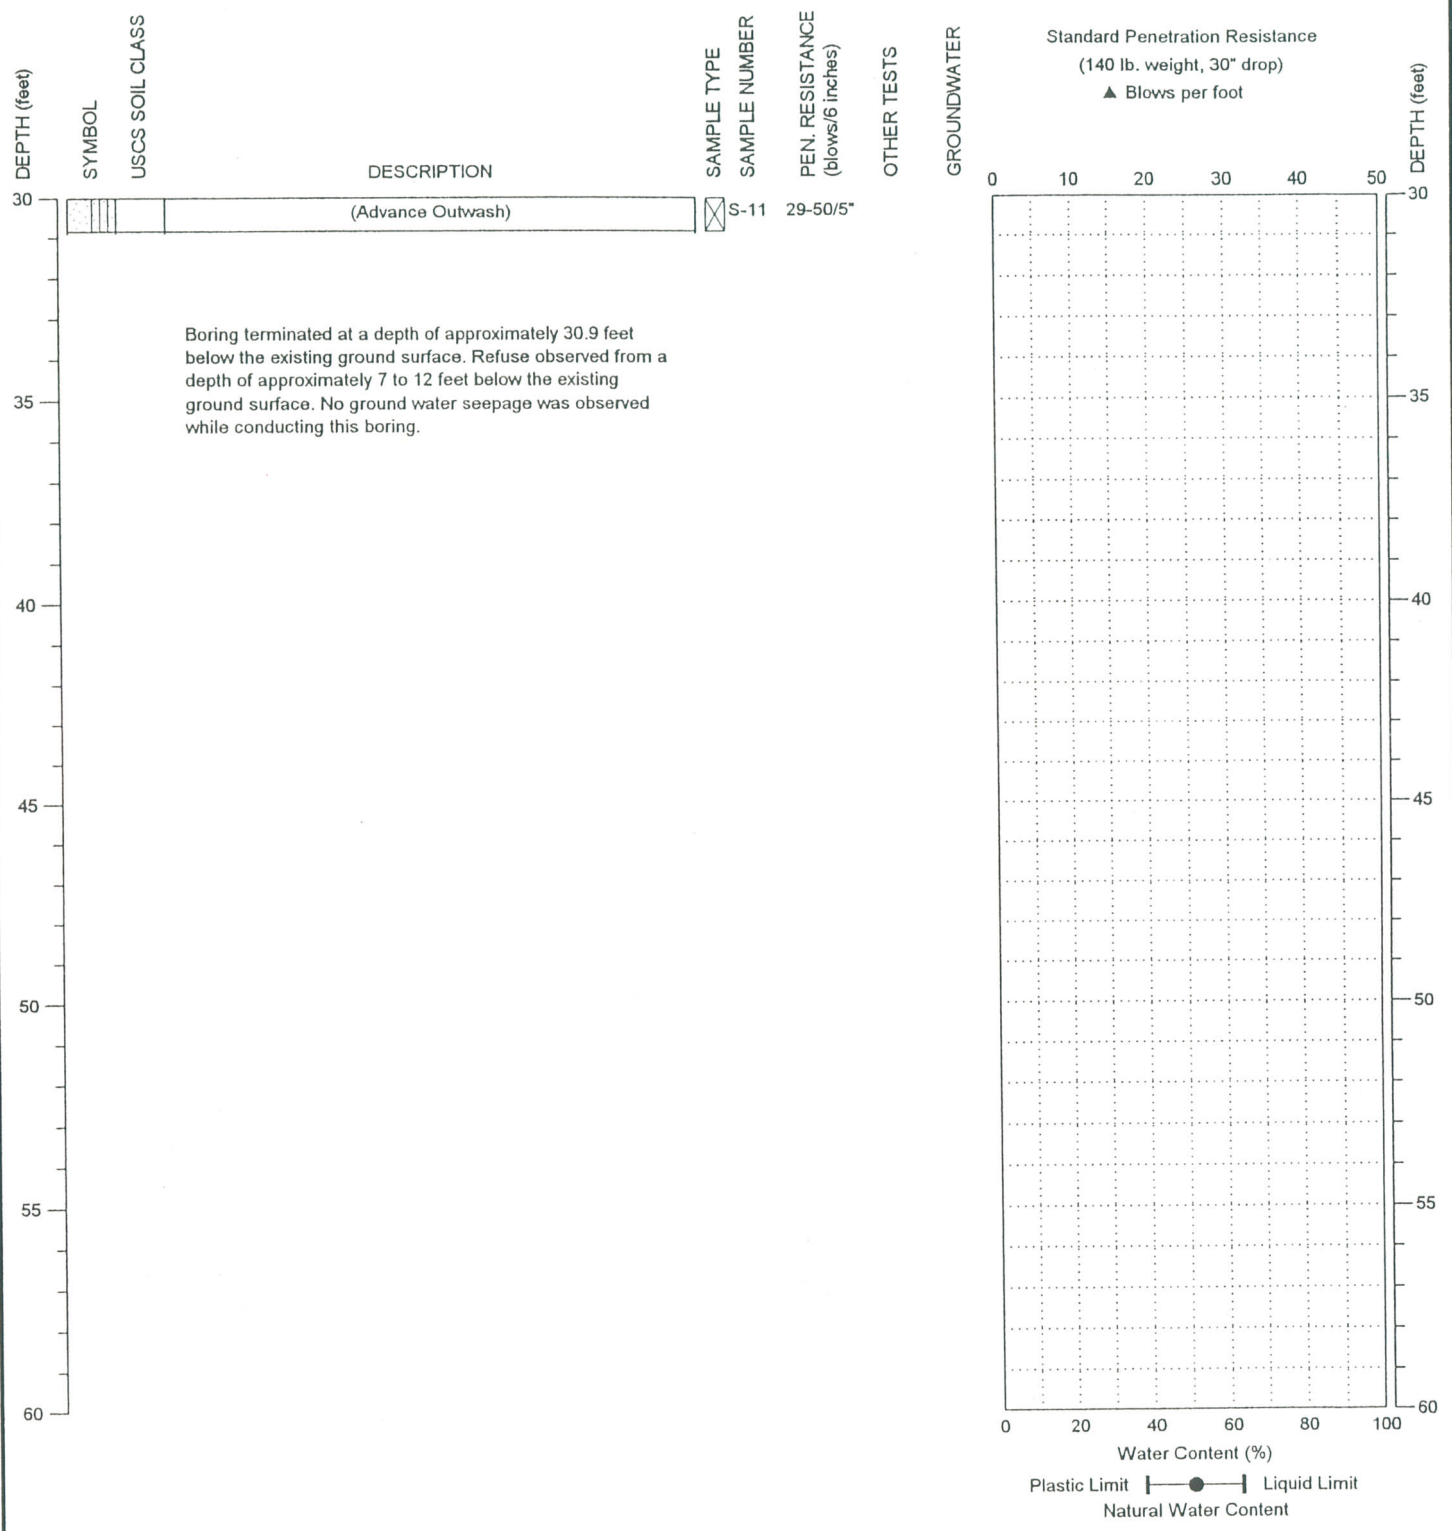

NOTE: This log of subsurface conditions applies only at the specified location and on the date indicated and therefore may not necessarily be indicative of other times and/or locations.




Vashon Island Landfill Access Road Evaluation  
 Vashon Island Landfill  
 King County, Washington

BORING:  
 BH- 5  
 PAGE: 2 of 2

DRILLING COMPANY: Cascade Drilling, Inc.  
 DRILLING METHOD: CME 75, 4 1/4" HSA  
 SAMPLING METHOD: Autohammer  
 SURFACE ELEVATION: 402 ± feet

LOCATION: See Figure 2.  
 DATE STARTED: 6/5/2001  
 DATE COMPLETED: 6/5/2001  
 LOGGED BY: S. Nelson

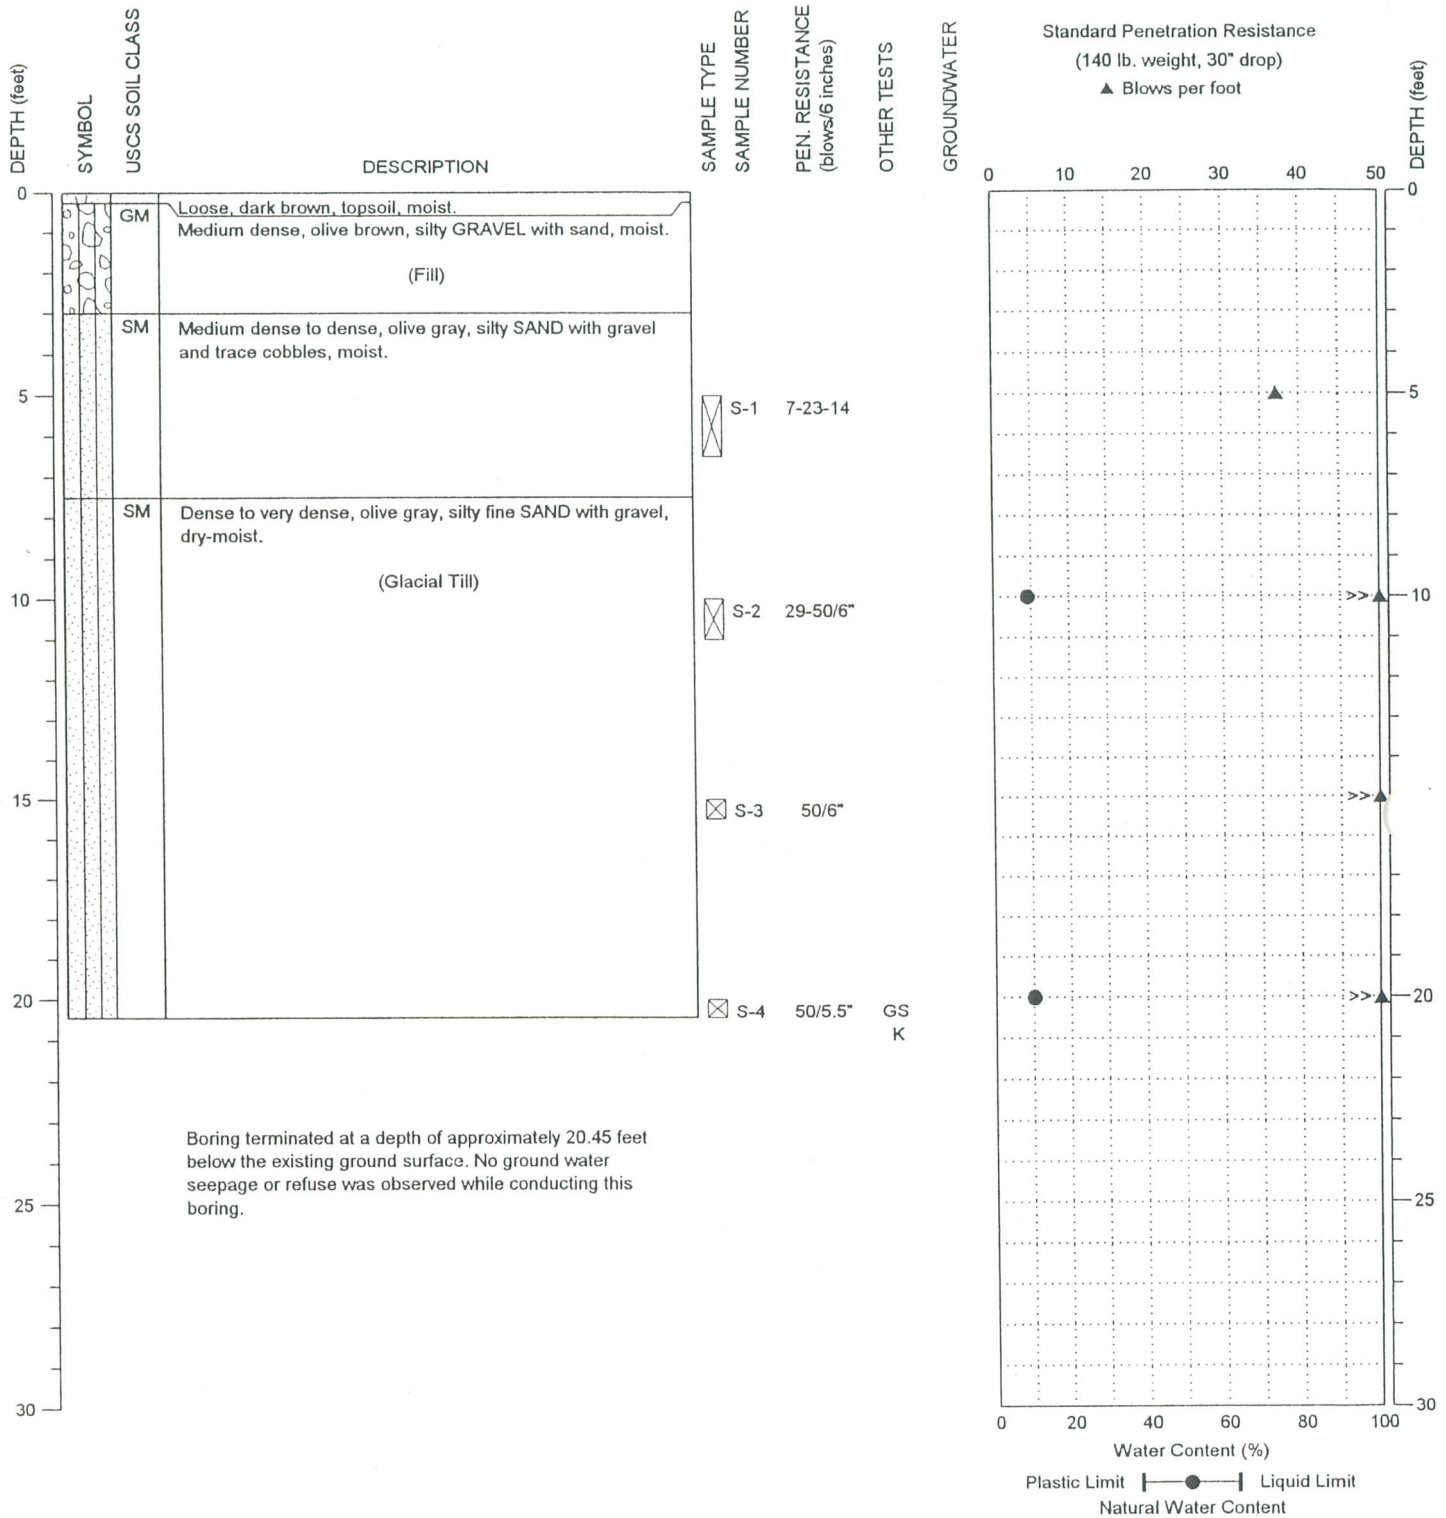

NOTE: This log of subsurface conditions applies only at the specified location and on the date indicated and therefore may not necessarily be indicative of other times and/or locations.



Vashon Island Landfill Access Road Evaluation  
 Vashon Island Landfill  
 King County, Washington

BORING:  
 BH- 6

PAGE: 1 of 1


PROJECT NO.: 98158-4.1

FIGURE: A-5



DRILLING COMPANY: Cascade Drilling, Inc.  
 DRILLING METHOD: CME 75, 4 1/4" HSA  
 SAMPLING METHOD: Autohammer  
 SURFACE ELEVATION: 395 ± feet

LOCATION: See Figure 2.  
 DATE STARTED: 6/5/2001  
 DATE COMPLETED: 6/5/2001  
 LOGGED BY: S. Nelson

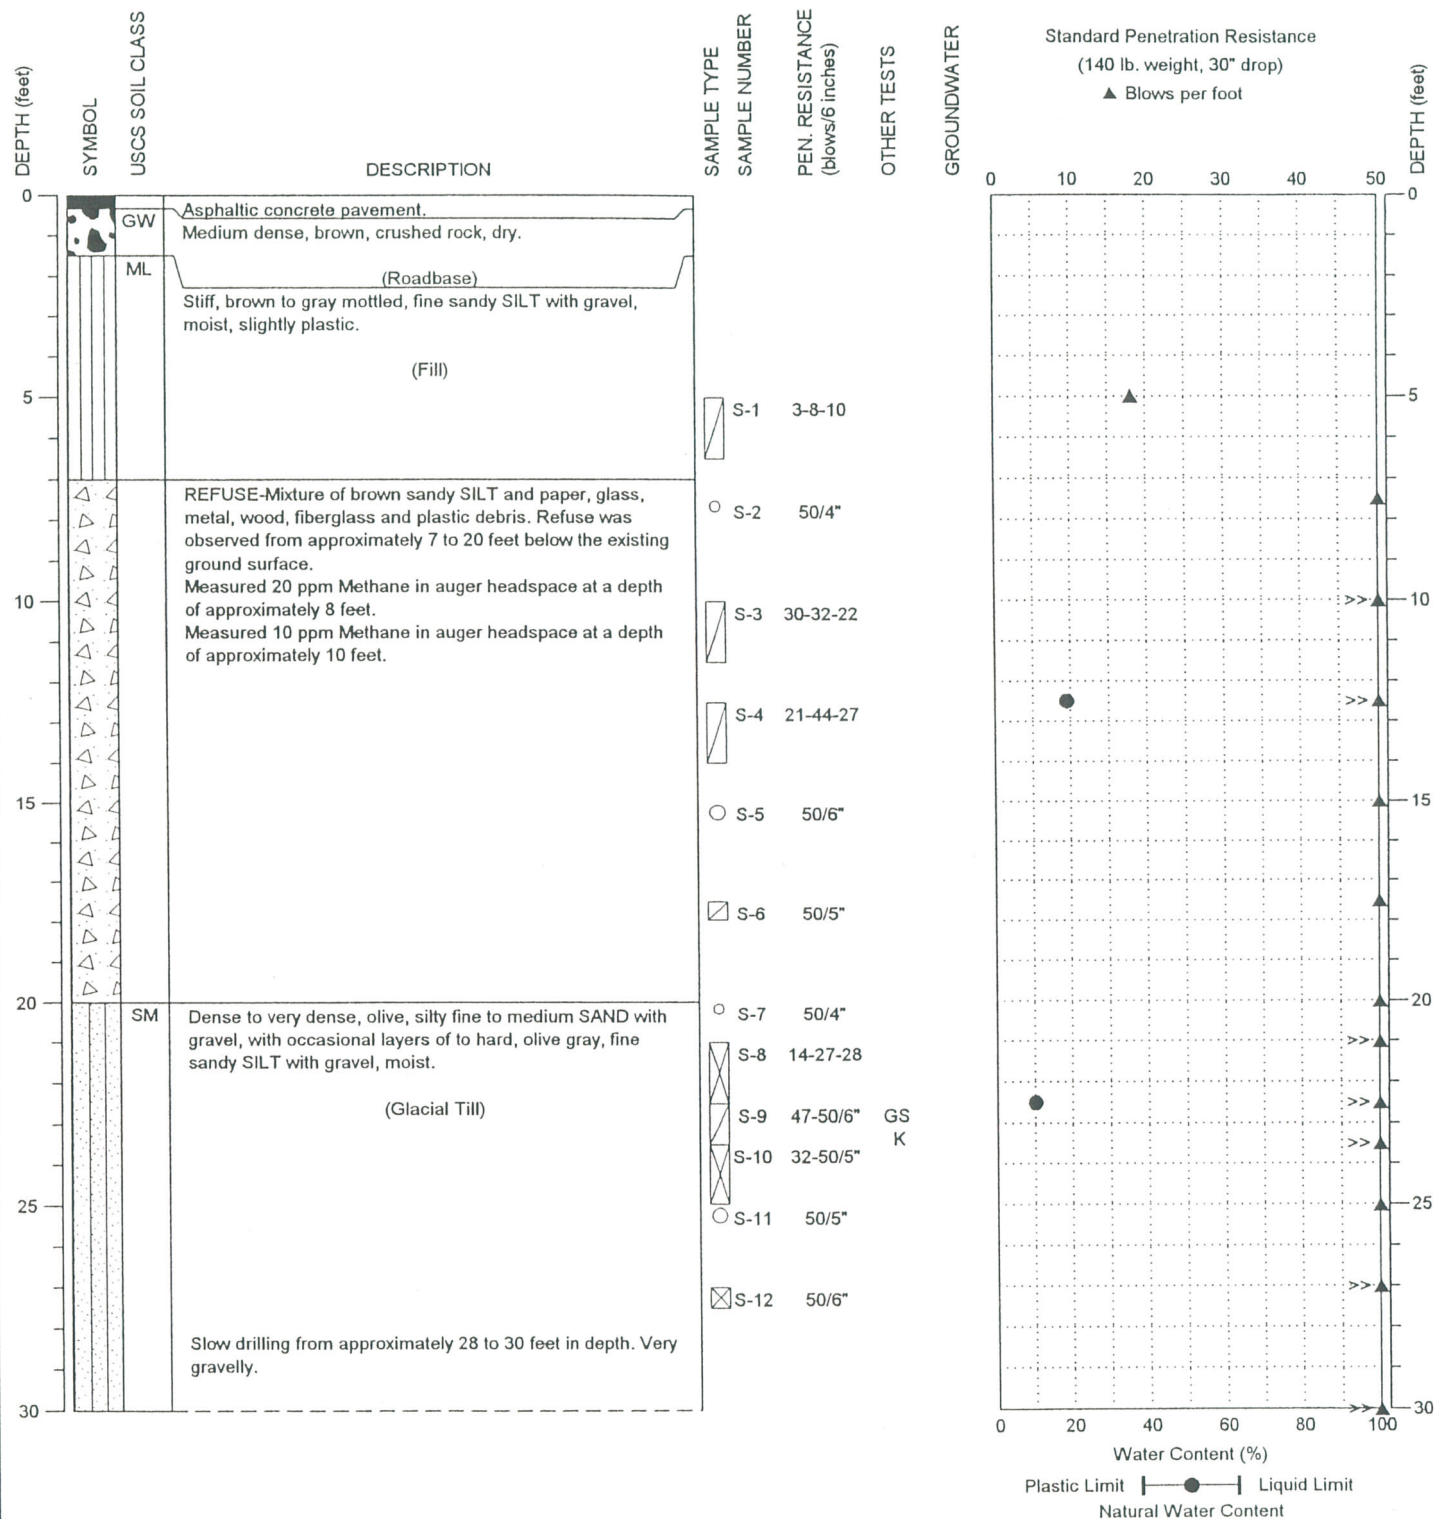

NOTE: This log of subsurface conditions applies only at the specified location and on the date indicated and therefore may not necessarily be indicative of other times and/or locations.



Vashon Island Landfill Access Road Evaluation  
 Vashon Island Landfill  
 King County, Washington

BORING:  
 BH- 7


PAGE: 1 of 2

PROJECT NO.: 98158-4.1

FIGURE: A-6

DRILLING COMPANY: Cascade Drilling, Inc.  
 DRILLING METHOD: CME 75, 4 1/4" HSA  
 SAMPLING METHOD: Autohammer  
 SURFACE ELEVATION: 395 ± feet


LOCATION: See Figure 2.  
 DATE STARTED: 6/5/2001  
 DATE COMPLETED: 6/5/2001  
 LOGGED BY: S. Nelson

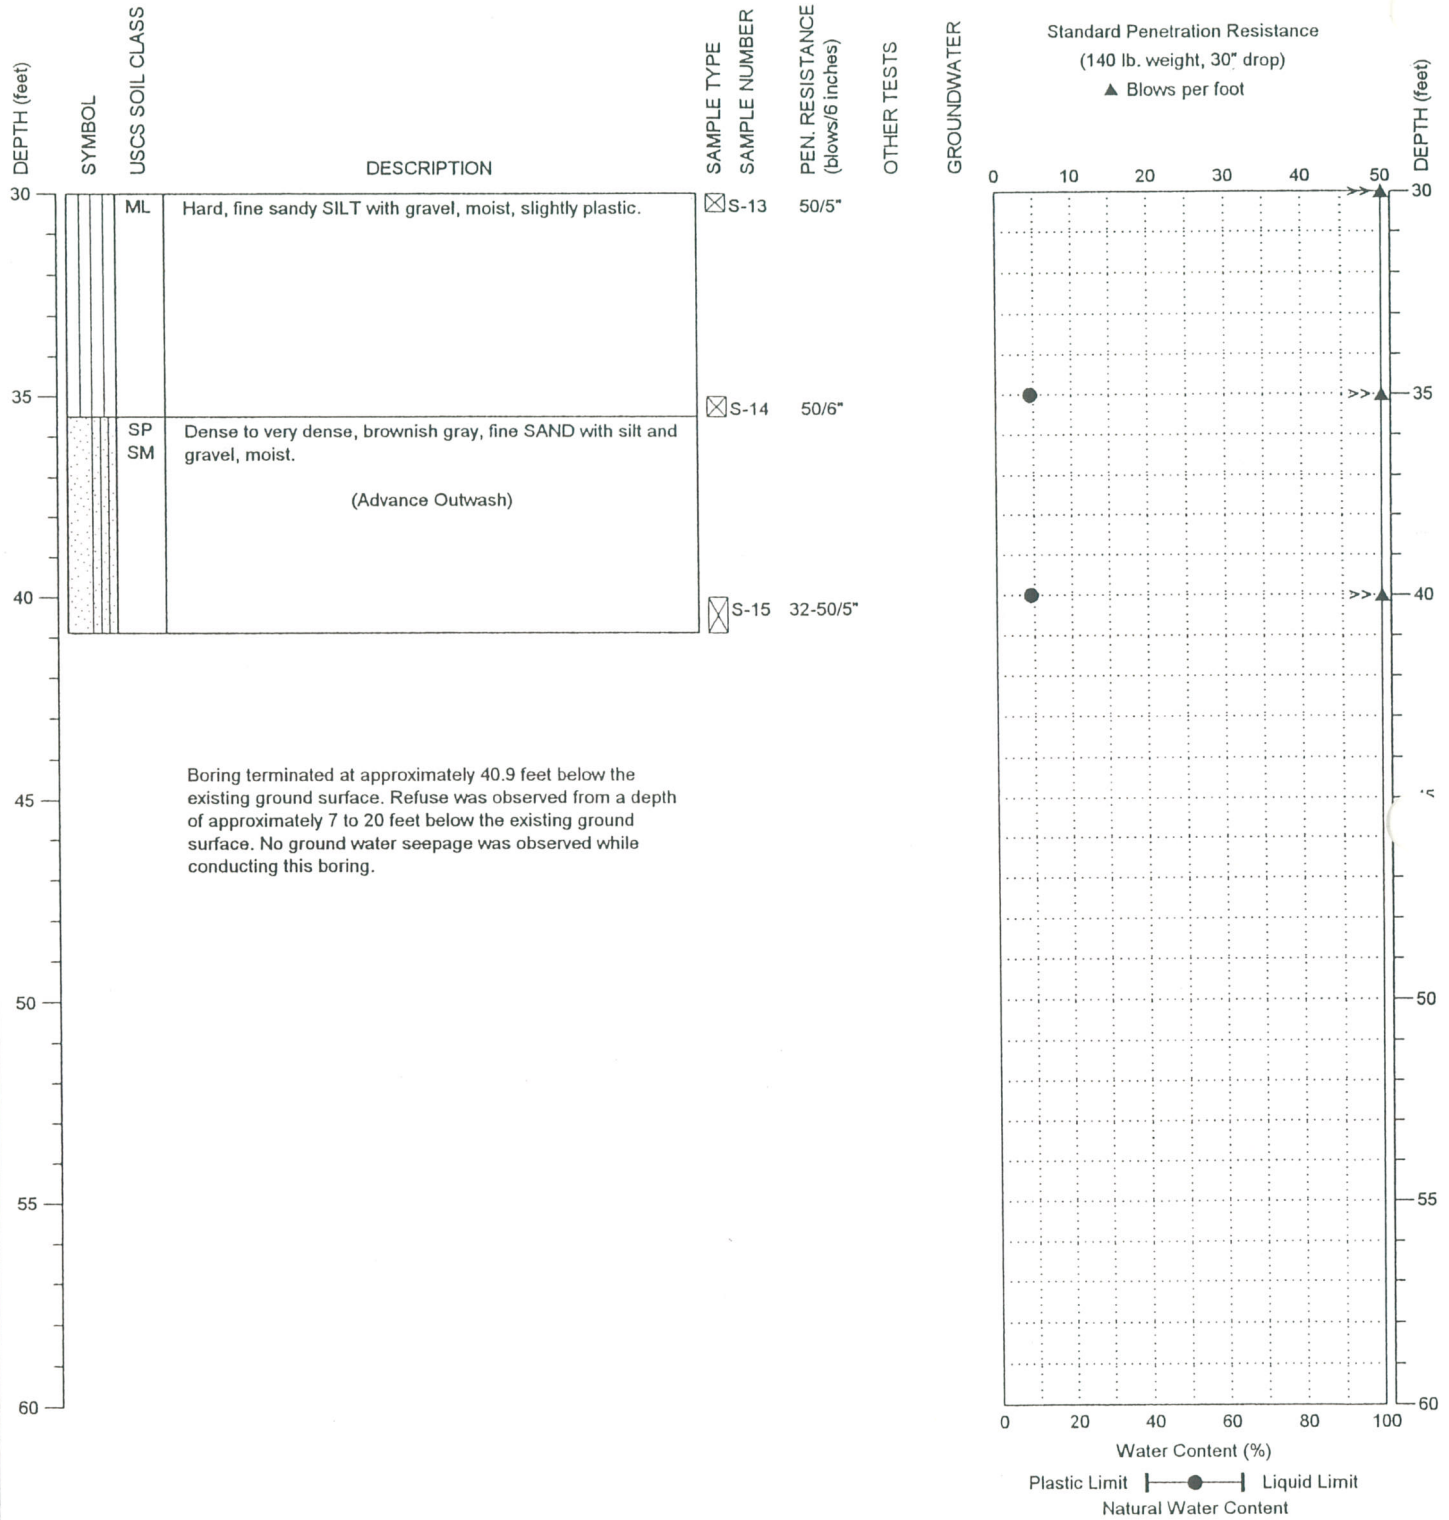

NOTE: This log of subsurface conditions applies only at the specified location and on the date indicated and therefore may not necessarily be indicative of other times and/or locations.

DRILLING COMPANY: Cascade Drilling, Inc.  
 DRILLING METHOD: CME 75, 4 1/4" HSA  
 SAMPLING METHOD: Autohammer  
 SURFACE ELEVATION: 395 ± feet

LOCATION: See Figure 2.  
 DATE STARTED: 6/6/2001  
 DATE COMPLETED: 6/6/2001  
 LOGGED BY: S. Nelson

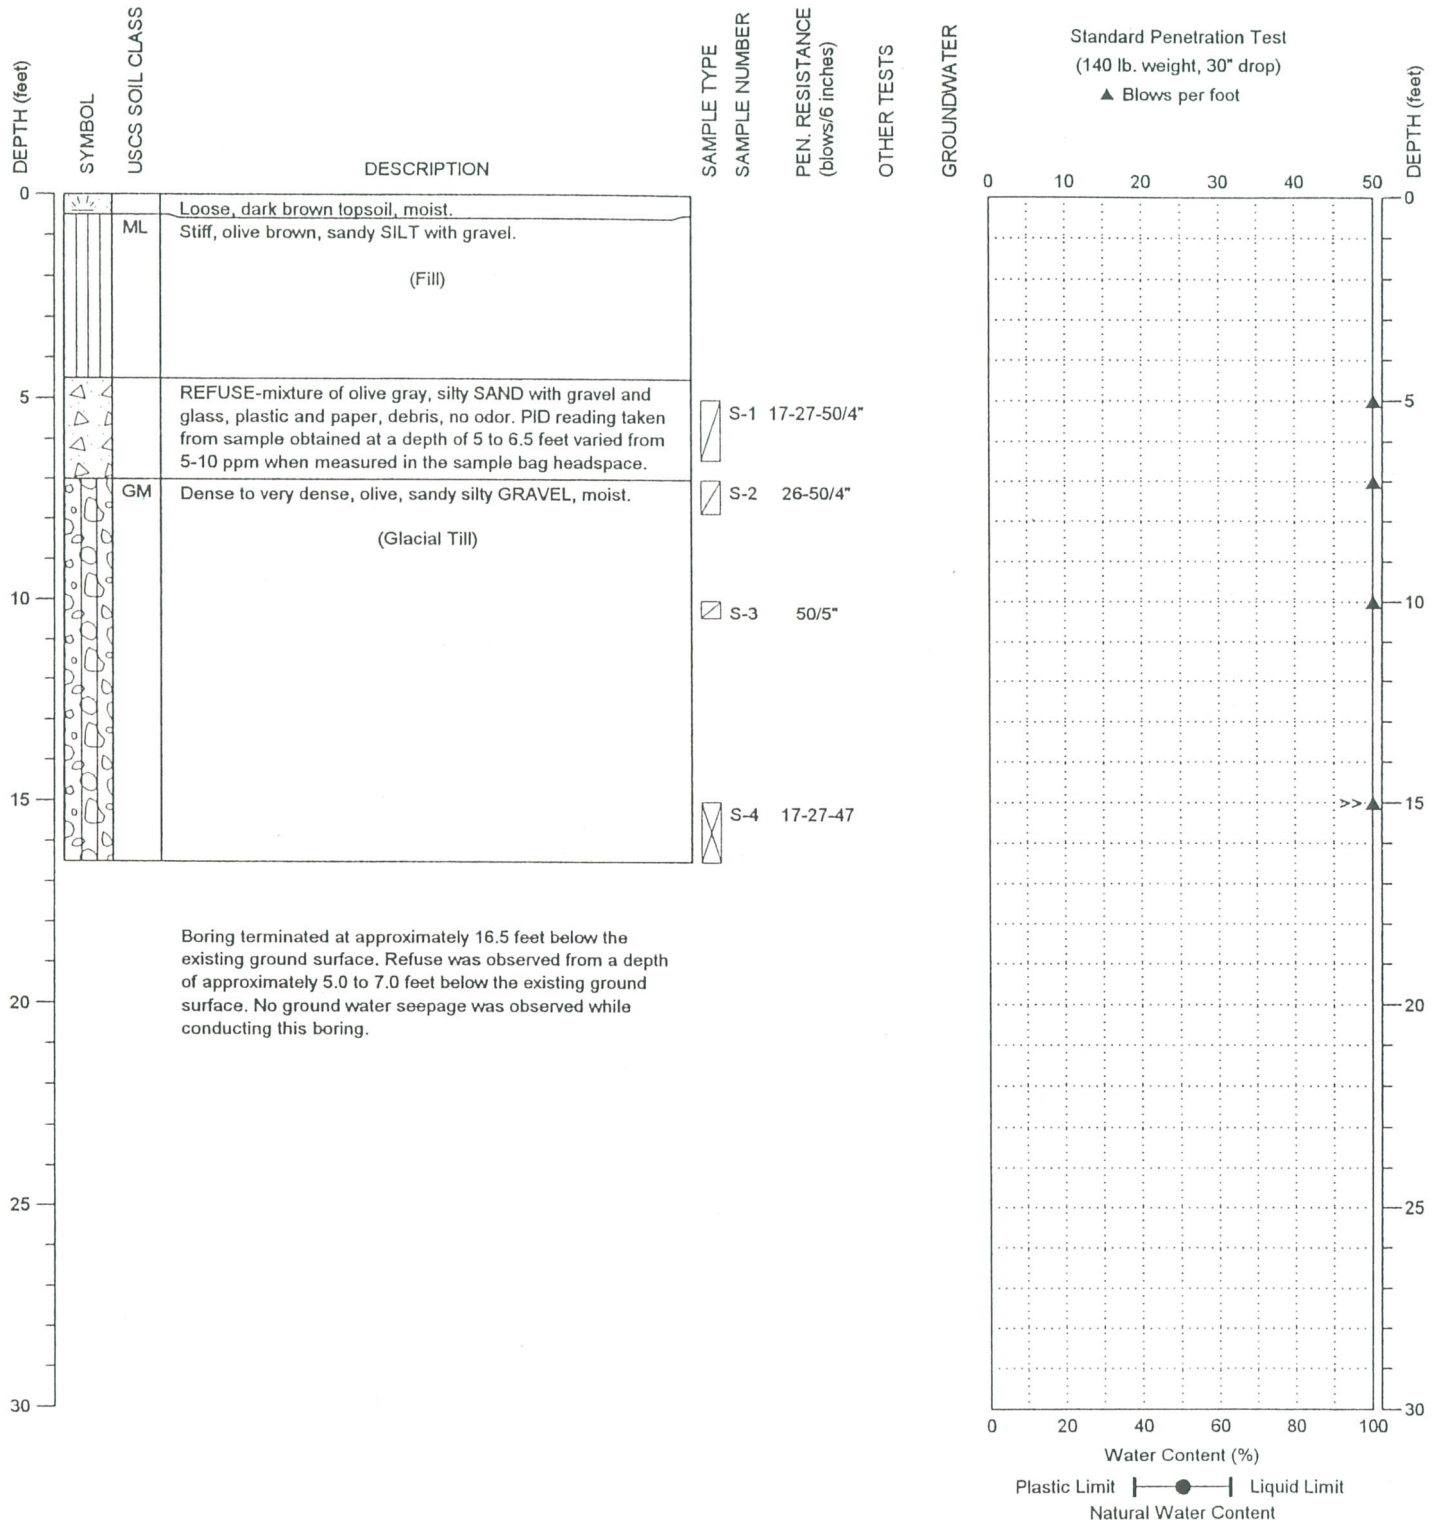

NOTE: This log of subsurface conditions applies only at the specified location and on the date indicated and therefore may not necessarily be indicative of other times and/or locations.




Vashon Island Landfill Access Road Evaluation  
 Vashon Island Landfill  
 King County, Washington

BORING:  
 BH- 8

PAGE: 1 of 1

DRILLING COMPANY: Cascade Drilling, Inc.  
 DRILLING METHOD: CME 75, 4 1/4" HSA  
 SAMPLING METHOD: Autohammer  
 SURFACE ELEVATION: 387 ± feet

LOCATION: See Figure 2.  
 DATE STARTED: 6/4/2001  
 DATE COMPLETED: 6/4/2001  
 LOGGED BY: S. Nelson

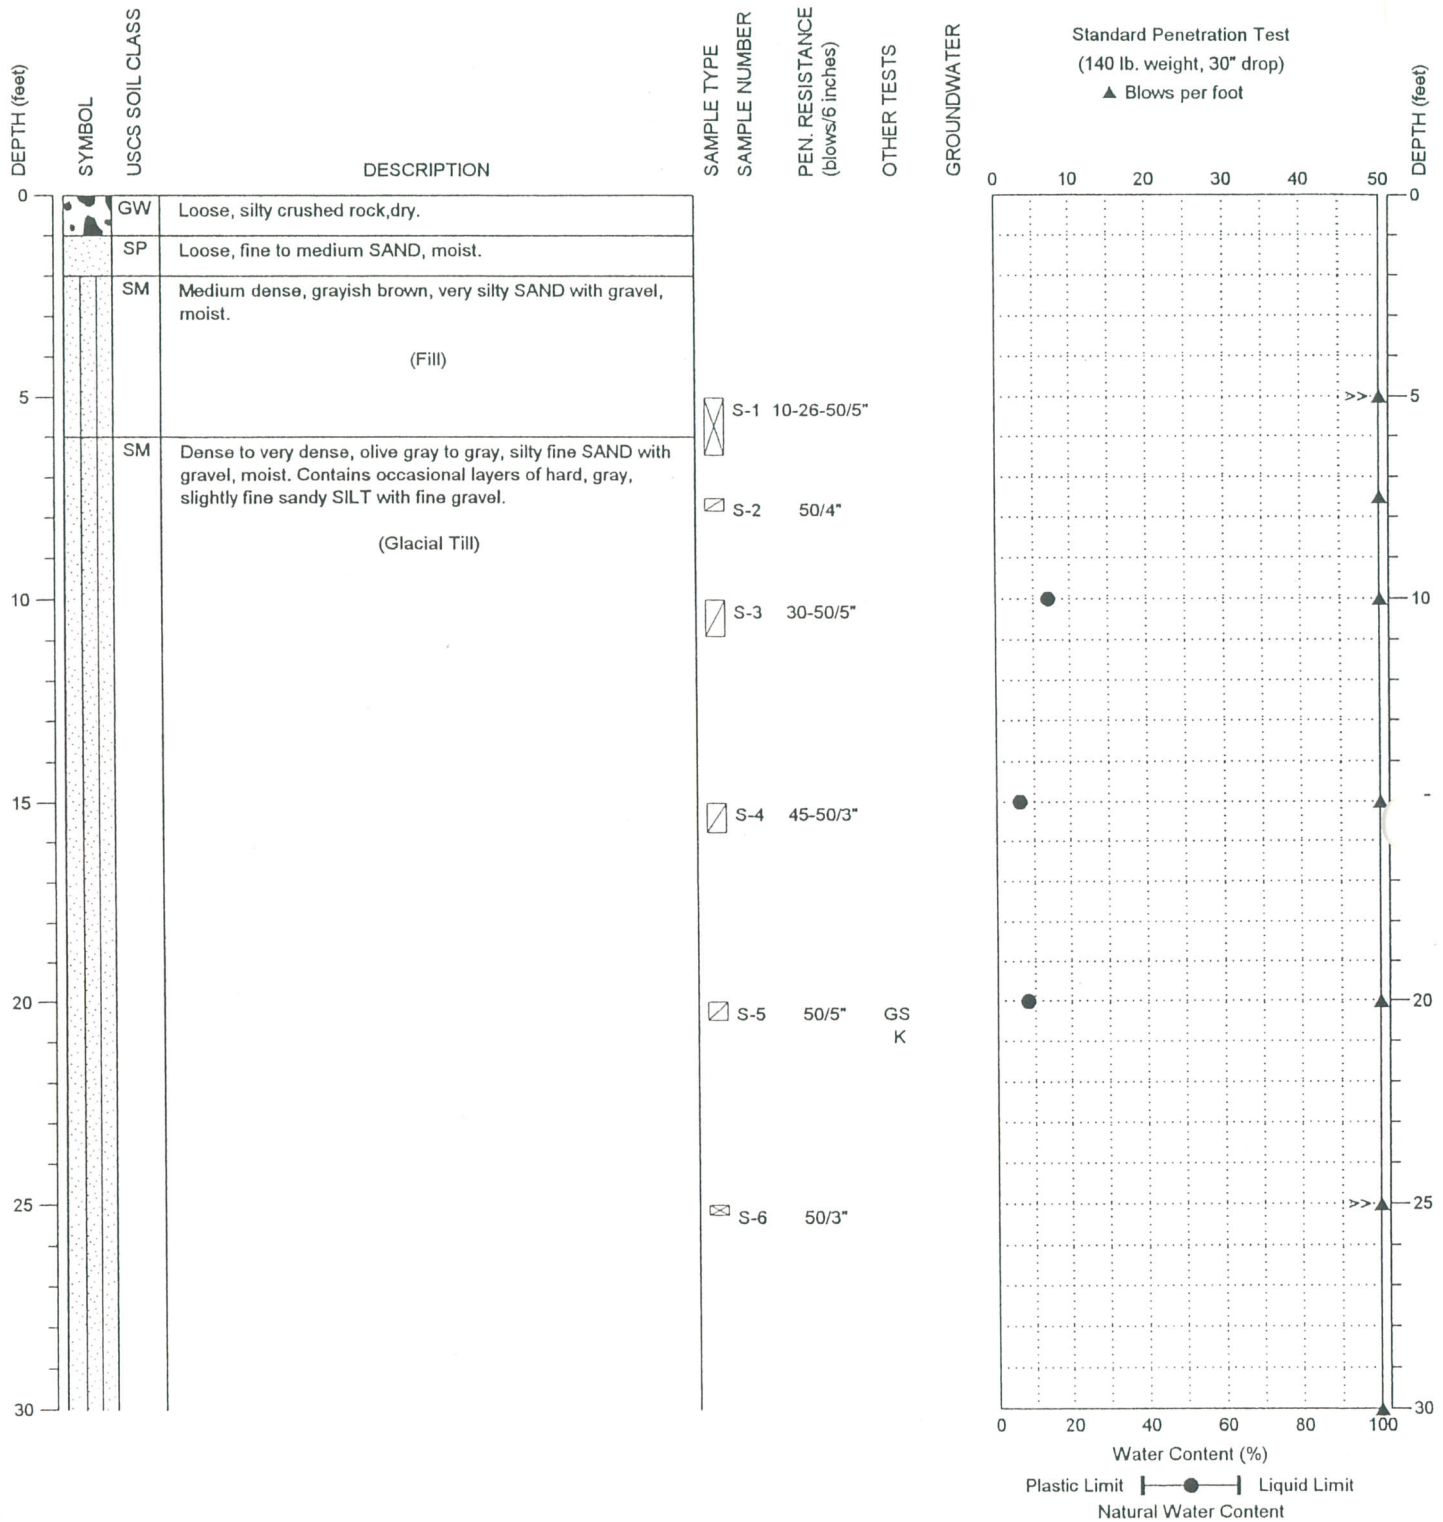

NOTE: This log of subsurface conditions applies only at the specified location and on the date indicated and therefore may not necessarily be indicative of other times and/or locations.



Vashon Island Landfill Access Road Evaluation  
 Vashon Island Landfill  
 King County, Washington


BORING:  
 BH- 9  
 PAGE: 1 of 2

PROJECT NO.: 98158-4.1

FIGURE: A-8

DRILLING COMPANY: Cascade Drilling, Inc.  
 DRILLING METHOD: CME 75, 4 1/4" HSA  
 SAMPLING METHOD: Autohammer  
 SURFACE ELEVATION: 387 ± feet

LOCATION: See Figure 2.  
 DATE STARTED: 6/4/2001  
 DATE COMPLETED: 6/4/2001  
 LOGGED BY: S. Nelson

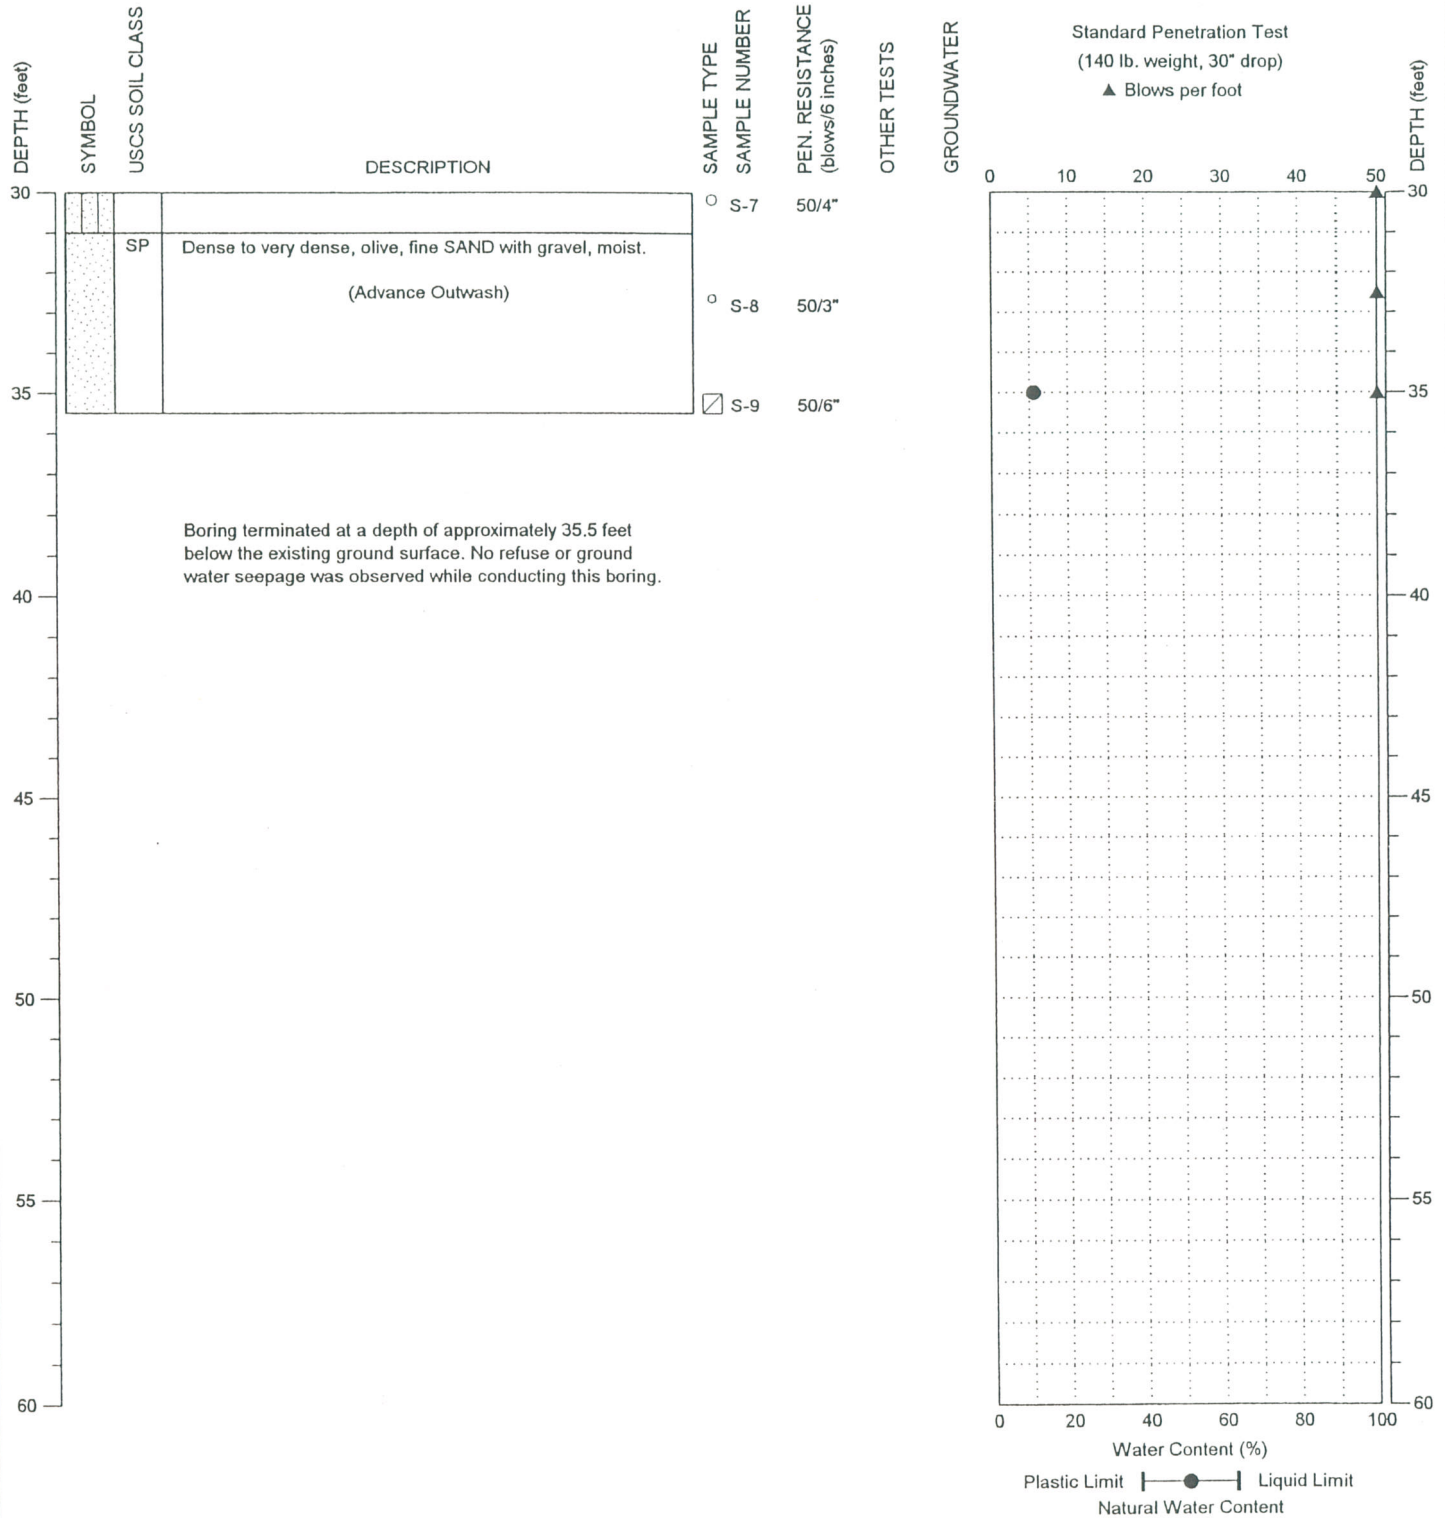

NOTE: This log of subsurface conditions applies only at the specified location and on the date indicated and therefore may not necessarily be indicative of other times and/or locations.




Vashon Island Landfill Access Road Evaluation  
 Vashon Island Landfill  
 King County, Washington

BORING:  
 BH- 9  
 PAGE: 2 of 2

DRILLING COMPANY: Cascade Drilling, Inc.  
 DRILLING METHOD: CME 75, 4 1/4" HSA  
 SAMPLING METHOD: Autohammer  
 SURFACE ELEVATION: 383 ± feet

LOCATION: See Figure 2.  
 DATE STARTED: 6/6/2001  
 DATE COMPLETED: 6/6/2001  
 LOGGED BY: S. Nelson

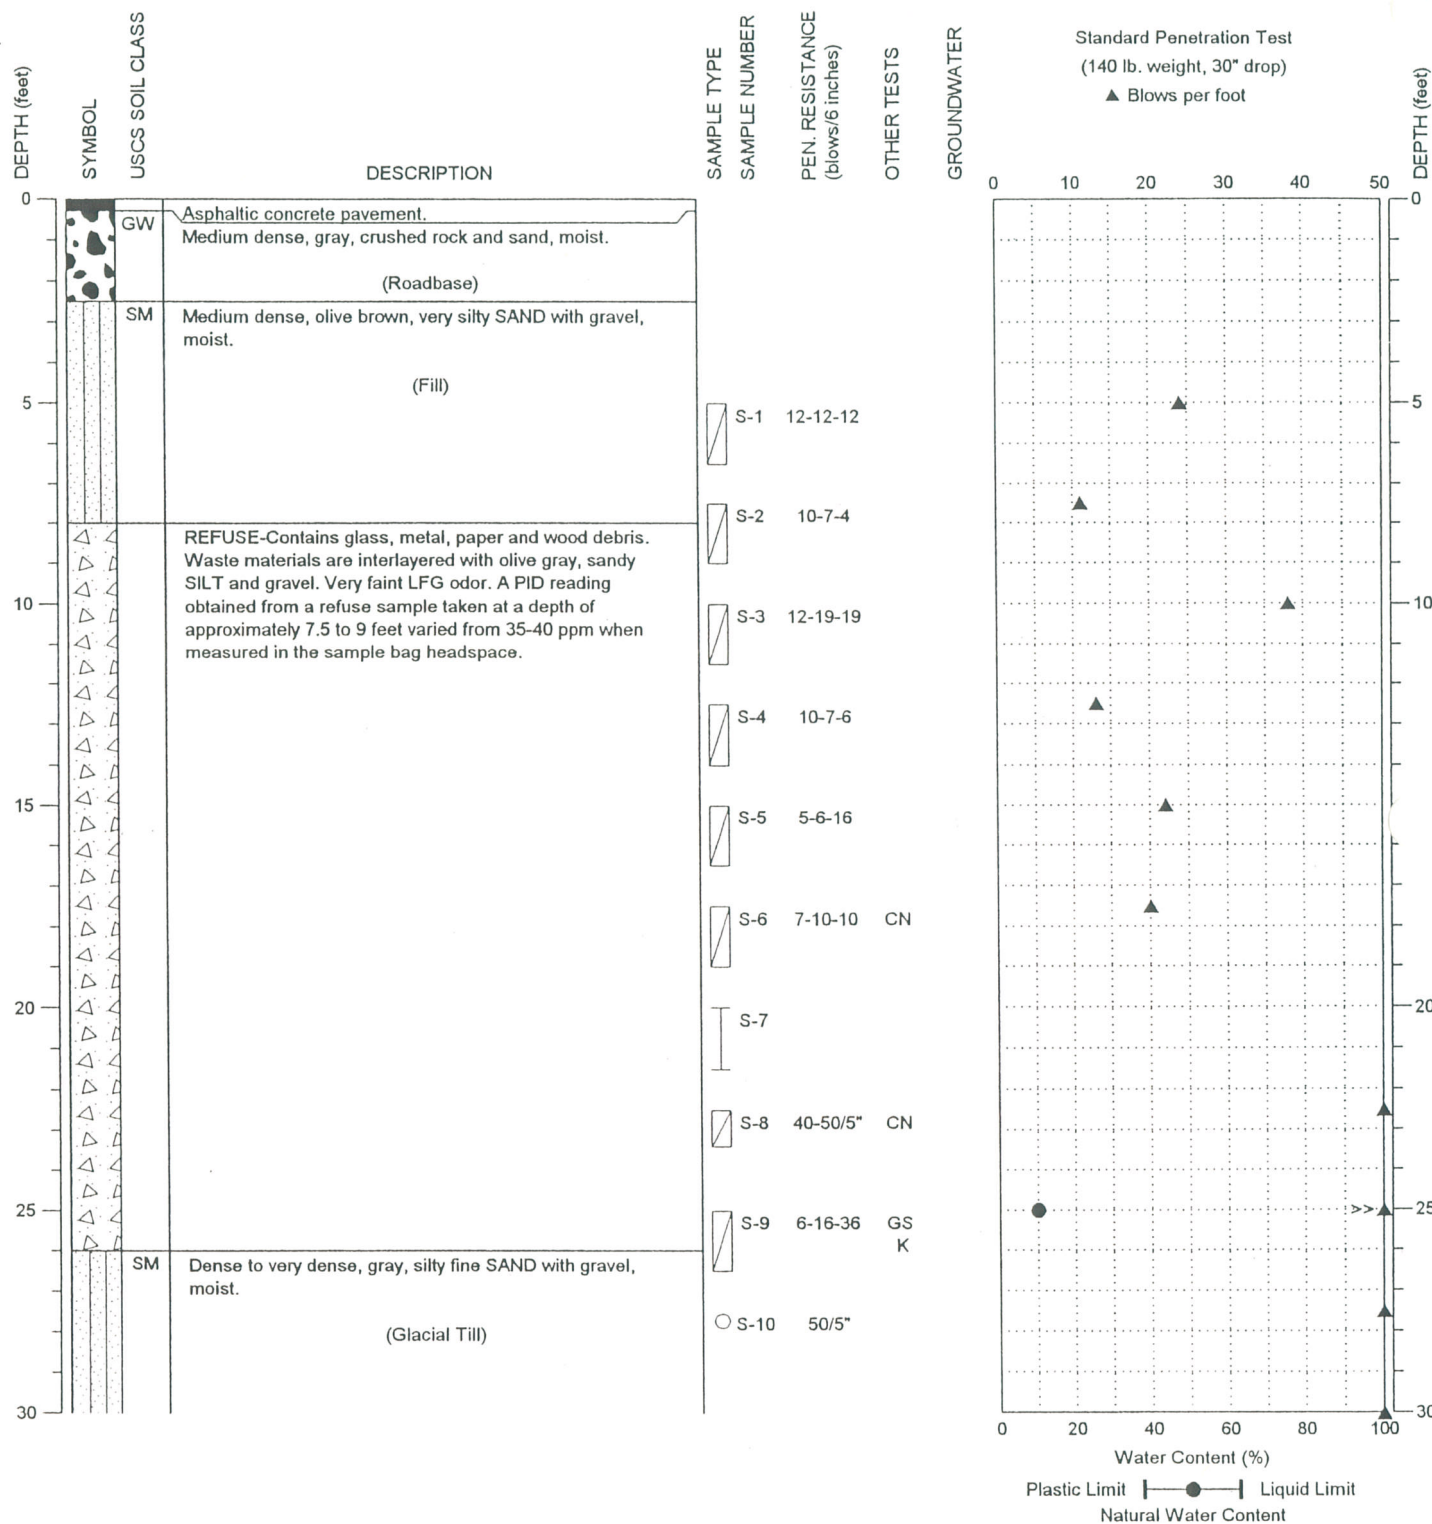

NOTE: This log of subsurface conditions applies only at the specified location and on the date indicated and therefore may not necessarily be indicative of other times and/or locations.




Vashon Island Landfill Access Road Evaluation  
 Vashon Island Landfill  
 King County, Washington

BORING:  
 BH-10  
 PAGE: 1 of 2

DRILLING COMPANY: Cascade Drilling, Inc.  
 DRILLING METHOD: CME 75, 4 1/4" HSA  
 SAMPLING METHOD: Autohammer  
 SURFACE ELEVATION: 383 ± feet

LOCATION: See Figure 2.  
 DATE STARTED: 6/6/2001  
 DATE COMPLETED: 6/6/2001  
 LOGGED BY: S. Nelson

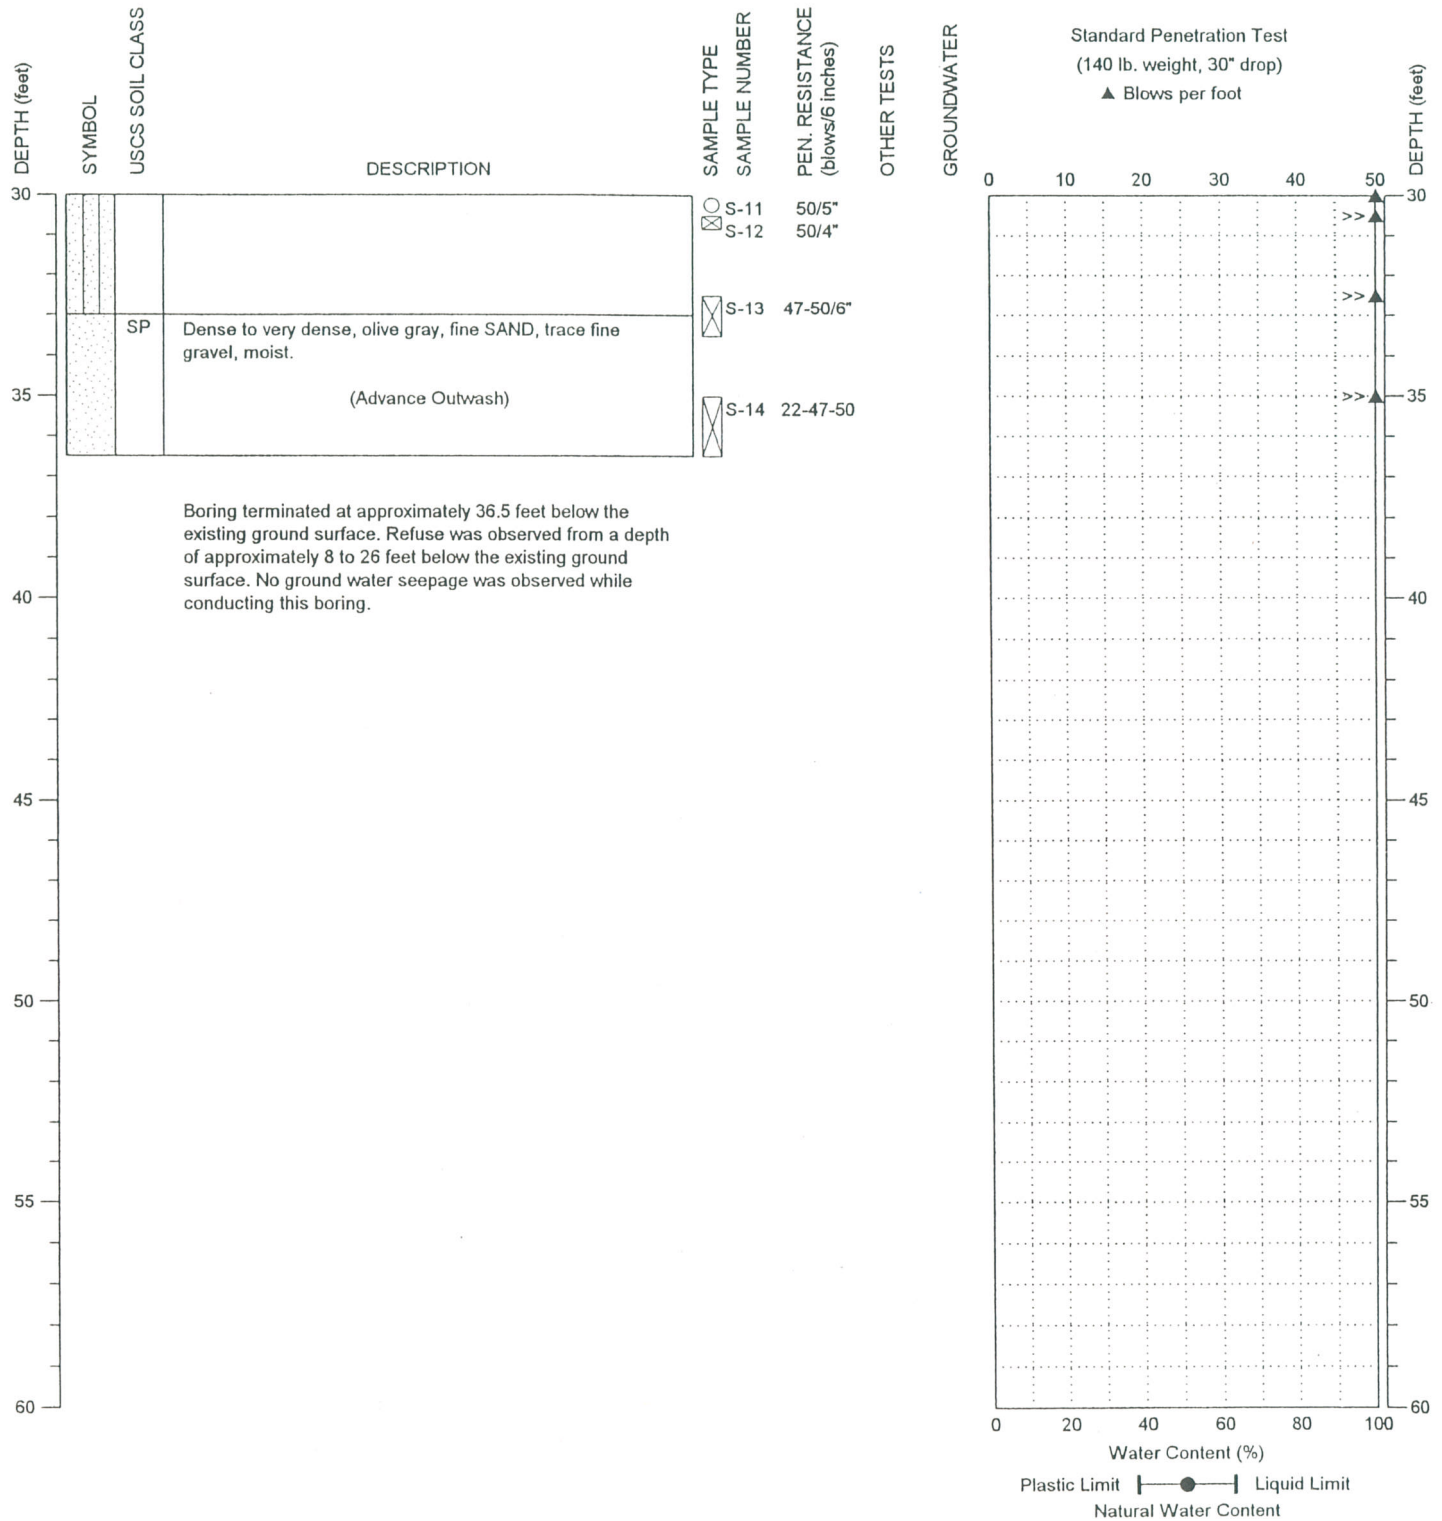

NOTE: This log of subsurface conditions applies only at the specified location and on the date indicated and therefore may not necessarily be indicative of other times and/or locations.



Vashon Island Landfill Access Road Evaluation  
 Vashon Island Landfill  
 King County, Washington

BORING:  
 BH-10


PAGE: 2 of 2

PROJECT NO.: 98158-4.1

FIGURE: A-9

DRILLING COMPANY: Cascade Drilling, Inc.  
 DRILLING METHOD: CME 75, 4 1/4" HSA  
 SAMPLING METHOD: Wire line jars and D&M sampler  
 SURFACE ELEVATION: 402 ± feet

LOCATION: 12 ft NNE of KCB-1  
 DATE STARTED: 1/21/2002  
 DATE COMPLETED: 1/21/2002  
 LOGGED BY: S. Nelson

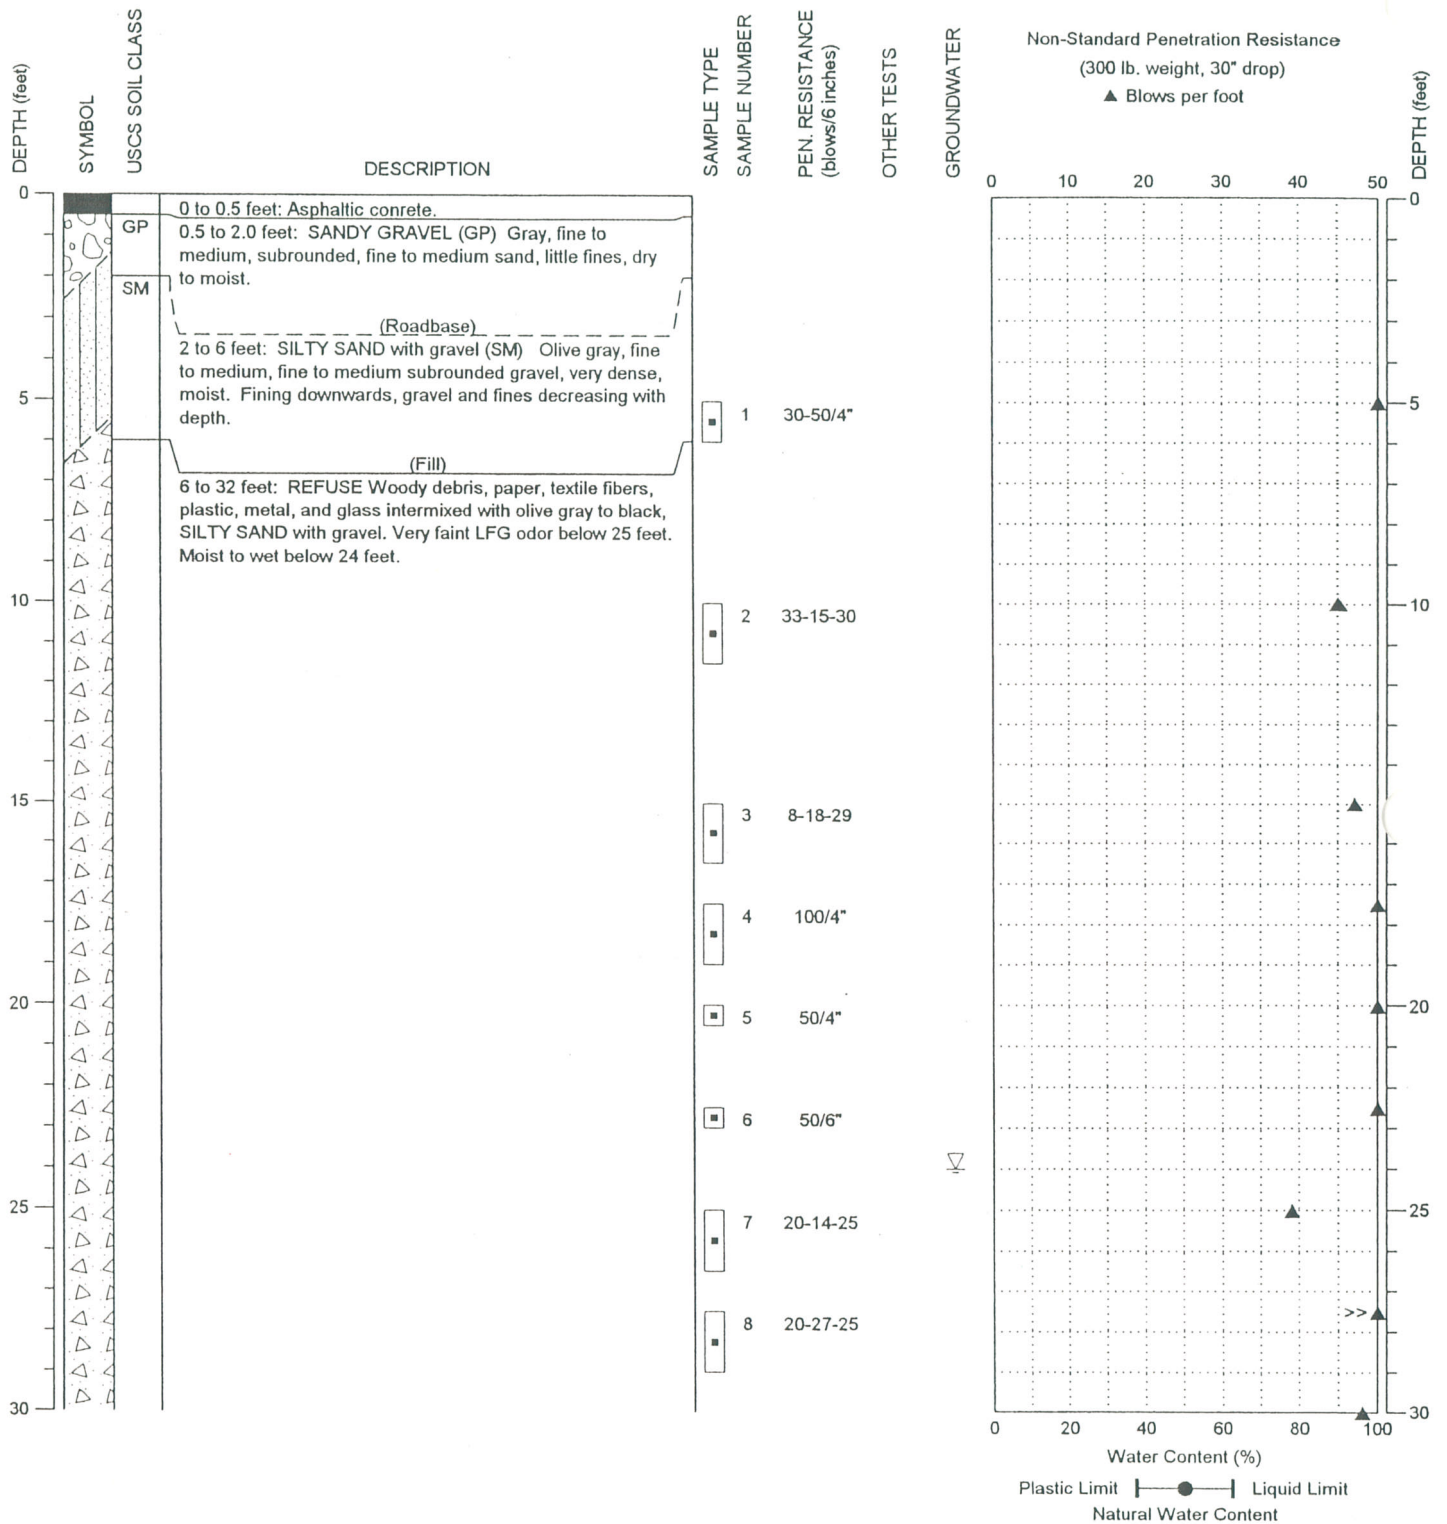

NOTE: This log of subsurface conditions applies only at the specified location and on the date indicated and therefore may not necessarily be indicative of other times and/or locations.




Vashon Island Landfill Access Road Evaluation  
 Vashon Island Landfill  
 King County, Washington

BORING:  
 BH-11  
 PAGE: 1 of 2



DRILLING COMPANY: Cascade Drilling, Inc.  
 DRILLING METHOD: CME 75, 4 1/4" HSA  
 SAMPLING METHOD: Wire line jars and D&M sampler  
 SURFACE ELEVATION: 402 ± feet

LOCATION: 12 ft NNE of KCB-1  
 DATE STARTED: 1/21/2002  
 DATE COMPLETED: 1/21/2002  
 LOGGED BY: S. Nelson

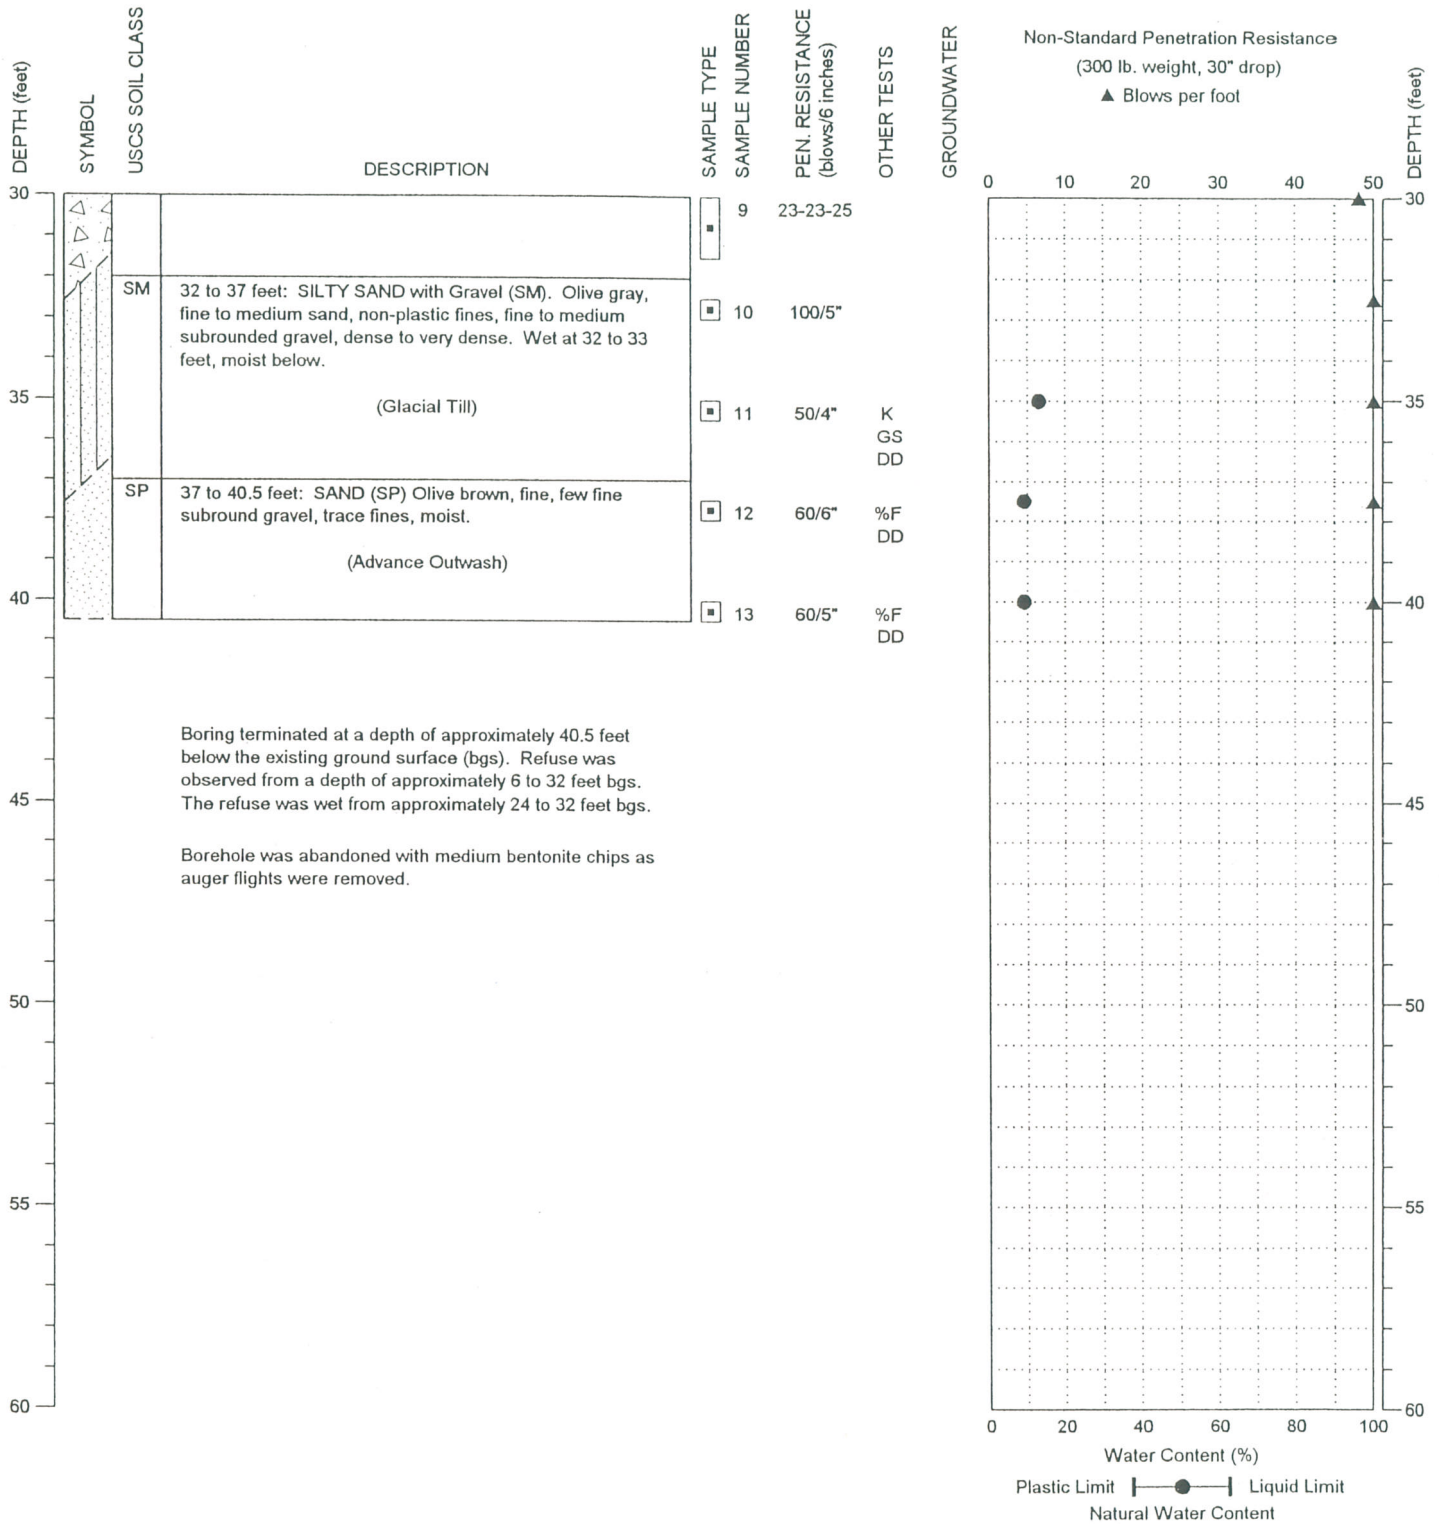

NOTE: This log of subsurface conditions applies only at the specified location and on the date indicated and therefore may not necessarily be indicative of other times and/or locations.



Vashon Island Landfill Access Road Evaluation  
 Vashon Island Landfill  
 King County, Washington

BORING:  
 BH-11

PAGE: 2 of 2

PROJECT NO.: 98158-4.1

FIGURE: A-10



**PROJECT** King County Ground Water Study - Vashon

Page 1 of 2

**Location** Northeast corner

**Boring No.** MW-1

**Surface Elevation** 403.64 ft.

**Drilling Method** Hollow Stem Auger (6" i

**Total Depth** 130 ft.

**Drilled By** Unitas/Kring

**Date Completed** 9/8/83

**Logged By** CEWells

WELL DETAILS	PENE-TRATION TIME/RATE	DEPTH (FEET)	SAMPLE		PERME-ABILITY TESTING	SYMBOL	LITHOLOGIC DESCRIPTION	WATER QUALITY
			NO.	TYPE				
Bentonite 3" dia. Sch. 80 PVC riser	N=24		1	D&M		SM-GM	0.0-35.0' <u>Gravelly sandy silt (Till)</u> - grey-tan, with some clay, occasional cobbles, some thin seams of clean sand, wet in sand seams, otherwise damp.	
	N=40	10	2	"				
	N=90		3	"				
	N=50/6"	20	4	"				
	N=50/5"		5	"				
	N=50/5.5"	30	6	"				
	N=100/3"		7	"				
	N=100/3"	40	8	"				
	N=100/4"		9	"				
	N=100/5"	50	10	"				
	N=50/6"		11	"				
	N=50/6"	60	12	"				
	N=49		13	"				
	N=50/6"	70	14	"				
					SM	35.0'-46.0' <u>Gravelly silty sand</u> - grey, occasional cobbles, dense, damp.		
					SW	46.0'-77.0' <u>Sand, gravelly sand</u> - grey-tan, medium grained, poorly graded to well graded, variable sand-gravel ratios, with some cobbles, moderately hard, moist to wet.		



# BORING LOG

PROJECT King County Ground Water Study - Vashon

Page 2 of 2

Boring No. MW-1

WELL DETAILS	PENE-TRATION TIME/RATE	DEPTH (FEET)	SAMPLE		PERME-ABILITY TESTING	SYMBOL	LITHOLOGIC DESCRIPTION	WATER QUALITY
			NO.	TYPE				
3" dia. PVC screen 0.010" slots 3" Sch. 80 PVC riser Bentonite Gravel Backfill	N=50/6"		15	D&M			77.0'-130' Sand- Grey, very fine to medium grained, poorly graded to moderately poorly graded, distinctly stratified, with thin silt seams from 100 to 115 ft., damp to 121 ft., saturated below 121 ft.	
	N=59	80	16	"				
	N=85/11"		17	"				
	N=69	90	18	"				
	N=90/11"		19	"		SP		
	N=50/6"	100	20	"				
	N=73		21	"				
	N=60	110	22	"				
	N=85		23	"				
	N=77/9"	120	24	"				
N=44		25	"					
N=50/5"	130	26	"					
		140						

Note: Penetration rate/ "N" value are based on blow counts using a Dames and Moore sampler.



PROJECT King County Ground Water Study - Vashon

Page 1 of 2

Location South side

Boring No. MW-2

Surface Elevation 313.31 ft.

Drilling Method Hollow Stem Auger (6" i.d.)

Total Depth 85 ft.

Drilled By Unitas/Kring

Date Completed 9/9/83

Logged By CEWells

WELL DETAILS	PENE-TRATION TIME/RATE	DEPTH (FEET)	SAMPLE		PERME-ABILITY TESTING	SYMBOL	LITHOLOGIC DESCRIPTION	WATER QUALITY
			NO.	TYPE				
Bentonite 3" dia. Sch. 80 PVC riser	N=9		1	D&M			0.0'-39.0' Sand- Tan and light grey, fine to moderately poorly graded, loose, with rare gravels, few dark brown, 1/8" thick organic seams at approximately 35 ft., damp.	
	N=12	10	2	"				
	N=10		3	"				
	N=22	20	4	"		SP		
	N=21		5	"				
	N=20	30	6	"				
	N=21		7	"				
	N=20	40	8	"				
	N=22		9	"				
	N=24	50	10	"				
	N=26		11	"				
	N=22	60	12	"				
	N=24		13	"				
	N=27	70	14	"		SP	67.0'-78.0' Sand- Light brown to grey, fine to medium grained, poorly	



PROJECT King County Ground Water Study - Vashon

Page 2 of 2

Boring No. MW-2

WELL DETAILS	PENE-TRATION TIME/RATE	DEPTH (FEET)	SAMPLE		PERME-ABILITY TESTING	SYMBOL	LITHOLOGIC DESCRIPTION	WATER QUALITY
			NO.	TYPE				
3" dia. Sch. 80 PVC, 0.010" slots Gravel Backfill	N=28		15	D&M		SP	graded, wet to saturated.	
	N=30	80	16	"		ML	78.0'-85.0' <u>Silt</u> - Dark grey, dense to very dense, hard, with some clay, damp.	
	N=70	90	17	"				
		100						
		110						
		120						
		130						
		140						

Note: Penetration rate/  
 "N" value are based on  
 blow counts using a  
 Dames and Moore sampler.



**PROJECT** King County Ground Water Study - Vashon

**Page** 1 **of** 1

**Location** South side

**Boring No.** MW-3

**Surface Elevation** 313.54 ft.

**Drilling Method** Hollow Stem Auger (6" i.d.)

**Total Depth** 40 ft.

**Drilled By** Unitas/Kring

**Date Completed** 9/12/83

**Logged By** CEWells

WELL DETAILS	PENE-TRATION TIME/RATE	DEPTH (FEET)	SAMPLE		PERME-ABILITY TESTING	SYMBOL	LITHOLOGIC DESCRIPTION	WATER QUALITY
			NO.	TYPE				
Bentonite 3" dia. Sch. 80 PVC riser Bentonite Pellets 3" dia. Sch. 80 PVC, 0.010" slots Gravel		10	None taken.				See log for MW-2.	
		20						
		30						
		40						
		50						
		60						
		70						



PROJECT King County Ground Water Study - Vashon

Page 1 of 2

Location West side

Boring No. MW-4

Surface Elevation 374.33 ft.

Drilling Method Hollow Stem Auger (6" i.d.)

Total Depth 110 ft.

Drilled By Unitas/Kring

Date Completed 9/14/83

Logged By CEWells

WELL DETAILS	PENE-TRATION TIME/RATE	DEPTH (FEET)	SAMPLE		PERME-ABILITY TESTING	SYMBOL	LITHOLOGIC DESCRIPTION	WATER QUALITY
			NO.	TYPE				
Bentonite 3" dia. Sch. 80 PVC riser	N=68	0	1	D&M			0.0'-23.0' <u>Gravelly sandy silt (Till)</u> - Grey-tan, with some cobbles, well graded, moderately dense, dry.	
	N=36	10	2	"		SM-GM		
	N=48		3	"				
	N=50	20	4	"				
	N=38		5	"			23.0'-36.0' <u>Sand, gravelly sand</u> - Grey or grey-tan, medium to coarse grained sand with gravel to one inch diameter, occasional cobbles, well graded, damp.	
	N=36	30	6	"		SW		
	N=34		7	"				
	N=37	40	8	"			36.0'-103.0' <u>Sand</u> - Grey-tan or grey, variable/stratified, fine to very coarse, poorly graded to well graded, loose, occasional silty sand zones, gravelly zones below 75 ft., damp to wet.	
	N=35		9	"				
	N=28	50	10	"			SP	
	N=30		11	"				
	N=41	60	12	"				
	N=36		13	"				
	N=40	70	14	"				



WELL DETAILS	PENE-TRATION TIME/RATE	DEPTH (FEET)	SAMPLE		PERME-ABILITY TESTING	SYMBOL	LITHOLOGIC DESCRIPTION	WATER QUALITY
			NO.	TYPE				
	N=31		15	D&M				
	N=44	80	16	"				
	N=46		17	"	SP			
	N=54	90	18	"				
	N=55		19	"				
	N=53	100	20	"				
	N=37		21	"				
	N=30	110	22	"	ML			
		120						
		130						
	140							
						103.0'-110.0' <u>Silt- Grey</u> , dense, with some very fine sand, wet to saturated.		
						Note: Penetration rate/ "N" value are based on blow counts using a Dames and Moore sampler.		



# RECORD OF BOREHOLE MW-5

Figure A-5

Page 1 of 5


LOCATION See Figure 2

DATUM 355.86 ft. MSL

DATE 3-6-86

SAMPLER HAMMER WEIGHT 320 LB., DROP 19 IN.

BORING METHOD-CABLE TOOL

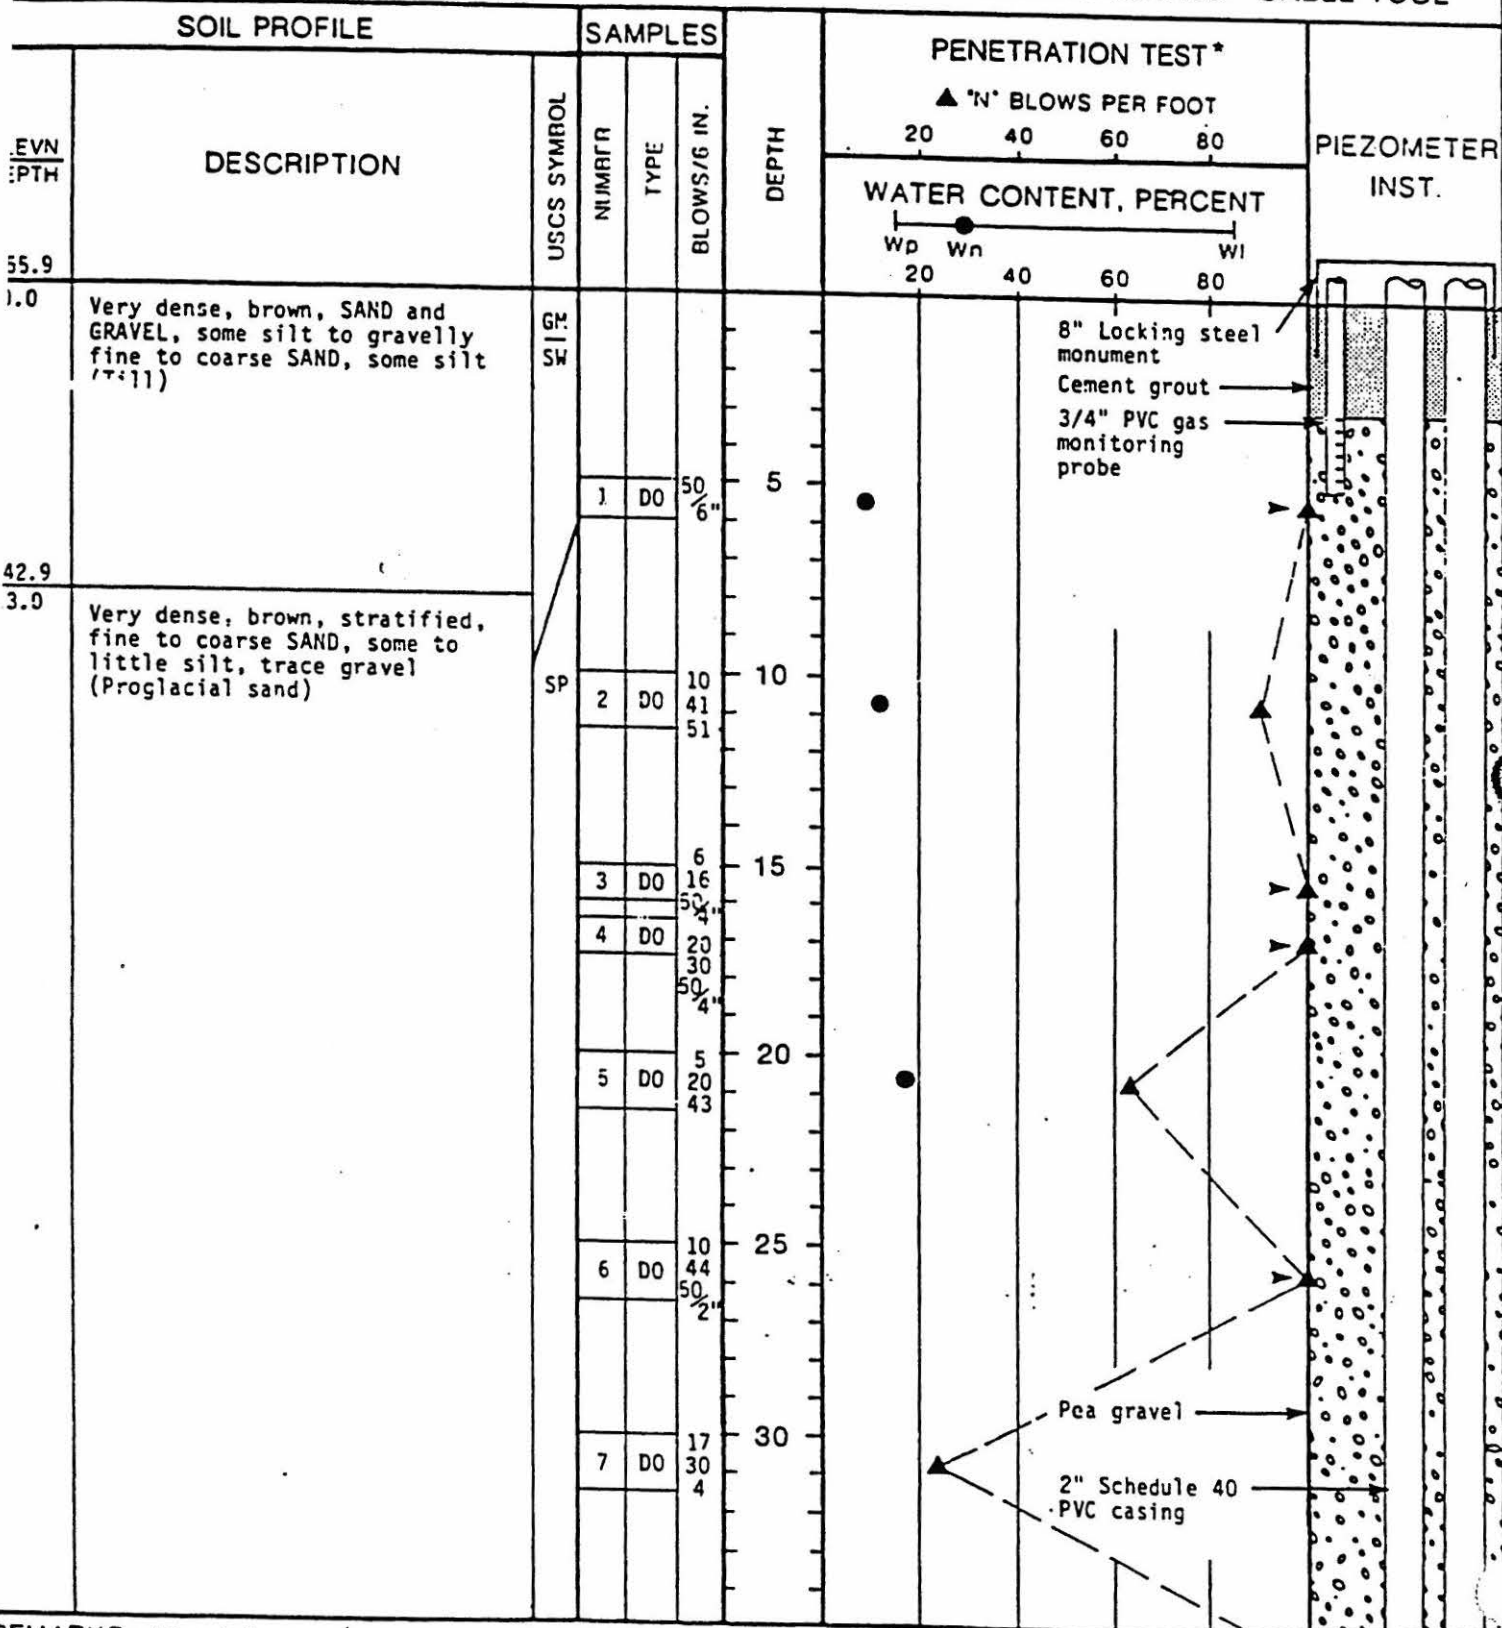

REMARKS: DO = Drive Open  
 \* 320 lbs. hammer falling 1.6 ft.

VERTICAL SCALE  
 1 IN. TO 5 FT.

Golder Associates

VASHON LANDFILL  
 JOB # 853-1047 05

# RECORD OF BOREHOLE MW-5

Figure A-5

Page 2 of 5

LOCATION See Figure 2



DATUM 355.86 ft. MSL

DATE 3-6-86

SAMPLER HAMMER WEIGHT 320 LB., DROP 19 IN.

BORING METHOD-CABLE TOOL

SOIL PROFILE		SAMPLES			DEPTH	PENETRATION TEST *		PIEZOMETER INST.			
EVN PTH	DESCRIPTION	USCS SYMBOL	NUMBER	TYPE		BLOWS/6 IN.	20		40	60	80
	Very dense, brown, stratified, fine to coarse SAND, some to little silt, trace gravel (Proglacial sand)	SP	8	DO	14 32 50 4"						
			9	DO	16 50	40					
			10	DO	11 50 4"	45					
			11	DO	9 18 51	50					
			12	DO	2 4 47	55					
			13	DO	1 31 50 4"	60					
			14	DO	23 50 6"	65					
			15	DO	10 41 50 4"						

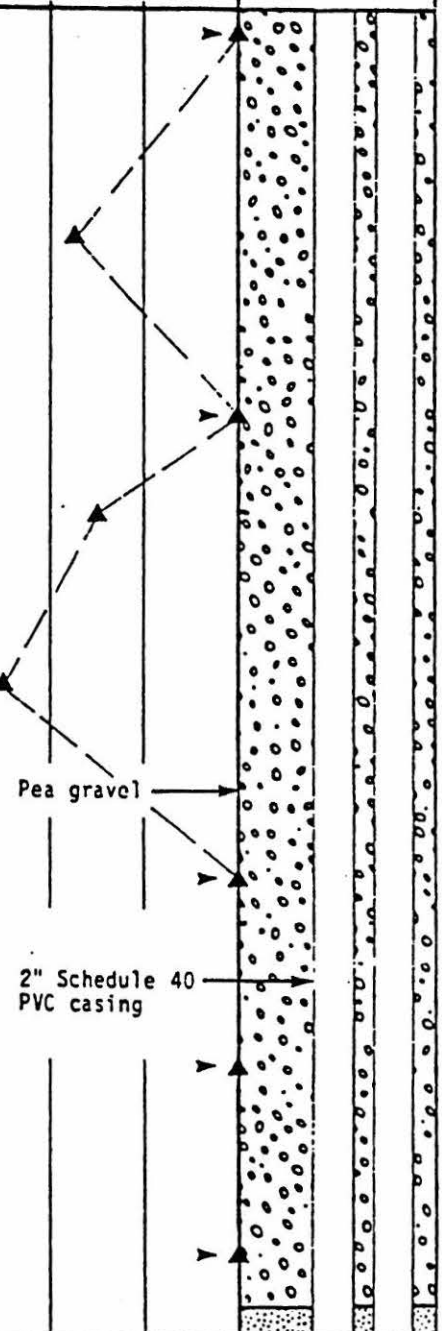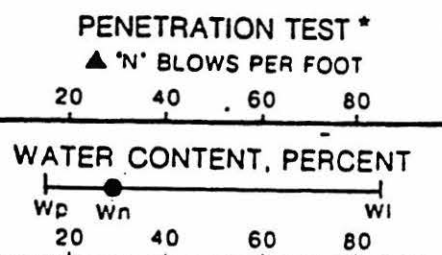

REMARKS:

# RECORD OF BOREHOLE MW-5

Figure A-5

Page 3 of 5


LOCATION See Figure 2

DATUM 355.86 ft. MSL

DATE 3-6-86

SAMPLER HAMMER WEIGHT 320 LB., DROP 19 IN.

BORING METHOD-CABLE TOOL

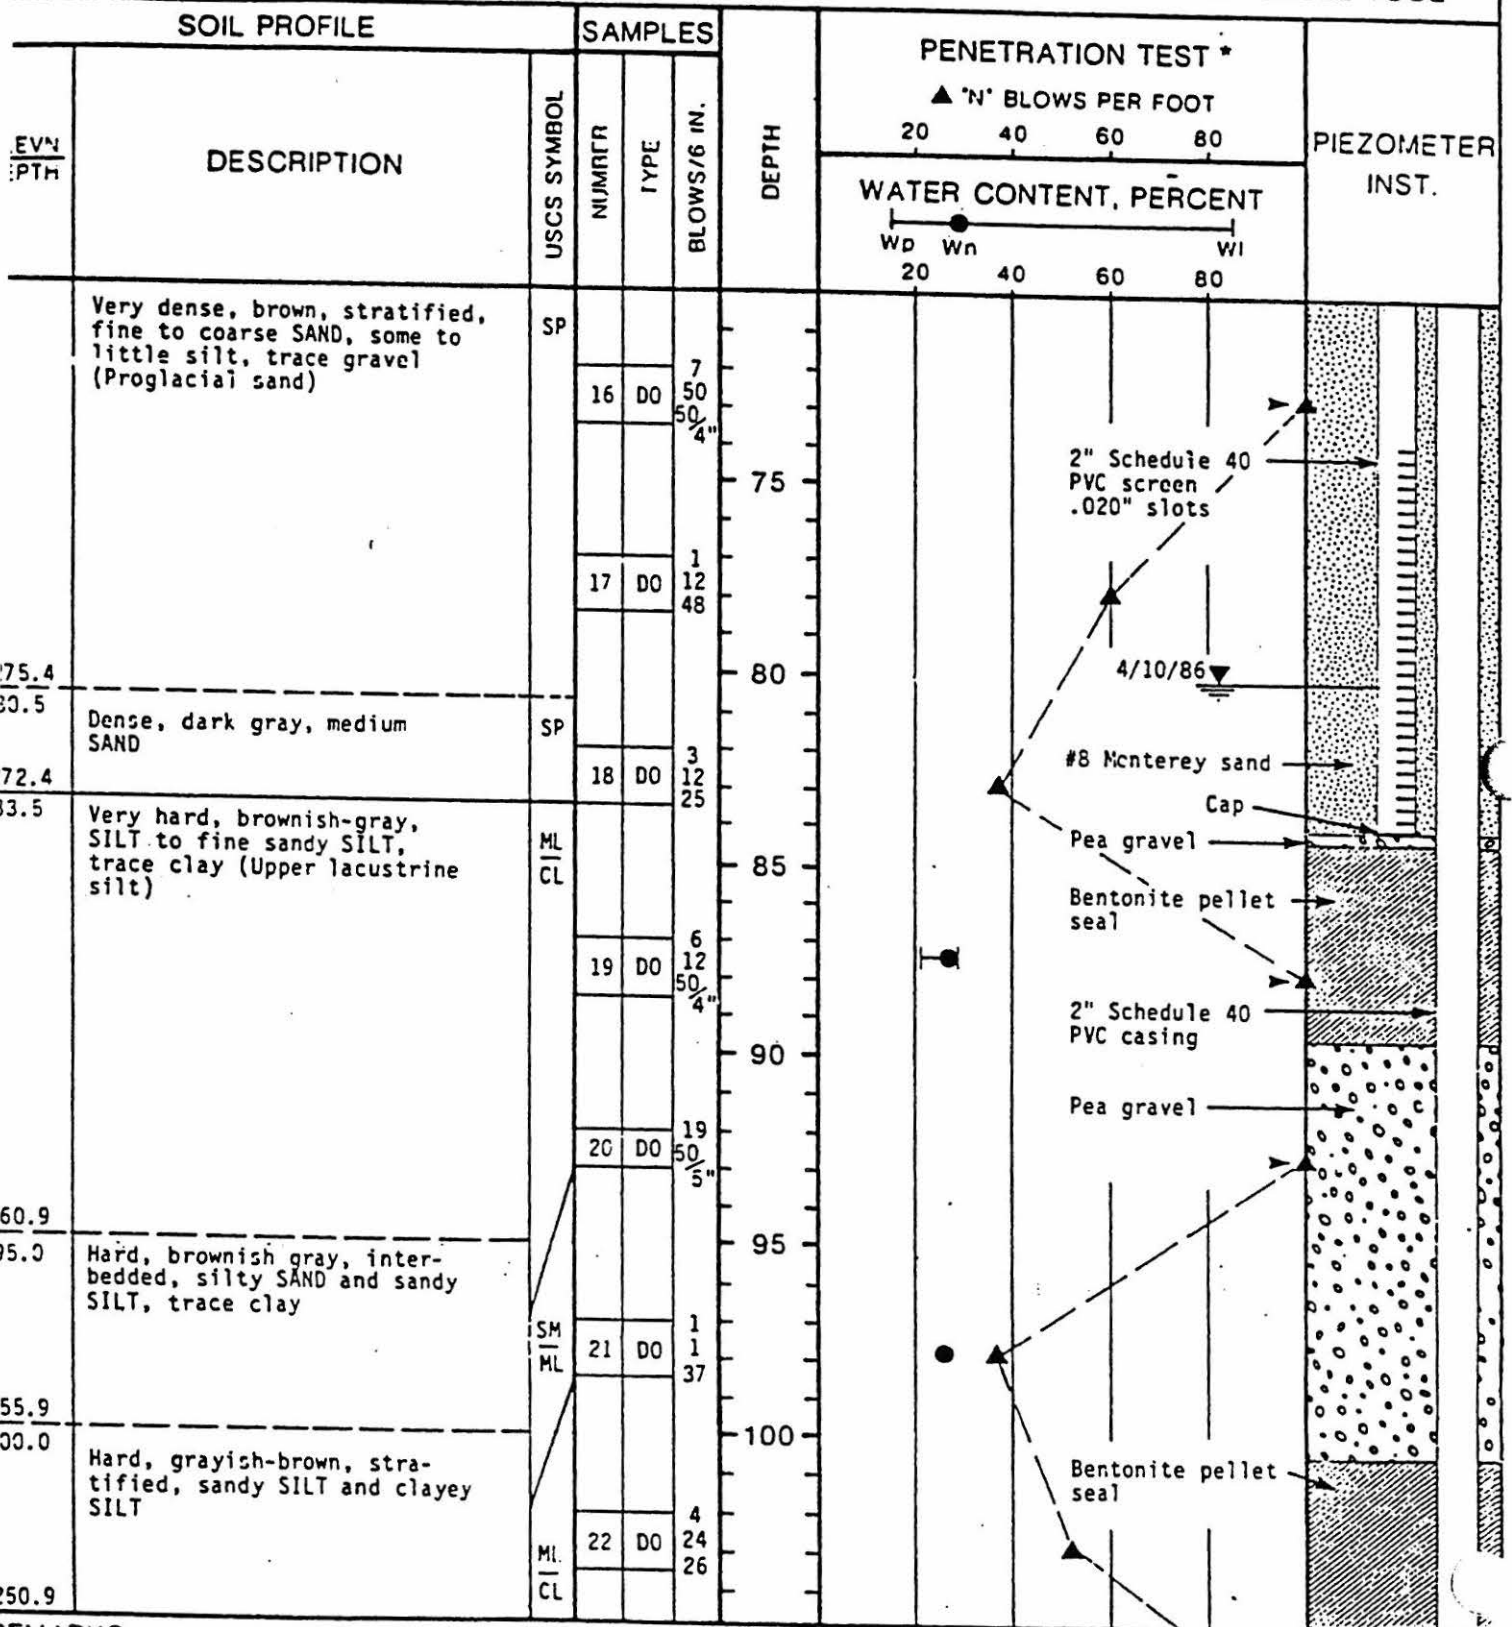

REMARKS:

VERTICAL SCALE

Golder Associates

VASHON LANDFILL  
100 - 950 - 1047 05

# RECORD OF BOREHOLE MW-5

Figure A-5

Page 4 of 5

LOCATION See Figure 2

DATUM 355.86 ft. MSL

DATE 3-6-86

SAMPLER HAMMER WEIGHT 320 LB., DROP 19 IN.

BORING METHOD - CABLE TOOL

SOIL PROFILE		SAMPLES			DEPTH	PENETRATION TEST *				PIEZOMETER INST.	
LEVL EPTH	DESCRIPTION	USCS SYMBOL	NUMRFR	TYPE		BLOWS/6 IN.	▲ 'N' BLOWS PER FOOT				
							20	40	60		80
						WATER CONTENT, PERCENT					
						Wp	Wn			Wi	
						20	40	60	80		
05.0	Very dense to very hard, dark gray, stratified, silty fine SAND, fine sandy SILT and SILT, trace fine sand	ML CL			12 34 50 5" 5"						
245.9			23	DO							
110.0	Very dense to very hard, grayish-brown, medium to fine SAND and SILT	SM			75 6"						
110.0			24	SO							
115.0					43 50 5" 4"						
115.0			25	DO							
120.0	Very dense, brownish-gray, silty fine to medium SAND	SM			36 50 2"						
235.9			26	DO							
120.0					24 50 4"						
124.0	Very hard, dark gray, clayey SILT (Lower lacustrine silt)	CH			24 50 4"						
124.0			27	DC							
130.0					37 50 4"						
224.9	Very dense, brown, fine to coarse SAND, little silt, trace fine gravel	SM SP			25 50 6"						
131.0			28	DC							
135.0					25 50 6"						
135.0			29	DO							

REMARKS:

# RECORD OF BOREHOLE MW-5

Figure A-5

Page 5 of 5

LOCATION See Figure 2

DATUM 355.86 ft. MSL

DATE 3-6-86

SAMPLER HAMMER WEIGHT 320 LB., DROP 19 IN.

BORING METHOD - CABLE TOOL

SOIL PROFILE		SAMPLES			DEPTH	PENETRATION TEST *				PIEZOMETER INST.	
ELEV DEPTH	DESCRIPTION	USCS SYMBOL	NUMBR	TYPE		BLOWS/6 IN.	▲ 'N' BLOWS PER FOOT				
							20	40	60		80
						WATER CONTENT, PERCENT					
						Wp	Wn	Wi			
						20	40	60	80		
210.9	Very dense, brown, fine to coarse SAND, little silt, trace fine gravel	SM SP			31						
145.0			30	DO	50	4"					
206.9	Very dense, dark gray, fine sandy SILT to silty fine SAND	SM ML			18						
149.0			31	DO	50	5"					
204.9	Very dense, dark gray, fine SAND, trace silt	SP			16						
151.0			32	DO	50	6"					
151.0	End of hole at 151.0 feet										

REMARKS:

VERTICAL SCALE  
1 IN TO 5 FT

Golder Associates

VASHON LANDFILL  
JOB # 853-1047.05

# RECORD OF BOREHOLE MW6

Figure A-6

Page 1 of 5


LOCATION See Figure 2

DATUM 392.42 ft. MSL

DATE 3-19-86

SAMPLER HAMMER WEIGHT 320 LB., DROP 19 IN.

BORING METHOD - CABLE TOOL

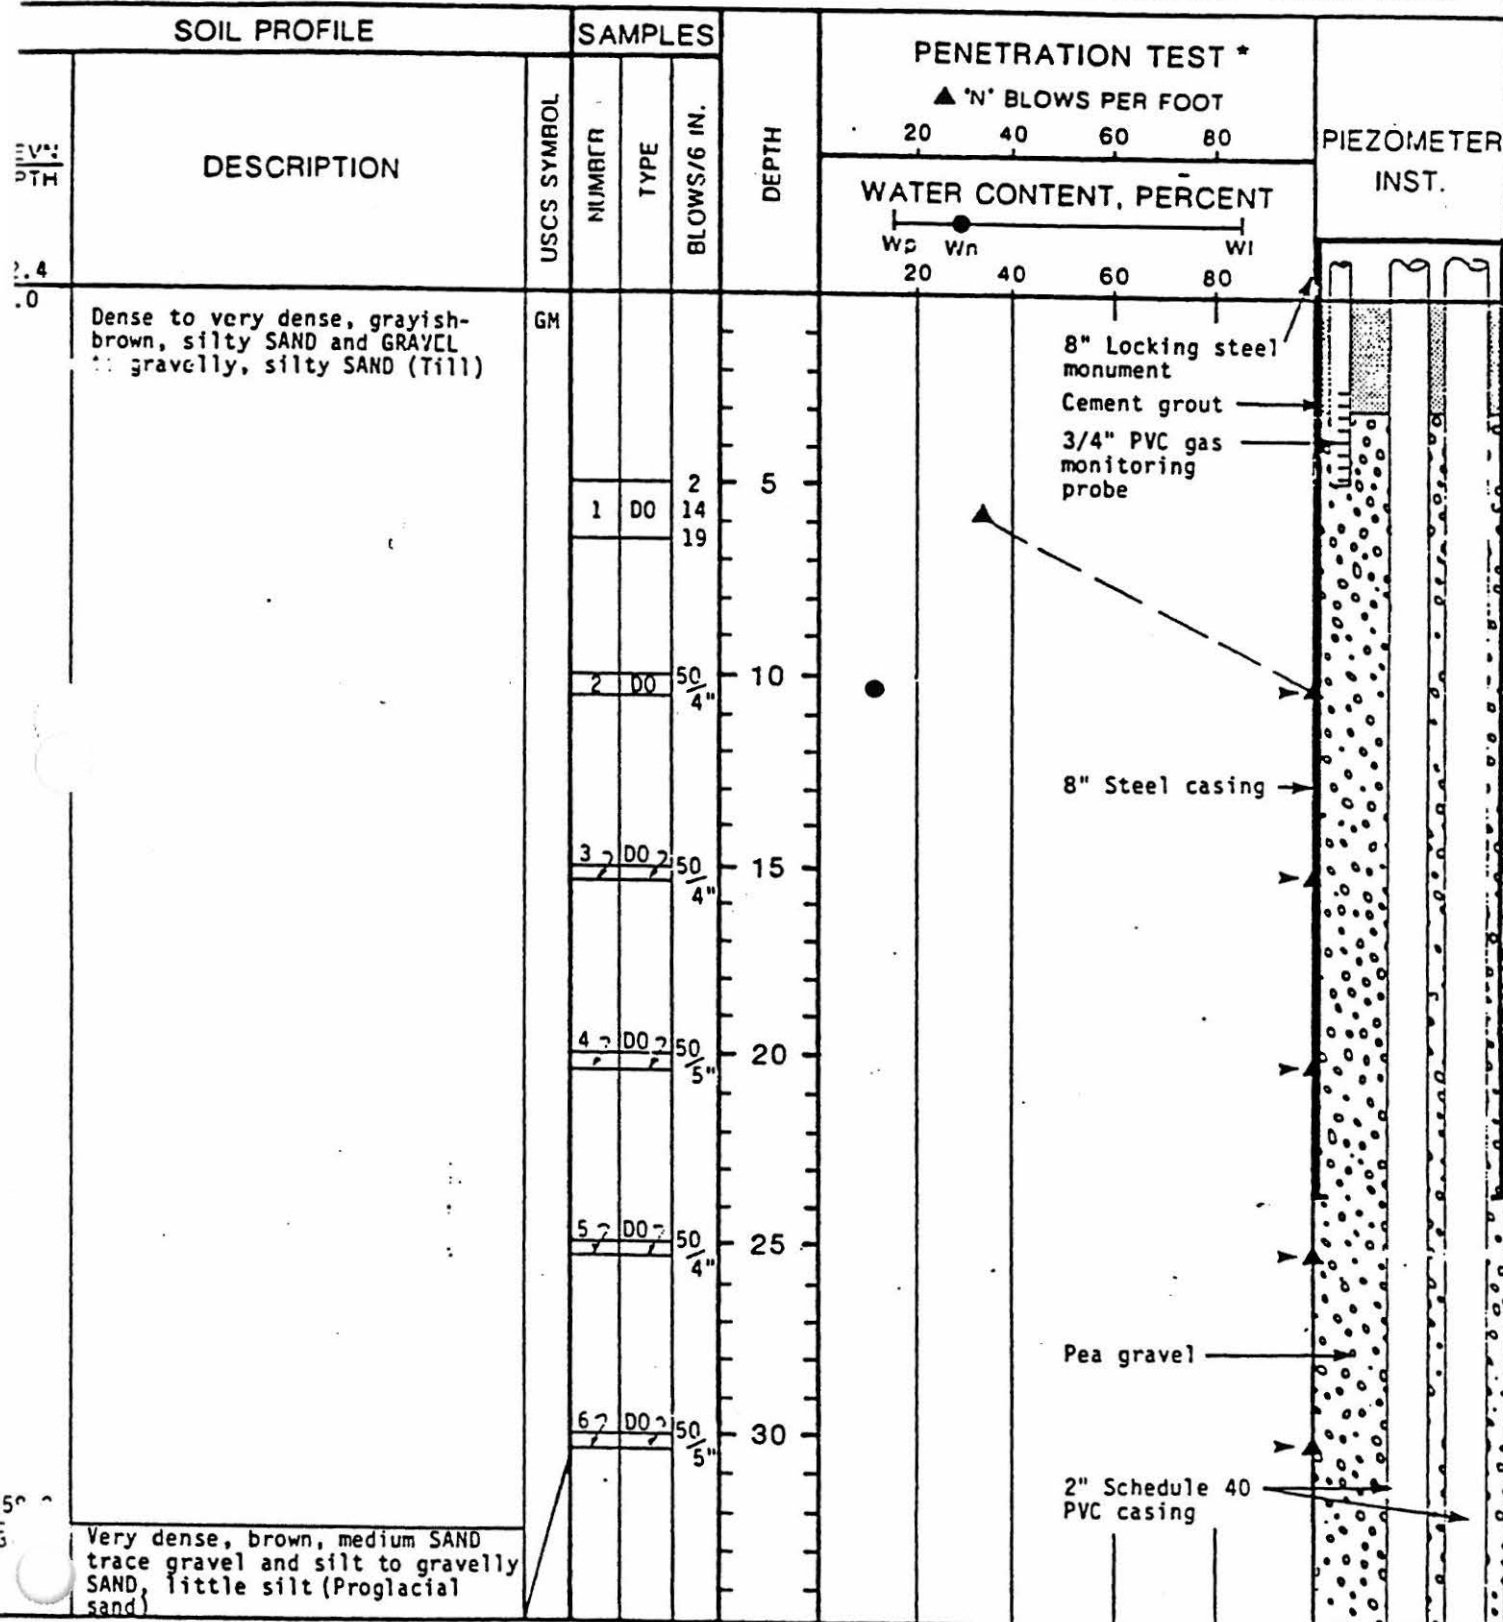

REMARKS: DO = Drive Open

\* 320 lbs. hammer falling 1.6 ft.

VERTICAL SCALE

Golden Association

VASHON LANDFILL

# RECORD OF BOREHOLE MW6

Figure A-6

Page 2 of 5

LOCATION See Figure 2

DATUM 392.42 ft. MSL

DATE 3-19-86

SAMPLER HAMMER WEIGHT 320 LB., DROP 19 IN.

BORING METHOD-CABLE TOOL

SOIL PROFILE			SAMPLES			DEPTH	PENETRATION TEST *				PIEZOMETER INST.	
LEVN EPTH	DESCRIPTION	USCS SYMBOL	NUMBER	TYPE	BLOWS/6 IN.		▲ 'N' BLOWS PER FOOT					
							20	40	60	80		
						WATER CONTENT, PERCENT						
						Wp	Wn			Wi		
						20	40	60	80			
	Very dense, brown, medium SAND trace gravel and silt to gravelly SAND, little silt (Proglacial sand)	SP / SW	7	DO	100 6"							
			8	DO	13 50 5"	40	●					
			9	DO	21 50 4"	45						
			10	DO	18 50 6"	50						
			11	DO	70 6"	55						
			12	DO	17 50 5"	60						
			13	DO	9 22 50 2"	65	●					

Pea gravel  
2" Schedule 40 PVC casing

REMARKS:

VERTICAL SCALE

Golder Associates

VASHON LANDFILL

# RECORD OF BOREHOLE MW6

Figure A-6

Page 3 of 5

LOCATION See Figure 2

DATUM 392.42 ft. MSL

DATE 3-19-86

SAMPLER HAMMER WEIGHT 320 LB., DROP 19 IN.

BORING METHOD—CABLE TOOL

SOIL PROFILE		SAMPLES			DEPTH	PENETRATION TEST*				PIEZOMETER INST.		
LEVN DEPTH	DESCRIPTION	USCS SYMBOL	NUMBER	TYPE		BLOWS/6 IN.	▲ "N" BLOWS PER FOOT					
							20	40	60		80	
						WATER CONTENT, PERCENT						
						Wp	Wn			Wi		
						20	40	60	80			
	Very dense, brown, medium SAND trace gravel and silt to gravelly SAND, little silt (Proglacial sand)	SP SW	14	DO	17 50 5"							
			15	DO	15 50 4"	75						
			16	DO	9 50 6"	80						
			17	DO	7 36 50 4"	85	●					
304.4 88.0	Very dense, brown, fine SAND and silty fine SAND	SM	18	DO	10 28 50							
			19	DO	2 23 50	95						
299.4 93.0	Very dense, brown, medium SAND trace gravel and silt to gravelly SAND, little silt (Proglacial sand)	SP	20	DO	11 40 50	100						

REMARKS:



# RECORD OF BOREHOLE MW6

Figure A-6

Page 4 of 5


LOCATION See Figure 2

DATUM 392.42 ft. MSL

DATE 3-19-86

SAMPLER HAMMER WEIGHT 320 LB., DROP 19 IN.

BORING METHOD - CABLE TOOL

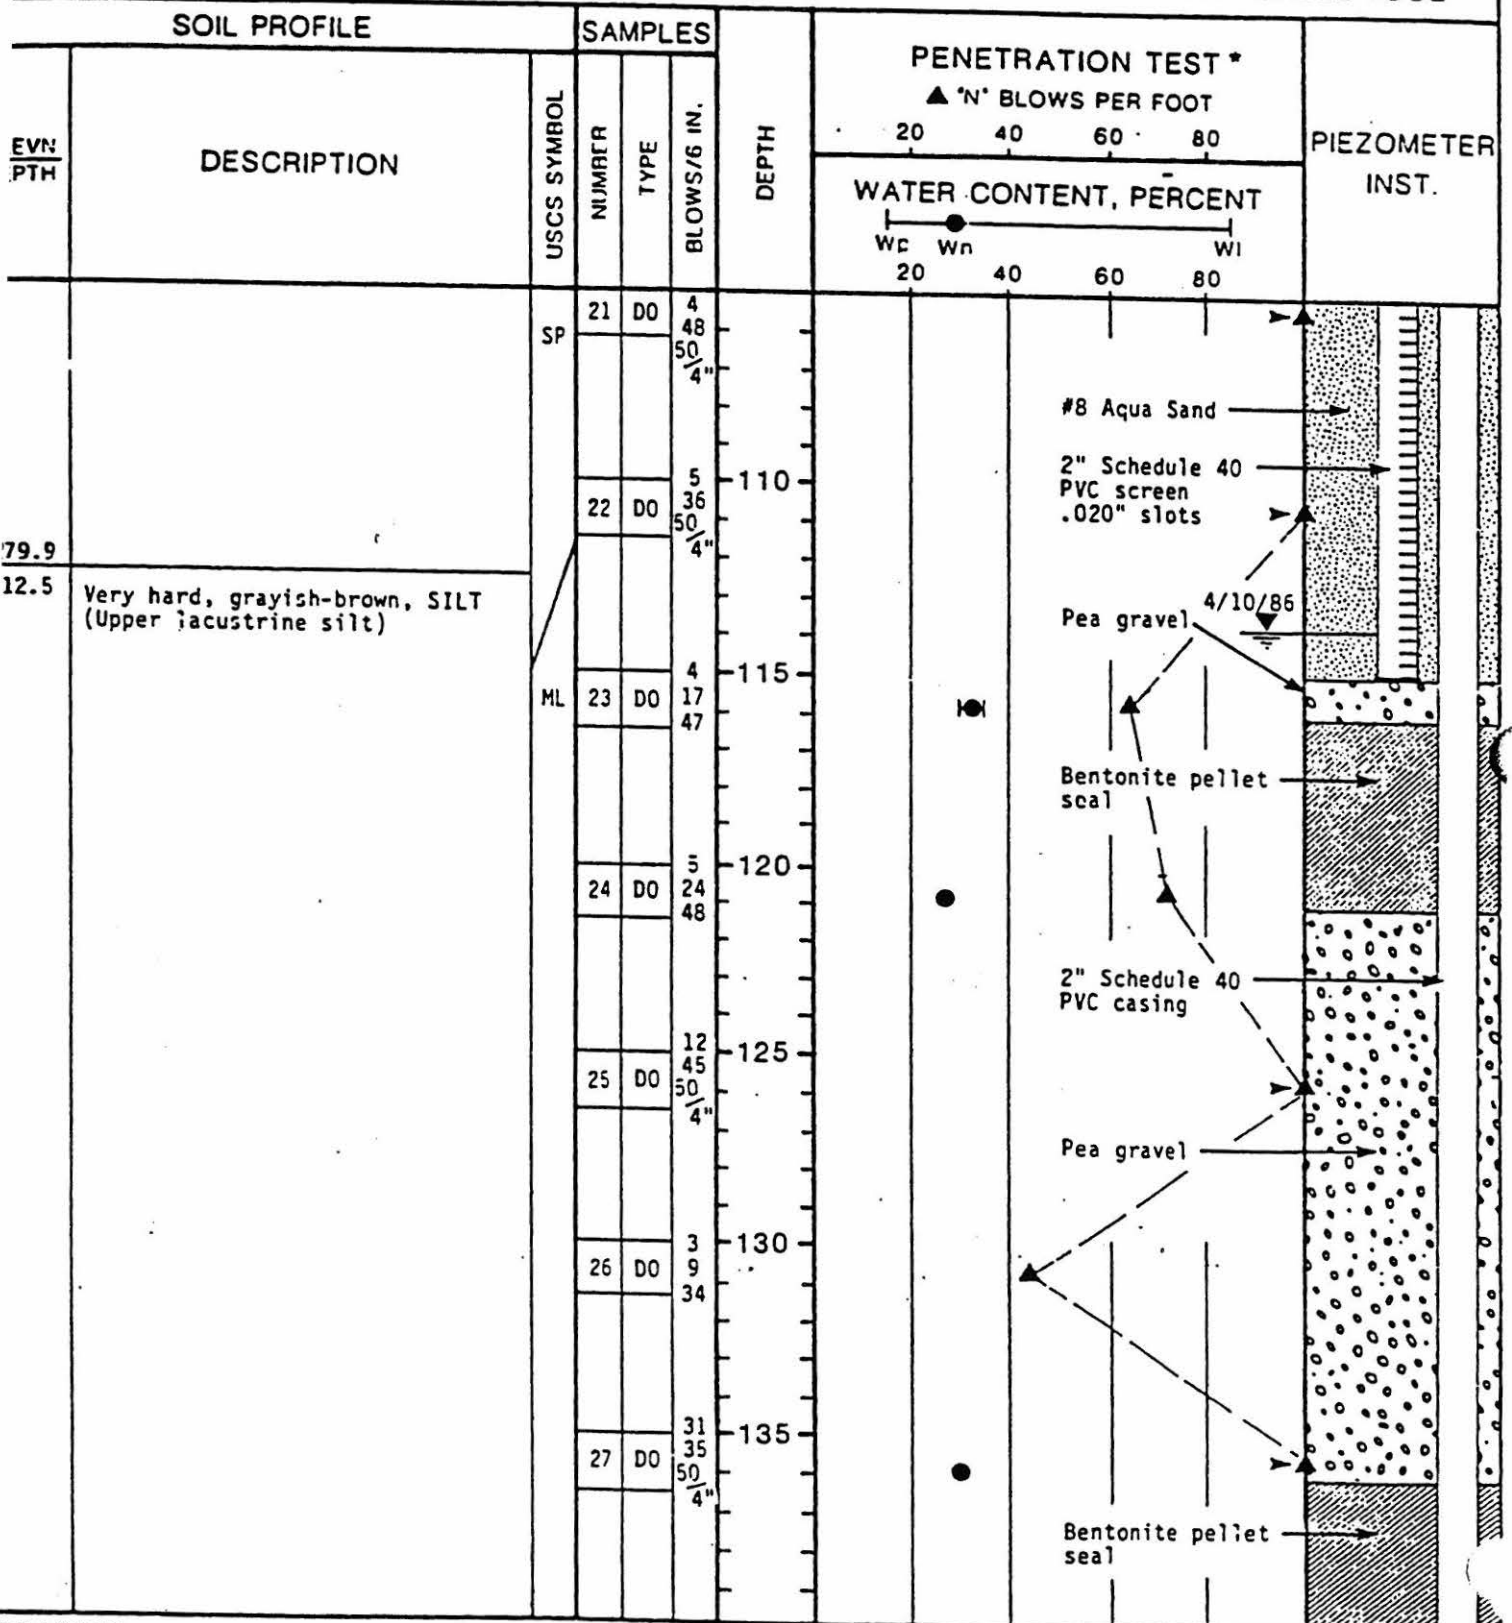

REMARKS:

VERTICAL SCALE

VASHON LANDFILL

# RECORD OF BOREHOLE MW6

Figure A-6

Page 5 of 5

LOCATION See Figure 2


DATUM 392.42 ft. MSL

DATE 3-19-86

SAMPLER HAMMER WEIGHT 320 LB., DROP 19 IN.

BORING METHOD - CABLE TOOL

SOIL PROFILE		SAMPLES			DEPTH	PENETRATION TEST *				PIEZOMETER INST.	
ELEVATION DEPTH	DESCRIPTION	USCS SYMBOL	NUMBER	TYPE		BLOWS/6 IN.	▲ 'N' BLOWS PER FOOT				
							20	40	60		80
						WATER CONTENT, PERCENT					
						Wp	Wn			Wi	
						20	40	60	80		
251.5			28	DO	29						
140.9	Very dense, brown, fine to medium SAND, trace to little silt	SP			50						
249.4						3					
143.0	Hard, dark gray, SILT (Upper lacustrine unit)	ML			14						
244.4						20					
148.0	Very dense, brown to brownish-gray, fine to coarse SAND, little to trace gravel and silt	SW			50						
244.4						4					
235.4	Very dense, brownish-gray, gravelly SAND, trace silt	SP			2						
157.0						17					
233.4	Very hard, brownish-gray, SILT and medium to fine SAND (Lower lacustrine unit)	ML			5						
159.0						17					
232.1	Very dense, gray, fine to coarse SAND, little gravel	SW			2						
160.3						9					
230.4	Very dense, gray, fine to coarse SAND, little gravel	SW			12						
162.0						3					
225.9	End of hole at 166.5 feet.				15						
166.5						50					

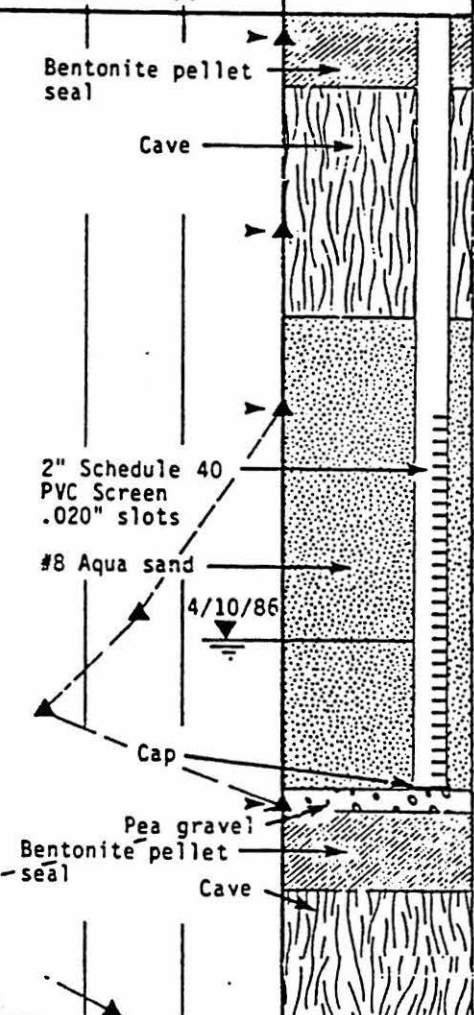

REMARKS:



PROJECT NUMBER 106241.E3.ZZ	BORING NUMBER MW-7C
Renumbered as MW-7 SHEET 1 OF 4	
<b>BOREHOLE/WELL CONSTRUCTION LOG</b>	

PROJECT VASHON ISLAND LANDFILL LOCATION N583.02, E2987.97  
 ELEVATION 371.09 DRILLING CONTRACTOR TACOMA PUMP & DRILLING INC.  
 DRILLING METHOD AND EQUIPMENT AIR ROTARY  
 WATER LEVELS N/A START 04/21/95 FINISH 04/28/95 LOGGER T.O'CONNOR

DEPTH BELOW SURFACE (FT)	SAMPLE			STANDARD PENETRATION TEST RESULTS	SOIL DESCRIPTION	WELL COMPLETION DIAGRAM
	INTERVAL	TYPE AND NUMBER	RECOVERY			
10.0				6" - 6" - 6" (N)	SOIL NAME, USCS GROUP SYMBOL, COLOR, MOISTURE CONTENT, RELATIVE DENSITY OR CONSISTENCY, SOIL STRUCTURE, MINERALOGY  SILTY SAND (SM), light brown/gray, moist, firm, trace gravel up to 1" diameter	<p style="font-size: small;">             6" Dia. Steel Protective Casing w/Locking Cap              8" Diameter Borehole              Bentonite Grout Seal              2" Dia. Flush Threaded, Sch 40 Casing w/"O" Ring Seals              Cement           </p>
20.0	20 21.5	SS	8"	50-100/6"		
30.0						
40.0	40 41.5	SS	1.0'	75-100/6"		
50.0					WELL GRADED SAND WITH GRAVEL (SW), gray brown, moist, firm	
60.0	60 61.5	SS	18"	50-200	SILTY SAND WITH GRAVEL (SM), gray brown, moist, firm	
70.0						
80.0	80 81.5	SS	18"	13-65-50/5"	SANDY SILT (ML), gray brown, moist, firm  SILT (ML), gray brown, moist, firm, dense	
90.0						
100.0						

VHM-7C LOG  
 Use WELLBORE Template



PROJECT NUMBER  
106241.E3.ZZ

BORING NUMBER  
MW-7C

Renumbered as MW-7

SHEET 2 OF 4

BOREHOLE/WELL CONSTRUCTION LOG

PROJECT VASHON ISLAND LANDFILL

LOCATION N583.02, E2987.97

ELEVATION 371.09

DRILLING CONTRACTOR TACOMA PUMP & DRILLING INC.

DRILLING METHOD AND EQUIPMENT AIR ROTARY

WATER LEVELS N/A

START 04/21/95

FINISH 04/28/95

LOGGER T.O'CONNOR

DEPTH BELOW SURFACE (FT)	SAMPLE			STANDARD PENETRATION TEST RESULTS 6" - 6" - 6" (N)	SOIL DESCRIPTION SOIL NAME, USCS GROUP SYMBOL, COLOR, MOISTURE CONTENT, RELATIVE DENSITY OR CONSISTENCY, SOIL STRUCTURE, MINERALOGY	WELL COMPLETION DIAGRAM		
	INTERVAL	TYPE AND NUMBER	RECOVERY			DEPTH OF CASING, DRILLING RATE, DRILLING FLUID LOSS TESTS AND INSTRUMENTATION		
100.0	100.0 - 101.5	SS	1.0'	25-45-25/5"	SILT WITH SAND (ML), gray, moist, firm	8" Diameter Borehole	Bentonite Grout Seal	2" Dia. Flush Threaded, Sch 40 Casing w/ 1" Ring Seals
110.0				SILT (ML), trace fine sand, wet, firm, high plasticity				
120.0	120.0 - 121.5	SS	1.5'	13-20-50/5"	SILT WITH SAND (ML), gray, saturated, firm, slightly plastic			
130.0								
140.0	140.0 - 141.5	SS	1.2'	35-50-50/5"				
150.0								
160.0	160.0 - 161.5	SS	1.5'	2-2-3	SILTY SAND (SW), gray, wet, firm SILT (ML), gray, moist, firm, dense			
170.0					SANDY SILT (ML), gray, firm, saturated			
180.0	180.0 - 181.5	SS	1.4'	15-35-50/4"	FAT CLAY (CH), gray, dry, brittle, very dense, very hard SANDY SILT (ML), gray/brown, damp, firm, hard and very hard, dense			
190.0								

VJHW-7C LOG Use WELLDRE 15 plate



PROJECT NUMBER 106241.E3.22	BORING NUMBER MW-7C	Renumbered as MW-7
		SHEET 3 OF 4

## BOREHOLE/WELL CONSTRUCTION LOG

PROJECT VASHON ISLAND LANDFILL LOCATION N583.02. E2987.97  
 ELEVATION 371.09 DRILLING CONTRACTOR TACOMA PUMP & DRILLING INC.  
 DRILLING METHOD AND EQUIPMENT AIR ROTARY  
 WATER LEVELS N/A START 04/21/95 FINISH 04/28/95 LOGGER T.O'CONNOR

DEPTH BELOW SURFACE (FT)	SAMPLE			STANDARD PENETRATION TEST RESULTS 6" - 6" - 6" (N)	SOIL DESCRIPTION SOIL NAME, USCS GROUP SYMBOL, COLOR, MOISTURE CONTENT, RELATIVE DENSITY OR CONSISTENCY, SOIL STRUCTURE, MINERALOGY	WELL COMPLETION DIAGRAM DEPTH OF CASING, DRILLING RATE, DRILLING FLUID LOSS TESTS AND INSTRUMENTATION
	INTERVAL	TYPE AND NUMBER	RECOVERY			
200.0	200.5 - 201.5	SS	1.0'	8-15-30	<p><u>CLAYEY SAND (SC)</u>, gray/brown, moist, firm, dense, trace 1/4" gravel</p> <p><u>SILT WITH GRAVEL (ML)</u>, gray/brown, moist, firm, gravel sub angular up to 2 diameter</p>	<p>8" Diameter Borehole, No. 20-40 Colorado Silica Sand Filter Pack</p> <p>Bentonite Grout Seal</p> <p>2" Dia. Flush Threaded Sch 40 Casing w/ 0" Ring Seals</p> <p>2" Dia. Sump &amp; End Cap (0.010" Fly Cut Sump &amp; End Cap) Centralizer</p>
220.0	220 - 221.5	SS	6"	12-16-30	<u>POORLY GRADED SAND WITH SILT AND GRAVEL (SP-SM)</u> , gray, saturated, firm	
230.0					<u>SILT (ML)</u> , gray, moist (wet), dense to very dense	
240.0	240 - 241.5	SS	1.2'	18-30-30	<u>FAT CLAY (CH)</u> , gray/brown, dry/moist, brittle, very dense	
250.0					<u>SILTY GRAVEL WITH SAND (GM)</u> , gray/brown, wet, saturated, wood fragments (3%)	
260.0	260 - 261.5	SS	.5'	6-15-25	<u>POORLY GRADED SAND WITH SILT (SP-SM)</u> , gray, wet, white pumice or tuff, trace silt, trace gravel 1/4-1/2" diameter Wood fragments in sample	
270.0					<u>SILTY GRAVEL WITH SAND (GM)</u> , gray/brown, wet, saturated, wood fragments (3%)	
280.0	280 - 281.5	SS	1.0'	2-2-27	<u>POORLY GRADED SAND WITH SILT (SP)</u> , gray, wet, saturated, firm, dense, trace silt	
290.0					<u>CLAY (CL)</u> , dark gray, moist, firm, dense	

VIMM-CLUB Use WELLBORE 18"



PROJECT NUMBER 106241.E3.ZZ	BORING NUMBER MW-7C
Renumbered as MW-7 SHEET 4 OF 4	
<b>BOREHOLE/WELL CONSTRUCTION LOG</b>	

PROJECT VASHON ISLAND LANDFILL LOCATION N583.02, E2987.97  
 ELEVATION 371.09 DRILLING CONTRACTOR TACOMA PUMP & DRILLING INC.  
 DRILLING METHOD AND EQUIPMENT AIR ROTARY  
 WATER LEVELS N/A START 04/21/95 FINISH 04/28/95 LOGGER T.O'CONNOR


DEPTH BELOW SURFACE (FT)	SAMPLE			STANDARD PENETRATION TEST RESULTS	SOIL DESCRIPTION	WELL COMPLETION DIAGRAM
	INTERVAL	TYPE AND NUMBER	RECOVERY	6" -6" -6" (N)	SOIL NAME, USCS GROUP SYMBOL, COLOR, MOISTURE CONTENT, RELATIVE DENSITY OR CONSISTENCY, SOIL STRUCTURE, MINERALOGY	DEPTH OF CASING, DRILLING RATE, DRILLING FLUID LOSS TESTS AND INSTRUMENTATION
<div style="text-align: right; margin-bottom: 10px;"><del>300</del></div> <div style="text-align: right; margin-bottom: 10px;">310.0</div> <div style="text-align: right; margin-bottom: 10px;">320.0</div> <div style="text-align: right; margin-bottom: 10px;">340.0</div> <div style="text-align: right; margin-bottom: 10px;">350.0</div> <div style="text-align: right; margin-bottom: 10px;">380.0</div> <div style="text-align: right; margin-bottom: 10px;">370.0</div> <div style="text-align: right; margin-bottom: 10px;">380.0</div> <div style="text-align: right; margin-bottom: 10px;">390.0</div>	<div style="text-align: right; margin-bottom: 10px;"><del>300</del></div> <div style="text-align: right; margin-bottom: 10px;">320</div> <div style="text-align: right; margin-bottom: 10px;">340</div> <div style="text-align: right; margin-bottom: 10px;">350</div>	<div style="text-align: right; margin-bottom: 10px;">SS</div> <div style="text-align: right; margin-bottom: 10px;">SS</div> <div style="text-align: right; margin-bottom: 10px;">SS</div> <div style="text-align: right; margin-bottom: 10px;">SS</div>	<div style="text-align: right; margin-bottom: 10px;">1.0'</div> <div style="text-align: right; margin-bottom: 10px;">1.2'</div> <div style="text-align: right; margin-bottom: 10px;">1.0'</div> <div style="text-align: right; margin-bottom: 10px;">1.5'</div>	<div style="text-align: right; margin-bottom: 10px;">35-50-50/2"</div> <div style="text-align: right; margin-bottom: 10px;">15-35-50/4"</div> <div style="text-align: right; margin-bottom: 10px;">20-30-50/5"</div> <div style="text-align: right; margin-bottom: 10px;">35-75/5"</div>	<div style="text-align: center; margin-bottom: 10px;">TOTAL DEPTH = 351.5 FEET</div>	<div style="text-align: center; margin-bottom: 10px;">8" Diameter Borehole</div>

VMW-7C LUG  
 Use MELLBONE 18 plate



PROJECT NUMBER 106241E3.77	BORING NUMBER MW-7C	Renumbered as MW-7 SHEET 1 OF 4
WELL CONSTRUCTION SUMMARY		

PROJECT VASHON ISLAND LANDFILL LOCATION N583.02, E2987.97  
ELEVATION 371.09 DRILLING CONTRACTOR TACOMA PUMP & DRILLING INC.  
DRILLING METHOD AND EQUIPMENT AIR ROTARY  
WATER LEVELS N/A START 04/21/95 FINISH 04/28/95 LOGGER T.O'CONNOR

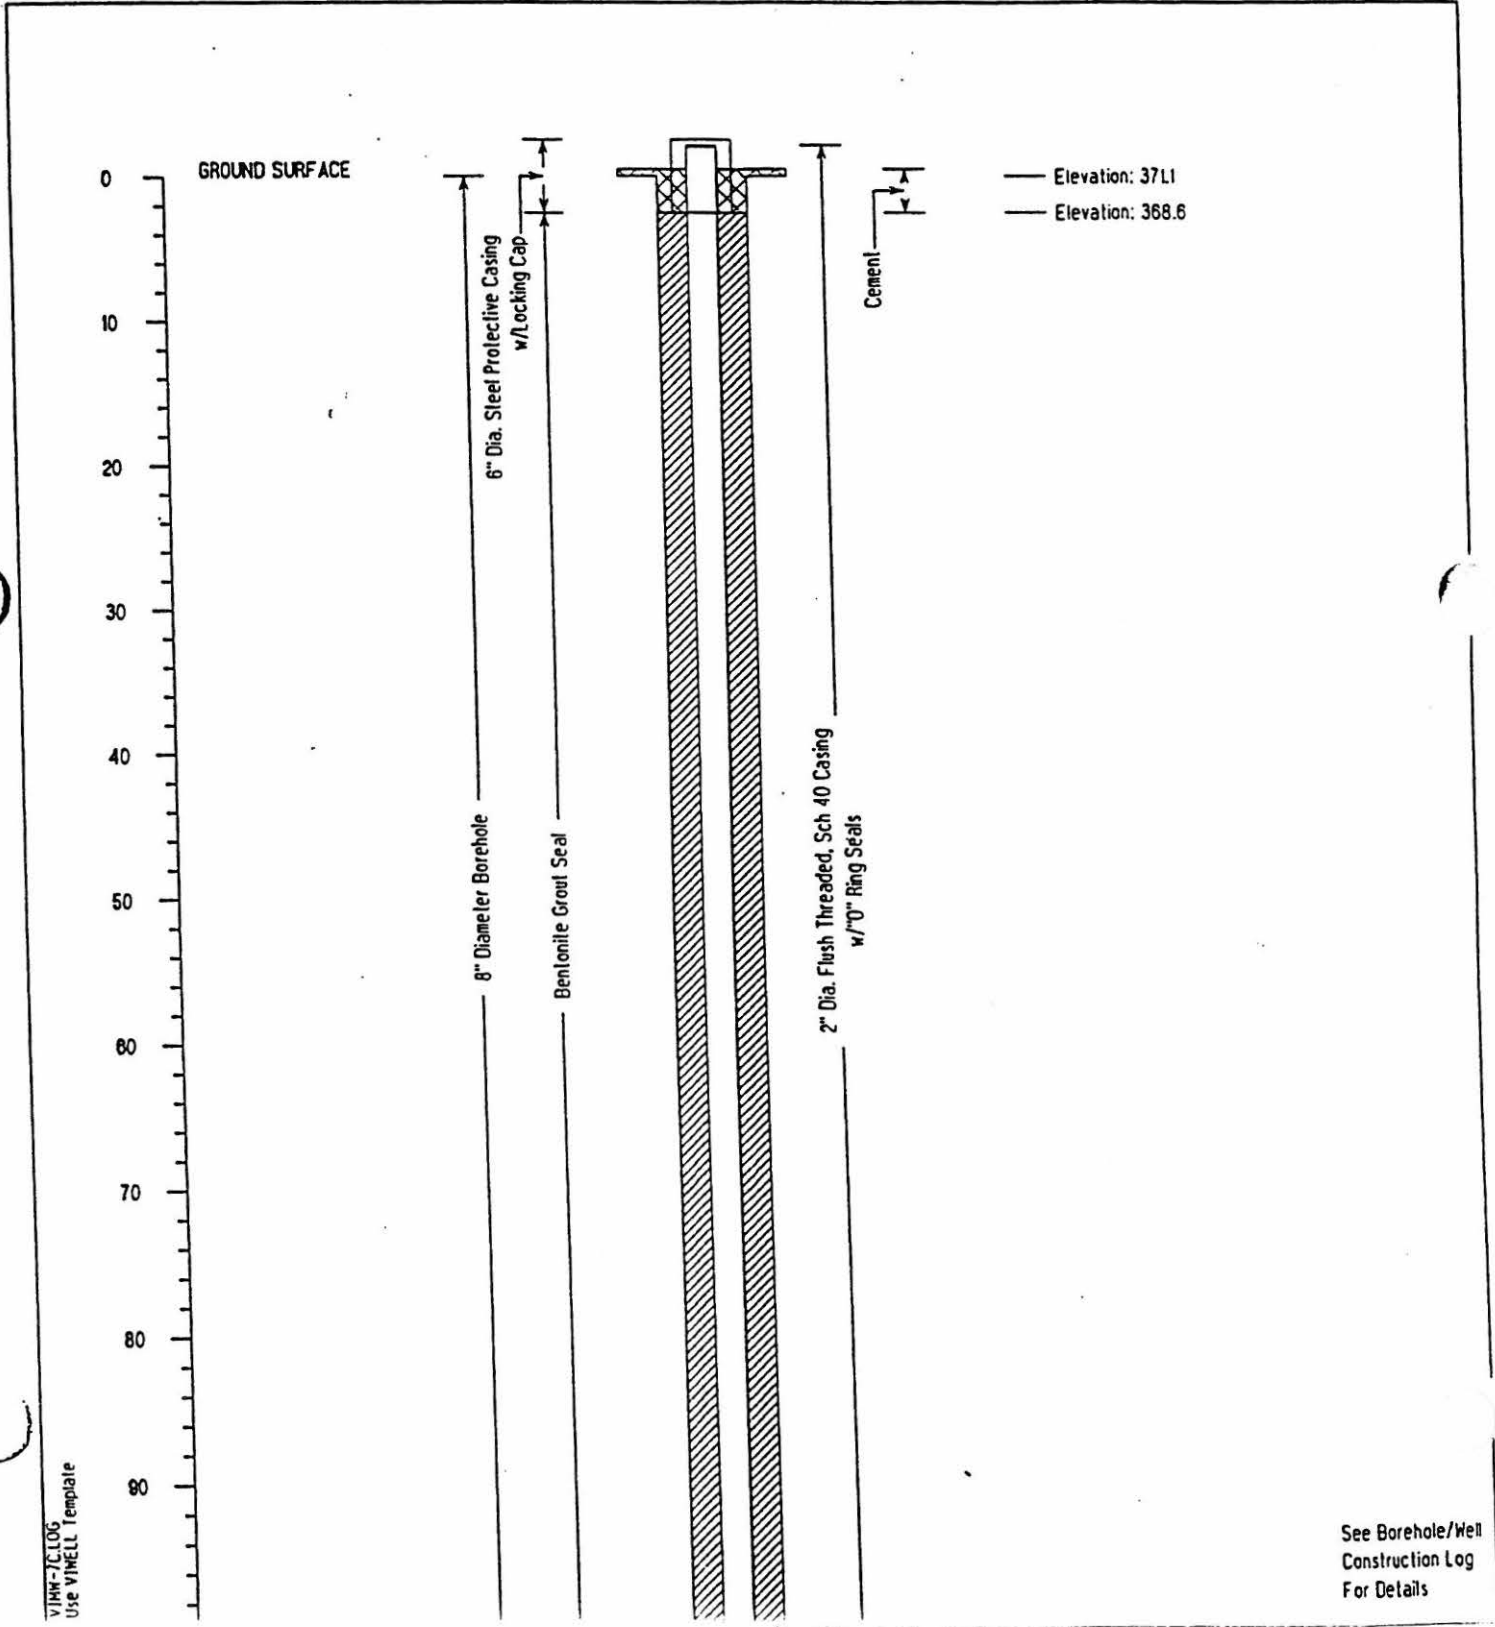




PROJECT NUMBER 106241.E3.77	BORING NUMBER MW-7C	Renumbered as MW-7 SHEET 2 OF 4
--------------------------------	------------------------	------------------------------------

**WELL CONSTRUCTION SUMMARY**

PROJECT VASHON ISLAND LANDFILL LOCATION N583.02. E2987.97  
ELEVATION 371.09 DRILLING CONTRACTOR TACOMA PUMP & DRILLING INC.  
DRILLING METHOD AND EQUIPMENT AIR ROTARY  
WATER LEVELS N/A START 04/21/95 FINISH 04/28/95 LOGGER T.O'CONNOR

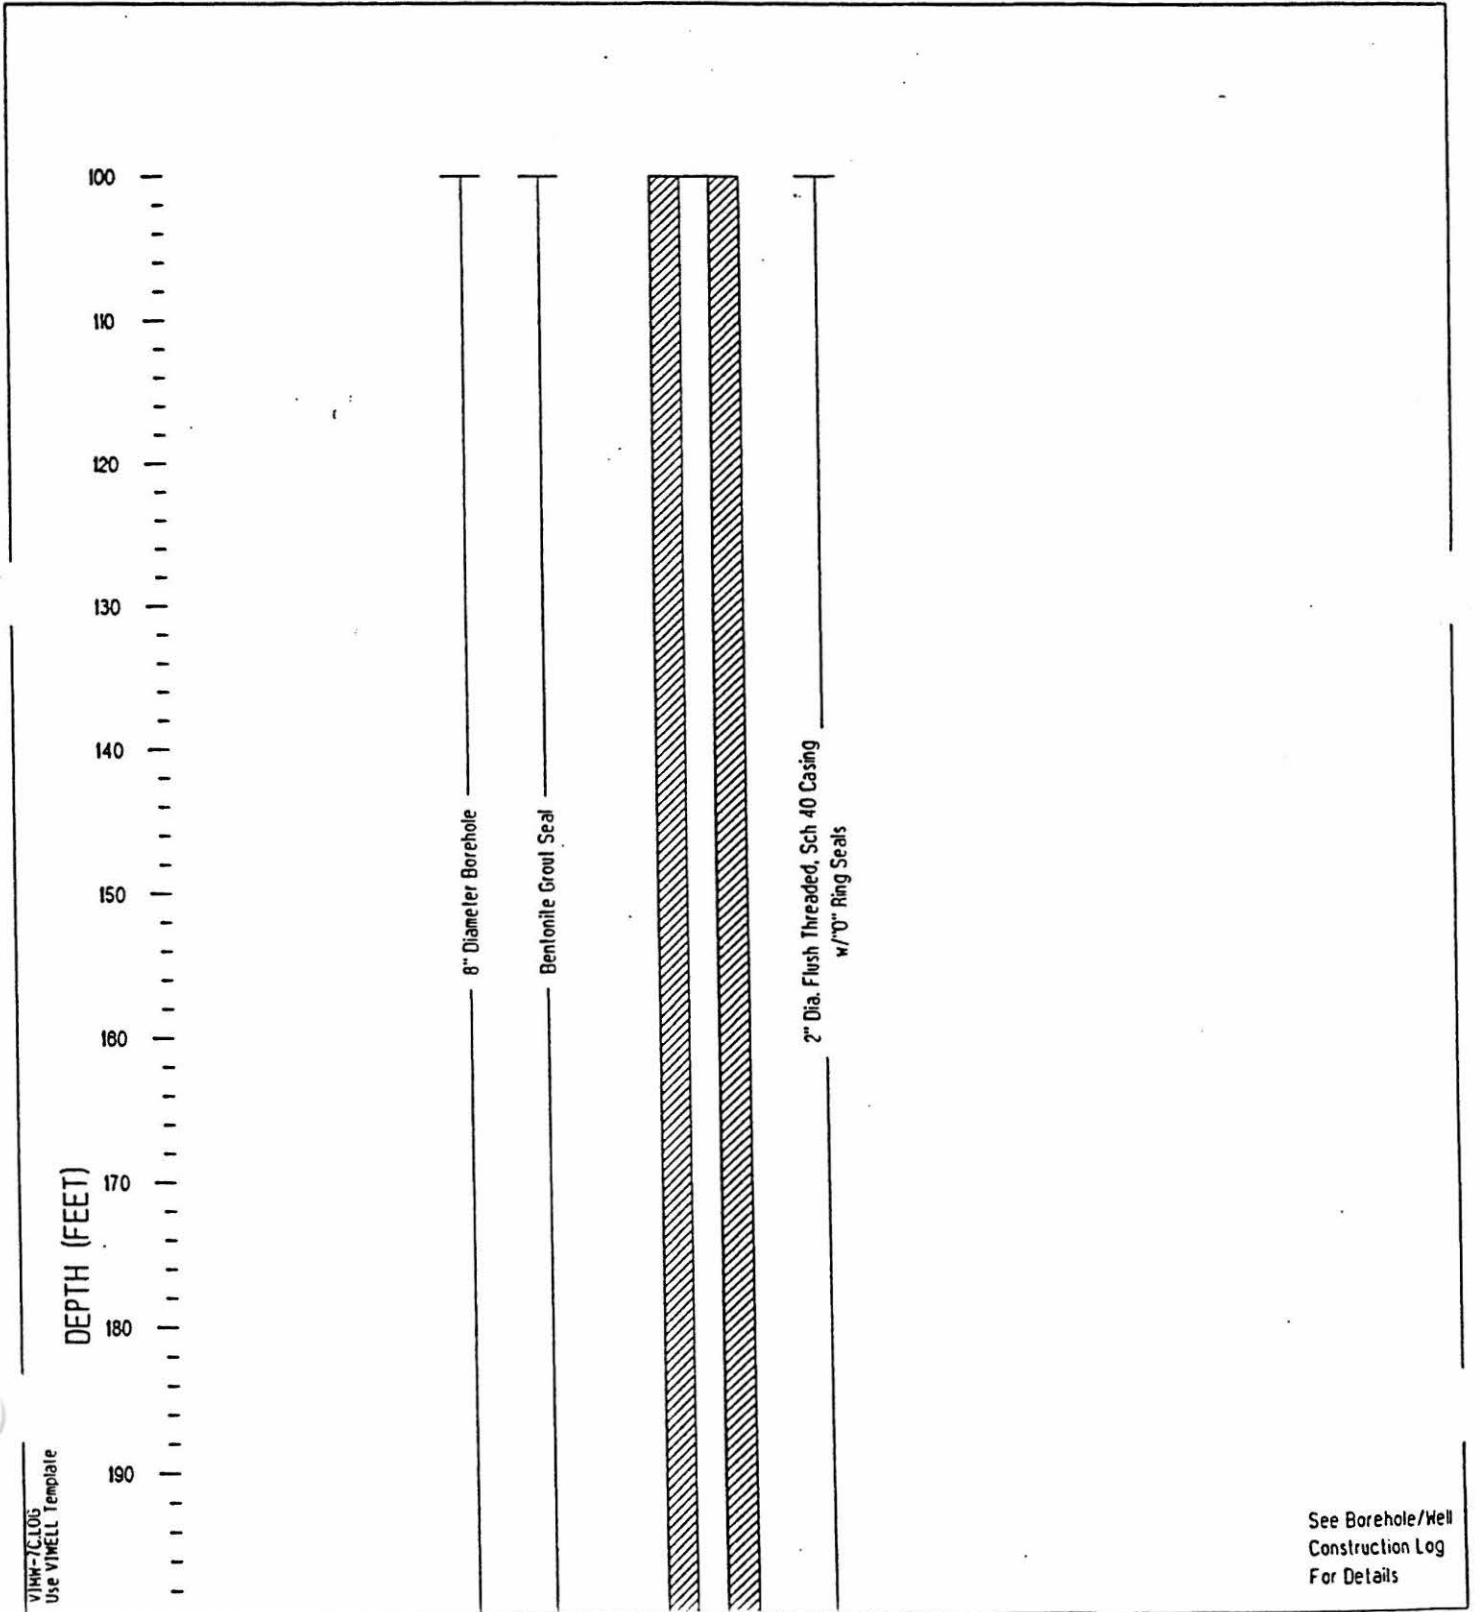





PROJECT NUMBER

106241E3.77

BORING NUMBER

MW-7C

Renumbered as MW-7

SHEET 3 OF 4

# WELL CONSTRUCTION SUMMARY

PROJECT VASHON ISLAND LANDFILL

LOCATION N583.02, E2987.97

ELEVATION 371.09

DRILLING CONTRACTOR TACOMA PUMP & DRILLING INC.


DRILLING METHOD AND EQUIPMENT AIR ROTARY

WATER LEVELS N/A

START 04/21/95

FINISH 04/28/95


LOGGER T.O'CONNOR

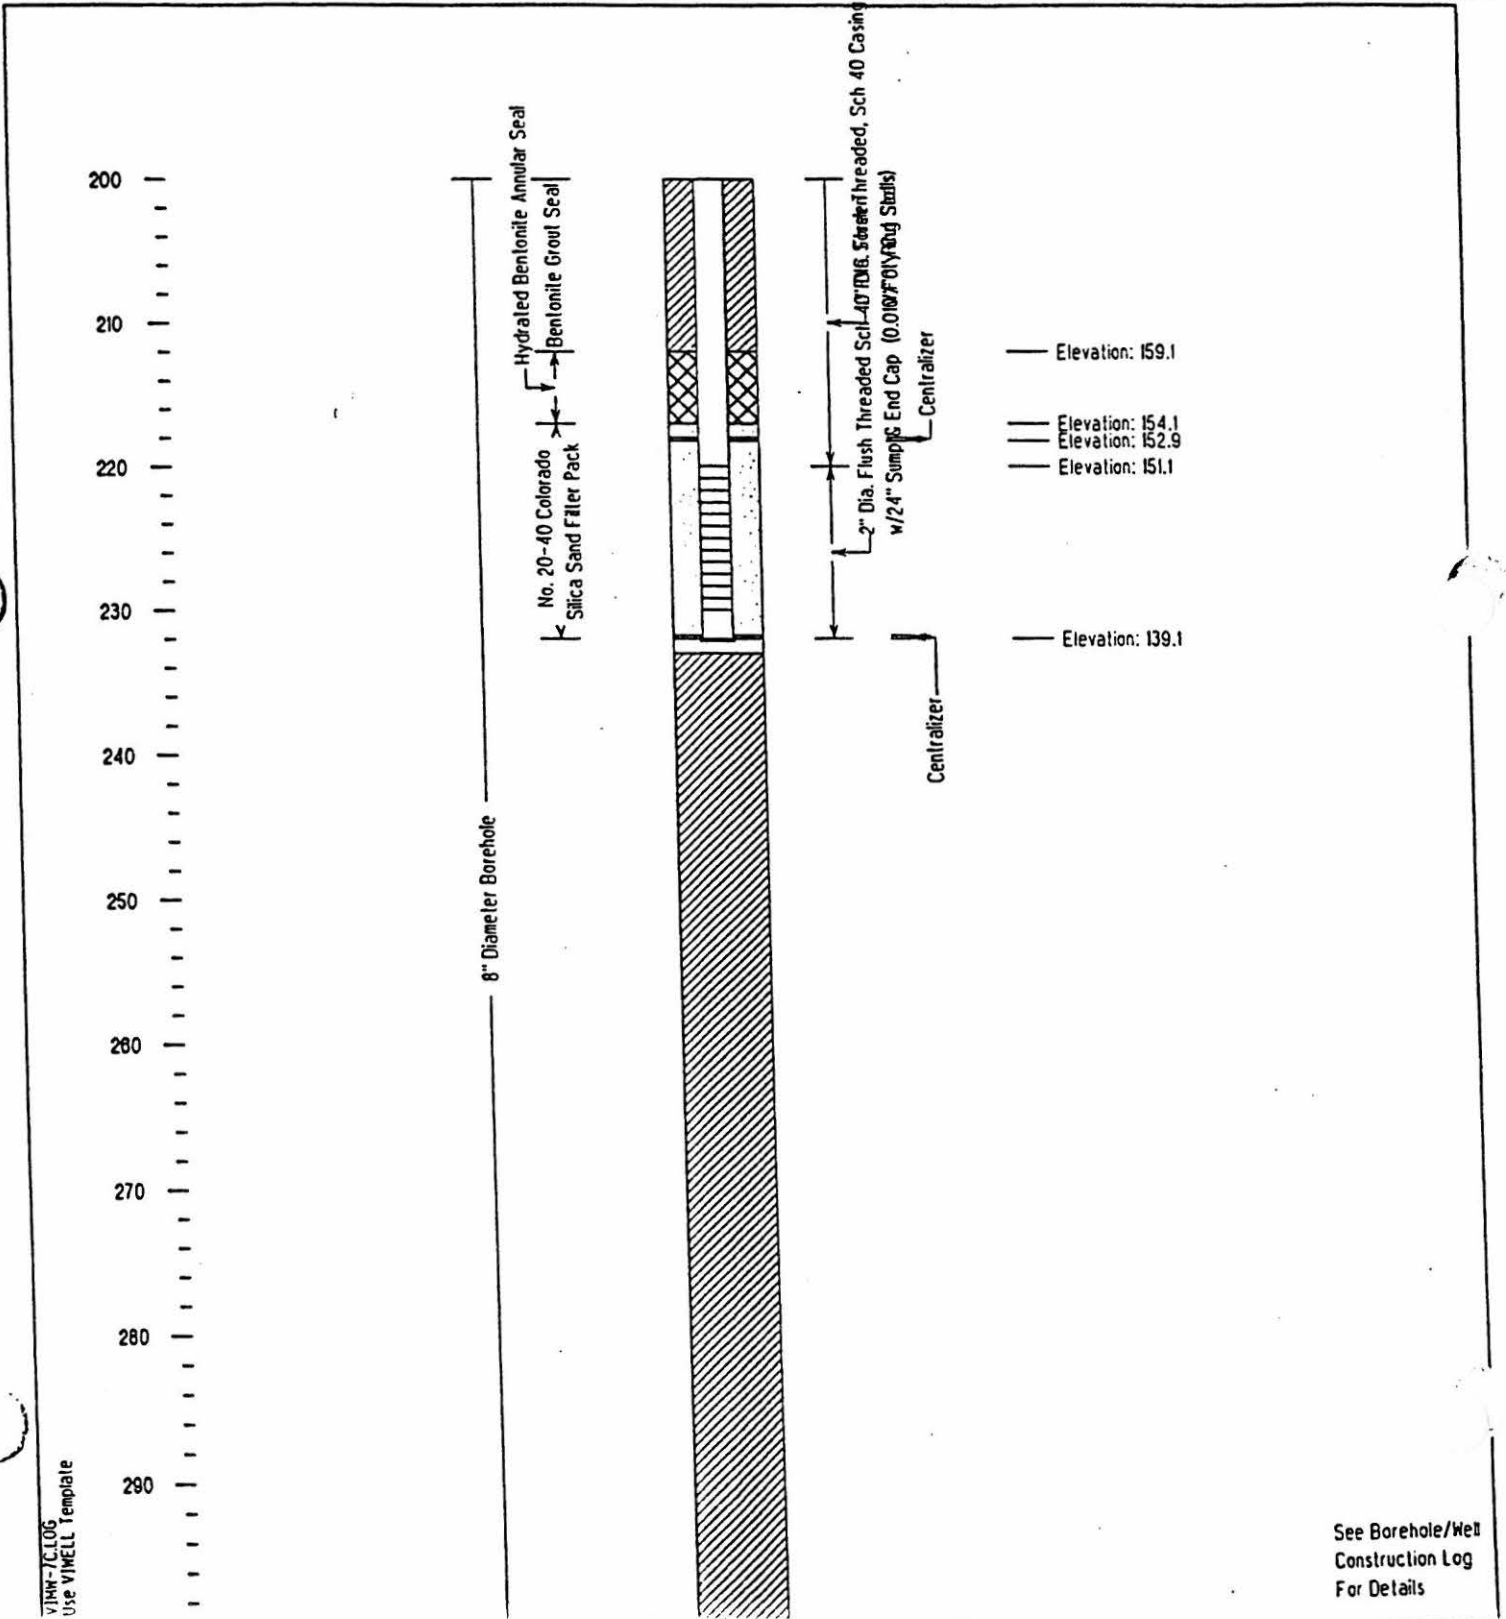



PROJECT NUMBER 106241.E3.7.7	BORING NUMBER MW-7C	Renumbered as MW-7 SHEET 4 OF 4
WELL CONSTRUCTIONSUMMARY		

PROJECT VASHON ISLAND LANDFILL LOCATION N583.02. E2987.97  
ELEVATION 371.09 DRILLING CONTRACTOR TACOMA PUMP & DRILLING INC.  
DRILLING METHOD AND EQUIPMENT AIR ROTARY  
WATER LEVELS N/A START 04/21/95 FINISH 04/28/95 LOGGER T.O'CONNOR

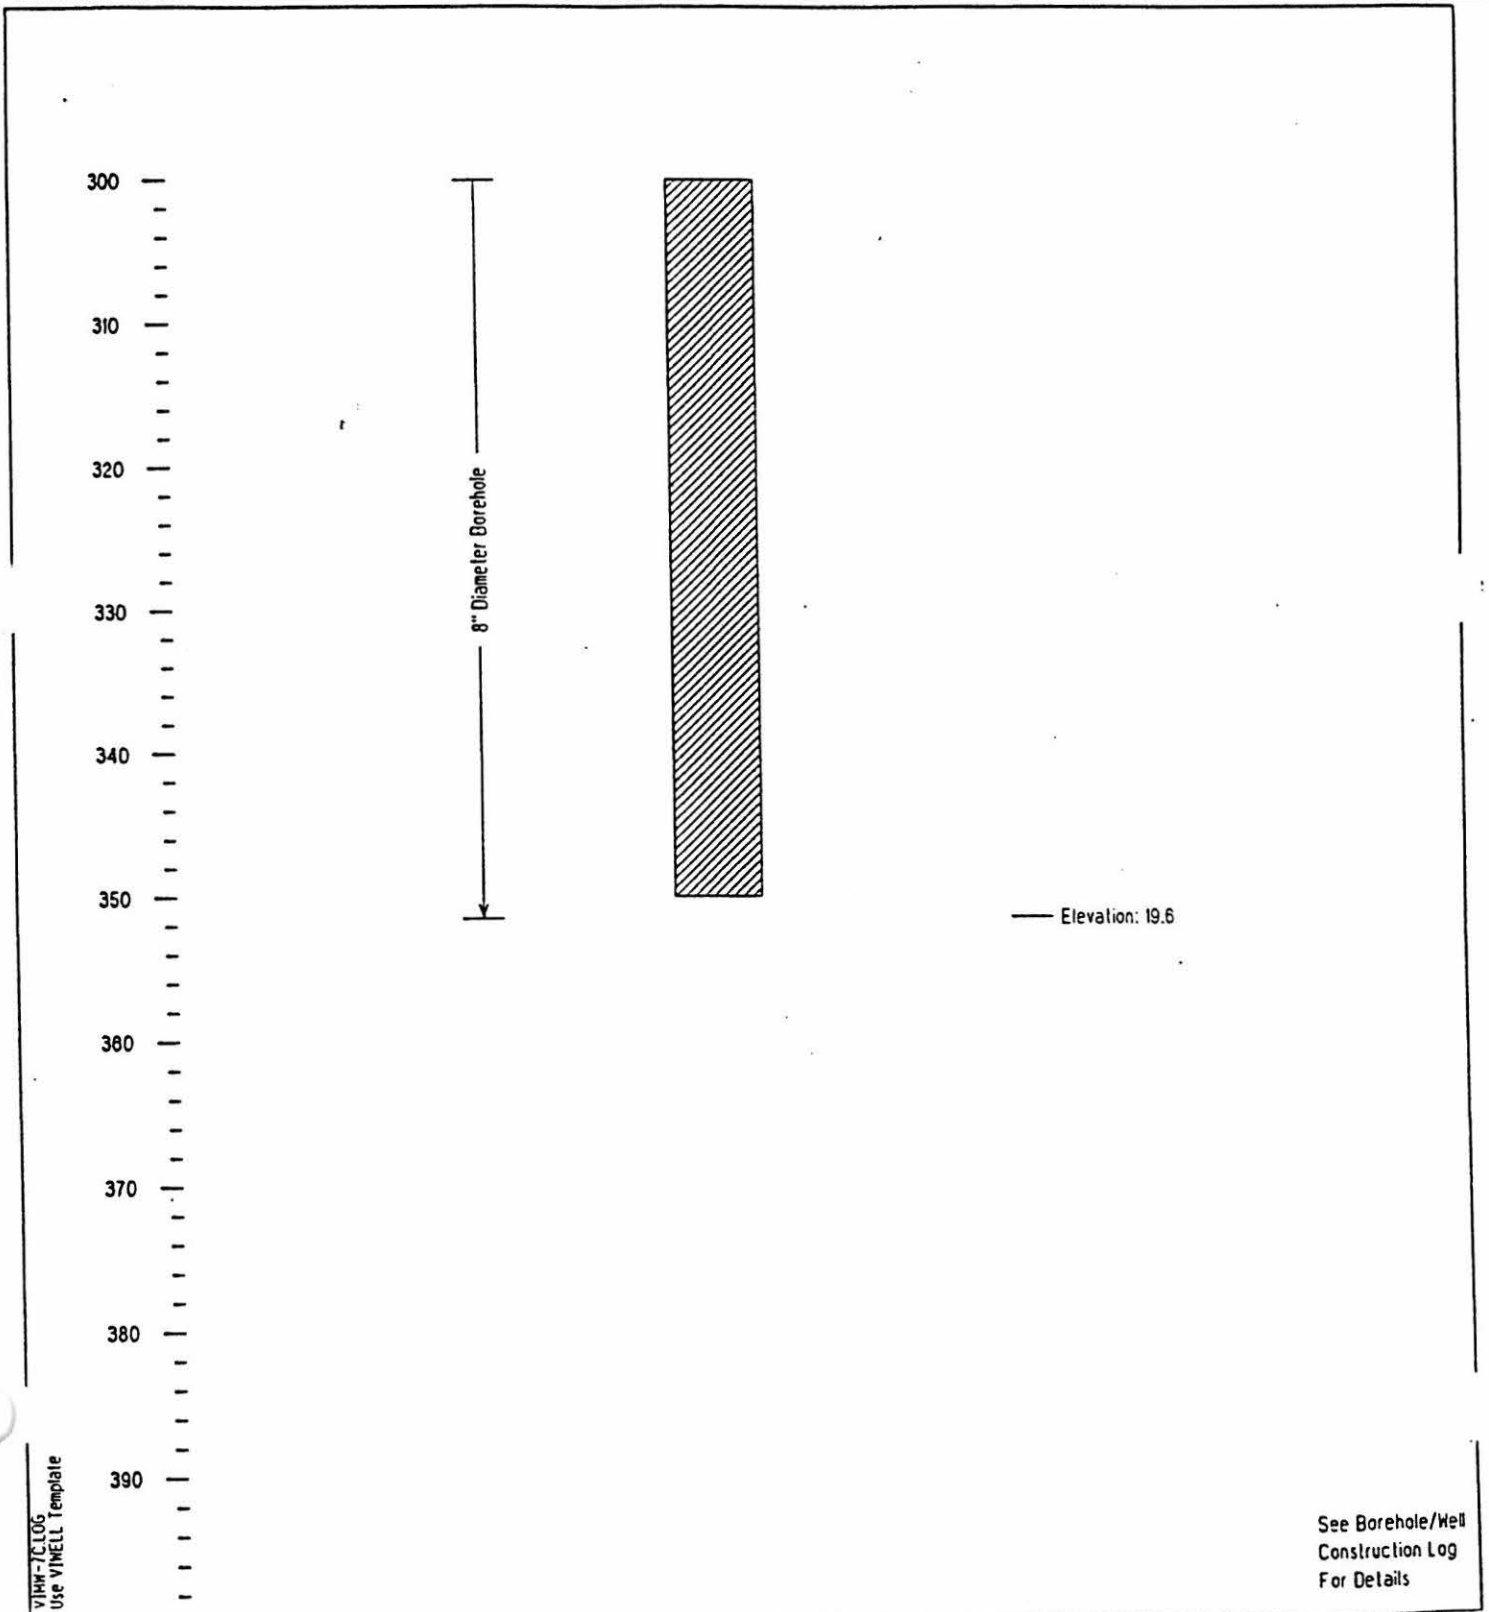

VHM-7C LOG  
Use VINELL Template



## BOREHOLE/WELL CONSTRUCTION LOG

PROJECT VASHON ISLAND LANDFILL LOCATION N972.30, E2217.04  
 ELEVATION 381.24 DRILLING CONTRACTOR TACOMA PUMP & DRILLING INC.  
 DRILLING METHOD AND EQUIPMENT AIR ROTARY  
 WATER LEVELS N/A START 06/28/95 FINISH 06/30/95 LOGGER T.O'CONNOR

DEPTH BELOW SURFACE (FT)	SAMPLE			STANDARD PENETRATION TEST RESULTS 6" - 6" - 6" (N)	SOIL DESCRIPTION SOIL NAME, USCS GROUP SYMBOL, COLOR, MOISTURE CONTENT, RELATIVE DENSITY OR CONSISTENCY, SOIL STRUCTURE, MINERALOGY	WELL COMPLETION DIAGRAM
	INTERVAL	TYPE AND NUMBER	RECOVERY			
10.0					<u>SILTY SAND (SM)</u> , brown-tan, moist, firm, trace gravel	<p>6" Dia. Steel Protective Casing w/Locking Cap</p> <p>8" Diameter Borehole</p> <p>Bentonite GROUT Seal</p> <p>2" Dia. Sch 40 Flush Threaded, PVC Well Casing w/0" Ring Seals</p> <p>Cement</p> <p>Centralizer</p>
20.0	20					
21.0	21	SS	1.0'	7-10-25		
30.0					<u>POORLY GRADED SAND WITH SILT (SP-SM)</u> , brown, moist, firm	
40.0	40				Trace gravel, up to 1" diameter	
41.0	41	SS	1.0'			
50.0						
60.0	60				OVA=20.2 CGI=20%	
61.0	61	SS	1.0'	12-15-35		
70.0						
80.0	80				<u>SILT (ML)</u> , olive, moist, firm, trace iron oxide staining, brittle	
81.0	81	SS	.6'	20-25-30		
100.0					<u>SILTY SAND (SM)</u> , brown, moist, firm, fine grained sand	

VHM-88105  
Use WELLBORE Template



PROJECT NUMBER 106241.E3.ZZ	BORING NUMBER MW-8B
Renumbered as MW-8	
SHEET 2 OF 2	
<b>BOREHOLE/WELL CONSTRUCTION LOG</b>	

PROJECT VASHON ISLAND LANDFILL LOCATION N972.30, E2217.04  
 ELEVATION 381.24 DRILLING CONTRACTOR TACOMA PUMP & DRILLING INC.  
 DRILLING METHOD AND EQUIPMENT AIR ROTARY  
 WATER LEVELS N/A START 06/28/95 FINISH 06/30/95 LOGGER T.O'CONNOR


DEPTH BELOW SURFACE (FT)	SAMPLE			STANDARD PENETRATION TEST RESULTS 6'-6"-6" (N)	SOIL DESCRIPTION	WELL COMPLETION DIAGRAM
	INTERVAL	TYPE AND NUMBER	RECOVERY			
100.0 110.0 120.0 130.0 140.0 150.0 160.0 170.0 180.0	100 101	SS	1.0'	17-27-40	SILT (ML), olive, moist, firm	<p style="font-size: small;">8" Diameter Borehole Bentonite Grout Seal Hydrated Bentonite Annular Seal No. 20-40 Colorado Silica Sand Filter Pack 2" Dia. Sch 40 Flush Threaded, PVC Well Casing w/ 10" Ring Seals Centralizer Screen Slot Threaded Sch 4" Cap (0.010" Fact)</p>
	120 121	SS	1.0'	15-12"-35/6"	SANDY SILT (ML), dark gray, brown, moist, firm, iron oxide staining, stratified layering  SILT (ML), dark gray, moist-wet, firm, trace fine sand	
	140 141	SS	1.0'	3'-12"-10/6"	SILTY SAND (SM), dark gray, moist, firm	
	160 161	SS	1.0'	25-40-50/4"	WELL GRADED SAND (SM), brown-tan, moist, firm SANDY LEAN CLAY (CL), grayish brown, moist, firm, horizontal layers  SILTY SAND (SM), brown-gray, moist-wet, medium coarse sand	
	TOTAL DEPTH = 180 FEET					

VHM-88 LOG Use WELLBORE plate



PROJECT NUMBER 106241E3.7Z	BORING NUMBER MW-8B	Renumbered as MW-8
WELL CONSTRUCTION SUMMARY		


PROJECT VASHON ISLAND LANDFILL LOCATION N972.30, E2217.04  
ELEVATION 381.24 DRILLING CONTRACTOR TACOMA PUMP & DRILLING INC.  
DRILLING METHOD AND EQUIPMENT AIR ROTARY  
WATER LEVELS N/A START 06/28/95 FINISH 06/30/95 LOGGER T.O'CONNOR

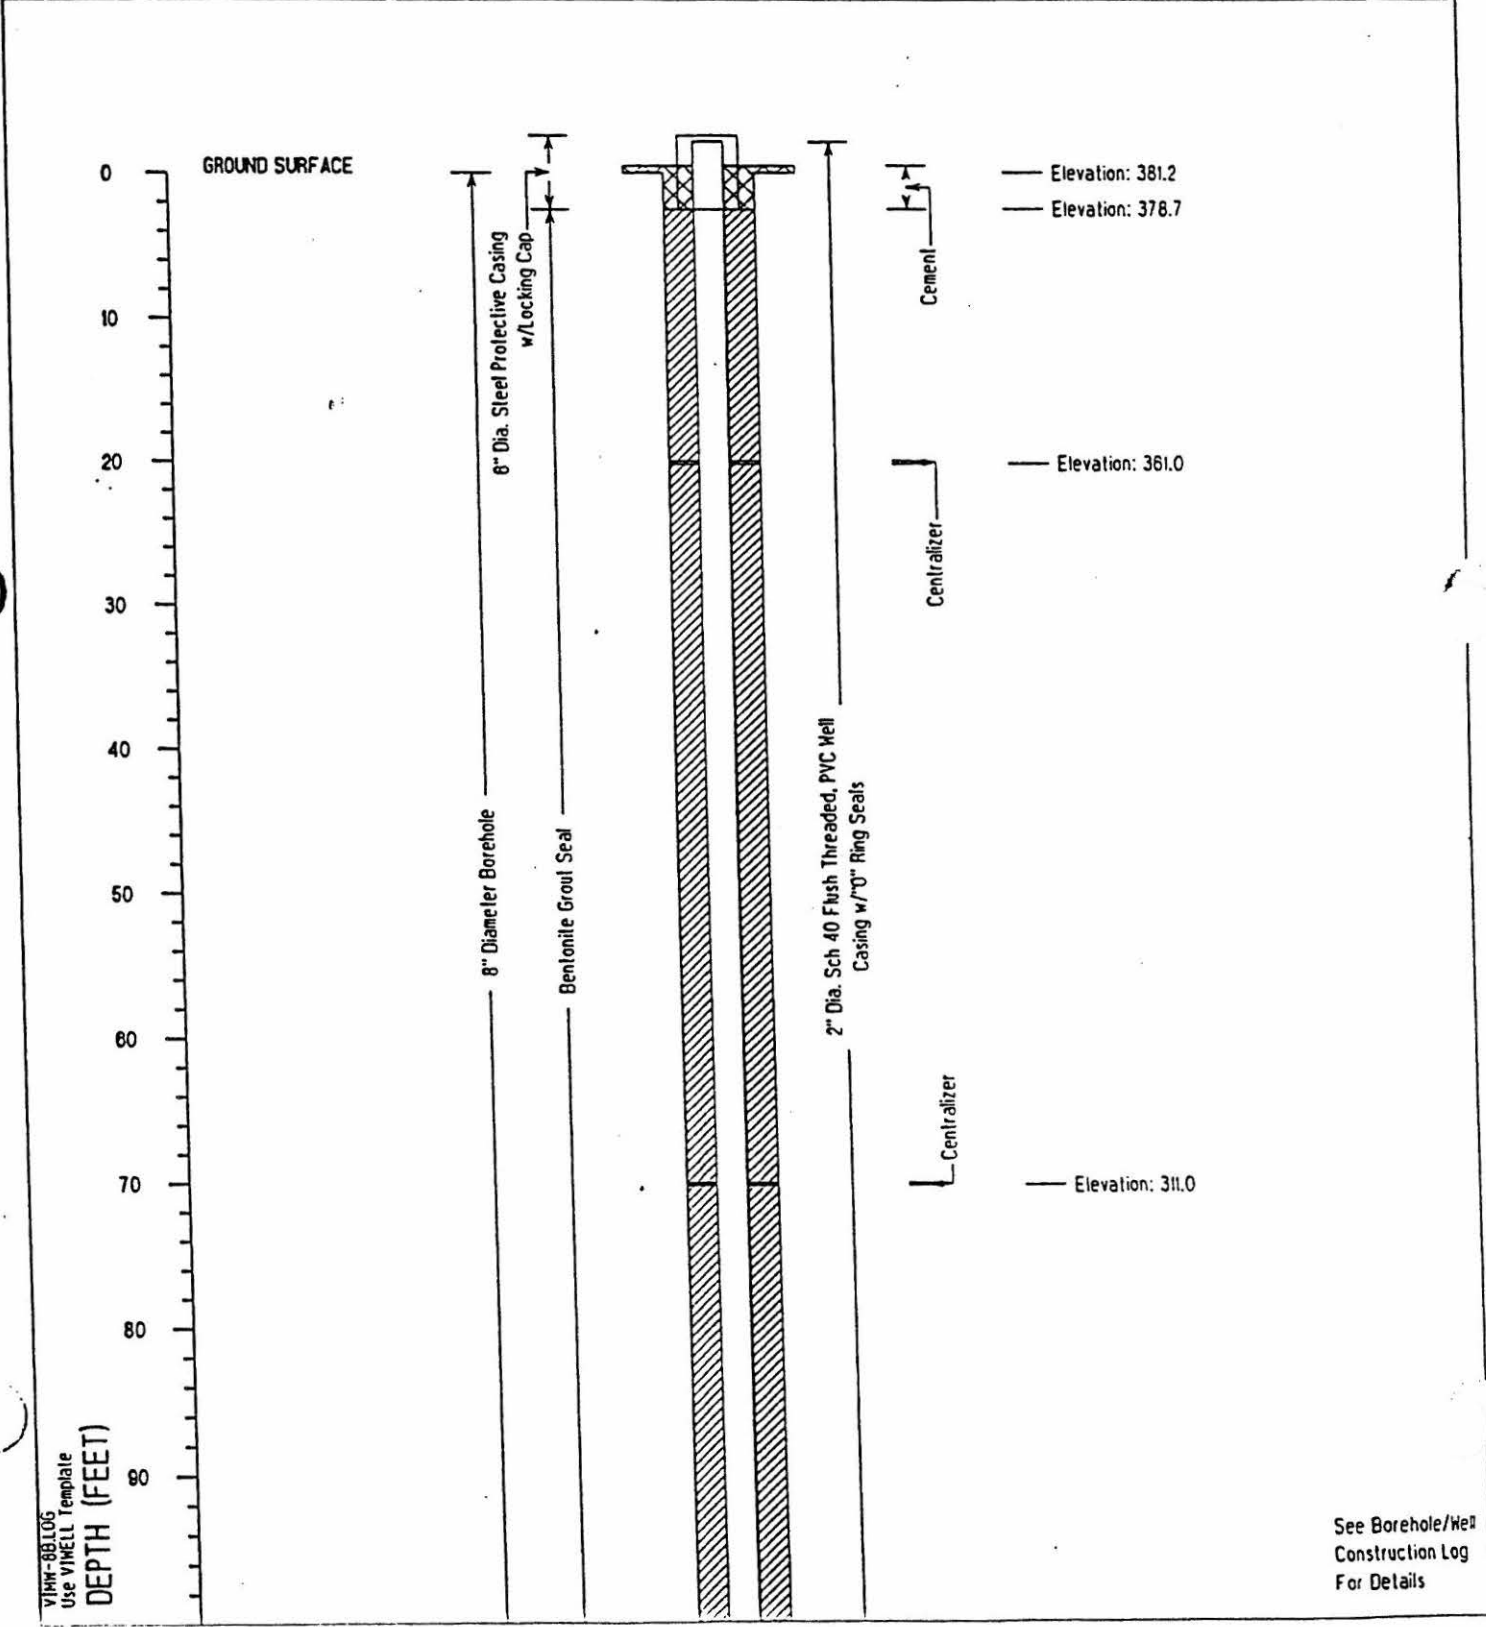



PROJECT NUMBER 106241.E3.77	BORING NUMBER MW-8B	Renumbered as MW-8 SHEET 2 OF 2
WELL CONSTRUCTION SUMMARY		

PROJECT VASHON ISLAND LANDFILL LOCATION N972.30, E2217.04  
ELEVATION 381.24 DRILLING CONTRACTOR TACOMA PUMP & DRILLING INC.  
DRILLING METHOD AND EQUIPMENT AIR ROTARY  
WATER LEVELS N/A START 06/28/95 FINISH 06/30/95 LOGGER T.O'CONNOR

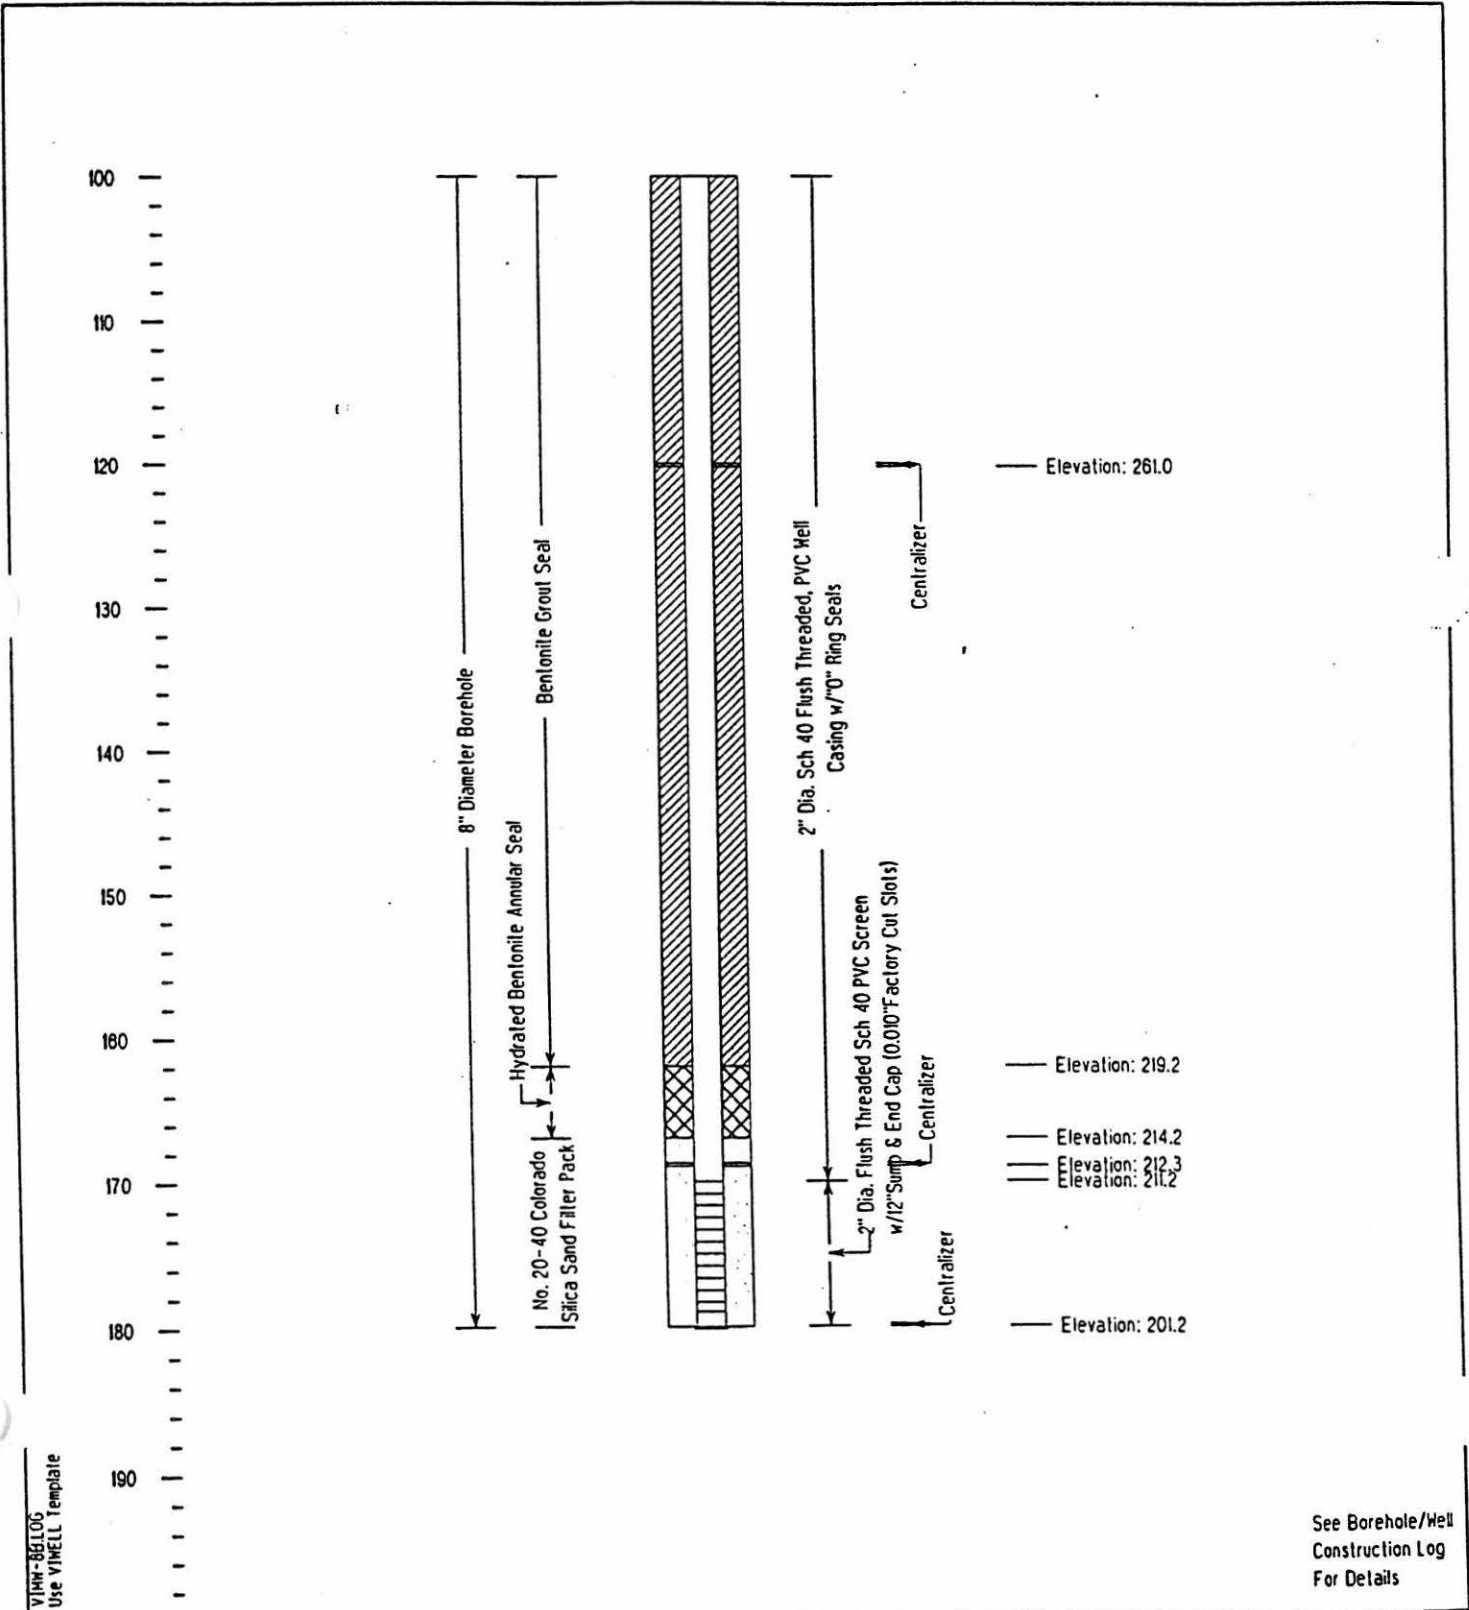

VINELL-861 LOG  
Use VINELL Template

See Borehole/Well  
Construction Log  
For Details



PROJECT NUMBER  
106241.E3.ZZ

BORING NUMBER Renumbered as MW-9  
MW-9B

SHEET 1 OF 2

BOREHOLE/WELL CONSTRUCTION LOG

PROJECT VASHON ISLAND LANDFILL

LOCATION N1291.50, E2269.88

ELEVATION 400.60

DRILLING CONTRACTOR TACOMA PUMP & DRILLING INC.

DRILLING METHOD AND EQUIPMENT AIR ROTARY

WATER LEVELS N/A

START 06/01/95

FINISH

LOGGER I.O'CONNOR

DEPTH BELOW SURFACE (FT)	SAMPLE			STANDARD PENETRATION TEST RESULTS 6" - 6" - 6" (N)	SOIL DESCRIPTION SOIL NAME, USCS GROUP SYMBOL, COLOR, MOISTURE CONTENT, RELATIVE DENSITY OR CONSISTENCY, SOIL STRUCTURE, MINERALOGY	WELL COMPLETION DIAGRAM
	INTERVAL	TYPE AND NUMBER	RECOVERY			
10.0					SILTY SAND, (SM) brown, moist, firm, trace pea gravel	<p>8" Dia. Steel Protective Casing w/ Locking Cap</p> <p>8" Diameter Borehole</p> <p>Bentonite Grout Seal</p> <p>2" Dia. Flush-Threaded, Sch 40 PVC Casing w/ 1/2" Ring Seals</p> <p>Centralizer</p> <p>Cement</p>
20.0	20				Gravel up to 1" diameter	
	21	SS	6"	50/4"		
30.0					POORLY GRADED SAND, (SP) brown, moist, firm, trace silt, trace gravel, up to 1" in diameter	
40.0	40				SILTY SAND, (SM) brown, moist, firm, trace gravel; OVA=1000; CGI=0	
	41	SS	1.0	80/6" 100/1"		
50.0					POORLY GRADED SAND, (SP) gray to light brown, moist, firm	
60.0	60				WELL GRADED SAND, (SW) gray to light brown, moist, firm	
	61	SS	1.1	35-50/6-50/3"	POORLY GRADED SAND WITH SILT AND GRAVEL, (SP-SM) olive, moist, firm; OVA=20; CGI=0	
70.0						
80.0	80				POORLY GRADED SAND WITH SILT, (SP-SM), olive, moist, firm	
	81	SS	1.2	25-35-50/5"		
100.0						

V11W-9B LOG Use WELLBORE template



PROJECT NUMBER 106241.E3.ZZ	BORING NUMBER MW-98
Renumbered as MW-9	
SHEET 2 OF 2	
<b>BOREHOLE/WELL CONSTRUCTION LOG</b>	

PROJECT VASHON ISLAND LANDFILL LOCATION N1291.50, E2269.88  
 ELEVATION 400.60 DRILLING CONTRACTOR TACOMA PUMP & DRILLING INC.  
 DRILLING METHOD AND EQUIPMENT AIR ROTARY  
 WATER LEVELS N/A START 06/01/95 FINISH \_\_\_\_\_ LOGGER T.O'CONNOR

DEPTH BELOW SURFACE (FT)	SAMPLE			STANDARD PENETRATION TEST RESULTS 6" -6" -6" (N)	SOIL DESCRIPTION SOIL NAME, USCS GROUP SYMBOL, COLOR, MOISTURE CONTENT, RELATIVE DENSITY OR CONSISTENCY, SOIL STRUCTURE, MINERALOGY	WELL COMPLETION DIAGRAM DEPTH OF CASING, DRILLING RATE, DRILLING FLUID LOSS TESTS AND INSTRUMENTATION
	INTERVAL	TYPE AND NUMBER	RECOVERY			
100.0 110.0 120.0 130.0 140.0 150.0 160.0 170.0 180.0	100 101	SS	1.5	10-25-40	<p><u>SILT</u>, (ML) olive, moist, brittle Red iron oxide deposit .1" thick with wood/fine sand, no silt</p> <p><u>SILTY SAND</u>, (SM), olive, moist, firm</p>	<p style="text-align: center;">8" Diameter Borehole</p> <p style="text-align: center;">Bentonite Grout Seal</p> <p style="text-align: center;">Hydrated Bentonite Annular Seal</p> <p style="text-align: center;">No. 20-40 Colorado Silica Sand Filter Pack</p> <p style="text-align: center;">2" Dia. Flush-Threaded, Sch 40 PVC Casing w/1" O" Ring Seals</p> <p style="text-align: center;">Centralizer</p> <p style="text-align: center;">1/2" Thru Screen w/ 0.010" F. Cap</p>
	120 121	SS	1.5	3-3-10	<p><u>SILT</u>, (ML) grayish brown, moist, firm, plastic</p>	
	140 141	SS	1.0	7-25-40	<p>06/13/95, water level @ 143.0'</p>	
	160 161	SS	1.2	9-12-11	<p><u>POORLY GRADED SAND WITH GRAVEL</u>, (GP) gray, moist, firm, pea size gravel</p> <p>06/14/95, water level @ 163.20'</p> <p><u>POORLY GRADED GRAVEL</u>, moist, firm, size gravel</p> <p><u>GRAVEL</u>, (SW) gray, moist, pea sized to 1/2" diameter, subrounded, trace coarse sand</p>	
					TOTAL DEPTH = 180 FEET	

VJHW-98 LOG Use WELLBORE TEMPLATE





PROJECT NUMBER

106241E3.77

BORING NUMBER

MW-99

Renumbered as MW-9

SHEET 1 OF 2

# WELL CONSTRUCTION SUMMARY

PROJECT VASHON ISLAND LANDFILL

LOCATION N1291.50, E2269.88

ELEVATION 400.60

DRILLING CONTRACTOR TACOMA PUMP & DRILLING INC.


DRILLING METHOD AND EQUIPMENT AIR ROTARY

WATER LEVELS N/A

START 06/01/95

FINISH \_\_\_\_\_

LOGGER T.O'CONNOR

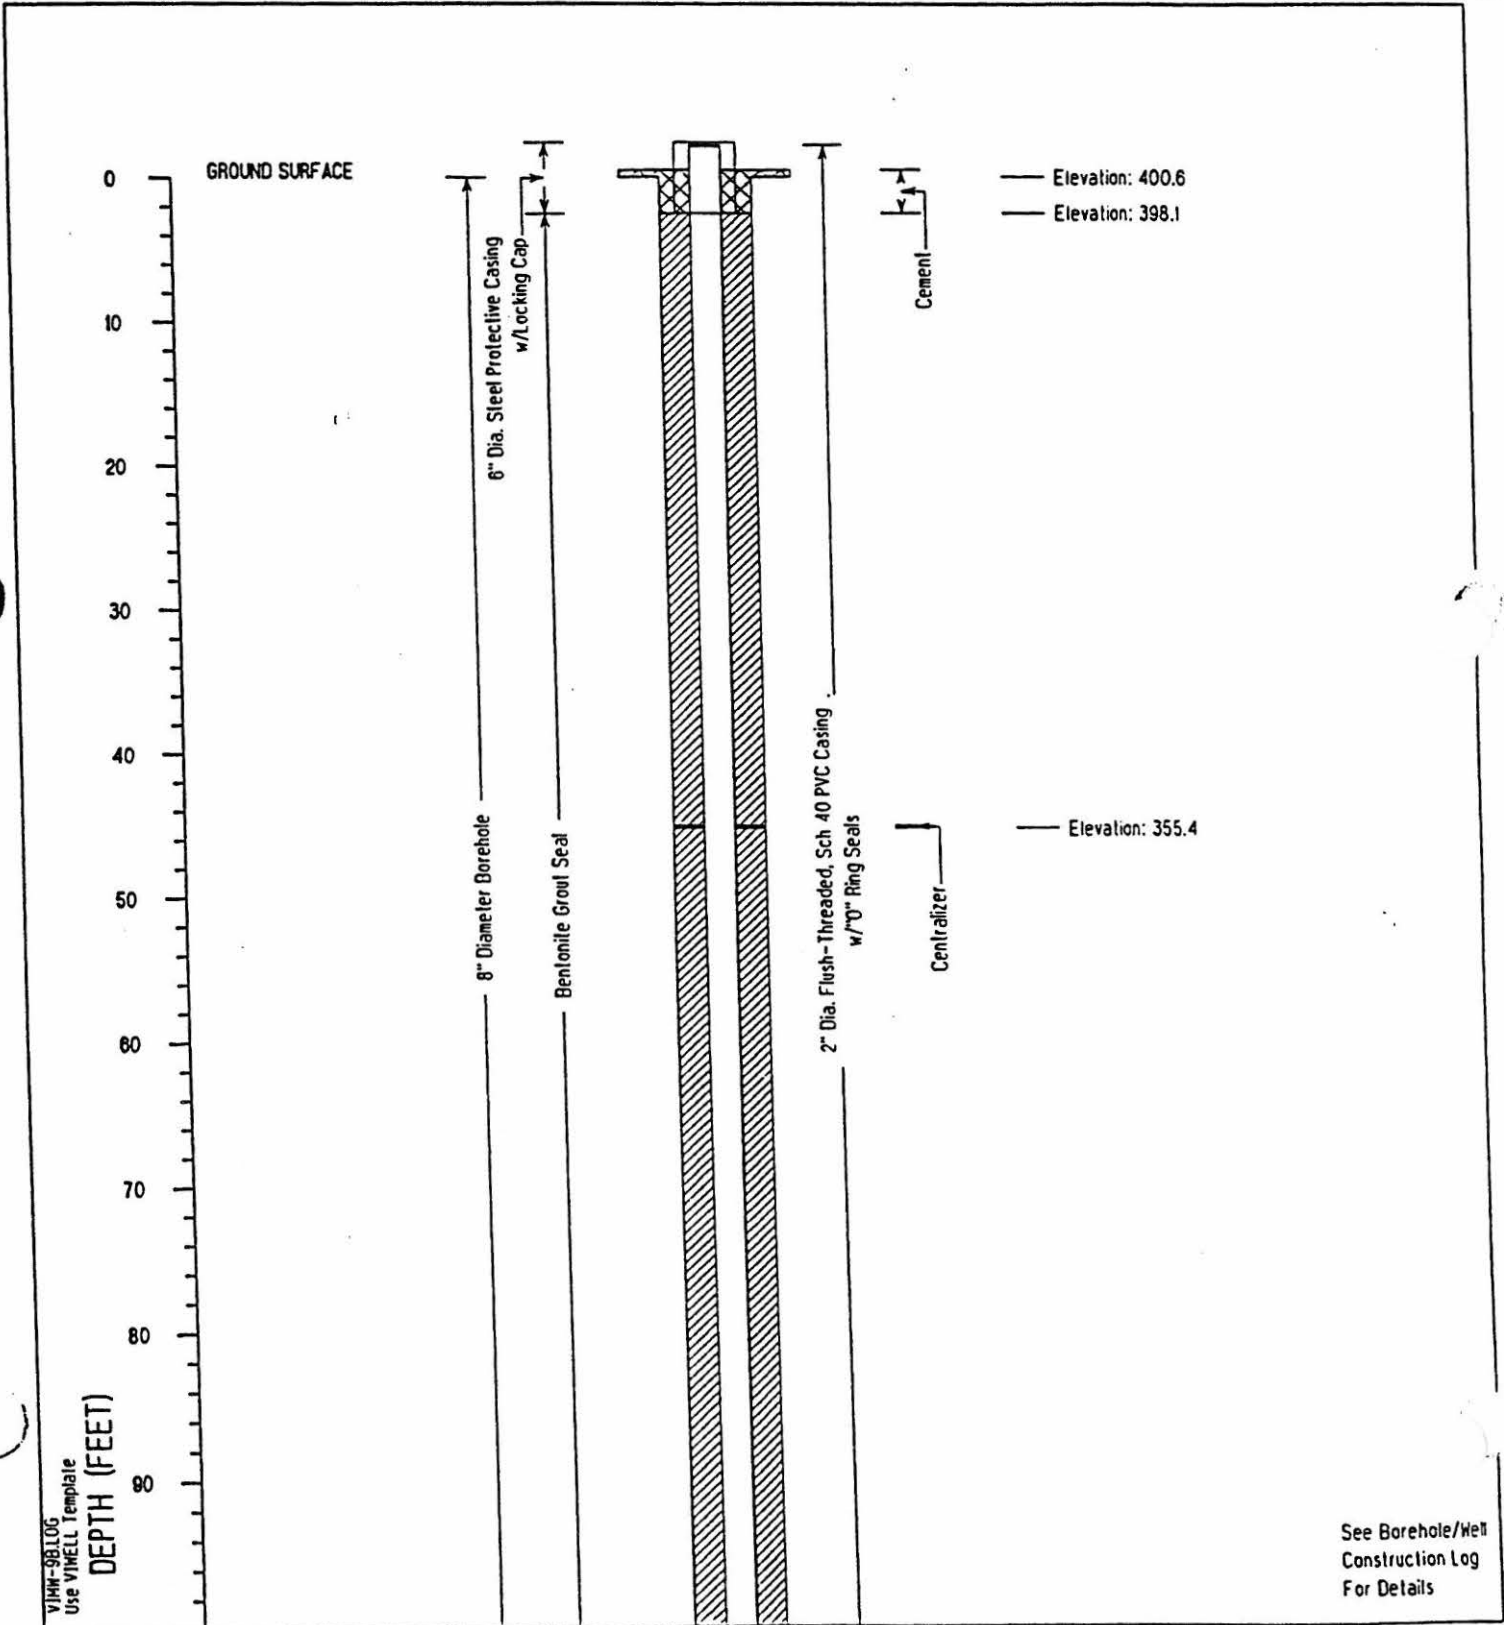



PROJECT NUMBER

105241E3.77

BORING NUMBER

MW-9B

Renumbered as MW-9

SHEET 2 OF 2

# WELL CONSTRUCTION SUMMARY

PROJECT VASHON ISLAND LANDFILL

LOCATION N1291.50, E2269.88

ELEVATION 400.60

DRILLING CONTRACTOR TACOMA PUMP & DRILLING INC.


DRILLING METHOD AND EQUIPMENT AIR ROTARY

WATER LEVELS N/A

START 06/01/95

FINISH \_\_\_\_\_

LOGGER T.O'CONNOR

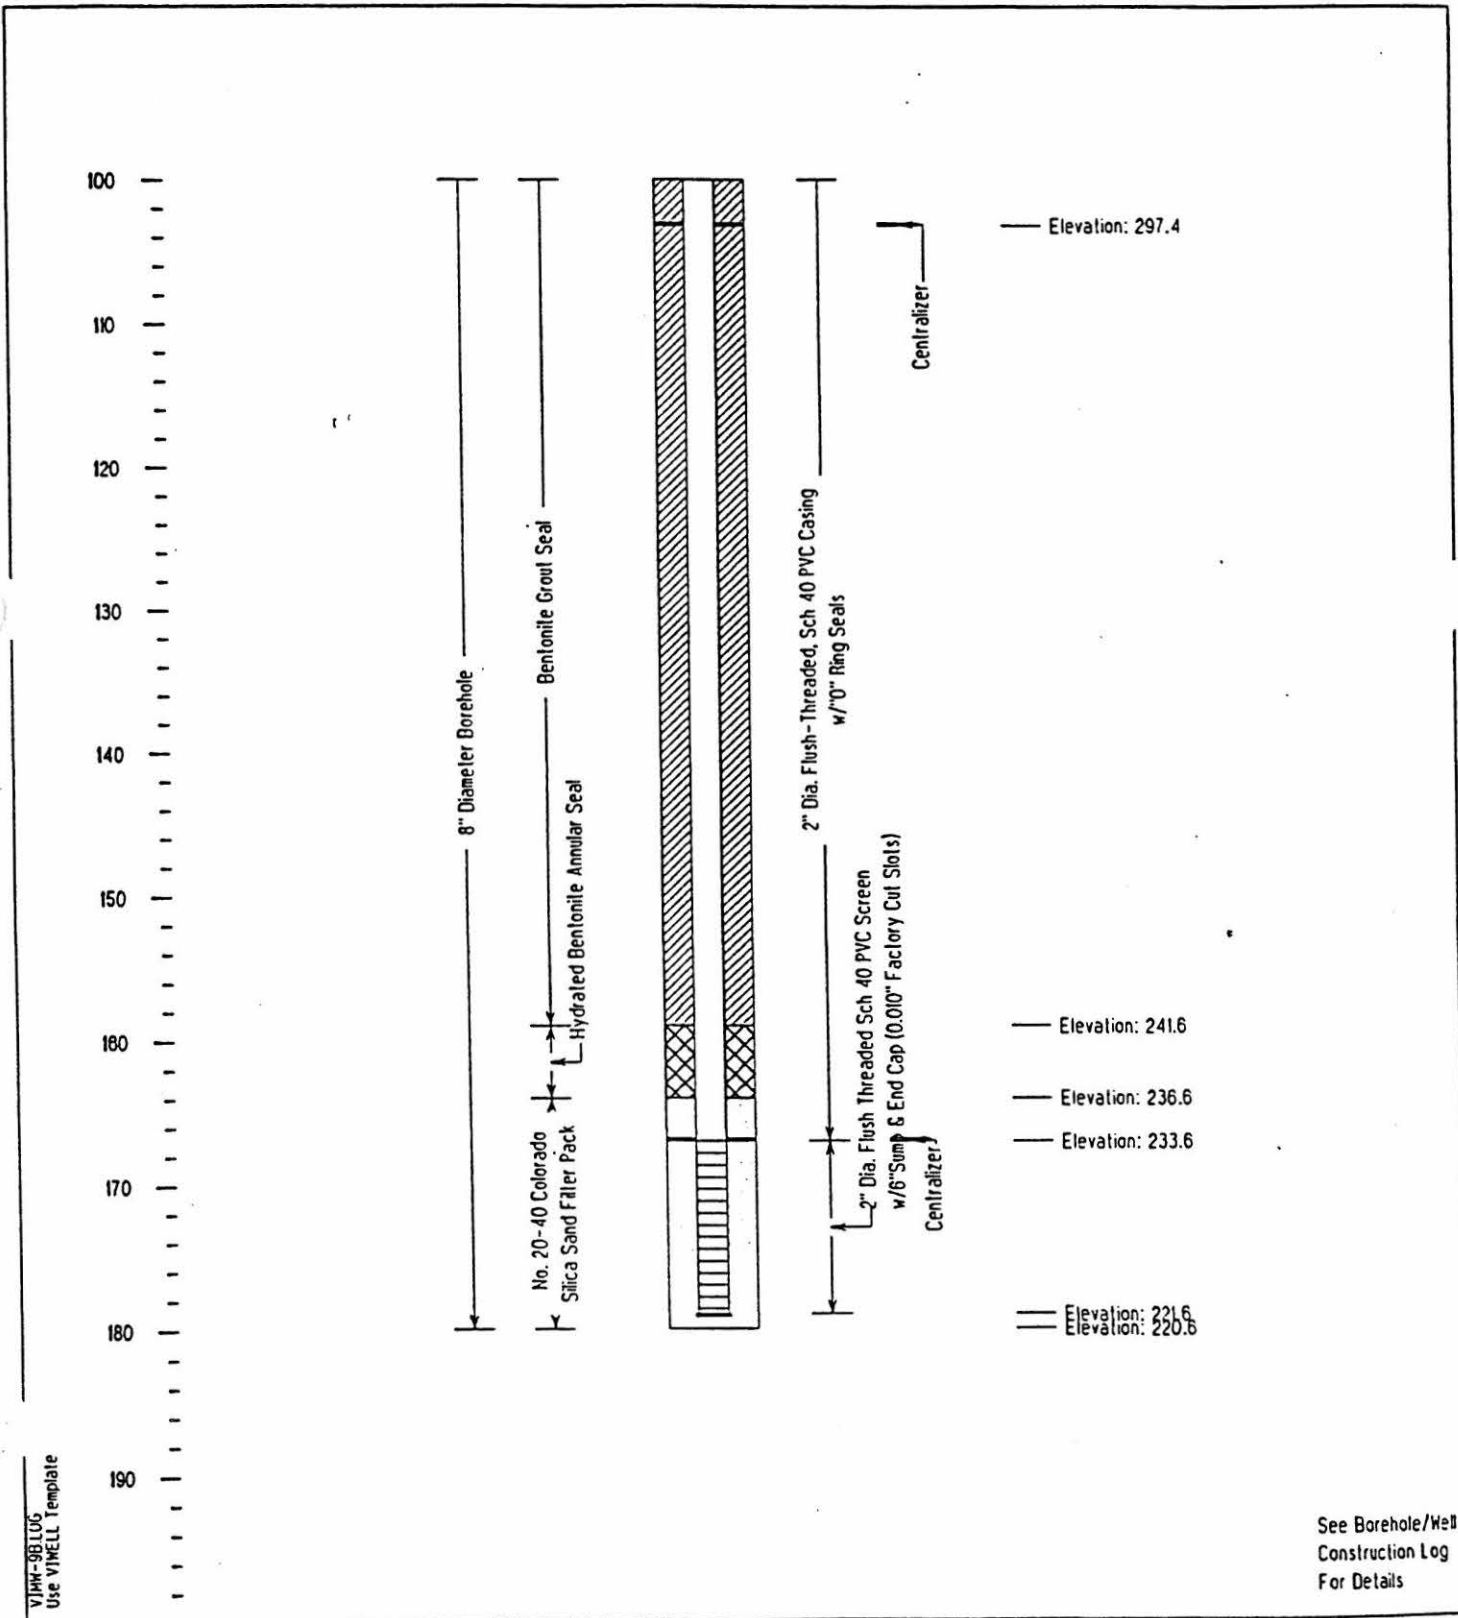

V10W-9B LOG Use WELLS Template

See Borehole/Well Construction Log For Details



PROJECT NUMBER 106241E3.77	BORING NUMBER MW-10B	Renumbered as MW-10
		SHEET 1 OF 2
<b>BOREHOLE/WELL CONSTRUCTION LOG</b>		

PROJECT VASHON ISLAND LANDFILL LOCATION N1597.18, E2406.73  
 ELEVATION 405.34 DRILLING CONTRACTOR TACOMA PUMP & DRILLING INC.  
 DRILLING METHOD AND EQUIPMENT AIR ROTARY  
 WATER LEVELS N/A START 06/26/95 FINISH 07/01/95 LOGGER T.O'CONNOR

DEPTH BELOW SURFACE (FT)	SAMPLE			STANDARD PENETRATION TEST RESULTS 6" - 6" - 6" (N)	SOIL DESCRIPTION SOIL NAME, USCS GROUP SYMBOL, COLOR, MOISTURE CONTENT, RELATIVE DENSITY OR CONSISTENCY, SOIL STRUCTURE, MINERALOGY	WELL COMPLETION DIAGRAM
	INTERVAL	TYPE AND NUMBER	RECOVERY			
10.0					<u>SILTY SAND (SM)</u> , brown, moist, firm, trace gravel up to 1 1/2" diameter	<p>8" Diameter Borehole</p> <p>6" Dia Steel Protective Casing w/Locking Cap</p> <p>Bentonite Grout Seal</p> <p>2" Dia. Flush Threaded Sch 40 PVC Casing w/1/2" Ring Seals</p> <p>Cement</p>
20.0	20					
	21	SS	1.0'	50/5"		
30.0					<u>SILTY SAND WITH GRAVEL (SM)</u> , brown, moist, firm, gravel up to 1" diameter	
40.0	40					
	41	SS	1'	35-50/4"		
50.0					<u>POORLY GRADED SAND WITH GRAVEL (SP)</u> , olive gray, moist, firm, gravel up to 1" diameter	
60.0	60					
	61	SS	1.0'	7/22/28		
70.0						
80.0	80					
	81	SS	1.0'	15/25/30	<u>POORLY GRADED SAND WITH SILT (SP)</u> , olive gray, moist, trace gravel up to 1" diameter	
90.0						
100.0	100					

VHM-DB LOG  
Use WELLBORE template



PROJECT NUMBER 106241.E3.ZZ	BORING NUMBER MW-10B	Renumbered as MW-10
		SHEET 2 OF 2
<b>BOREHOLE/WELL CONSTRUCTION LOG</b>		

PROJECT VASHON ISLAND LANDFILL LOCATION N1597.18, E2406.73  
 ELEVATION 405.34 DRILLING CONTRACTOR TACOMA PUMP & DRILLING INC.  
 DRILLING METHOD AND EQUIPMENT AIR ROTARY  
 WATER LEVELS N/A START 06/26/95 FINISH 07/01/95 LOGGER T.O'CONNOR


DEPTH BELOW SURFACE (FT)	SAMPLE			STANDARD PENETRATION TEST RESULTS 6" - 6" - 6" (N)	SOIL DESCRIPTION	WELL COMPLETION DIAGRAM
	INTERVAL	TYPE AND NUMBER	RECOVERY			
100.0 - 110.0	101	SS	1.1	50/20/35	<p>SILT (ML), brown-tan, moist, firm, trace iron oxide staining</p> <p>POORLY GRADED SAND WITH SILT (SP), olive gray, moist, firm</p> <p>SILT (ML), brown-gray, moist, firm, trace fine sand, slightly plastic</p>	
120.0	120					
120.0 - 130.0	121	SS	6"		SILTY SAND (SM), brown-gray, moist, firm	
140.0	140				SAND WITH GRAVEL (SW), brown-tan, moist, firm	
140.0 - 150.0	141	SS	1.5	6/12/20	POORLY GRADED SAND WITH SILT (SP-SM), brown-tan, moist, firm, medium to coarse grained	
160.0	160					
160.0 - 170.0	161	SS	1.0		<p>SILT (ML), dark gray, moist, hard, brittle</p> <p>TOTAL DEPTH = 161 FEET</p>	

VHM-DIBLUS  
Use WELLBORE



PROJECT NUMBER 106241E3.7.7	BORING NUMBER MW-10B	Renumbered as MW-10 SHEET 1 OF 3
WELL CONSTRUCTION SUMMARY		


PROJECT VASHON ISLAND LANDFILL LOCATION N1597.18, E2406.73  
ELEVATION 405.34 DRILLING CONTRACTOR TACOMA PUMP & DRILLING INC.  
DRILLING METHOD AND EQUIPMENT AIR ROTARY  
WATER LEVELS N/A START 06/26/95 FINISH 07/01/95 LOGGER T.O'CONNOR

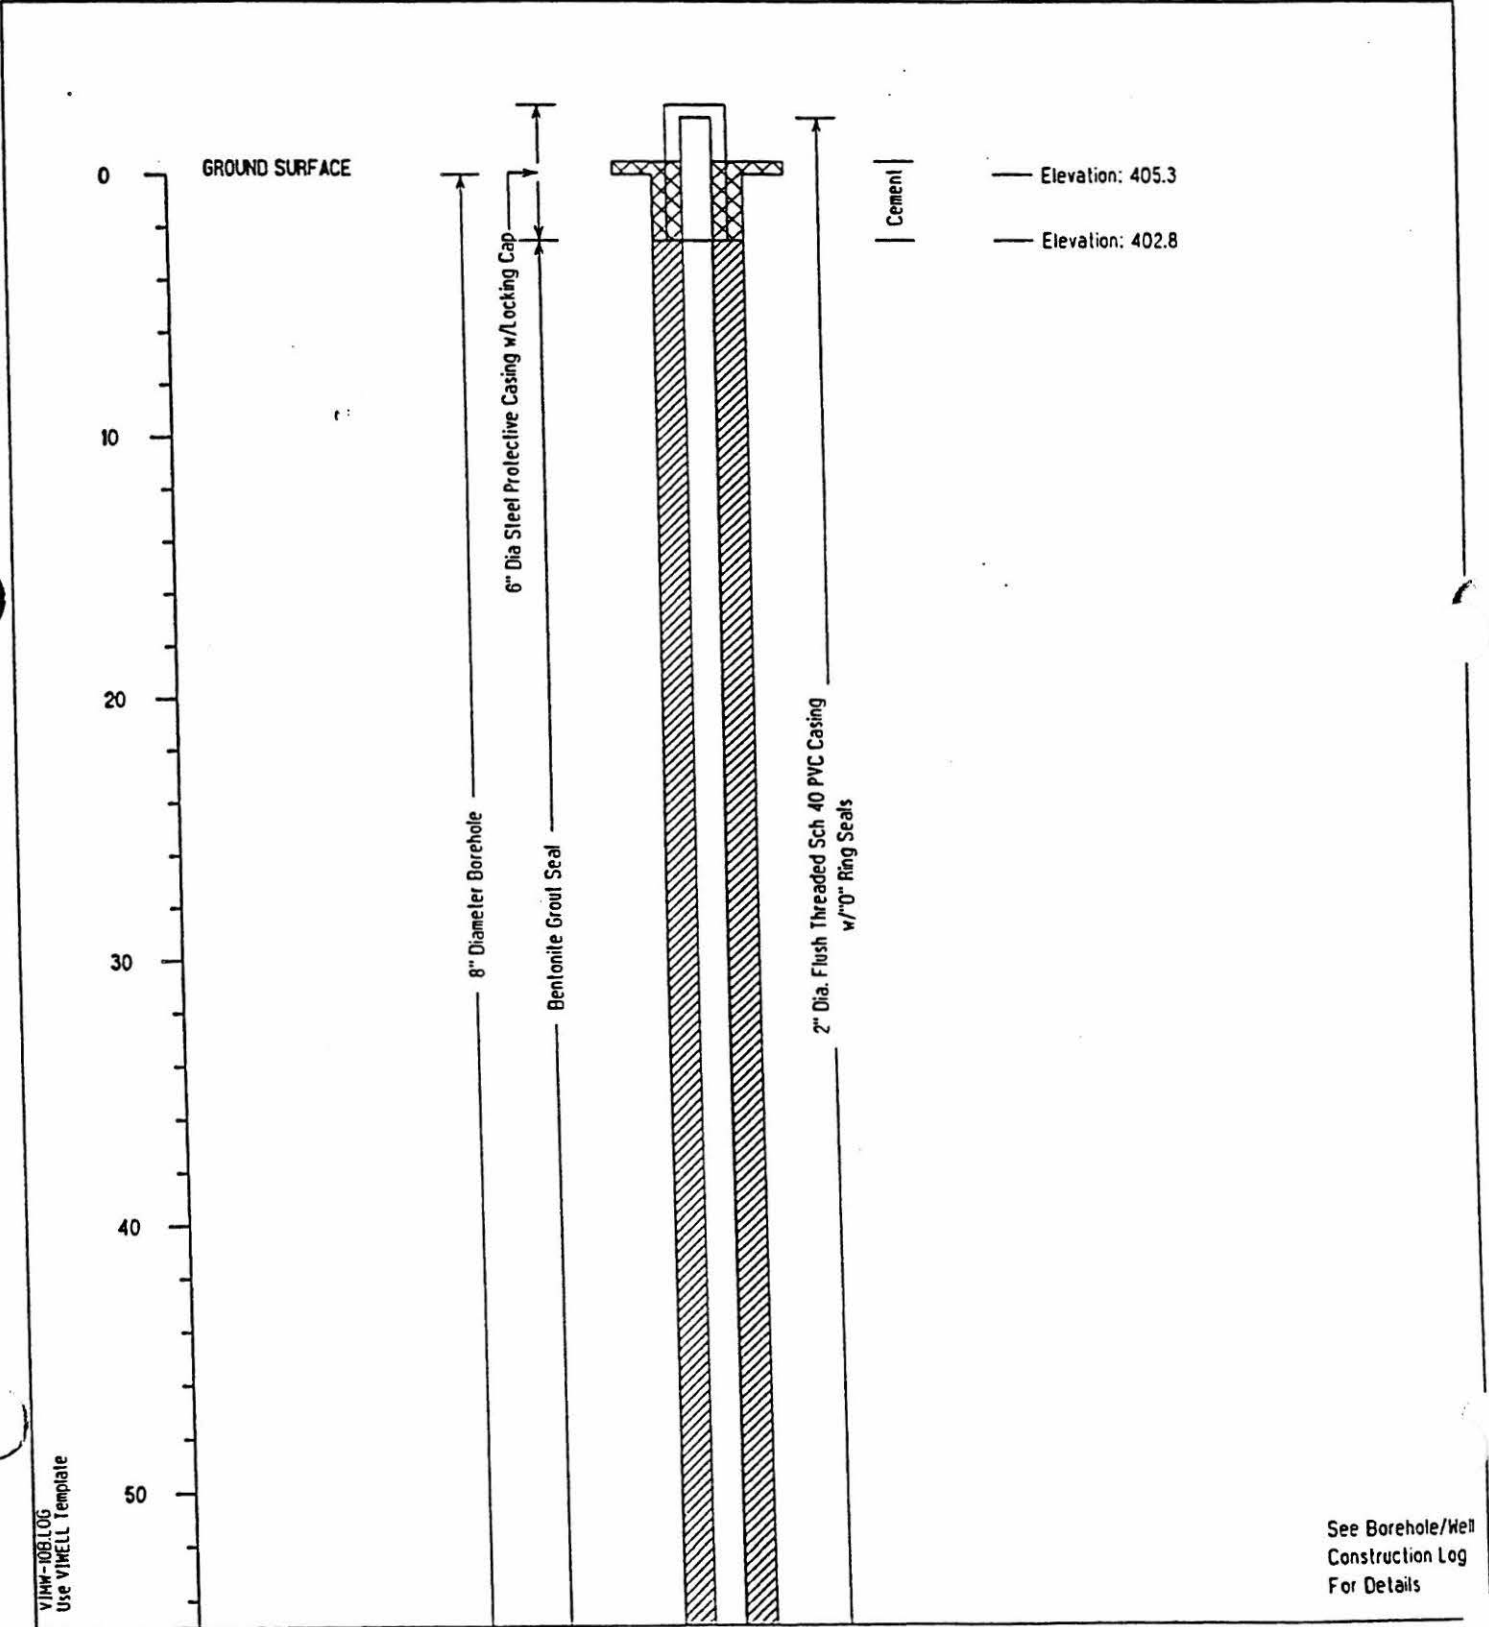



PROJECT NUMBER 106241E3.77	BORING NUMBER MW-10B	Renumbered as MW-10
SHEET 2 OF 3		
WELL CONSTRUCTION SUMMARY		


PROJECT VASHON ISLAND LANDFILL LOCATION N1597.18, E2406.73  
ELEVATION 405.34 DRILLING CONTRACTOR TACOMA PUMP & DRILLING INC.  
DRILLING METHOD AND EQUIPMENT AIR ROTARY  
WATER LEVELS N/A START 06/26/95 FINISH 07/01/95 LOGGER T.O'CONNOR

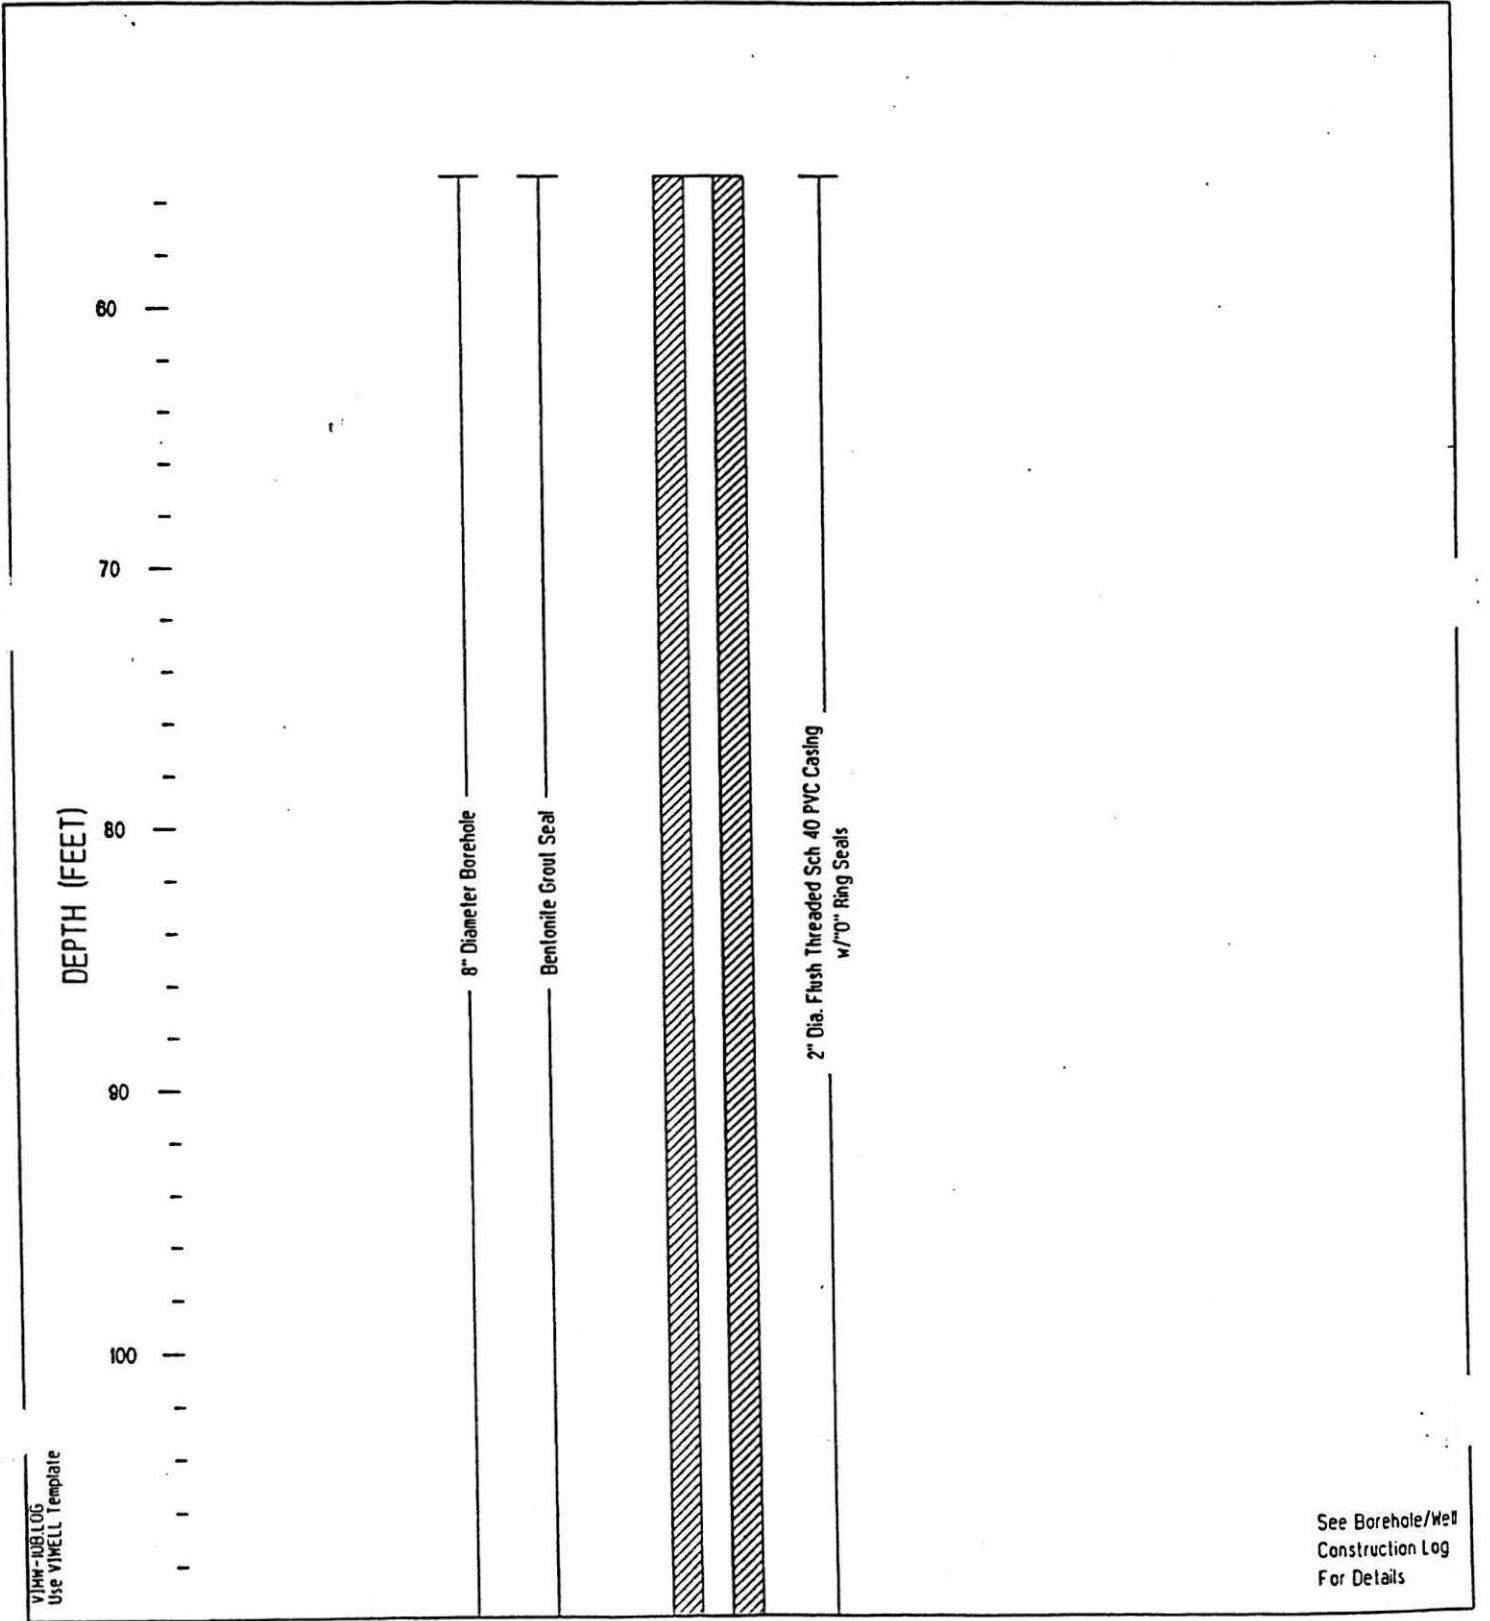



PROJECT NUMBER 105241.E3.77	BORING NUMBER MW-10B	Renumbered as MW-10
SHEET 3 OF 3		
WELL CONSTRUCTION SUMMARY		

PROJECT VASHON ISLAND LANDFILL LOCATION N1597.18, E2406.73  
ELEVATION 405.34 DRILLING CONTRACTOR TACOMA PUMP & DRILLING INC.  
DRILLING METHOD AND EQUIPMENT AIR ROTARY  
WATER LEVELS N/A START 06/26/95 FINISH 07/01/95 LOGGER T.O'CONNOR

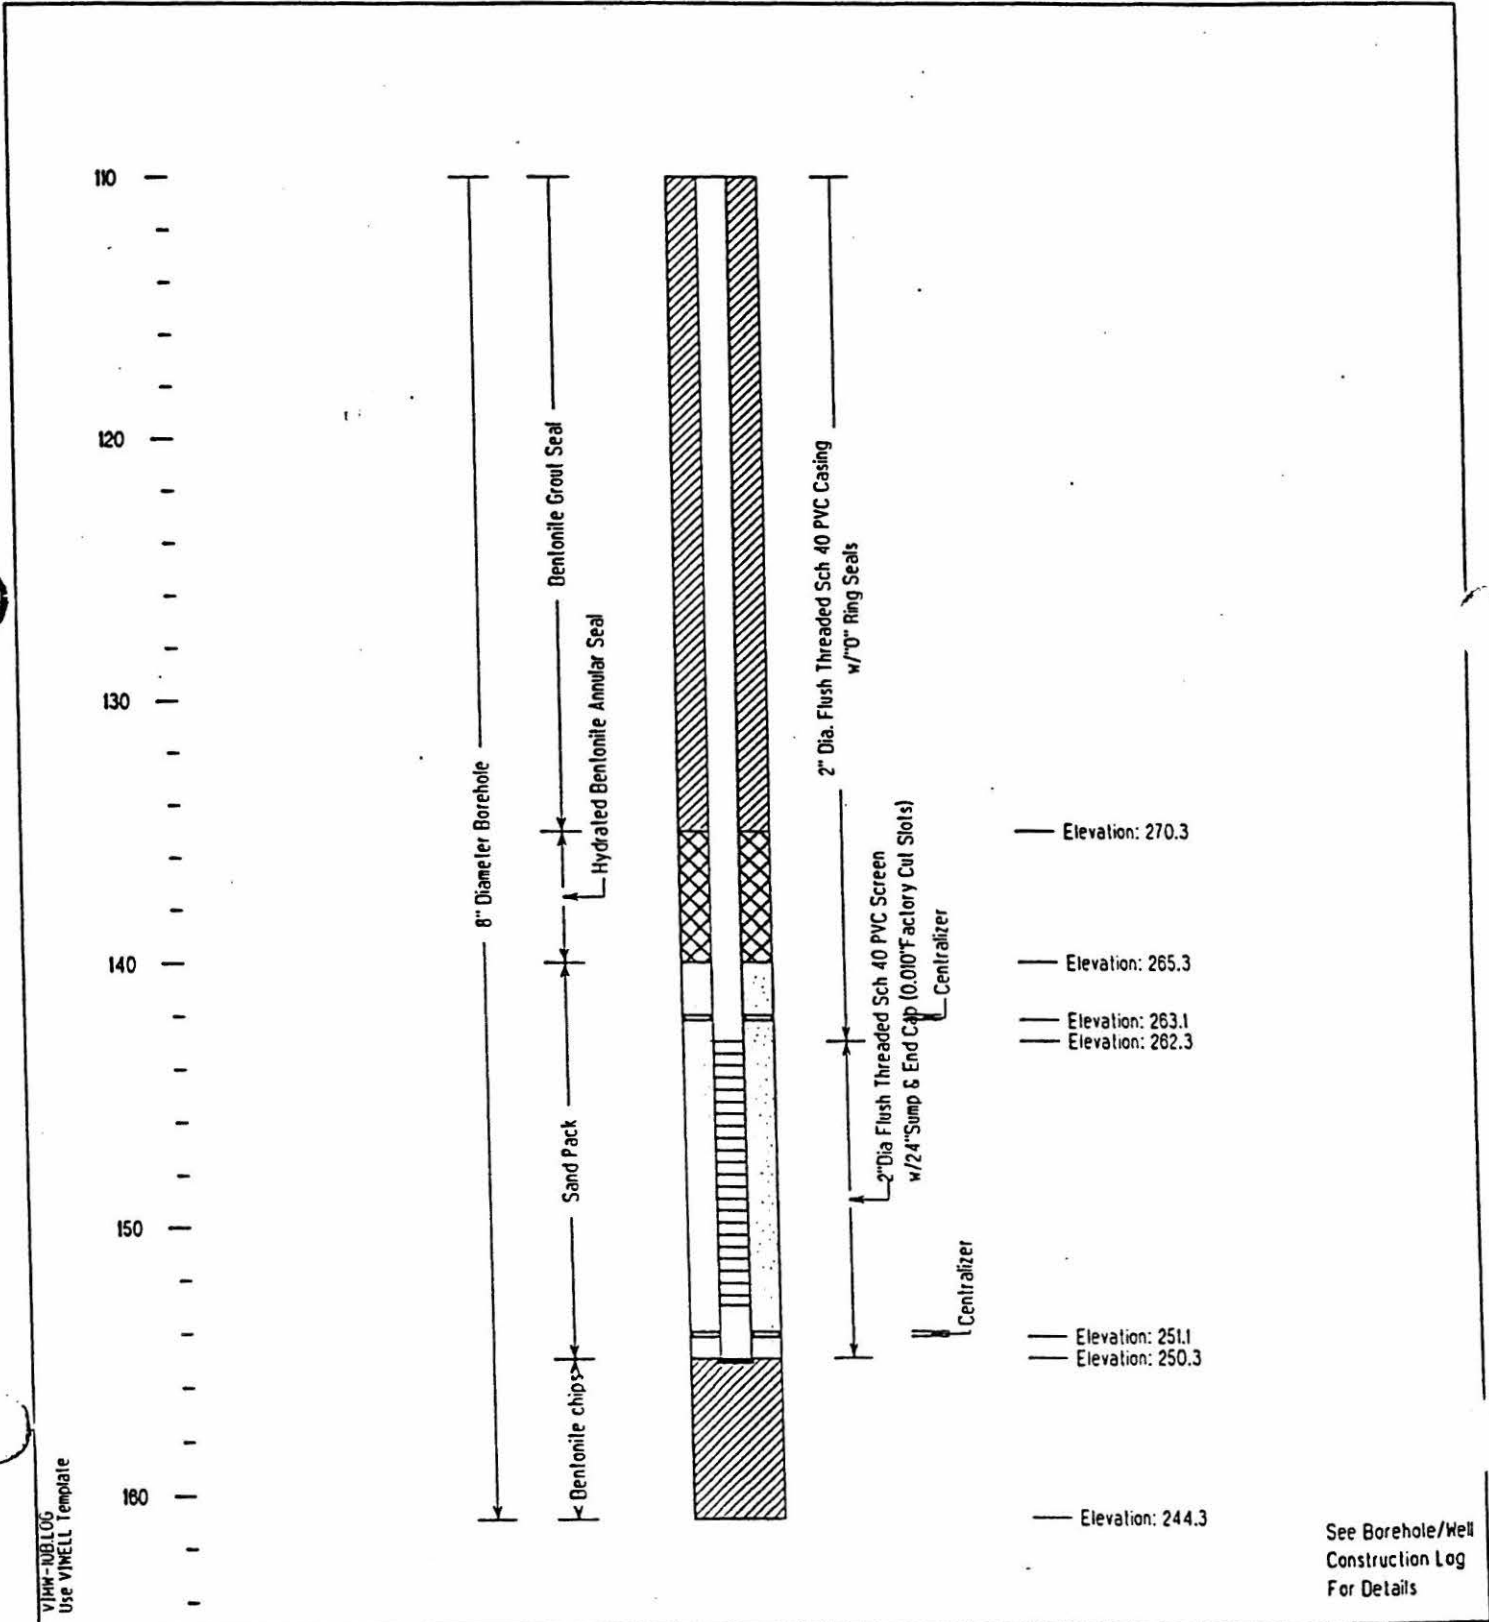

VHAK-DIBLOG  
Use VINELL Template

See Borehole/Well  
Construction Log  
For Details



PROJECT NUMBER  
106241.E3.ZZ

BORING NUMBER  
MW-1C

Renumbered as MW-11

SHEET 1 OF 4

BOREHOLE/WELL CONSTRUCTION LOG

PROJECT VASHON ISLAND LANDFILL

LOCATION N1471.91, E3023.75

ELEVATION 404.28

DRILLING CONTRACTOR TACOMA PUMP & DRILLING INC.

DRILLING METHOD AND EQUIPMENT AIR ROTARY

WATER LEVELS N/A

START 05/04/95

FINISH 05/15/95

LOGGER T.O'CONNOR

DEPTH BELOW SURFACE (FT)	SAMPLE			STANDARD PENETRATION TEST RESULTS 6" - 6" - 6" (N)	SOIL DESCRIPTION SOIL NAME, USCS GROUP SYMBOL, COLOR, MOISTURE CONTENT, RELATIVE DENSITY OR CONSISTENCY, SOIL STRUCTURE, MINERALOGY	WELL COMPLETION DIAGRAM
	INTERVAL	TYPE AND NUMBER	RECOVERY			
0.0						<p>6" Dia Steel Protective Casing w/Locking Cap</p> <p>8" Diameter Borehole</p> <p>Bentonite Grout Seal</p> <p>2" Dia. Flush Threaded Sch 40 PVC Casing w/1" Ring Seals</p> <p>Concrete Pad</p> <p>Centralizer</p>
10.0					<p>SILTY SAND, (SM) light brown, moist, firm, trace gravel</p> <p>SILTY SAND WITH GRAVEL, (SM) very dense, firm, wet, gravel 1/4"-1" diameter</p>	
20.0	20				Dark grayish brown Reached H2O @ 18'	
	21		5"	50/5"	Gravel layer @ 20'	
30.0						
40.0	40					
	41		4"	150/6"		
50.0					POORLY GRADED SAND, (SP) dark grayish brown, moist, firm	
60.0	60					
	61		1.0	15-45-50/4"	SILTY SAND WITH GRAVEL, (SM) light brown, moist, firm, trace gravel up to 1/2" diameter	
70.0						
80.0	80					
	81		1.0'	25-15-15		
90.0						
100.0						

VHM-1C LOG Use WELLSHORE template





PROJECT NUMBER 106241.E3.ZZ BORING NUMBER MW-1C Renumbered as MW-11  
 SHEET 2 OF 4

BOREHOLE/WELL CONSTRUCTION LOG

PROJECT VASHON ISLAND LANDFILL LOCATION N1471.91, E3023.75  
 ELEVATION 404.28 DRILLING CONTRACTOR TACOMA PUMP & DRILLING INC.  
 DRILLING METHOD AND EQUIPMENT AIR ROTARY  
 WATER LEVELS N/A START 05/04/95 FINISH 05/15/95 LOGGER T.O'CONNOR

DEPTH BELOW SURFACE (FT)	SAMPLE			STANDARD PENETRATION TEST RESULTS 6" -6" -6" (N)	SOIL DESCRIPTION SOIL NAME, USCS GROUP SYMBOL, COLOR, MOISTURE CONTENT, RELATIVE DENSITY OR CONSISTENCY, SOIL STRUCTURE, MINERALOGY	WELL COMPLETION DIAGRAM	
	INTERVAL	TYPE AND NUMBER	RECOVERY			DEPTH OF CASING	DRILLING RATE DRILLING FLUID LOSS TESTS AND INSTRUMENTATION
100.0	100-101		1.2	120/6"	SILTY SAND, (SM) dark grayish brown, moist, firm		
110.0					SILT, (ML) brownish gray, firm, moist, trace fine sand		
120.0	120-121		1.0	15-100/6"	Trace iron oxide staining SILTY SAND, (SM) dark grayish brown, moist, firm, dense SILT, (ML) dark gray, moist to wet, plastic, slight to moderate dilatancy		
140.0	140-141		1.1	15-35-35			
150.0					WELL GRADED SAND WITH SILT AND GRAVEL, (SW-SM) grayish brown, firm, moist		
160.0	160-161		1.0	8-15-25			
170.0							
180.0	180-181		1.2	35-100/4"	SANDY SILT, (ML), dark gray, massive, moist to dry, firm, dense, vertical layering		
190.0							
200.0							

8" Diameter Borehole

Bentonite Grout Seal

2" Dia. Flush Threaded Sch. 40 PVC Casing w/ "O" Ring Seals

Centralizer

VIAH-IL LOG Use WELLSBORO 150 plate



PROJECT NUMBER 106241.E3.ZZ	BORING NUMBER MW-1C	Renumbered as MW-11
SHEET 3 OF 4		
BOREHOLE/WELL CONSTRUCTION LOG		

PROJECT VASHON ISLAND LANDFILL LOCATION NI471.91, E3023.75  
 ELEVATION 404.28 DRILLING CONTRACTOR TACOMA PUMP & DRILLING INC.  
 DRILLING METHOD AND EQUIPMENT AIR ROTARY  
 WATER LEVELS N/A START 05/04/95 FINISH 05/15/95 LOGGER T.O'CONNOR

DEPTH BELOW SURFACE (FT)	SAMPLE			STANDARD PENETRATION TEST RESULTS	SOIL DESCRIPTION	WELL COMPLETION DIAGRAM
	INTERVAL	TYPE AND NUMBER	RECOVERY	6" - 6" - 6" (N)	SOIL NAME, USCS GROUP SYMBOL, COLOR, MOISTURE CONTENT, RELATIVE DENSITY OR CONSISTENCY, SOIL STRUCTURE, MINERALOGY	DEPTH OF CASING, DRILLING RATE, DRILLING FLUID LOSS TESTS AND INSTRUMENTATION
200.0	200		.5'	50/6"-50/1"	SANDY SILT, (ML), as above.	<p>8" Diameter Borehole          3/8" minus pea gravel          Bentonite Grout          Hydrated Bentonite Annular Seal          Bentonite Grout Seal          No.20-40 Colorado          2" Dia. Flush Threaded Sch 40 PVC Casing w/1/16" Sump &amp; End Cap (0.010" Fcly Cut Slots)          2" Dia. Flush Threaded Sch 40 PVC Casing w/1/8" Ring Seals          Centralizer</p>
210.0					SILTY SAND WITH GRAVEL, (SM) dark gray, firm, moist	
220.0	220		.6"	50-100/5"	WELL GRADED SAND WITH SILT AND GRAVEL, (SW-SM) very dark gray, firm, moist	
230.0	221					
240.0	240		1.0'	25-45-50/5"	SILTY SAND WITH GRAVEL, (SM) dark gray, firm, moist, gravel 1/4-1/2" diameter	
250.0	241					
260.0	260		1.0	15-35-50/5"	SANDY SILT, (ML) dark gray, firm, moist, brittle, trace pea gravel	
270.0	261					
280.0	280		1.0	15-35-50/5"	SILTY GRAVEL WITH SAND, (GM) dark gray, dense, moist, gravel ranging from 1/8-1" diameter, subangular	
290.0	281					
300.0	300				SANDY SILT, (ML) dark gray, firm, dense,	

VJMK-IC LOG Use WELLBORE 150 plate



PROJECT NUMBER 106241.E3.ZZ	BORING NUMBER MW-1C	Renumbered as MW-11 SHEET 4 OF 4
--------------------------------	------------------------	-------------------------------------

## BOREHOLE/WELL CONSTRUCTION LOG

PROJECT VASHON ISLAND LANDFILL LOCATION N1471.91, E3023.75  
 ELEVATION 404.28 DRILLING CONTRACTOR TACOMA PUMP & DRILLING INC.  
 DRILLING METHOD AND EQUIPMENT AIR ROTARY  
 WATER LEVELS N/A START 05/04/95 FINISH 05/15/95 LOGGER T.O'CONNOR


DEPTH BELOW SURFACE (FT)	SAMPLE			STANDARD PENETRATION TEST RESULTS 6" - 6" - 6" (N)	SOIL DESCRIPTION SOIL NAME, USCS GROUP SYMBOL, COLOR, MOISTURE CONTENT, RELATIVE DENSITY OR CONSISTENCY, SOIL STRUCTURE, MINERALOGY	WELL COMPLETION DIAGRAM DEPTH OF CASING, DRILLING RATE, DRILLING FLUID LOSS TESTS AND INSTRUMENTATION
	INTERVAL	TYPE AND NUMBER	RECOVERY			
300	301		.5	6-30-30	SANDY SILT (ML), as above.	
310.0					POORLY GRADED SAND (SP) dark gray, firm, saturated, trace white tuffaceous material	
320.0	321		1.0'	3-5-3		
330.0					Trace wood chips	
340.0	341		1.5'			
350.0						
360.0					POORLY GRADED SAND WITH GRAVEL (SW) dark gray, firm, moist	
370.0						
380.0					TOTAL DEPTH = 375 FEET	

VIEW - E.L.O.S. Use WELLBORE LOG plate



PROJECT NUMBER 106241.E3.2.2	BORING NUMBER MW-1C	Renumbered as MW-11 SHEET 1 OF 4
<b>WELL CONSTRUCTION SUMMARY</b>		

PROJECT VASHON ISLAND LANDFILL LOCATION NI471.91, E3023.75  
 ELEVATION 404.28 DRILLING CONTRACTOR TACOMA PUMP & DRILLING INC.  
 DRILLING METHOD AND EQUIPMENT AIR ROTARY  
 WATER LEVELS N/A START 05/04/95 FINISH 05/15/95 LOGGER T.O'CONNOR

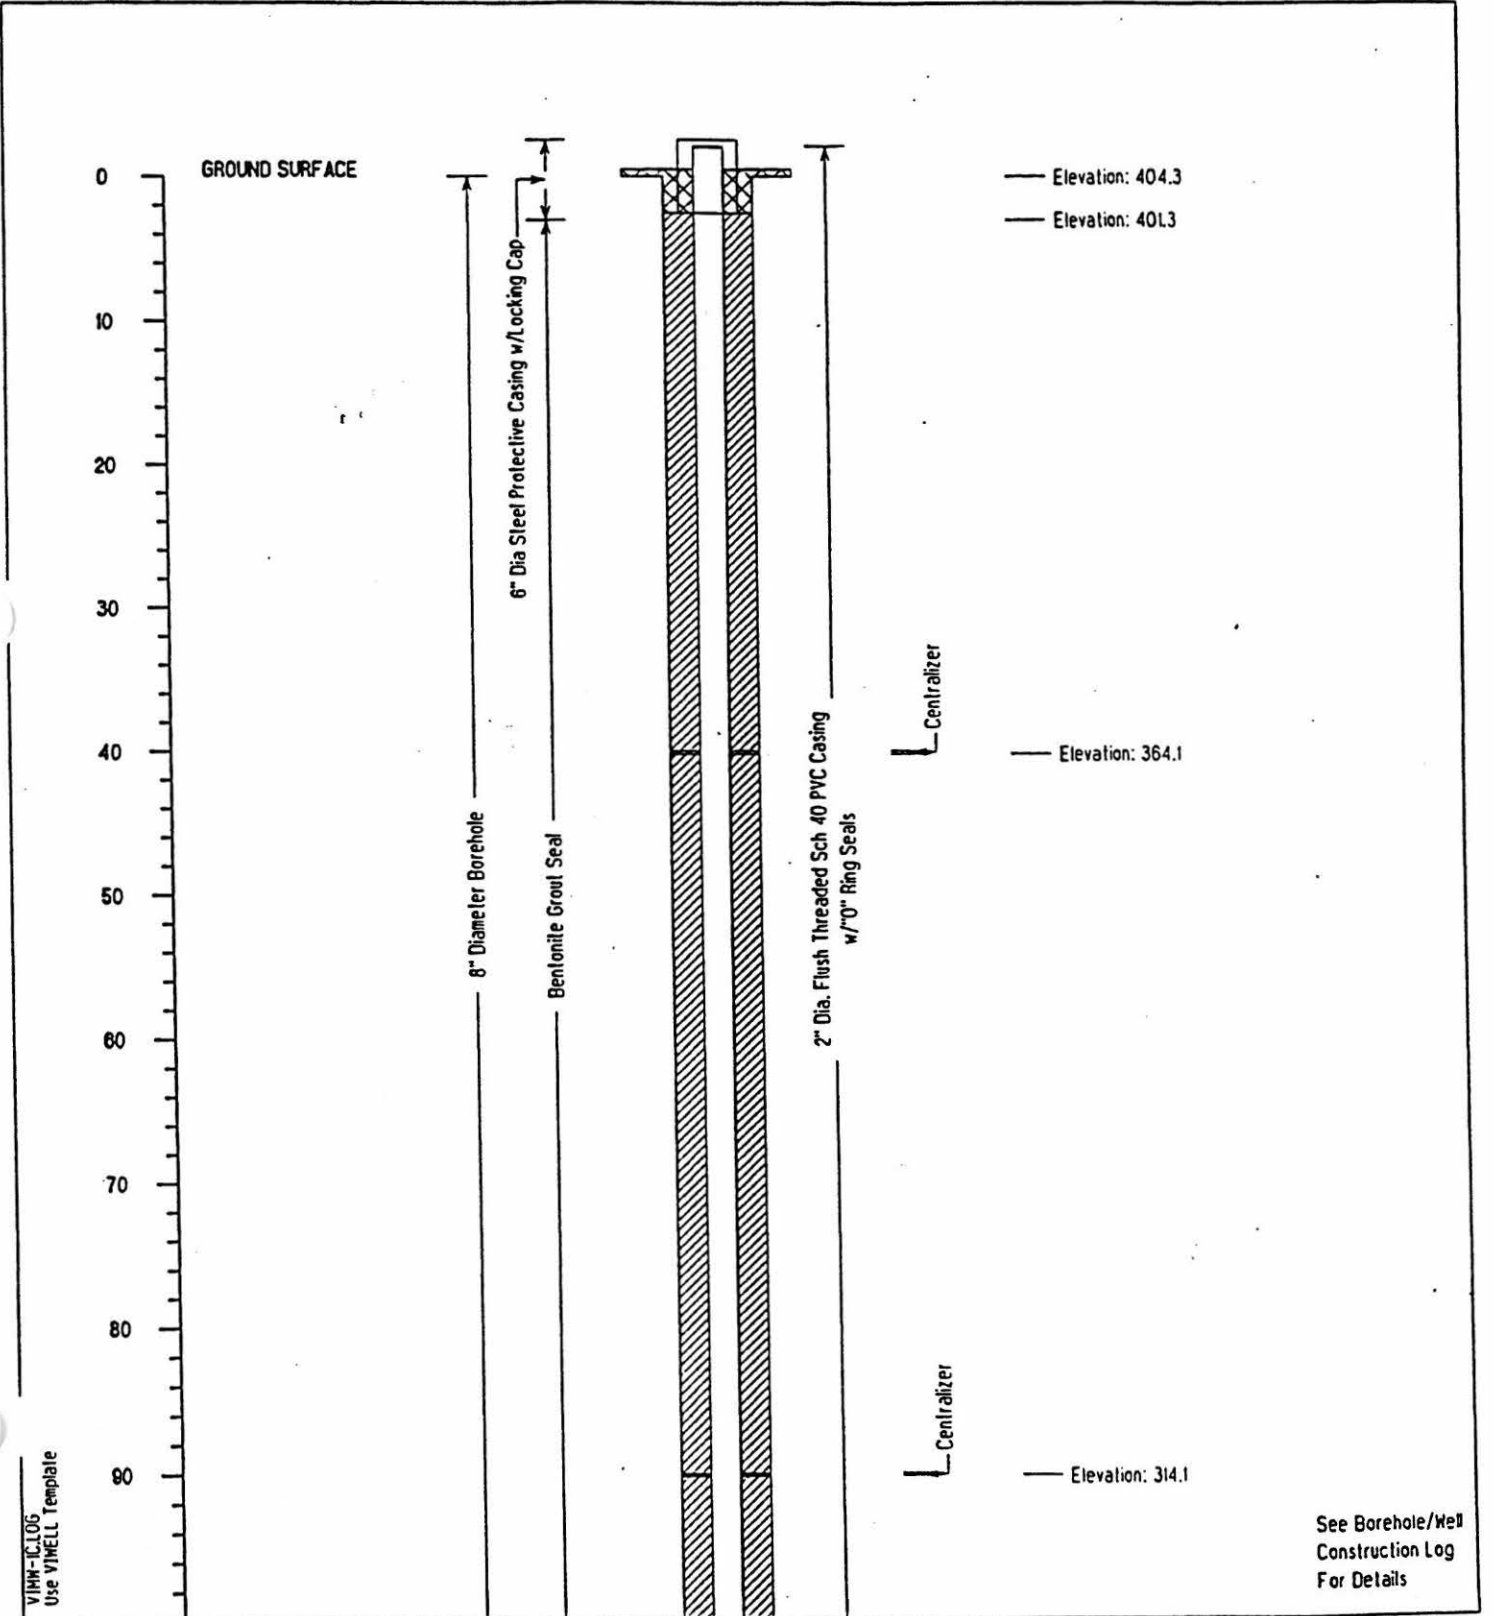

VINW-IC LOG  
Use VINELL Template

See Borehole/Well  
Construction Log  
For Details



PROJECT NUMBER

106241E3.77

BORING NUMBER

MW-1C

Renumbered as MW-11

SHEET 2 OF 4

# WELL CONSTRUCTION SUMMARY

PROJECT VASHON ISLAND LANDFILL

LOCATION N1471.91, E3023.75

ELEVATION 404.28

DRILLING CONTRACTOR TACOMA PUMP & DRILLING INC.


DRILLING METHOD AND EQUIPMENT AIR ROTARY

WATER LEVELS N/A

START 05/04/95

FINISH 05/15/95

LOGGER T.O'CONNOR

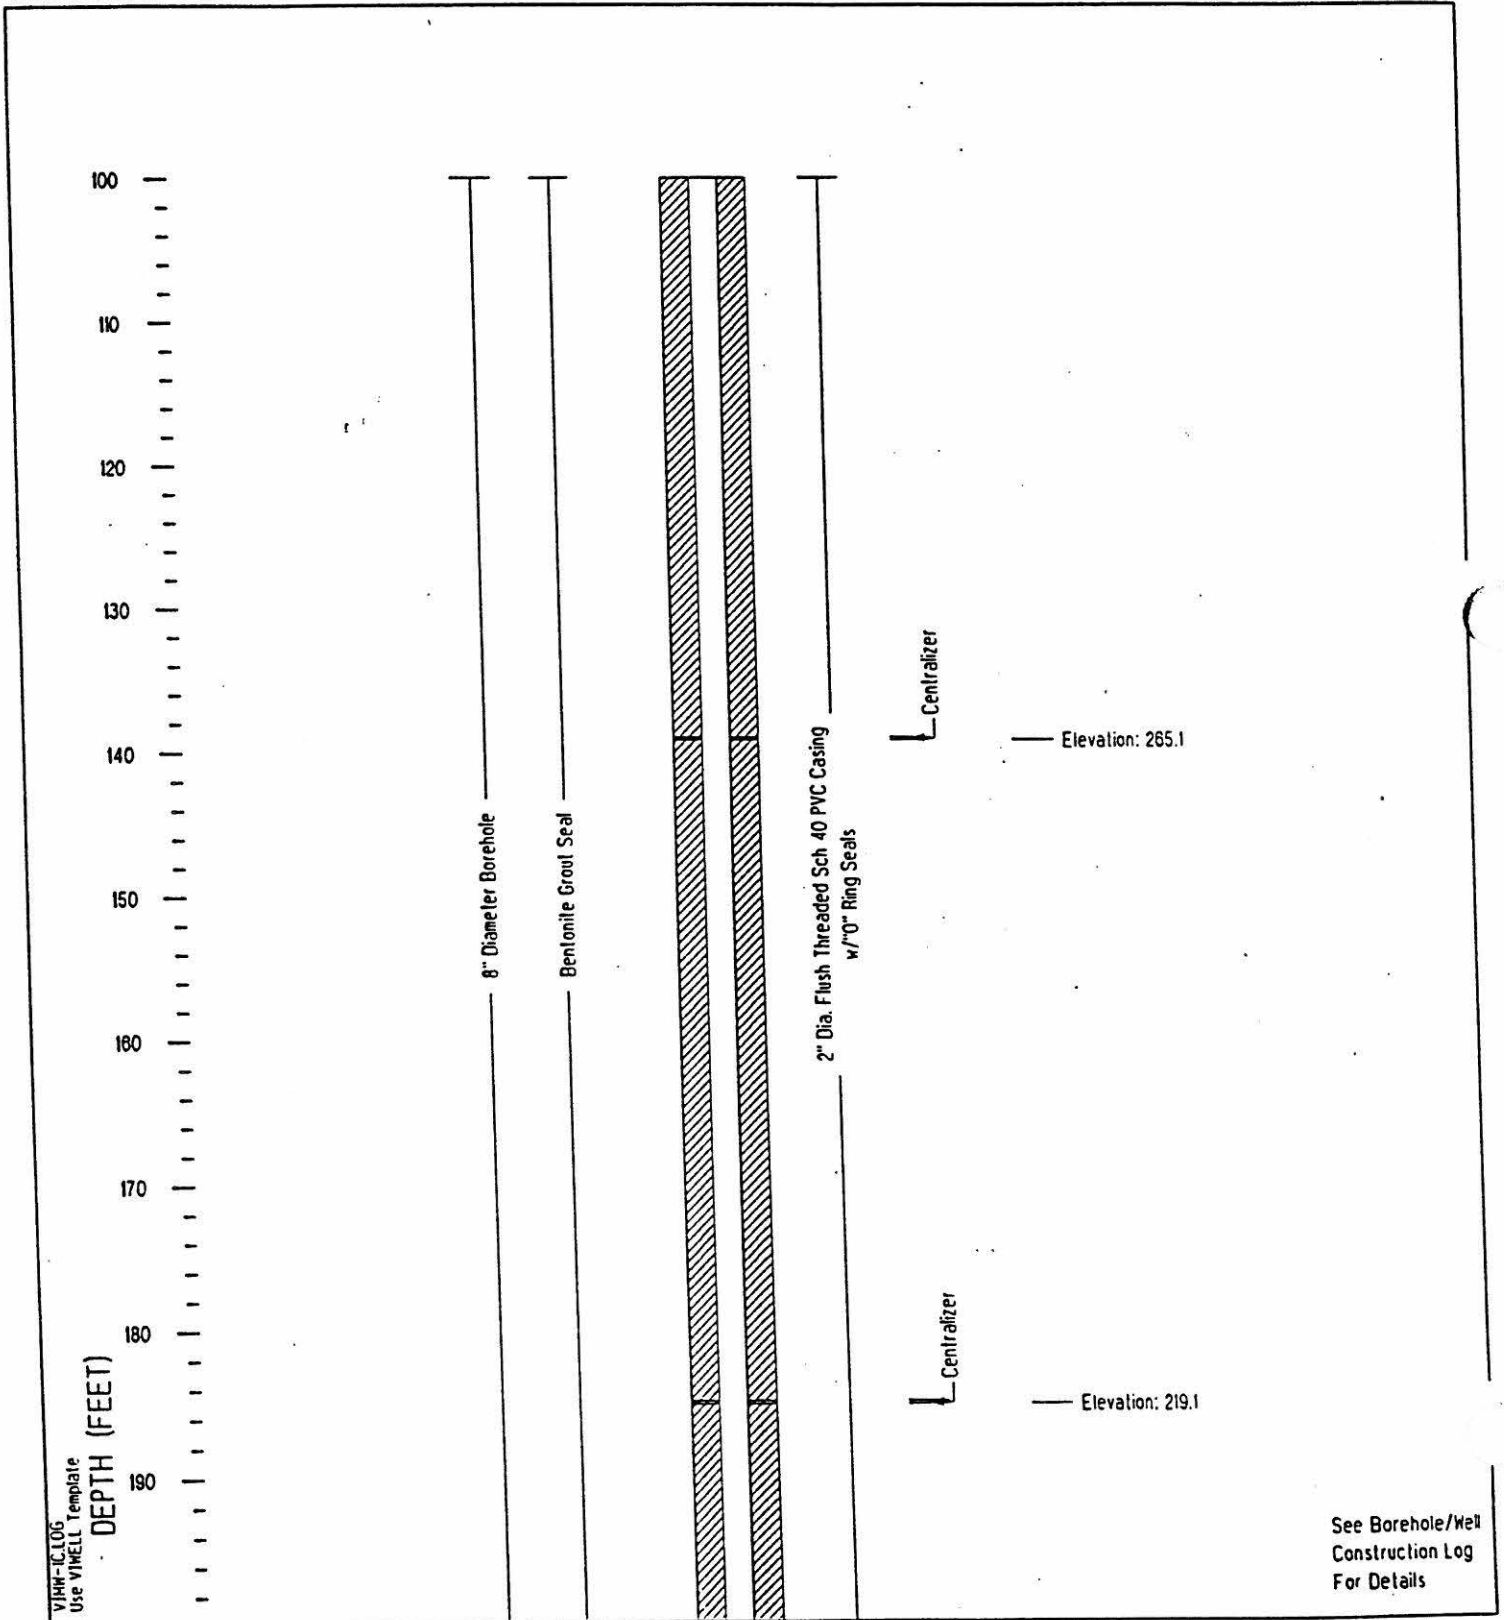



PROJECT NUMBER

105241E3.77

BORING NUMBER

MW-1C

Renumbered as MW-11

SHEET 3 OF 4

### WELL CONSTRUCTION SUMMARY

PROJECT VASHON ISLAND LANDFILL

LOCATION N1471.91, E3023.75

ELEVATION 404.28

DRILLING CONTRACTOR TACOMA PUMP & DRILLING INC.


DRILLING METHOD AND EQUIPMENT AIR ROTARY

WATER LEVELS N/A

START 05/04/95

FINISH 05/15/95

LOGGER T.O'CONNOR

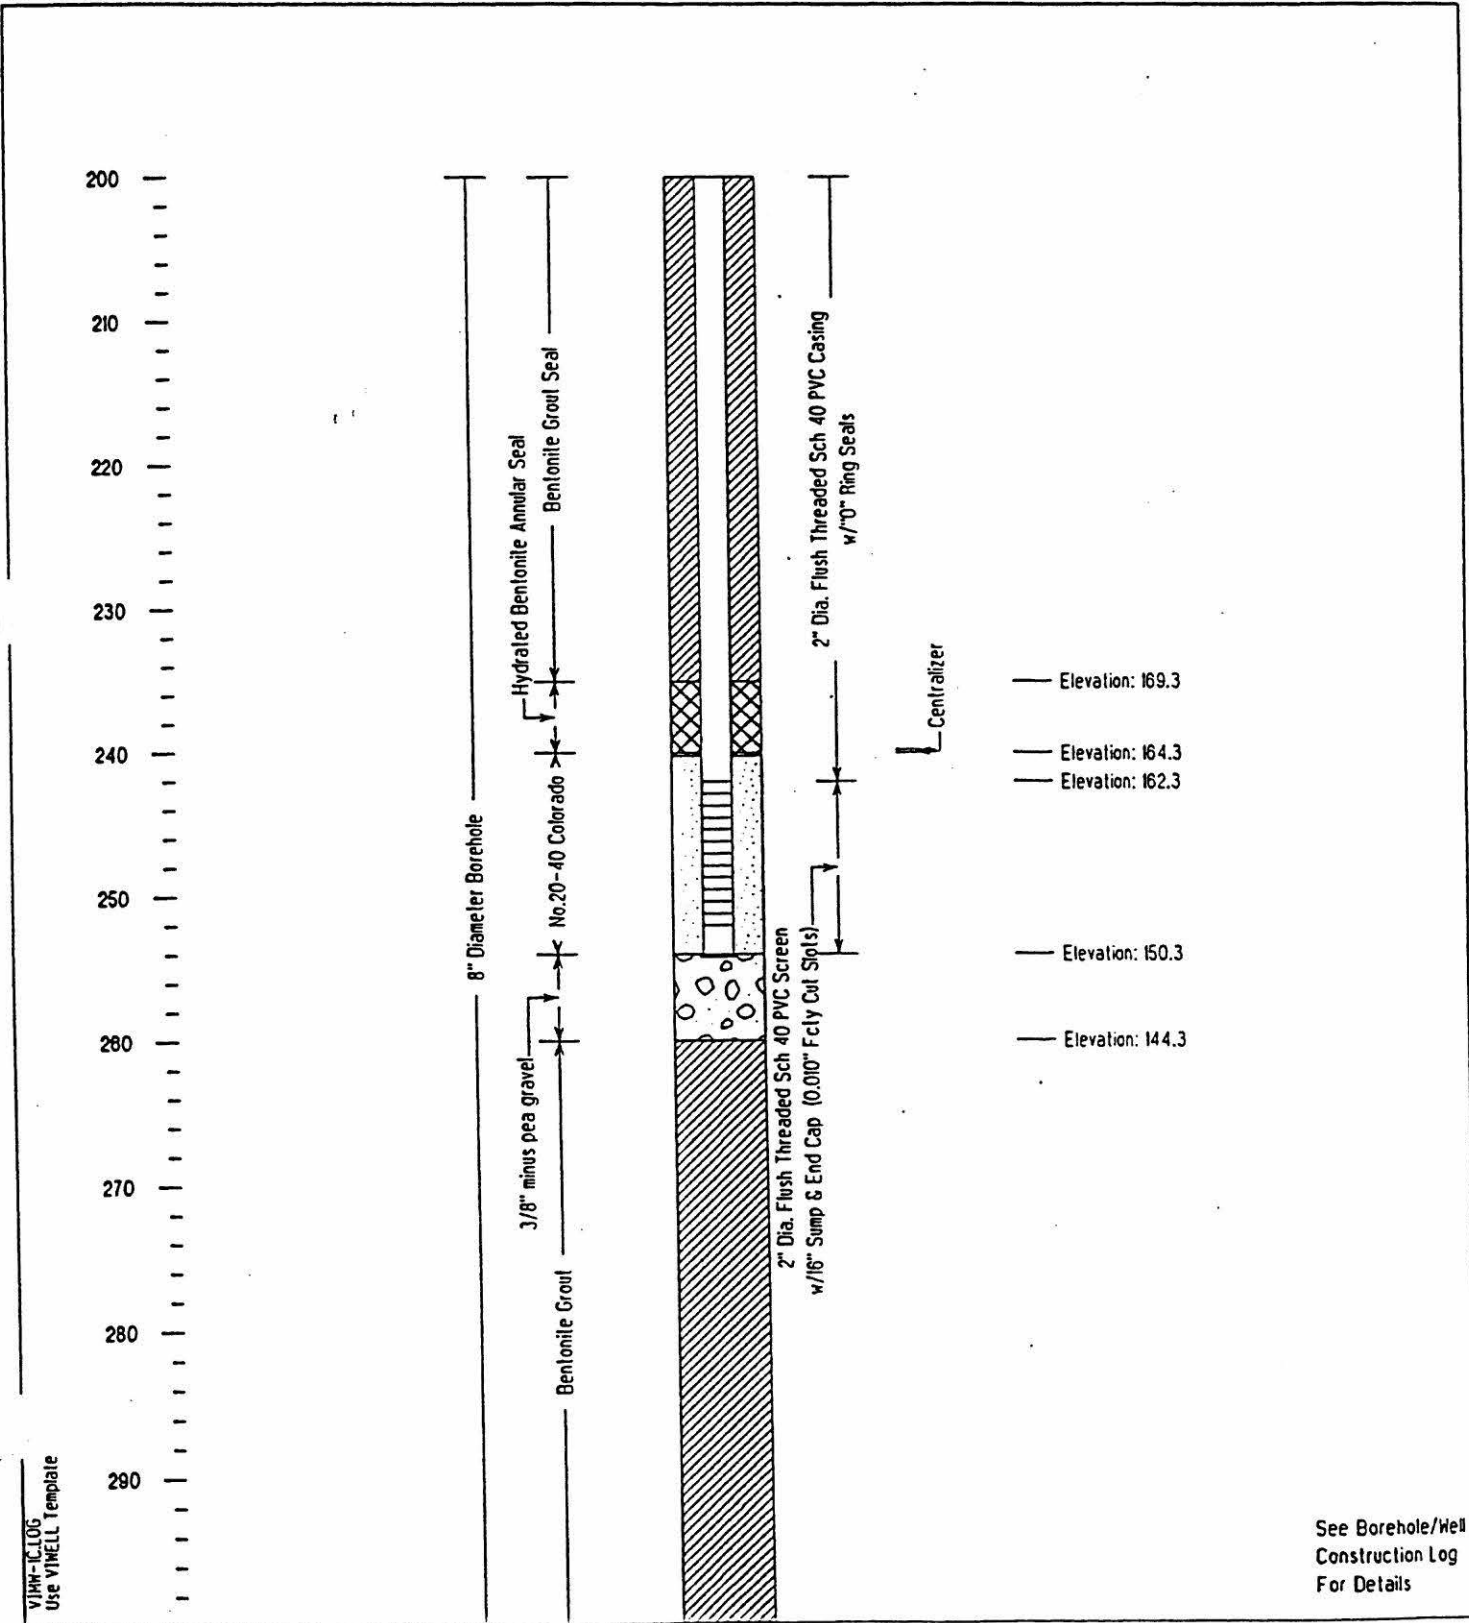




PROJECT NUMBER	BORING NUMBER	Renumbered as MW-11
106241.E3.7.7	MW-1C	SHEET 4 OF 4

**WELL CONSTRUCTION SUMMARY**

PROJECT VASHON ISLAND LANDFILL LOCATION NI471.91, E3023.75  
ELEVATION 404.28 DRILLING CONTRACTOR TACOMA PUMP & DRILLING INC.  
DRILLING METHOD AND EQUIPMENT AIR ROTARY  
WATER LEVELS N/A START 05/04/95 FINISH 05/15/95 LOGGER T.O'CONNOR

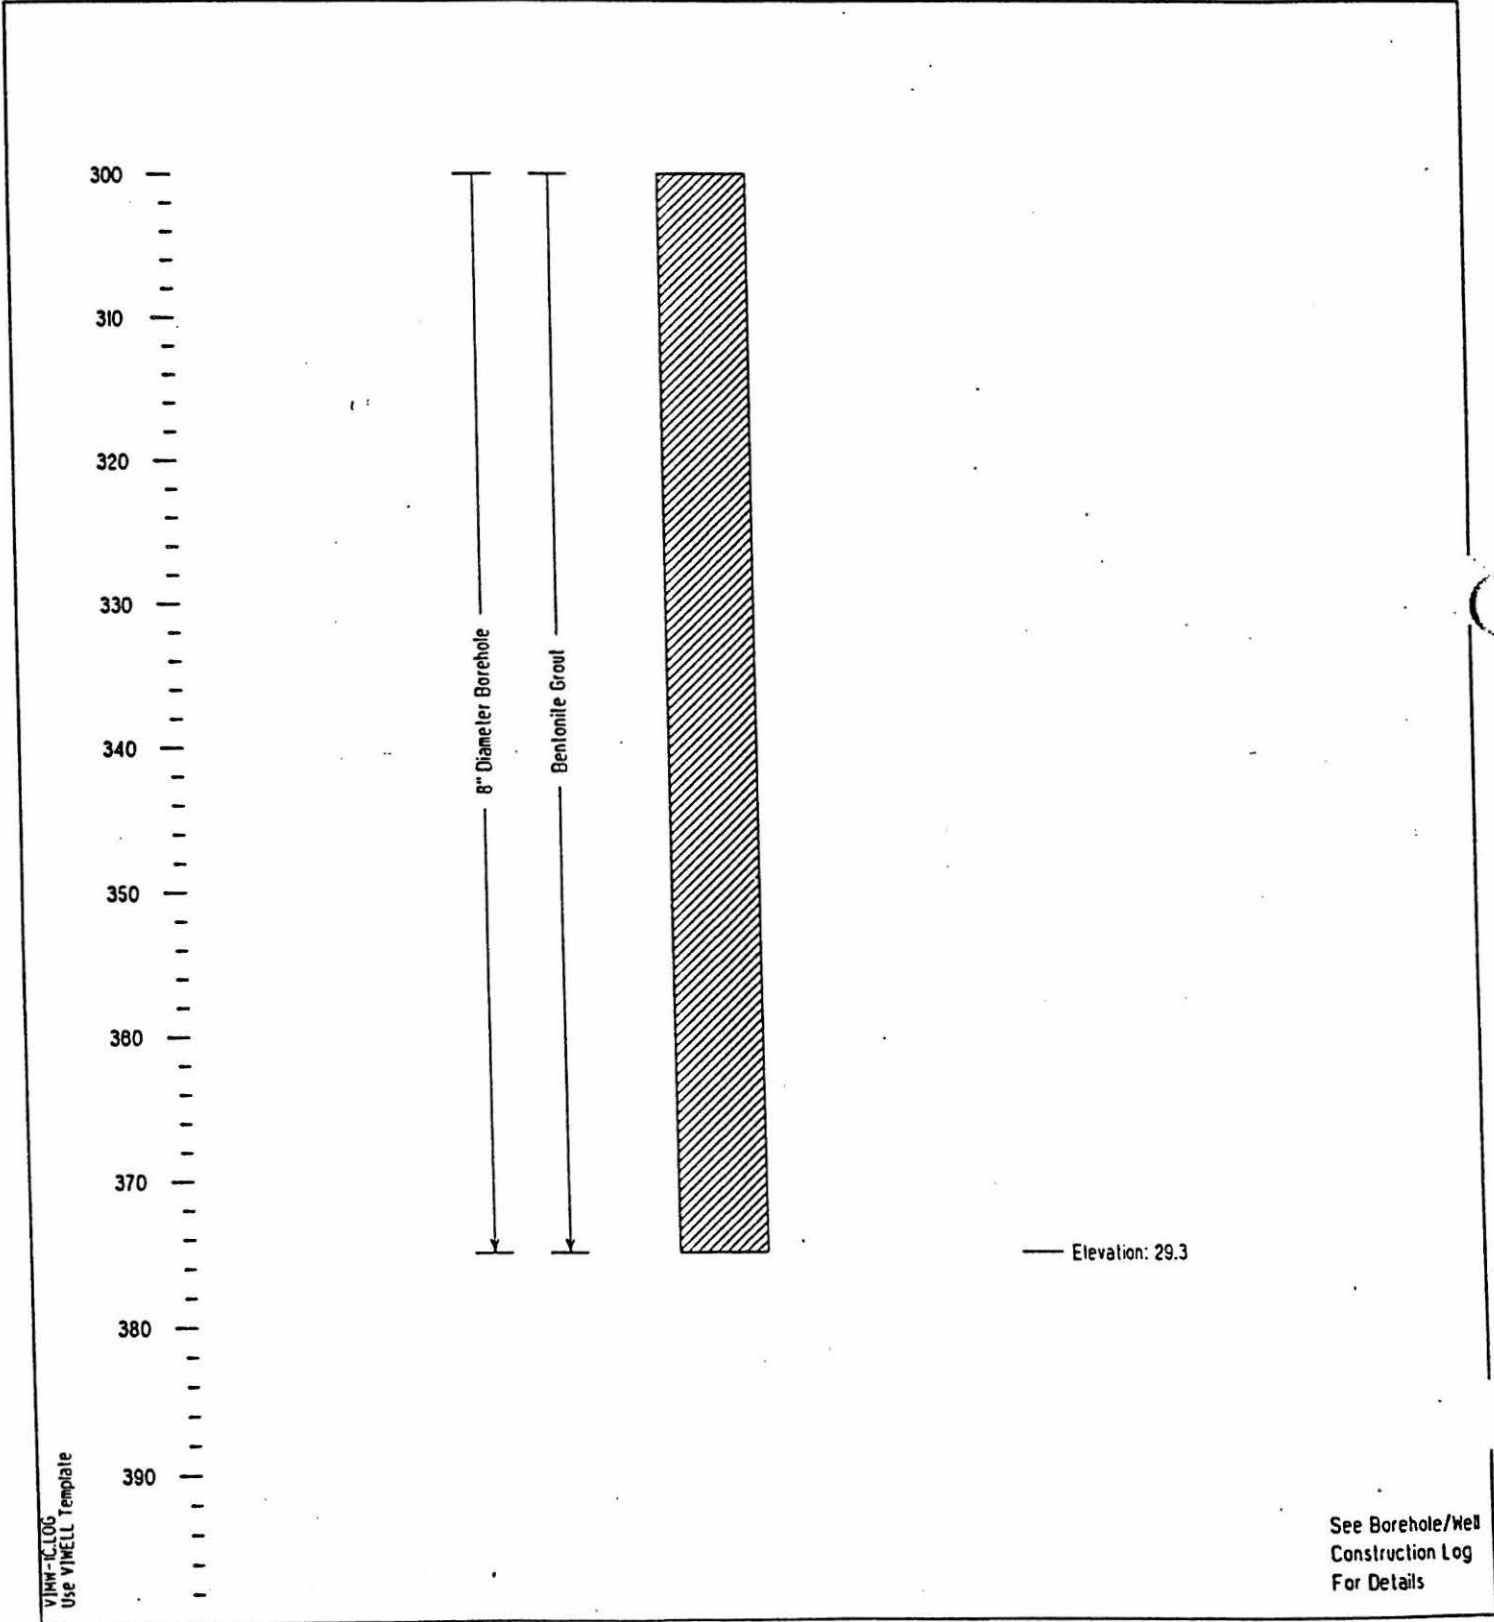



PROJECT NUMBER 106241.E3.ZZ	BORING NUMBER MW-2C
Renumbered as MW-12	
SHEET 1 OF 4	
<b>BOREHOLE/WELL CONSTRUCTION LOG</b>	

PROJECT YASHON ISLAND LANDFILL LOCATION N133.51, E2370.88  
 ELEVATION 310.12 DRILLING CONTRACTOR TACOMA PUMP & DRILLING INC.  
 DRILLING METHOD AND EQUIPMENT AIR ROTARY  
 WATER LEVELS N/A START 05/19/95 FINISH 05/26/95 LOGGER T.O'CONNOR

DEPTH BELOW SURFACE (FT)	SAMPLE			STANDARD PENETRATION TEST RESULTS 6" - 6" - 6" (N)	SOIL DESCRIPTION SOIL NAME, USCS GROUP SYMBOL, COLOR, MOISTURE CONTENT, RELATIVE DENSITY OR CONSISTENCY, SOIL STRUCTURE, MINERALOGY	WELL COMPLETION DIAGRAM
	INTERVAL	TYPE AND NUMBER	RECOVERY			
10.0					<u>SILTY SAND (SM)</u> , gray brown, moist, firm	<p style="font-size: small; margin: 0;">6" Dia. Steel Protective Casing w/ Locking Cap</p> <p style="font-size: small; margin: 0;">8" Diameter Borehole</p> <p style="font-size: small; margin: 0;">Bentonite Grout Seal</p> <p style="font-size: small; margin: 0;">2" Dia. Flush Threaded, Sch 40 PVC Casing w/ 0" Ring Seals</p> <p style="font-size: small; margin: 0;">Cement</p> <p style="font-size: small; margin: 0;">Centralizer</p>
20.0	20					
	21	1.1	7-12-25	<u>SILT (ML)</u> , brown/light brown, moist, firm, dense, brittle		
				<u>POORLY GRADED SAND (SP)</u> , light brown, moist, firm, trace silt		
30.0						
	40			<u>SILTY SAND (SM)</u> , gray, moist to wet		
	41.5	0.9"	18-20-50	<u>SILT (ML)</u> , olive gray, moist to wet, firm, brittle, vertical layering, trace iron oxide mottling, non-plastic Slightly plastic		
50.0						
	60			<u>WELL GRADED SAND (SW)</u> , light gray, moist, firm, trace silt		
	61	1.0'	6-15-32	<u>SANDY SILT (ML)</u> , gray/brown, wet to moist, firm		
70.0						
	80			<u>SILT (ML)</u> , dark gray, massive, dry, firm, dense, brittle		
	81.5	1.0'	15-20-35	<u>SILTY SAND (SM)</u> , light gray, moist to wet  Trace Gravel		
90.0				<u>WELL SORTED SAND (SW)</u> , light gray, moist, firm		
100						

VIHW-2C LOG  
Use WELLSBORO Template





Renamed MW-12

PROJECT NUMBER 106241.E3.ZZ	BORING NUMBER MW-2C	Renumbered as MW-12
		SHEET 2 OF 4
<b>BOREHOLE/WELL CONSTRUCTION LOG</b>		

PROJECT VASHON ISLAND LANDFILL LOCATION N133.51, E2370.88  
 ELEVATION 310.12 DRILLING CONTRACTOR TACOMA PUMP & DRILLING INC.  
 DRILLING METHOD AND EQUIPMENT AIR ROTARY  
 WATER LEVELS N/A START 05/19/95 FINISH 05/26/95 LOGGER T.O'CONNOR

DEPTH BELOW SURFACE (FT)	SAMPLE			STANDARD PENETRATION TEST RESULTS 6" - 6" - 6" (N)	SOIL DESCRIPTION SOIL NAME, USCS GROUP SYMBOL, COLOR, MOISTURE CONTENT, RELATIVE DENSITY OR CONSISTENCY, SOIL STRUCTURE, MINERALOGY	WELL COMPLETION DIAGRAM DEPTH OF CASING, DRILLING RATE, DRILLING FLUID LOSS TESTS AND INSTRUMENTATION
	INTERVAL	TYPE AND NUMBER	RECOVERY			
100.0	100.0 - 101.5		1.5'	2-2-2	SILTY SAND (SM), dark gray, moist, firm	<p>8" Diameter Borehole Hydrated Bentonite Annular Seal Bentonite Grout Seal No. 20-40 Colorado Silica Sand Filter Pack 3/8" minus pea gravel Bentonite Grout 2" Dia. Flush Threaded, Sch 40 PVC Casing w/1" O" Ring Seal Centralizer reel lot</p>
120.0	120.0 - 121.5		1.3'	2-2-12	SANDY SILT (ML), dark gray, wet, firm SILT (ML), gray, moist, firm, plastic	
140.0	140.0 - 145.5		1.5'	7-7-30	WELL GRADED SAND (SW), light gray, moist, firm, trace silt SILTY-CLAYEY SAND (SM-SC), dark gray, moist, firm SAND WITH GRAVEL, light brown/gray, trace silt,	
160.0	160.0 - 161.5		8"		POORLY GRADED SAND (SP), olive gray, wet, firm	
180.0	180.0 - 181.5		0.6"	2-10-18	POORLY GRADED SAND WITH SILT (SP-SM), gray, wet, firm, dense SILT (ML), gray, moist, firm, dense	
180.0	181.5 - 182.0					
180.0	182.0 - 182.5					
180.0	182.5 - 183.0					

V14W-21105  
Use WELLBORE 18" plate  
200



PROJECT NUMBER 106241.E3.ZZ	BORING NUMBER MW-2C	Renumbered as MW-12
		SHEET 3 OF 4
<b>BOREHOLE/WELL CONSTRUCTION LOG</b>		

PROJECT VASHON ISLAND LANDFILL LOCATION N133.51, E2370.88  
 ELEVATION 310.12 DRILLING CONTRACTOR TACOMA PUMP & DRILLING INC.  
 DRILLING METHOD AND EQUIPMENT AIR ROTARY  
 WATER LEVELS N/A START 05/19/95 FINISH 05/26/95 LOGGER T.O'CONNOR

DEPTH BELOW SURFACE (FT)	SAMPLE			STANDARD PENETRATION TEST RESULTS 6" - 6" - 6" (N)	SOIL DESCRIPTION SOIL NAME, USCS GROUP SYMBOL, COLOR, MOISTURE CONTENT, RELATIVE DENSITY OR CONSISTENCY, SOIL STRUCTURE, MINERALOGY	WELL COMPLETION DIAGRAM	
	INTERVAL	TYPE AND NUMBER	RECOVERY			DEPTH OF CASING	DRILLING RATE DRILLING FLUID LOSS TESTS AND INSTRUMENTATION
200.0	200.0 - 201.5	SS	1'	10-25-35	SANDY SILTY (ML), dark gray/black, moist, firm SILT (ML), dark gray, wet, firm, trace wood fragments POORLY GRADED SAND (SP), gray, moist, trace silt with white pumice		
220.0	220.0 - 221.5	SS	0.9	15-15-30	POORLY GRADED SAND WITH SILT (SP-SM), dark gray, wet, dense, white pumice, trace non-plastic silt WELL GRADED SAND (SW), gray, wet, wood fragments, some fine gravel, subrounded up to 1/4" in diameter POORLY GRADED SAND (SP), gray, wet, trace wood fragments, trace subrounded gravel		
240.0	240.0 - 241.5	SS	1.5	7-30-50/4"	SILTY SAND (SM), dark gray, wet, dense, trace of gray non-plastic silt SILTY SAND WITH GRAVEL (SP), dark gray, wet, firm	8" Diameter Borehole	Bentonite Grout
260.0	260.0 - 261.5	SS	0.5		POORLY GRADED SAND WITH GRAVEL (SP), gray, wet, gravel is subrounded to rounded, up to 1.5 inches in diameter SILTY SAND (SM), gray, wet, firm, up to trace subrounded gravel (up to 3%) 1/2 inch in diameter		
280.0	280.0 - 281.5	SS	1.0	5-7-30	POORLY GRADED SAND (SP), gray, very wet, medium dense, trace silt		
290.0	290.0 - 300.0						

VIHW-2C LOG Use WELLBORE 195 plate



PROJECT NUMBER  
106241.E3.2Z

BORING NUMBER  
MW-2C

Renumbered as MW-12

SHEET 4 OF 4

BOREHOLE/WELL CONSTRUCTION LOG

PROJECT VASHON ISLAND LANDFILL LOCATION N133.51. E2370.88  
 ELEVATION 310.12 DRILLING CONTRACTOR TACOMA PUMP & DRILLING INC.  
 DRILLING METHOD AND EQUIPMENT AIR ROTARY  
 WATER LEVELS N/A START 05/19/95 FINISH 05/26/95 LOGGER T.O'CONNOR.


DEPTH BELOW SURFACE (FT)	SAMPLE			STANDARD PENETRATION TEST RESULTS 6" - 6" - 6" (N)	SOIL DESCRIPTION SOIL NAME, USCS GROUP SYMBOL, COLOR, MOISTURE CONTENT, RELATIVE DENSITY OR CONSISTENCY, SOIL STRUCTURE, MINERALOGY	WELL COMPLETION DIAGRAM DEPTH OF CASING, DRILLING RATE, DRILLING FLUID LOSS TESTS AND INSTRUMENTATION
	INTERVAL	TYPE AND NUMBER	RECOVERY			
300.0		SS	0.8	1-1-6	POORLY GRADED SAND (SP), gray, wet, fine grain sand TOTAL DEPTH = 301.5 FEET	8" Diameter Borehole

VIHW-2C LOG Use WELLBORE TEMPLATE



PROJECT NUMBER 106241.E3.27	BORING NUMBER MW-2C	Renumbered as MW-12 SHEET 1 OF 4
WELL CONSTRUCTION SUMMARY		


PROJECT VASHON ISLAND LANDFILL LOCATION N133.51, E2370.88  
ELEVATION 310.12 DRILLING CONTRACTOR TACOMA PUMP & DRILLING INC.  
DRILLING METHOD AND EQUIPMENT AIR ROTARY  
WATER LEVELS N/A START 05/19/95 FINISH 05/26/95 LOGGER T.O'CONNOR

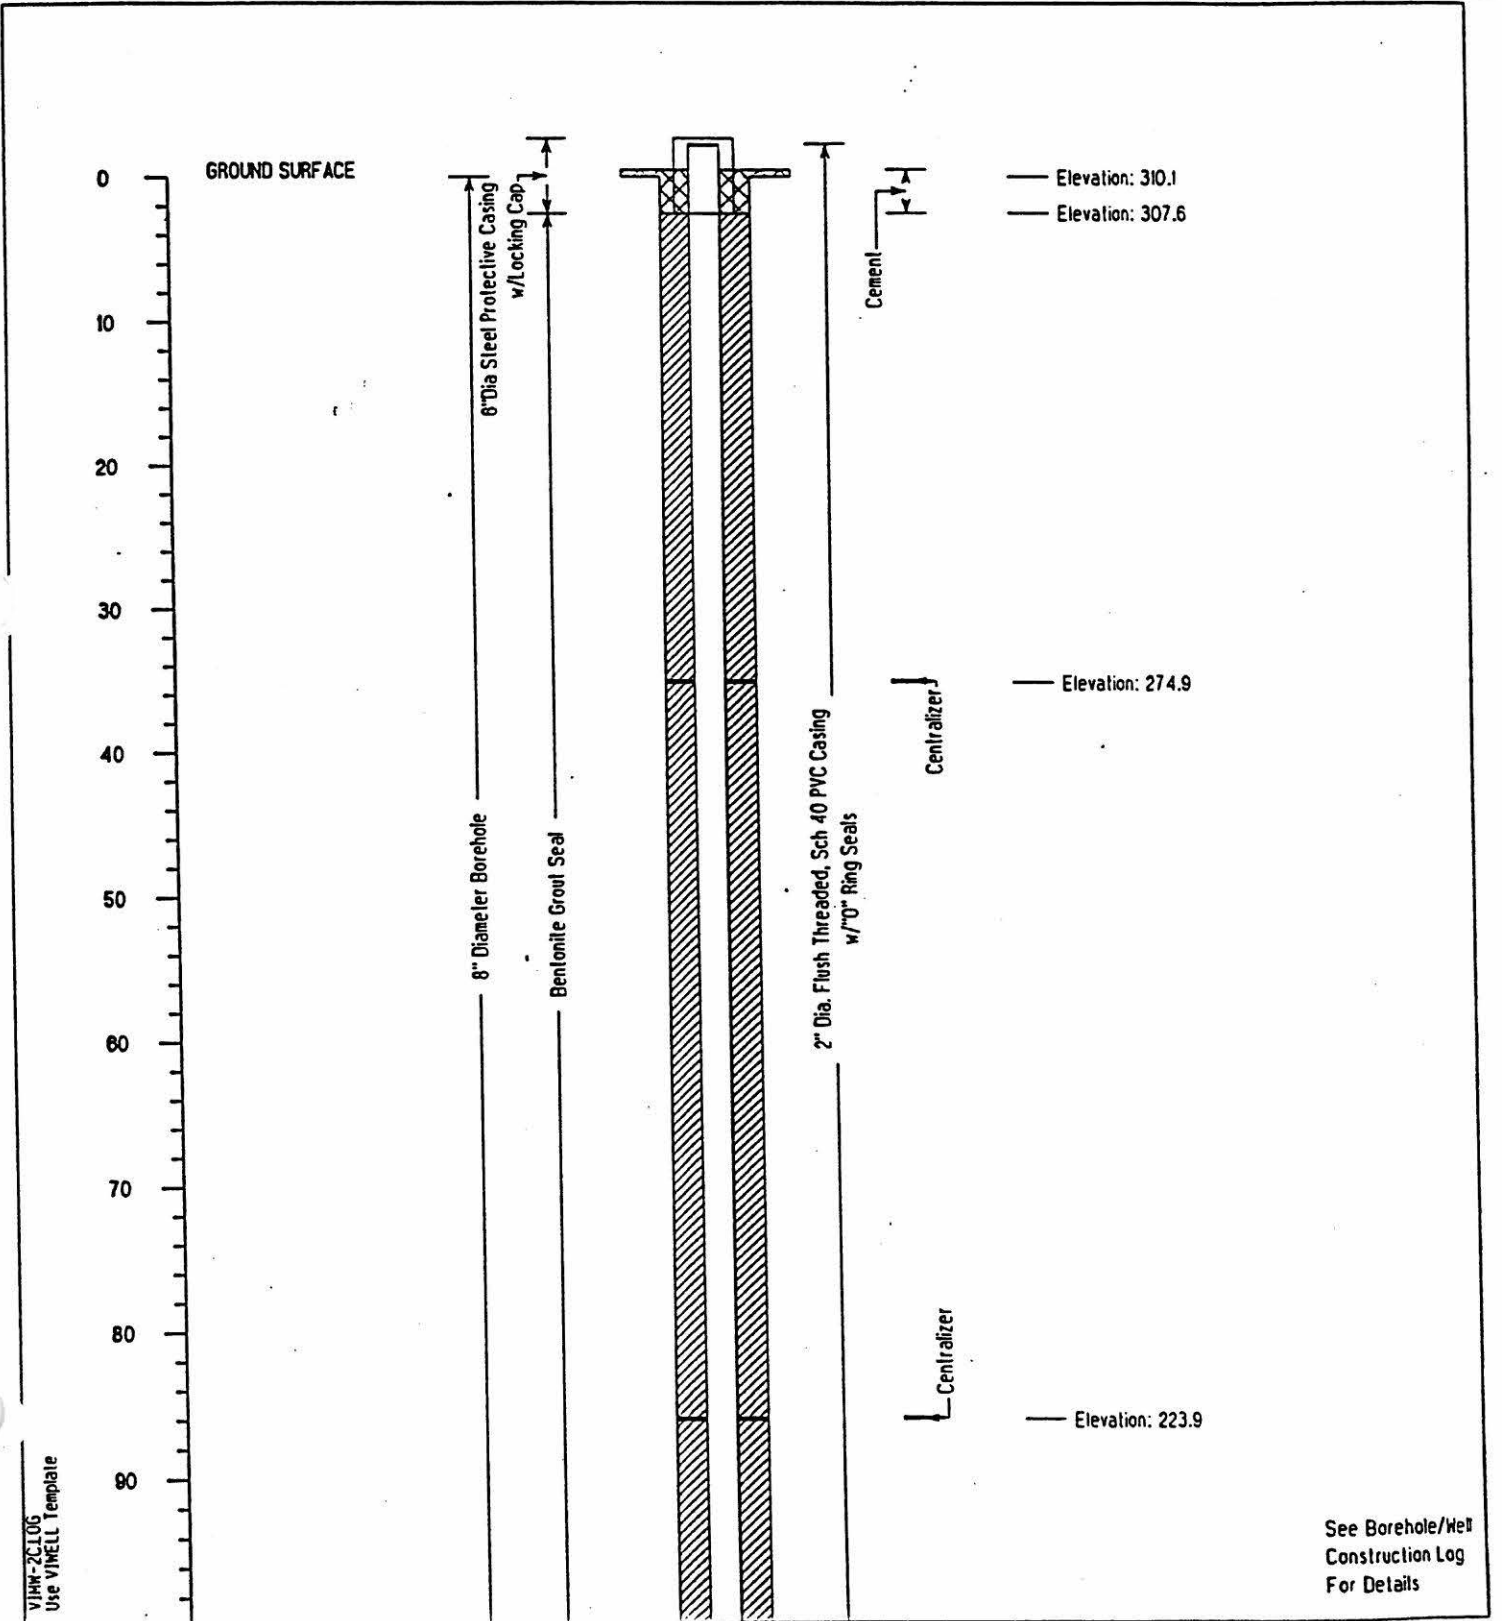



PROJECT NUMBER 106241.E3.27	BORING NUMBER MW-2C	Renumbered as MW-12
		SHEET 2 OF 4
WELL CONSTRUCTION SUMMARY		

PROJECT VASHON ISLAND LANDFILL	LOCATION N133.51, E2370.88
ELEVATION 310.12	DRILLING CONTRACTOR TACOMA PUMP & DRILLING INC.
DRILLING METHOD AND EQUIPMENT AIR ROTARY	
WATER LEVELS N/A	START 05/19/95 FINISH 05/26/95
	LOGGER T.O'CONNOR

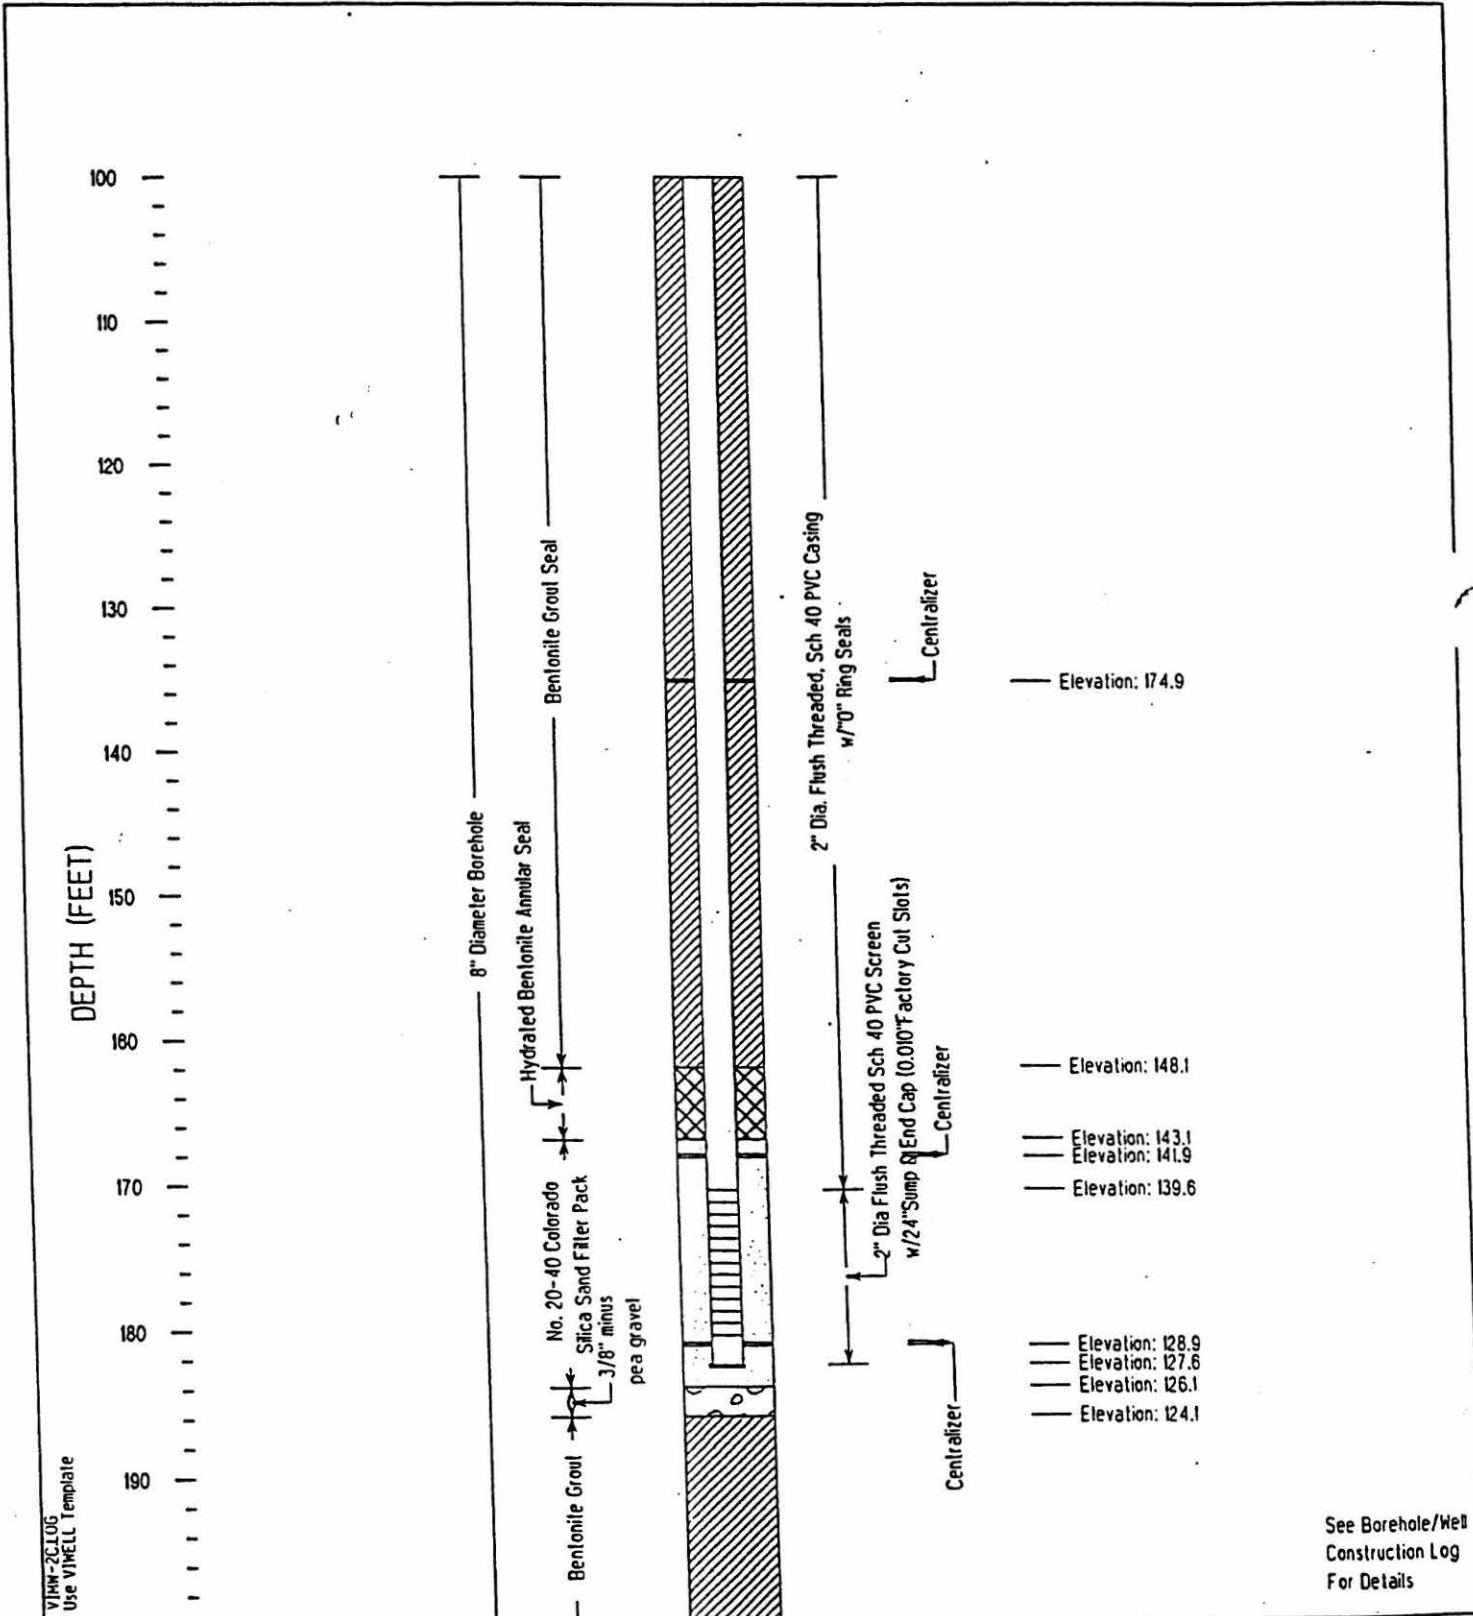


VHM-2C106  
Use VHMELL Template

See Borehole/Well Construction Log For Details



PROJECT NUMBER 106241E3.77	BORING NUMBER MW-2C	Renumbered as MW-12 SHEET 3 OF 4
WELL CONSTRUCTION SUMMARY		

PROJECT VASHON ISLAND LANDFILL LOCATION N133.51, E2370.88  
ELEVATION 310.12 DRILLING CONTRACTOR TACOMA PUMP & DRILLING INC.  
DRILLING METHOD AND EQUIPMENT AIR ROTARY  
WATER LEVELS N/A START 05/19/95 FINISH 05/26/95 LOGGER T.O'CONNOR

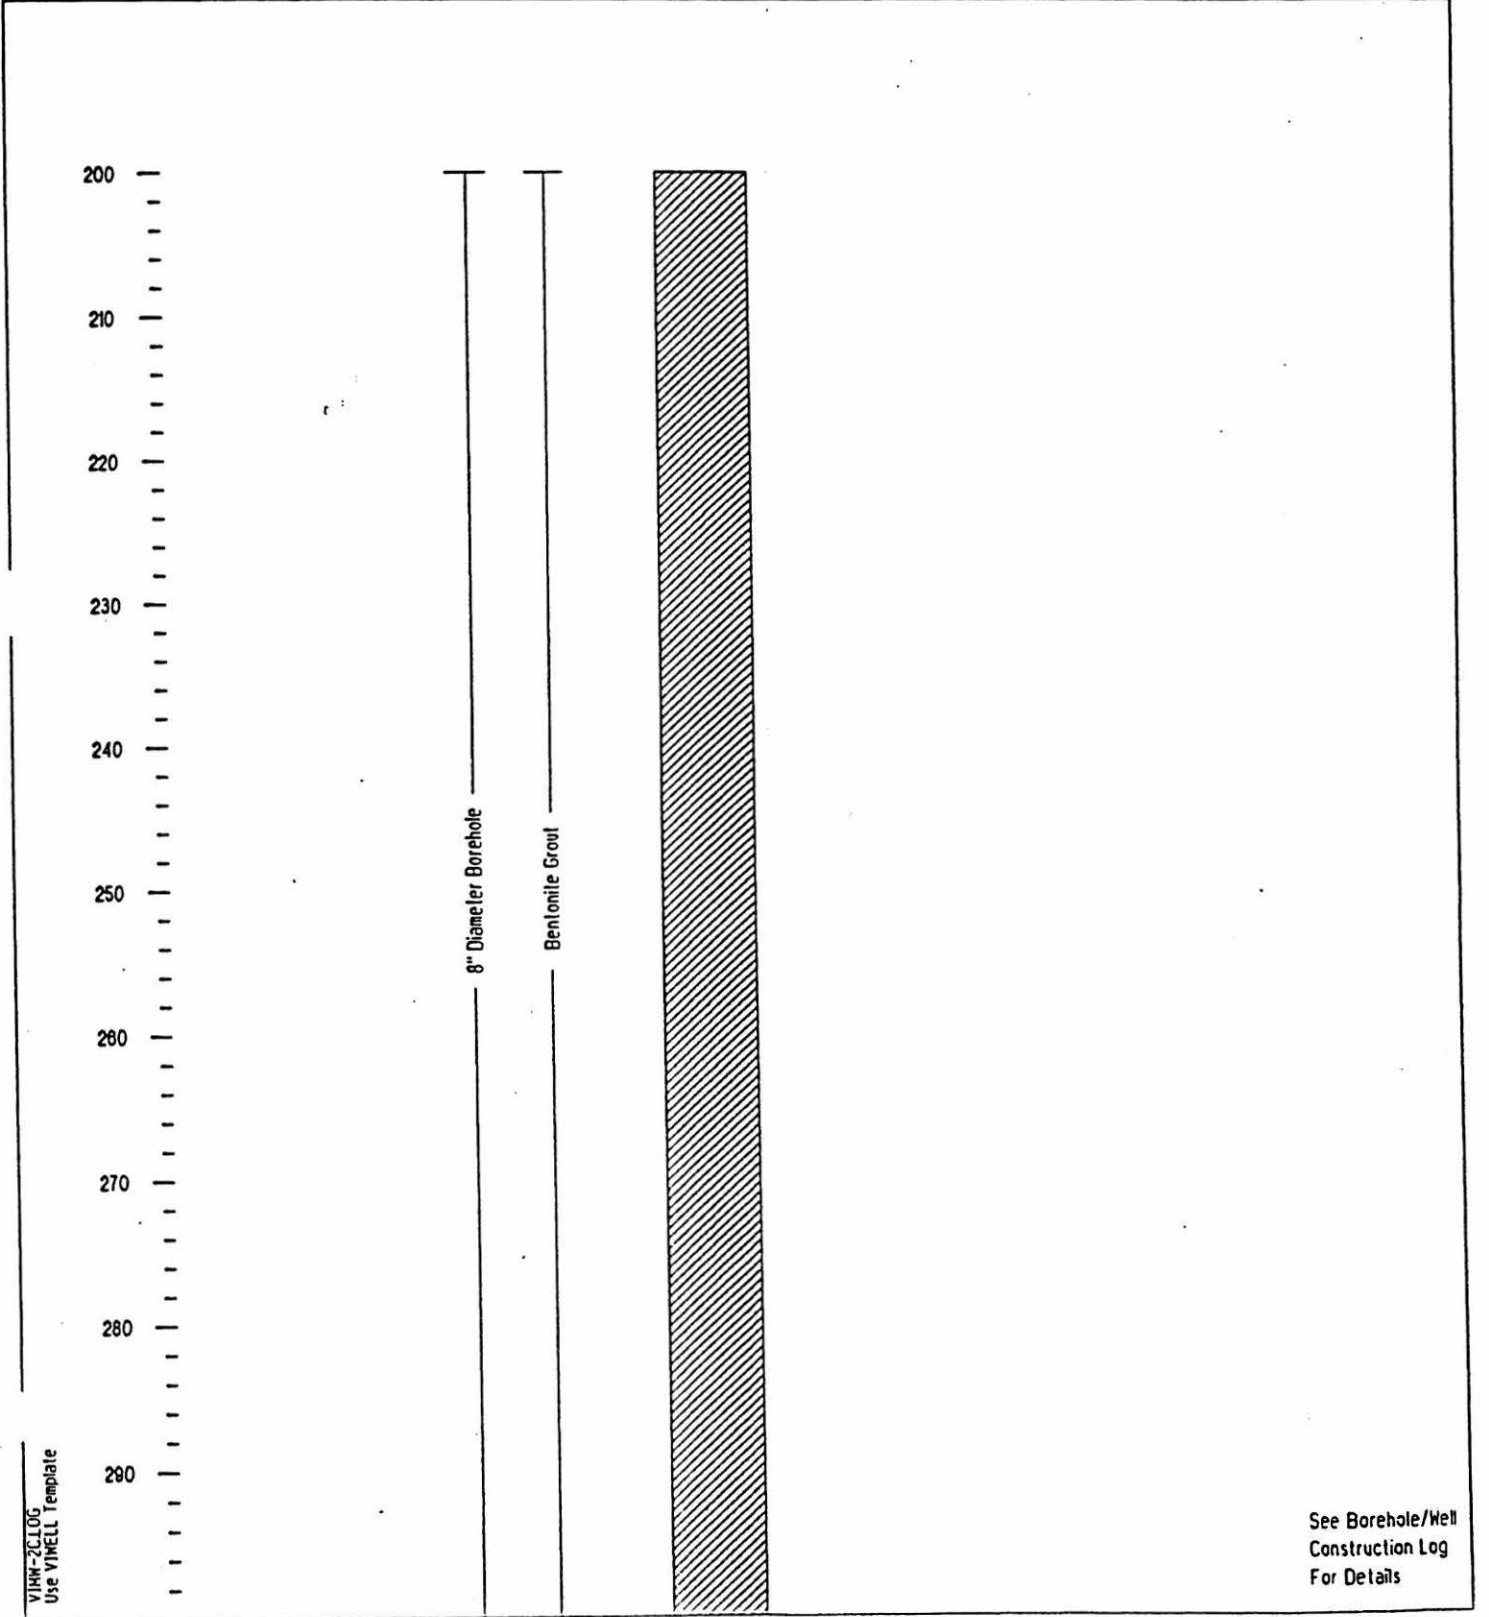


V10W-2C LOG  
Use V10WELL Template

See Borehole/Well  
Construction Log  
For Details



PROJECT NUMBER 106241.E3.77	BORING NUMBER MW-2C	Renumbered as MW-12
SHEET 4 OF 4		
WELL CONSTRUCTION SUMMARY		

PROJECT VASHON ISLAND LANDFILL LOCATION N133.51, E2370.88  
ELEVATION 310.12 DRILLING CONTRACTOR TACOMA PUMP & DRILLING INC.  
DRILLING METHOD AND EQUIPMENT AIR ROTARY  
WATER LEVELS N/A START 05/19/95 FINISH 05/26/95 LOGGER T.O'CONNOR

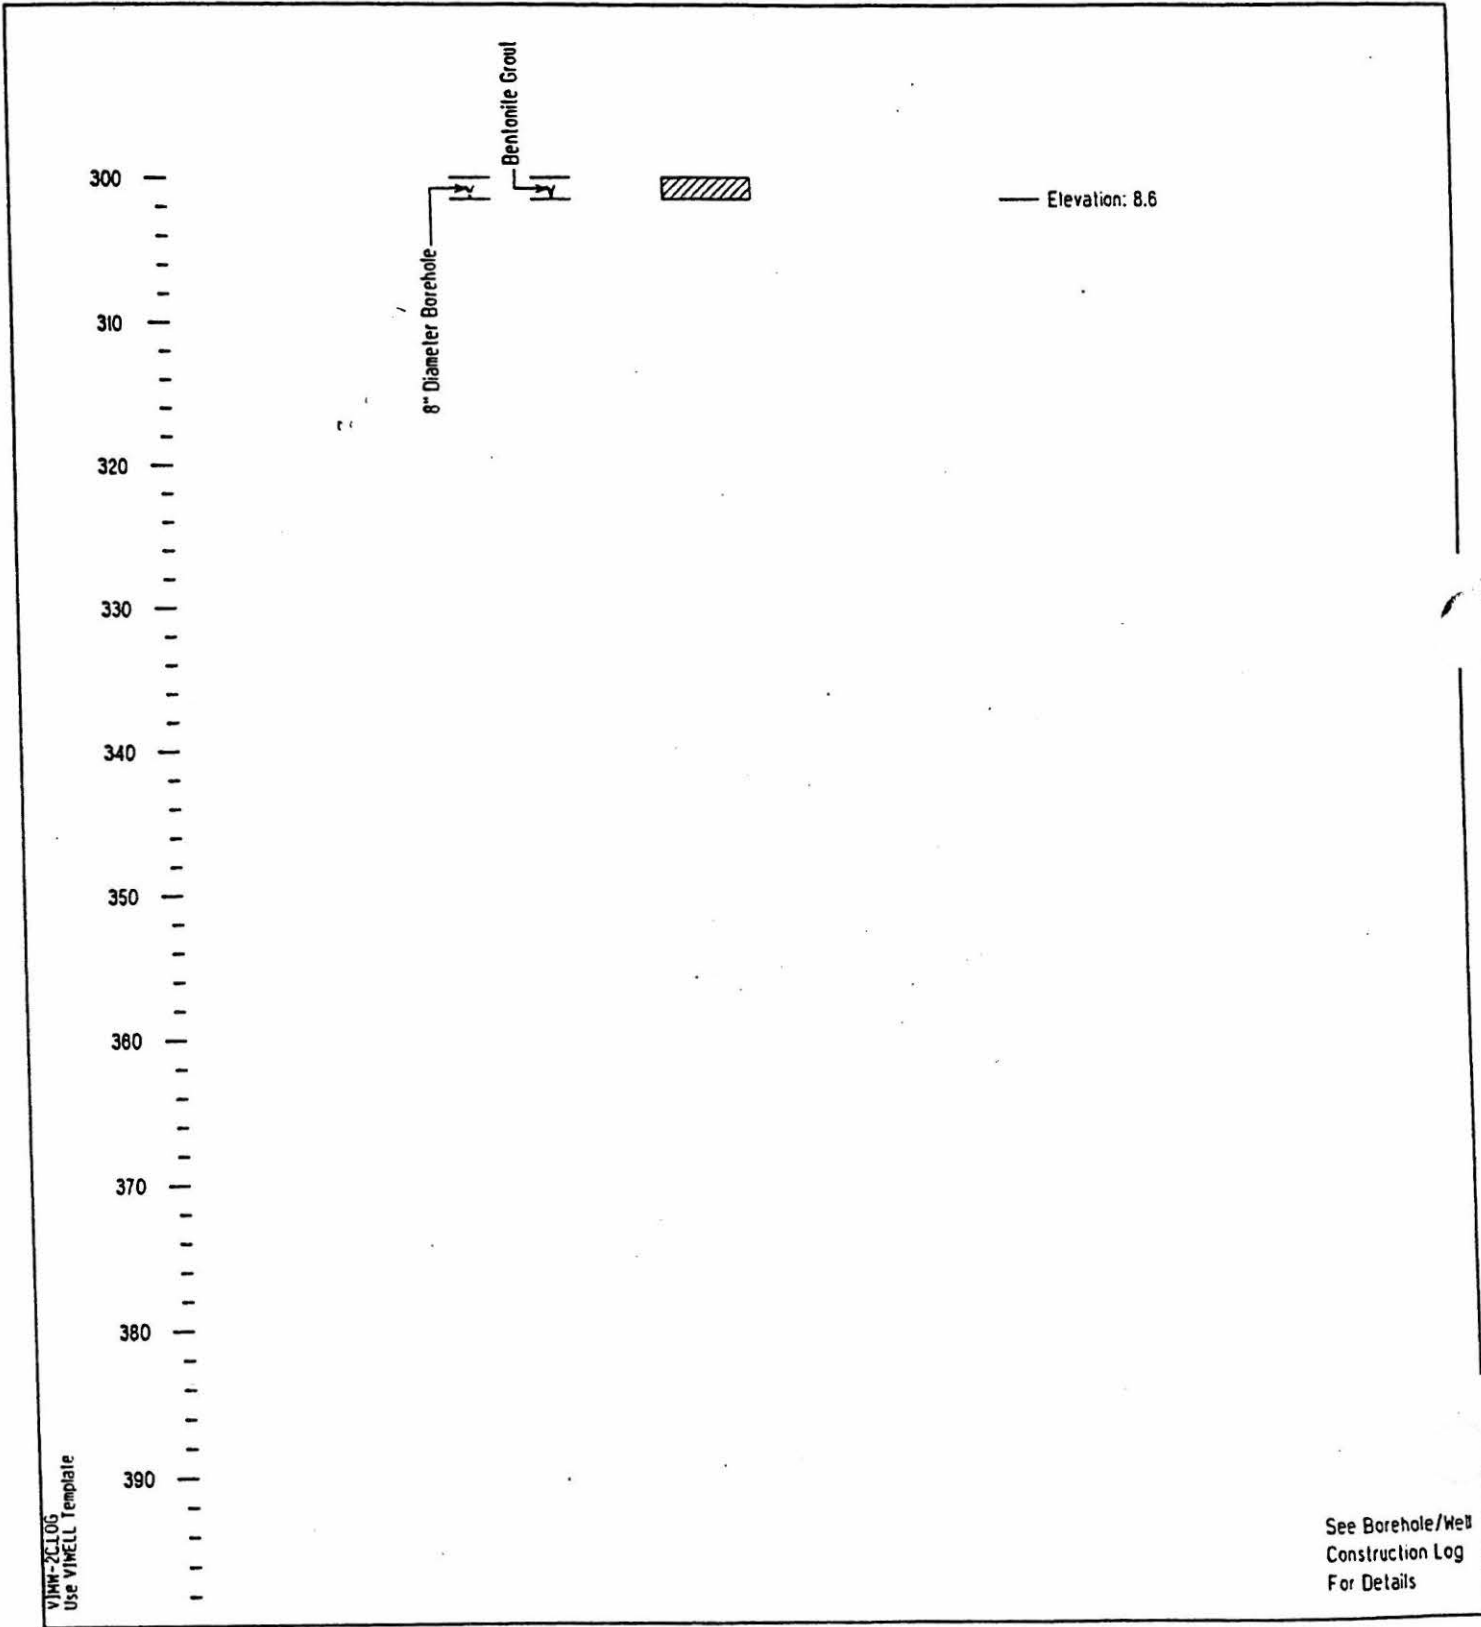

VJHW-2C LOG  
Use VJWELL Template

See Borehole/Well  
Construction Log  
For Details

# Boring No. P-3

N 614.2871  
E 2987.4369  
Top of PVC Elev.  
374.07

Logged by: CRL


1 of 3

Renumbered as MW-13

Dated: 4-22-92

Graph/ USCS	Soil Description	Consistency	Depth (ft.)	sample	(N) Blows (ft)	Water Content (%)	Well As-Built			
SM	Gray-brown, silty SAND, with gravel, moist, with seepage zones below 20 feet. (Till)	very dense	5	H	50/6"	9				
			10	H	50/6"	13				
			15	H	50/6"	12				
			20	H	50/3"	11				
			25	H	50/6"	10				
			30	H	50/4"	12				
			34		boulder at 34 feet					
			35	H	50/6"	10				
			SM/ SP	Gray-brown, silty to slightly silty medium SAND, dry to moist.	very dense	40		H	50/6"	8
						45		H	200/9"	—
50										

Continued

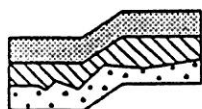

**TERRA  
ASSOCIATES**  
Geotechnical Consultants

Boring Log  
Vashon Landfill  
King County, Washington

Proj. No. T-1996

Date 7/92

Figure 4



# Boring No. P-3

2 of 3


Logged by: CRL

Dated: 4-22-92

Renumbered as MW-13

Graph/ USCS	Soil Description	Consistency	Depth (ft.)	sample	(N) Blows (ft)	Water Content (%)	Well As-Built
SM	Gray-brown, silty to slightly silty SAND, dry to moist.  (No methane or volatile organics noted during drilling)	very dense	55	II	50/5"	12	
			60	II	50/5"	7	
			65	II	50/6"	15	
			70	II	50/6"	11	
			75	II	50/5"	5	
			80	II	50/6"	8	
			85	II	50/6"	20	
			90	II	50/6"	24	
ML	Gray, fine sandy SILT dilatent, saturated.	very dense	95	II	50/6"	26	
			100				

Continued

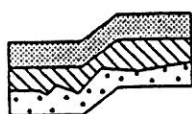

**TERRA  
ASSOCIATES**  
Geotechnical Consultants

Boring Log  
Vashon Landfill  
King County, Washington

Proj. No. T-1996

Date 7/92

Figure 5

# Boring No. P-3

3 of 3

Logged by: CRL

Dated: 4-22-92

Renumbered as MW-13

Graph/ USCS	Soil Description	Consistency	Depth (ft.)	Sample	(N) Blows (ft)	Water Content (%)	Well As-Built
SM	Gray fine to medium SAND with silt, saturated.	very dense		H	50/6"	22	
ML	Gray SILT with fine sand, saturated.	very dense	105	H	50/2"	31	
SM SP	Dark gray, medium SAND with silt, saturated.	very dense	110	H	50/6"	27	
ML	Gray SILT, slightly plastic	hard	115	H	50	32	

Total depth 115.5 feet

Well As-built:

2" 0.0200 PVC Screen placed from 113 to 108 feet.

Pea-gravel placed from 115 to 113 feet.


#8 Silica Sand placed from 113 to 106 feet.

Bentonite grout tremied to bottom of auger from 106 to 2 feet.

Upper 2 feet is concrete plug to hold surface casing.

(No methane or volatile organics noted during drilling of this well)

Survey data provided by King County Solid Waste Division.

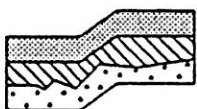

**TERRA  
ASSOCIATES**  
Geotechnical Consultants

Boring Log  
Vashon Landfill  
King County, Washington

Proj. No. T-1996

Date 7/92

Figure 6



PROJECT NUMBER 106241.E3.ZZ	BORING NUMBER MW-4B
Renumbered as MW-14	
SHEET 1 OF 2	
<b>BOREHOLE/WELL CONSTRUCTION LOG</b>	

PROJECT VASHON ISLAND LANDFILL LOCATION N713.05, E2126.69  
 ELEVATION 373.62 DRILLING CONTRACTOR TACOMA PUMP & DRILLING INC.  
 DRILLING METHOD AND EQUIPMENT AIR ROTARY  
 WATER LEVELS N/A START 06/19/95 FINISH 06/21/95 LOGGER T.O'CONNOR

DEPTH BELOW SURFACE (FT)	SAMPLE			STANDARD PENETRATION TEST RESULTS	SOIL DESCRIPTION	WELL COMPLETION DIAGRAM
	INTERVAL	TYPE AND NUMBER	RECOVERY	6" - 6" - 6" (N)	SOIL NAME, USCS GROUP SYMBOL, COLOR, MOISTURE CONTENT, RELATIVE DENSITY OR CONSISTENCY, SOIL STRUCTURE, MINERALOGY	
10.0					<u>SILTY SAND (SM)</u> , light brown, moist, firm, trace gravel	<p style="font-size: small;">6" Dia. Steel Protective Casing w/Locking Cap</p> <p style="font-size: small;">8" Diameter Borehole</p> <p style="font-size: small;">Cement Bentonite Groul Seal</p> <p style="font-size: small;">2" Dia. Flush Threaded, Sch. 40 PVC Casing w/"O" Ring Seals</p> <p style="font-size: small;">Cement</p> <p style="font-size: small;">Centralizer</p>
20.0	20 21.5	SS	1.2'	13-13-13		
30.0						
40.0	40 41.5	SS	1.0	30-50-4"	<u>POORLY GRADED SAND WITH SILT (SP-SM)</u>	
50.0						
60.0	60 61.5	SS	1.0'	13-30-40	<u>POORLY GRADED SAND (SP)</u> , moist, firm, very fine to fine grained	
70.0					<u>SILTY SAND (SM)</u> , olive, moist, firm	
80.0	80 82	SS	1.0'	15-25-25	<u>WELL GRADED SAND (SW)</u> , brown/tan, firm, moist	
90.0					<u>SILTY SAND (SM)</u> , olive, firm, moist	
100.0						

VHW-4B LOG  
Use WELLBORE TEMPLATE



## BOREHOLE/WELL CONSTRUCTION LOG


PROJECT VASHON ISLAND LANDFILL LOCATION N713.05, E2126.69  
 ELEVATION 373.62 DRILLING CONTRACTOR TACOMA PUMP & DRILLING INC.  
 DRILLING METHOD AND EQUIPMENT AIR ROTARY  
 WATER LEVELS N/A START 06/19/95 FINISH 06/21/95 LOGGER T.O'CONNOR

DEPTH BELOW SURFACE (FT)	SAMPLE			STANDARD PENETRATION TEST RESULTS 6" - 6" - 6" (N)	SOIL DESCRIPTION SOIL NAME, USCS GROUP SYMBOL, COLOR, MOISTURE CONTENT, RELATIVE DENSITY OR CONSISTENCY, SOIL STRUCTURE, MINERALOGY	WELL COMPLETION DIAGRAM DEPTH OF CASING, DRILLING RATE, DRILLING FLUID LOSS TESTS AND INSTRUMENTATION
	INTERVAL	TYPE AND NUMBER	RECOVERY			
109	SS	9"	75-40-45	SILT (ML), brown-gray, moist, firm, trace fine sand	<p style="position: absolute; left: 700px; top: 500px;">8" Diameter Borehole</p> <p style="position: absolute; left: 740px; top: 400px;">Cement Bentonite Grout Seal</p> <p style="position: absolute; left: 740px; top: 600px;">Hydrated Bentonite Annular Seal</p> <p style="position: absolute; left: 740px; top: 700px;">No. 20-40 Colorado Silica Sand Filter Pack</p> <p style="position: absolute; left: 890px; top: 400px;">2" Dia. Flush Threaded, Sch 40 PVC Casing w/"O" Rinn Seals</p> <p style="position: absolute; left: 930px; top: 650px;">Centralizer</p> <p style="position: absolute; left: 930px; top: 800px;">Centralizer</p> <p style="position: absolute; left: 930px; top: 900px;">2" Dia. Flush Thred. Sch 40 PVC Screen - Factory Cut Slot(s)</p> <p style="position: absolute; left: 930px; top: 950px;">Pump &amp; End Cap</p>	
120-121.5	SS	1.0'	15-30-50/5"	SILTY SAND, olive, moist, firm		
140-141.5	SS	0.6"	9-30-45	SILT (ML), brown, moist, trace sand, plastic,		
160-161	SS	9"		POORLY GRADED SAND WITH SILT (SP-SM), olive, moist, firm SILTY SAND (SM), gray, moist to wet, firm, trace pea gravel		
180-181.4	SS	11"	10-30-50/5"	SILT (ML), gray, moist to wet, firm, dense to very dense, trace wood chips SILTY SAND (SM), gray, moist, firm SAND AND GRAVEL, brown, moist, firm, gravel up to 1" diameter		
TOTAL DEPTH = 181.4 FEET						



PROJECT NUMBER 106241.E3.77	BORING NUMBER MW-4R	Renumbered as MW-14
SHEET 1 OF 2		
WELL CONSTRUCTION SUMMARY		


PROJECT VASHON ISLAND LANDFILL LOCATION N713.05. E2126.69  
ELEVATION 373.62 DRILLING CONTRACTOR TACOMA PUMP & DRILLING INC.  
DRILLING METHOD AND EQUIPMENT AIR ROTARY  
WATER LEVELS N/A START 06/19/95 FINISH 06/21/95 LOGGER T.O'CONNOR

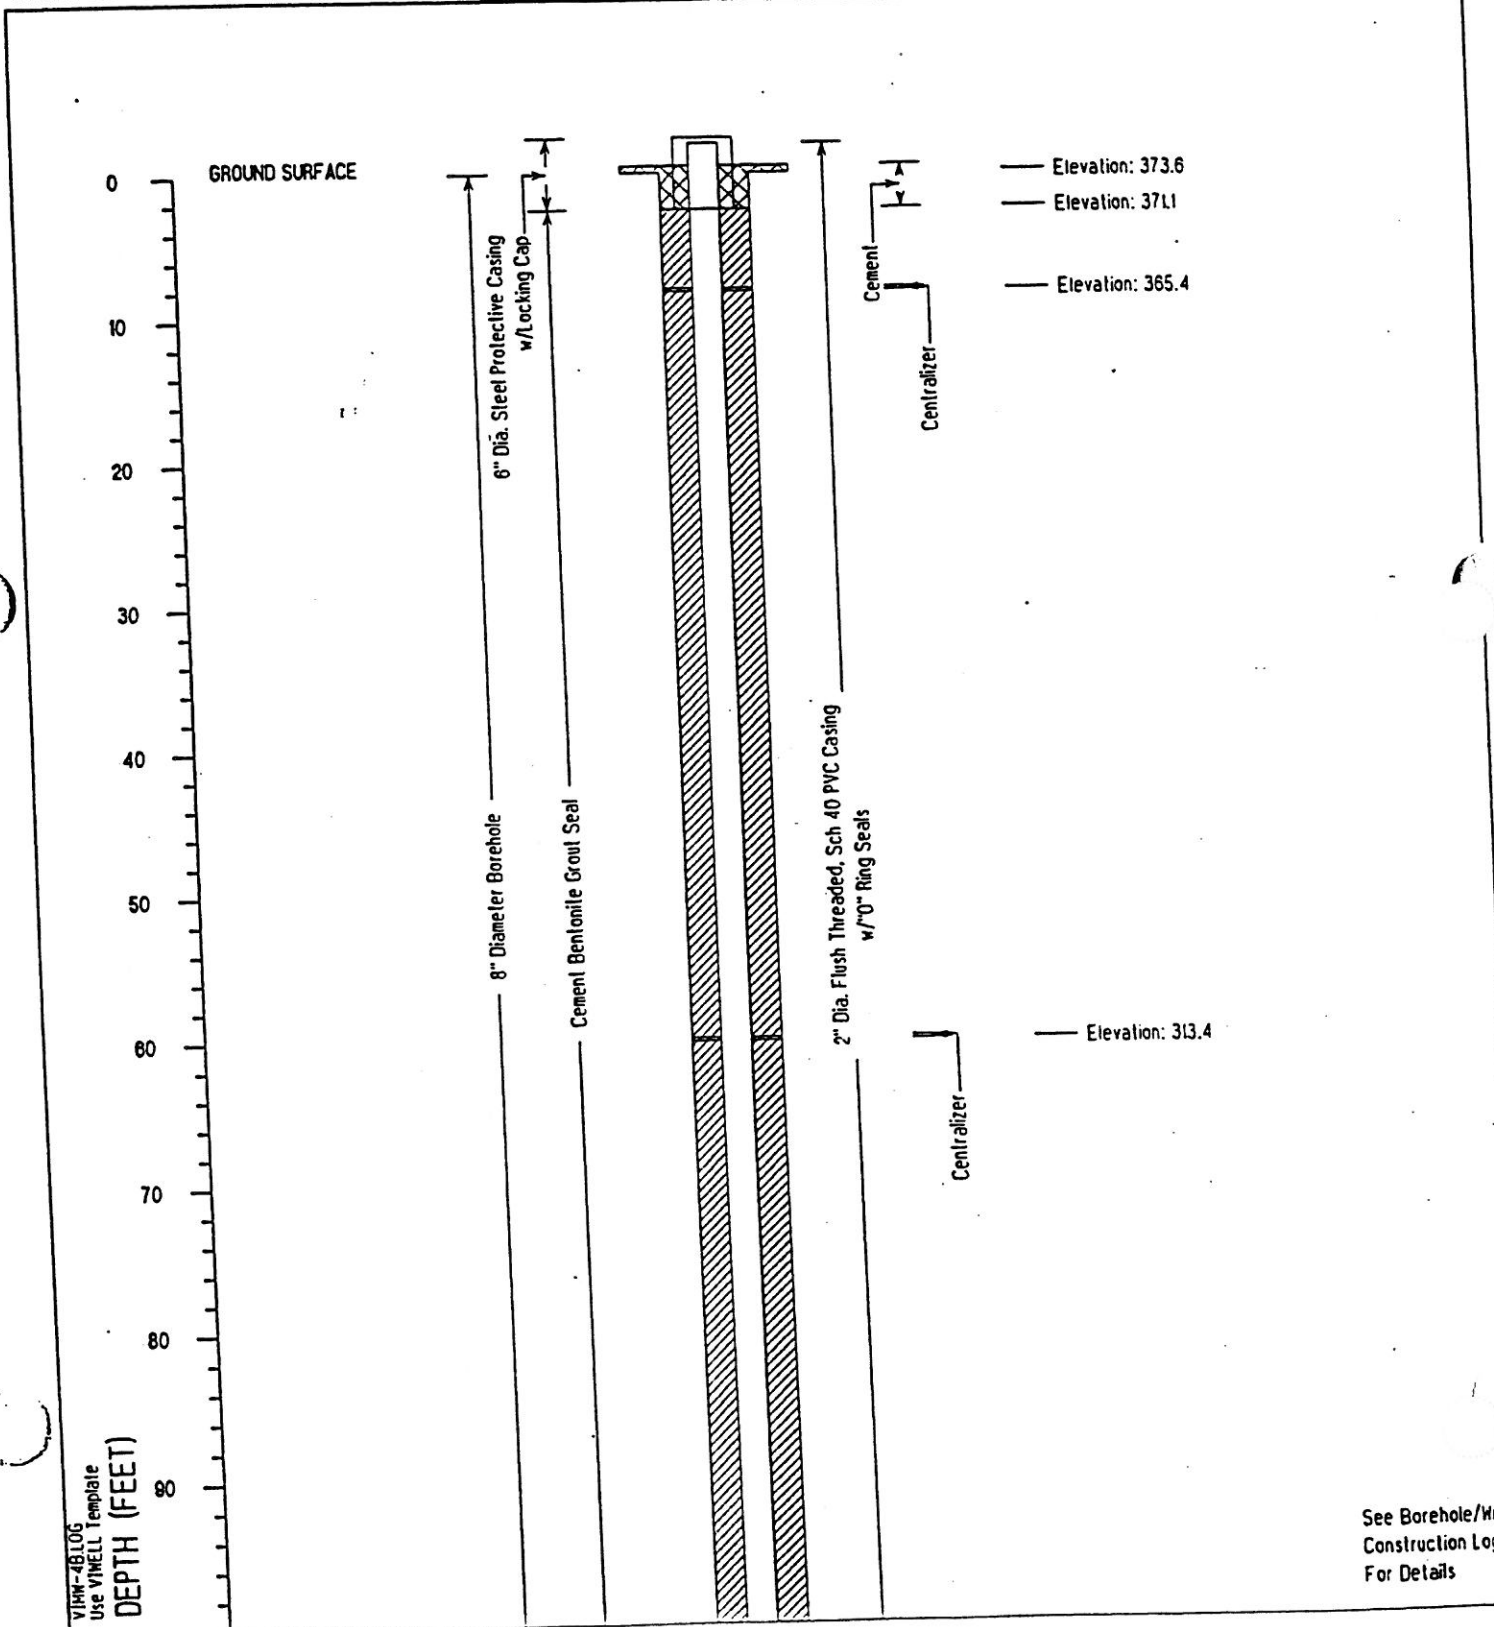



PROJECT NUMBER 106241E3.77	BORING NUMBER MW-4B	Renumbered as MW-14
SHEET 2 OF 2		
<b>WELL CONSTRUCTION SUMMARY</b>		

PROJECT VASHON ISLAND LANDFILL LOCATION N713.05, E2126.69  
ELEVATION 373.62 DRILLING CONTRACTOR TACOMA PUMP & DRILLING INC.  
DRILLING METHOD AND EQUIPMENT AIR ROTARY  
WATER LEVELS N/A START 06/19/95 FINISH 06/21/95 LOGGER T.O'CONNOR

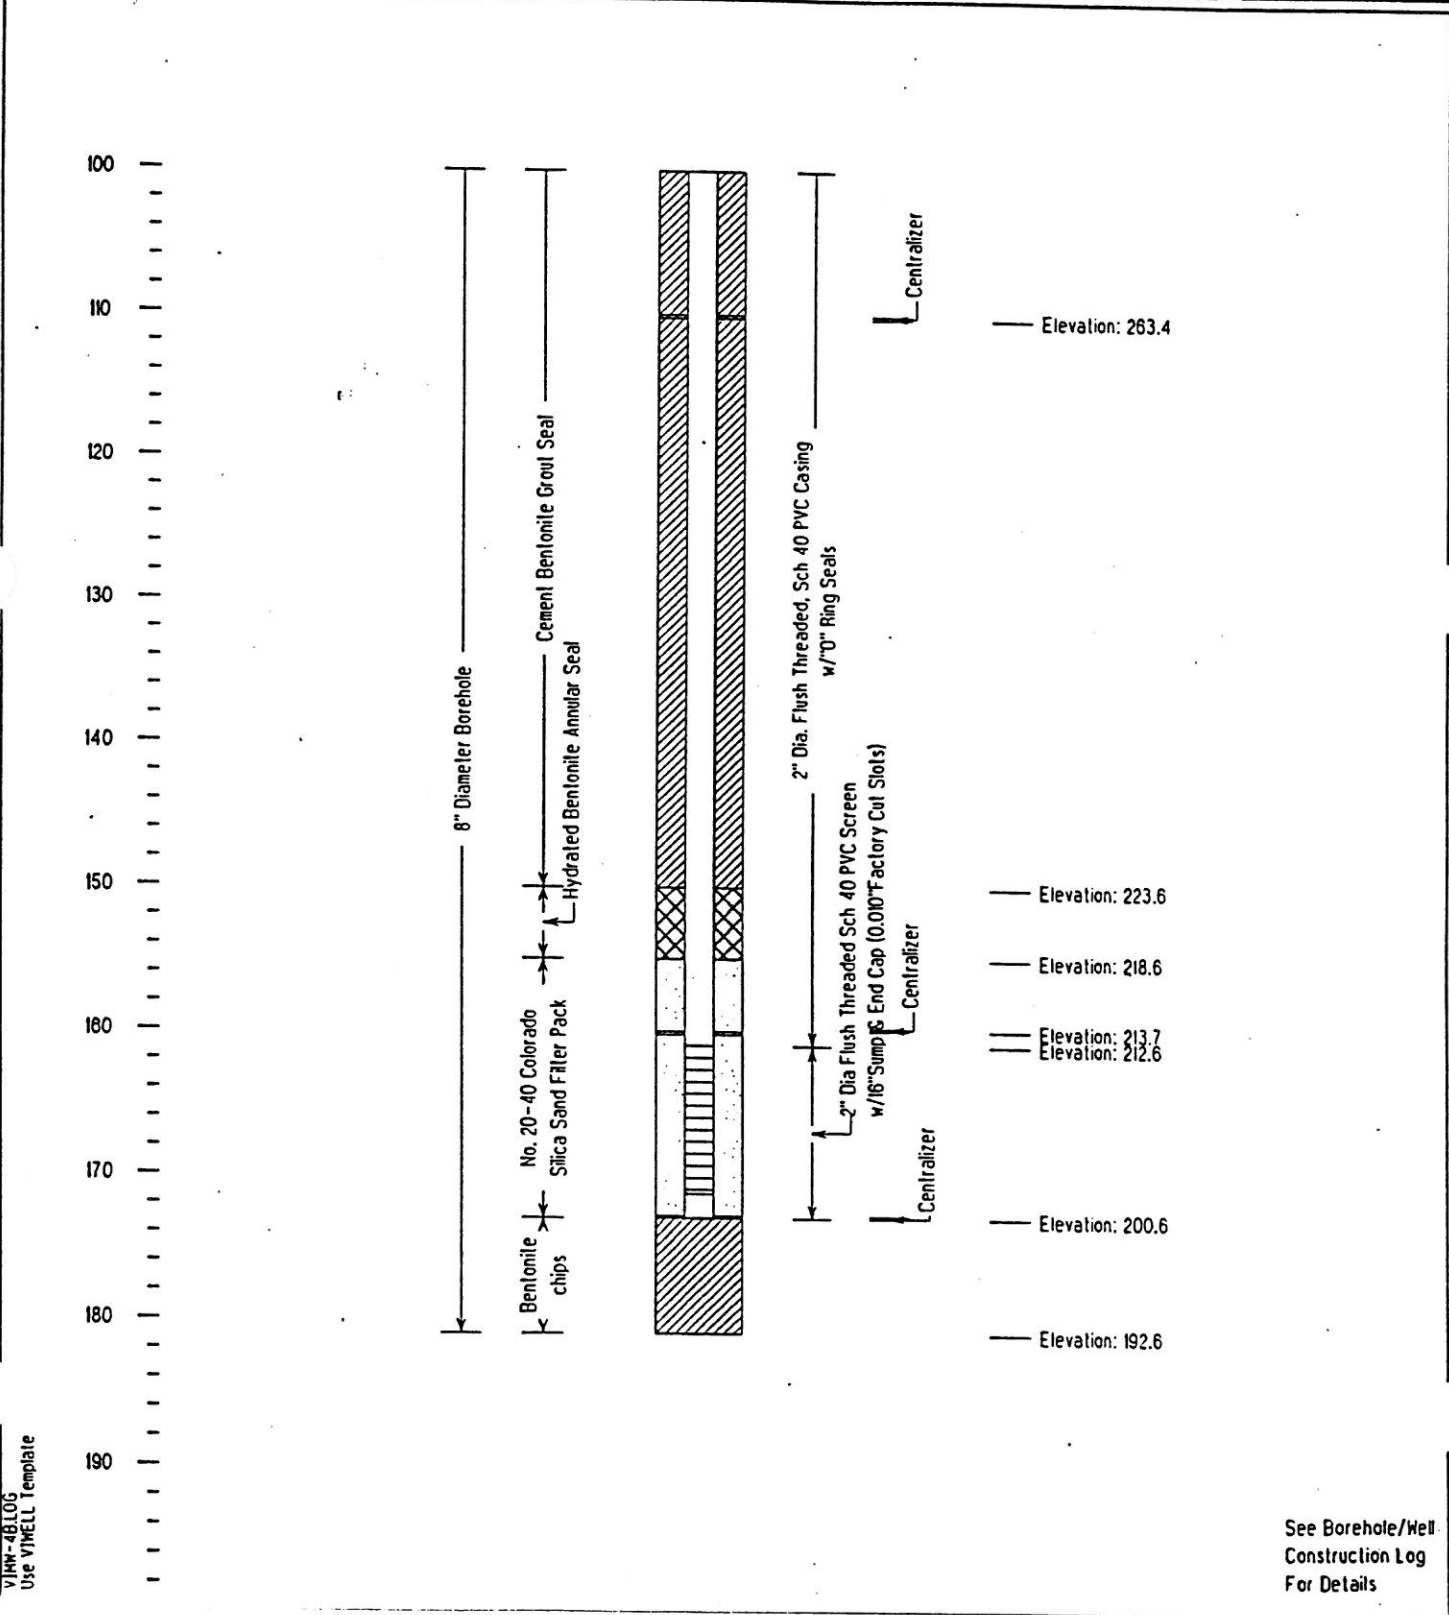

VJHW-4B LOG  
Use VINELL Template

See Borehole/Well Construction Log For Details



PROJECT NUMBER 106241.E3.ZZ	BORING NUMBER MW-9C
Renumbered as MW-19	
SHEET 1 OF 4	
<b>BOREHOLE/WELL CONSTRUCTION LOG</b>	

PROJECT VASHON ISLAND LANDFILL LOCATION NI283.59, E2268.63  
 ELEVATION 400.64 DRILLING CONTRACTOR TACOMA PUMP & DRILLING INC.  
 DRILLING METHOD AND EQUIPMENT AIR ROTARY  
 WATER LEVELS N/A START 06/01/95 FINISH 06/12/95 LOGGER T.O'CONNOR

DEPTH BELOW SURFACE (FT)	SAMPLE			STANDARD PENETRATION TEST RESULTS  6" - 6" - 6" (N)	SOIL DESCRIPTION  SOIL NAME, USCS GROUP SYMBOL, COLOR, MOISTURE CONTENT, RELATIVE DENSITY OR CONSISTENCY, SOIL STRUCTURE, MINERALOGY	WELL COMPLETION DIAGRAM
	INTERVAL	TYPE AND NUMBER	RECOVERY			
10.0					SILTY SAND, (SM) brown, moist, firm, trace pea gravel	<p style="font-size: small;">8" Dia. Steel Protective Casing w/ Locking Cap</p> <p style="font-size: small;">8" Diameter Borehole</p> <p style="font-size: small;">Bentonite Grout Seal</p> <p style="font-size: small;">2" Dia. Flush Threaded, Sch 40 PVC Casing w/ "O" Ring Seals</p> <p style="font-size: small;">Cement</p>
20.0	20				Gravel up to 1" diameter	
	21	SS	6"	50/4"		
40.0	40				POORLY GRADED SAND, (SP) brown, moist, firm, trace silt, trace gravel, up to 1" in diameter	
	41	SS	1.2	80/6" 100/1"	SILTY SAND, (SM) brown, moist, firm, trace gravel; OVA=1000; CGI=0	
50.0					POORLY GRADED SAND, (SP) gray to light brown, moist, firm	
					WELL GRADED SAND, (SW) gray to light brown, moist, firm	
60.0	60				POORLY GRADED SAND WITH SILT AND GRAVEL, (SP-SM) olive, moist, firm; OVA=20; CGI=0	
	61	SS	1.0	35-50/6-50/3"		
80.0	80				POORLY GRADED SAND WITH SILT, (SP-SM), olive, moist, firm	
	81	SS	1.0	25-35-50/5"		
100						

VIMW-9C.LOG  
Use WELLSBORE Template



PROJECT NUMBER 106241.E3.ZZ	BORING NUMBER MW-9C
Renumbered as MW-19	
SHEET 2 OF 4	
<b>BOREHOLE/WELL CONSTRUCTION LOG</b>	

PROJECT VASHON ISLAND LANDFILL LOCATION N1283.59, E2268.63  
 ELEVATION 400.64 DRILLING CONTRACTOR TACOMA PUMP & DRILLING INC.  
 DRILLING METHOD AND EQUIPMENT AIR ROTARY  
 WATER LEVELS N/A START 06/01/95 FINISH 06/12/95 LOGGER T.O'CONNOR

DEPTH BELOW SURFACE (FT)	SAMPLE			STANDARD PENETRATION TEST RESULTS  6" -6" -6" (N)	SOIL DESCRIPTION  SOIL NAME, USCS GROUP SYMBOL, COLOR, MOISTURE CONTENT, RELATIVE DENSITY OR CONSISTENCY, SOIL STRUCTURE, MINERALOGY	WELL COMPLETION DIAGRAM			
	INTERVAL	TYPE AND NUMBER	RECOVERY			DEPTH OF CASING	DRILLING RATE	DRILLING FLUID LOSS	TESTS AND INSTRUMENTATION
100.0 110.0 120.0 130.0 140.0 150.0 160.0 170.0 180.0 190.0 200.0	100 101	SS	1.5	10-25-40	<p><u>SILT</u>, (ML) olive, moist, brittle Red iron oxide deposit .1" thick with wood/fine sand, no silt</p> <p><u>SILTY SAND</u>, (SM), olive, moist, firm</p>	<div style="display: flex; justify-content: space-around;"> <div style="border-left: 1px solid black; border-right: 1px solid black; width: 100%; height: 100%;"></div> <div style="border-left: 1px solid black; border-right: 1px solid black; width: 100%; height: 100%;"></div> <div style="border-left: 1px solid black; border-right: 1px solid black; width: 100%; height: 100%;"></div> <div style="border-left: 1px solid black; border-right: 1px solid black; width: 100%; height: 100%;"></div> <div style="border-left: 1px solid black; border-right: 1px solid black; width: 100%; height: 100%;"></div> </div>	<p>8" Diameter Borehole</p> <p>Bentonite Grout Seal</p> <p>2" Dia. Flush Threaded, Sch 40 PVC Casing w/"O" Ring Seals</p>		
	120 121	SS	1.5	3-3-10	<p><u>SILT</u>, (ML) grayish brown, moist, firm, plastic</p>				
	140 141	SS	1.0	7-25-40	<p><u>POORLY GRADED SAND WITH GRAVEL</u>, (GP) gray, moist, firm, pea size gravel</p>				
	160 161	SS	8"		<p><u>POORLY GRADED GRAVEL</u>, moist, firm, size gravel</p>				
	180 181	SS	1'	15-35-35	<p><u>FAT CLAY</u>, (CL) dark gray, dry, brittle, massive</p>				
	190 200								

VIMW-9C LOG  
 Use WELLBORE TAG plate





PROJECT NUMBER 106241.E3.ZZ	BORING NUMBER MW-9C	Renumbered as MW-19
		SHEET 3 OF 4
<b>BOREHOLE/WELL CONSTRUCTION LOG</b>		

PROJECT VASHON ISLAND LANDFILL LOCATION N1283.59, E2268.63  
 ELEVATION 400.64 DRILLING CONTRACTOR TACOMA PUMP & DRILLING INC.  
 DRILLING METHOD AND EQUIPMENT AIR ROTARY  
 WATER LEVELS N/A START 06/01/95 FINISH 06/12/95 LOGGER T.O'CONNOR

DEPTH BELOW SURFACE (FT)	SAMPLE			STANDARD PENETRATION TEST RESULTS 6" - 6" - 6" (N)	SOIL DESCRIPTION SOIL NAME, USCS GROUP SYMBOL, COLOR, MOISTURE CONTENT, RELATIVE DENSITY OR CONSISTENCY, SOIL STRUCTURE, MINERALOGY	WELL COMPLETION DIAGRAM DEPTH OF CASING, DRILLING RATE TESTS AND INSTRUMENTATION
	INTERVAL	TYPE AND NUMBER	RECOVERY			
200.0 - 210.0	200-201	SS	1'	5-35-50/5"	SILTY SAND WITH GRAVEL, (SM) dark gray, moist, firm	
210.0 - 220.0	220-221	SS	.4"	10-15-50/5"	SILTY GRAVEL WITH SAND, (GM) dark gray, moist, firm, dense, gravel up to 1" diameter	
220.0 - 230.0	240-241	SS	.5'	25-75/6"	POORLY GRADED GRAVEL WITH SILT AND SAND, (GP-SM) dark grayish brown, moist, firm, large cobbles up to 3" diameter	
230.0 - 240.0					POORLY GRADED SAND WITH SILT, (SP-SM) dark gray, moist to wet, firm	
240.0 - 250.0	260-261	SS	.5'	1-1-1	SILT, (ML) gray, dense, moist SILTY SAND, (SM) dark gray, moist, firm	
250.0 - 260.0						
260.0 - 270.0						
270.0 - 280.0	280-281	SS	1.0	1-1-1	SILT, (ML) dark gray, firm, very dense	
280.0 - 290.0						
290.0 - 300.0						

VINW-9C.LUG  
Use WELLBORE



PROJECT NUMBER 106241E3.ZZ	BORING NUMBER MW-9C	Renumbered as MW-19
SHEET 4 OF 4		
<b>BOREHOLE/WELL CONSTRUCTION LOG</b>		

PROJECT VASHON ISLAND LANDFILL LOCATION N1283.59, E2268.63  
 ELEVATION 400.64 DRILLING CONTRACTOR TACOMA PUMP & DRILLING INC.  
 DRILLING METHOD AND EQUIPMENT AIR ROTARY  
 WATER LEVELS N/A START 06/01/95 FINISH 06/12/95 LOGGER T.O'CONNOR

DEPTH BELOW SURFACE (FT)	SAMPLE			STANDARD PENETRATION TEST RESULTS 6" -6" -6" (N)	SOIL DESCRIPTION	WELL COMPLETION DIAGRAM
	INTERVAL	TYPE AND NUMBER	RECOVERY			
300.0	300-301	SS	1.2	25-90/6"	<u>SILT</u> , (ML) dark gray, firm, dense, brittle, moist, dry, non-plastic	
310.0				<u>SILTY SAND</u> , (SM) gray, moist, firm		
320.0	320-321	SS	1.5	1-1-5	<u>SILT</u> , (ML) dark gray, firm, dense, moist, semi-plastic <u>SILTY SAND</u> , (SM) wet to moist, firm, very fine grained black, sand with pumice, with interlayers of brown to dark gray <u>SILT</u> (ML)	
330.0				<u>SILTY SAND</u> , (SM) brown, saturated, firm, very fine sand to fine sand, white pumice material <u>WOOD CHIPS</u> , trace white pumice		
340.0	340-341	SS	1.0	7-13-19	<u>SAND</u> , (SW) well graded, moist to wet, firm, black to black brown, sand medium grained, trace pumice, trace wood fragments, large up 1" long, grading coarser <u>SILTY SAND</u> , (SM) dark brown, wet, firm	
350.0						
360.0	359-360	SS	1.1	8-12-16	<u>POORLY GRADED SAND WITH SILT</u> , (SP-SM) dark gray, firm, wet TOTAL DEPTH = 360 FEET	
370.0						
380.0						
390.0						

VIM-9C LOG Use WELLSHORE TEMPLATE



PROJECT NUMBER

106241.E3.77

BORING NUMBER

MW-9C

Renumbered as MW-19

SHEET 1 OF 4

# WELL CONSTRUCTION SUMMARY

PROJECT VASHON ISLAND LANDFILL

LOCATION N1283.59, E2268.63

ELEVATION 400.64

DRILLING CONTRACTOR TACOMA PUMP & DRILLING INC.


DRILLING METHOD AND EQUIPMENT AIR ROTARY

WATER LEVELS N/A

START 06/01/95

FINISH 06/12/95


LOGGER T.O'CONNOR

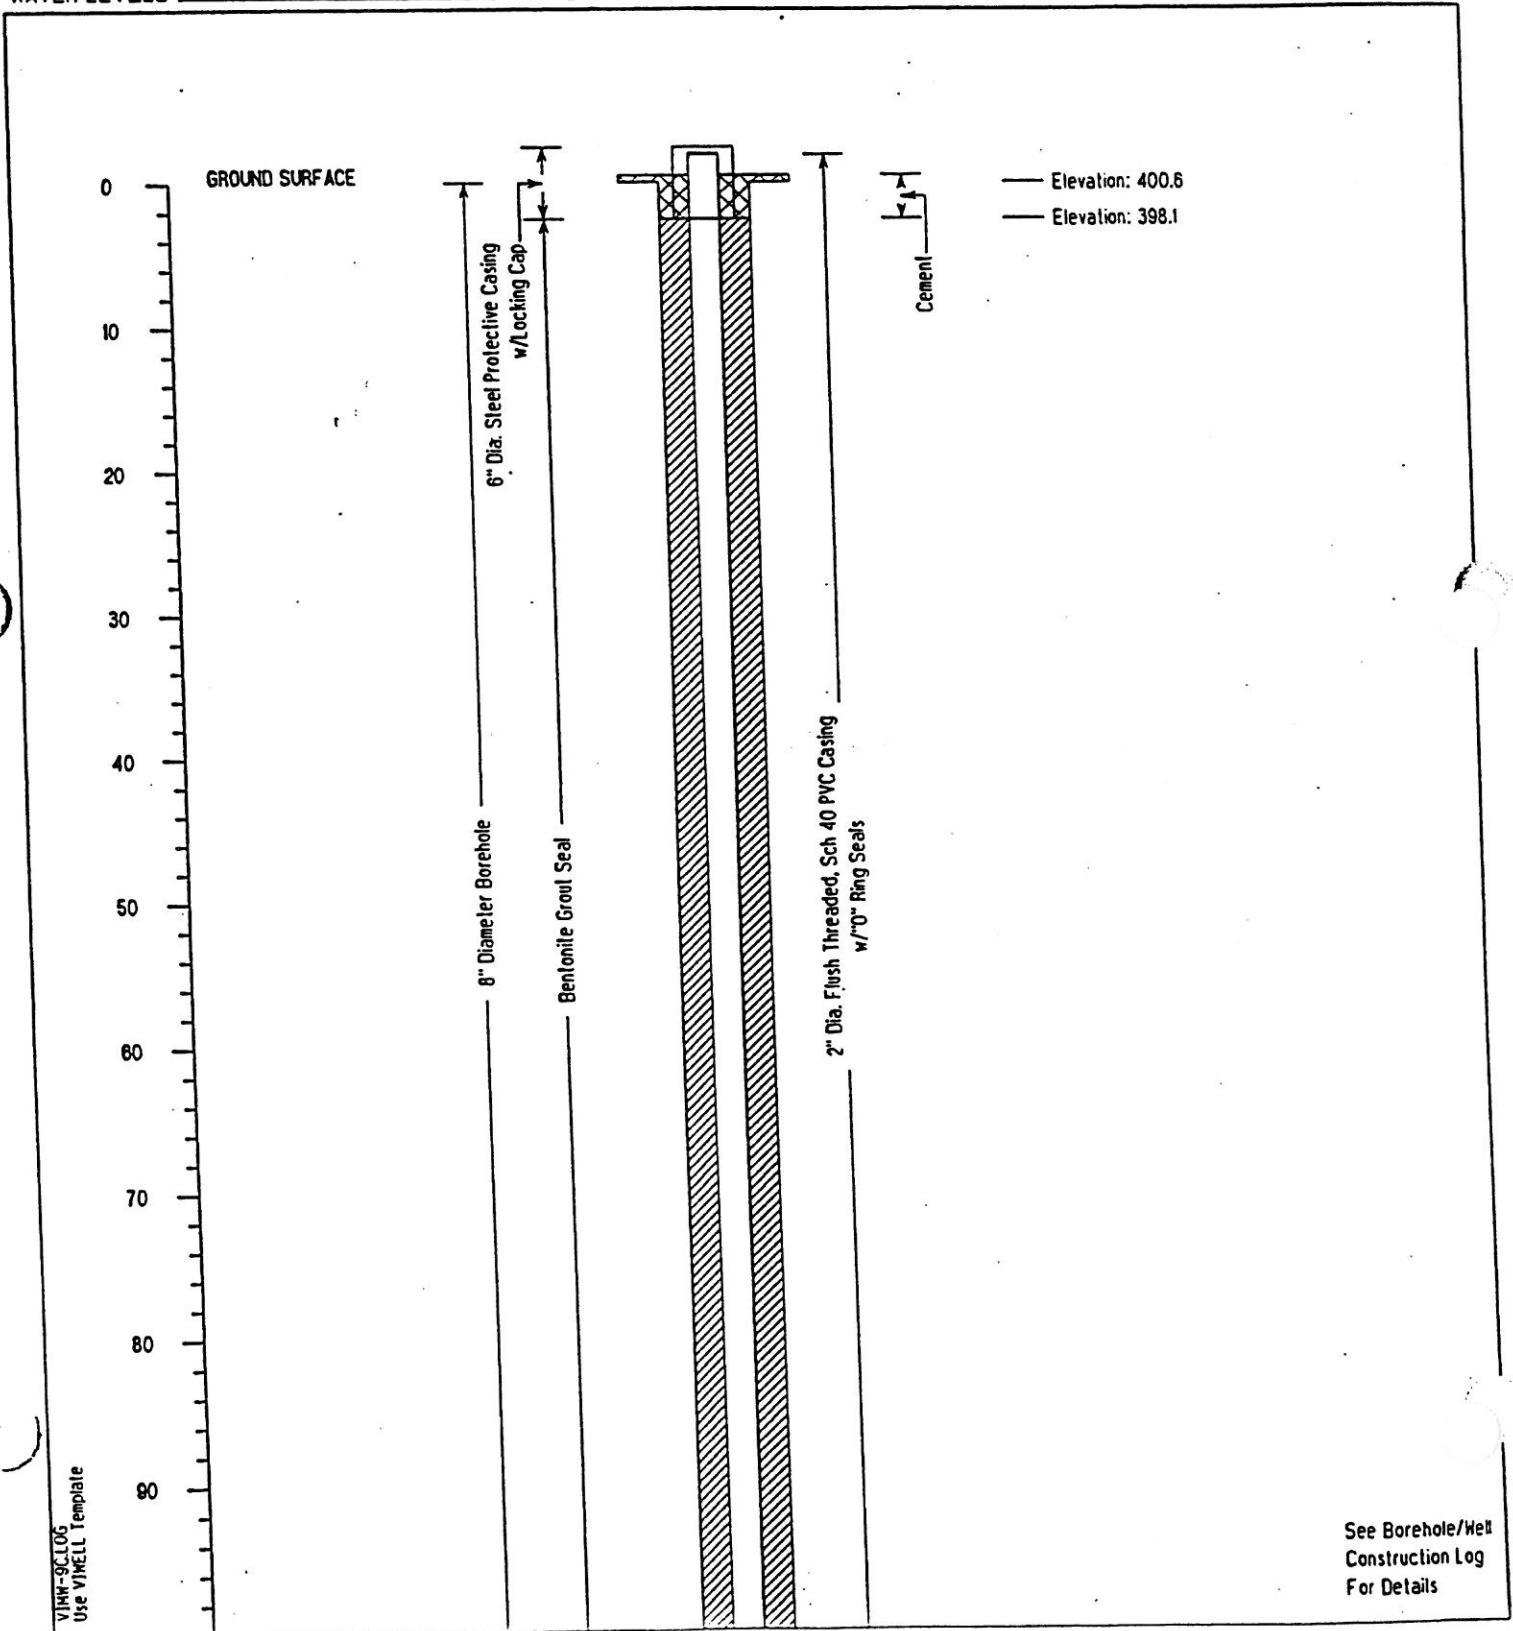



PROJECT NUMBER 105241.E3.77	BORING NUMBER MW-9C	Renumbered as MW-19
SHEET 2 OF 4		
WELL CONSTRUCTION SUMMARY		

PROJECT VASHON ISLAND LANDFILL LOCATION N1283.59, E2268.63  
ELEVATION 400.64 DRILLING CONTRACTOR TACOMA PUMP & DRILLING INC.  
DRILLING METHOD AND EQUIPMENT AIR ROTARY  
WATER LEVELS N/A START 06/01/95 FINISH 06/12/95 LOGGER T.O'CONNOR

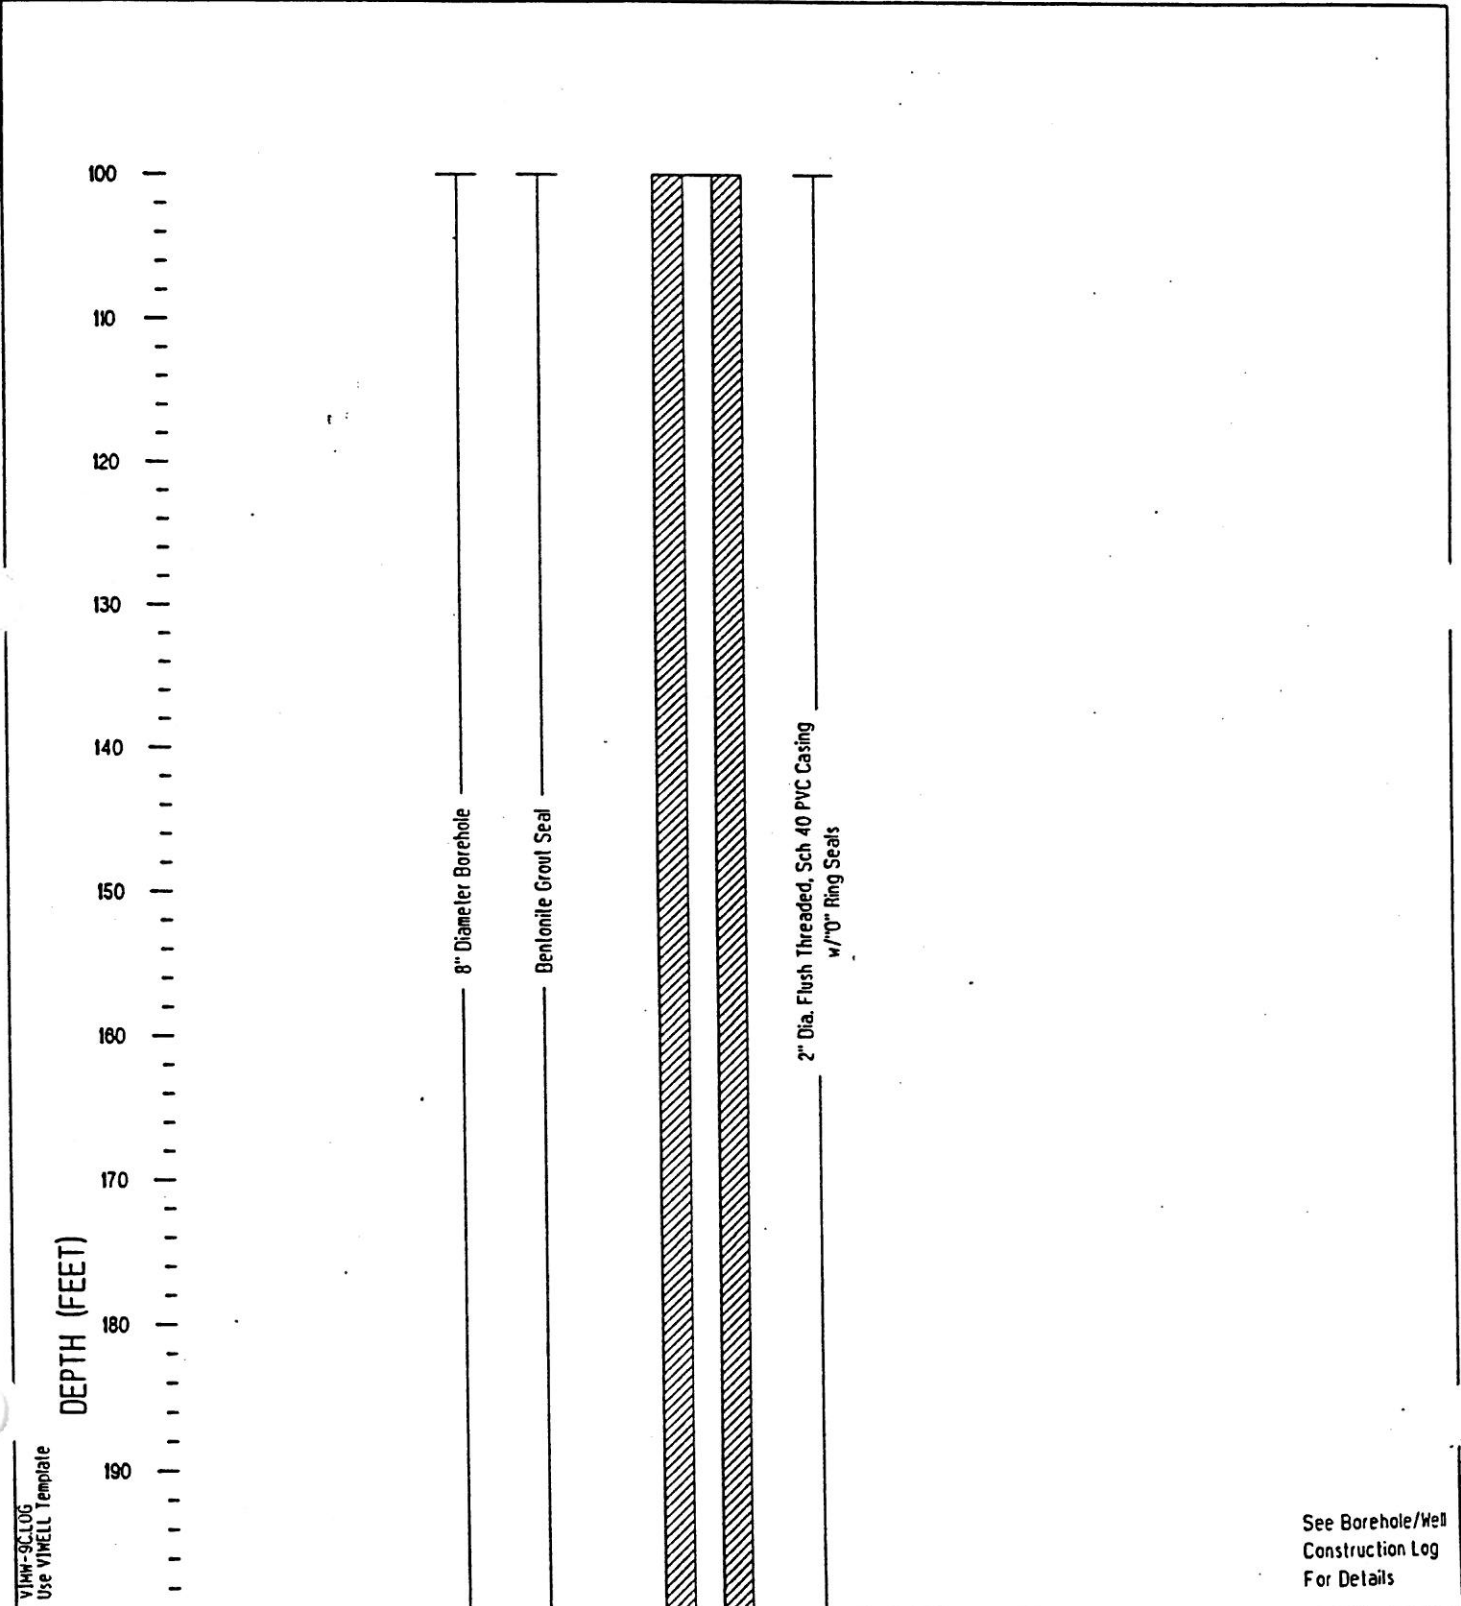



PROJECT NUMBER

106241.E3.77

BORING NUMBER

MW-9C

Renumbered as MW-19

SHEET 3 OF 4

# WELL CONSTRUCTION SUMMARY

PROJECT VASHON ISLAND LANDFILL

LOCATION N1283.59, E2268.63

ELEVATION 400.64

DRILLING CONTRACTOR TACOMA PUMP & DRILLING INC.


DRILLING METHOD AND EQUIPMENT AIR ROTARY

WATER LEVELS N/A

START 06/01/95

FINISH 06/12/95

LOGGER T.O'CONNOR

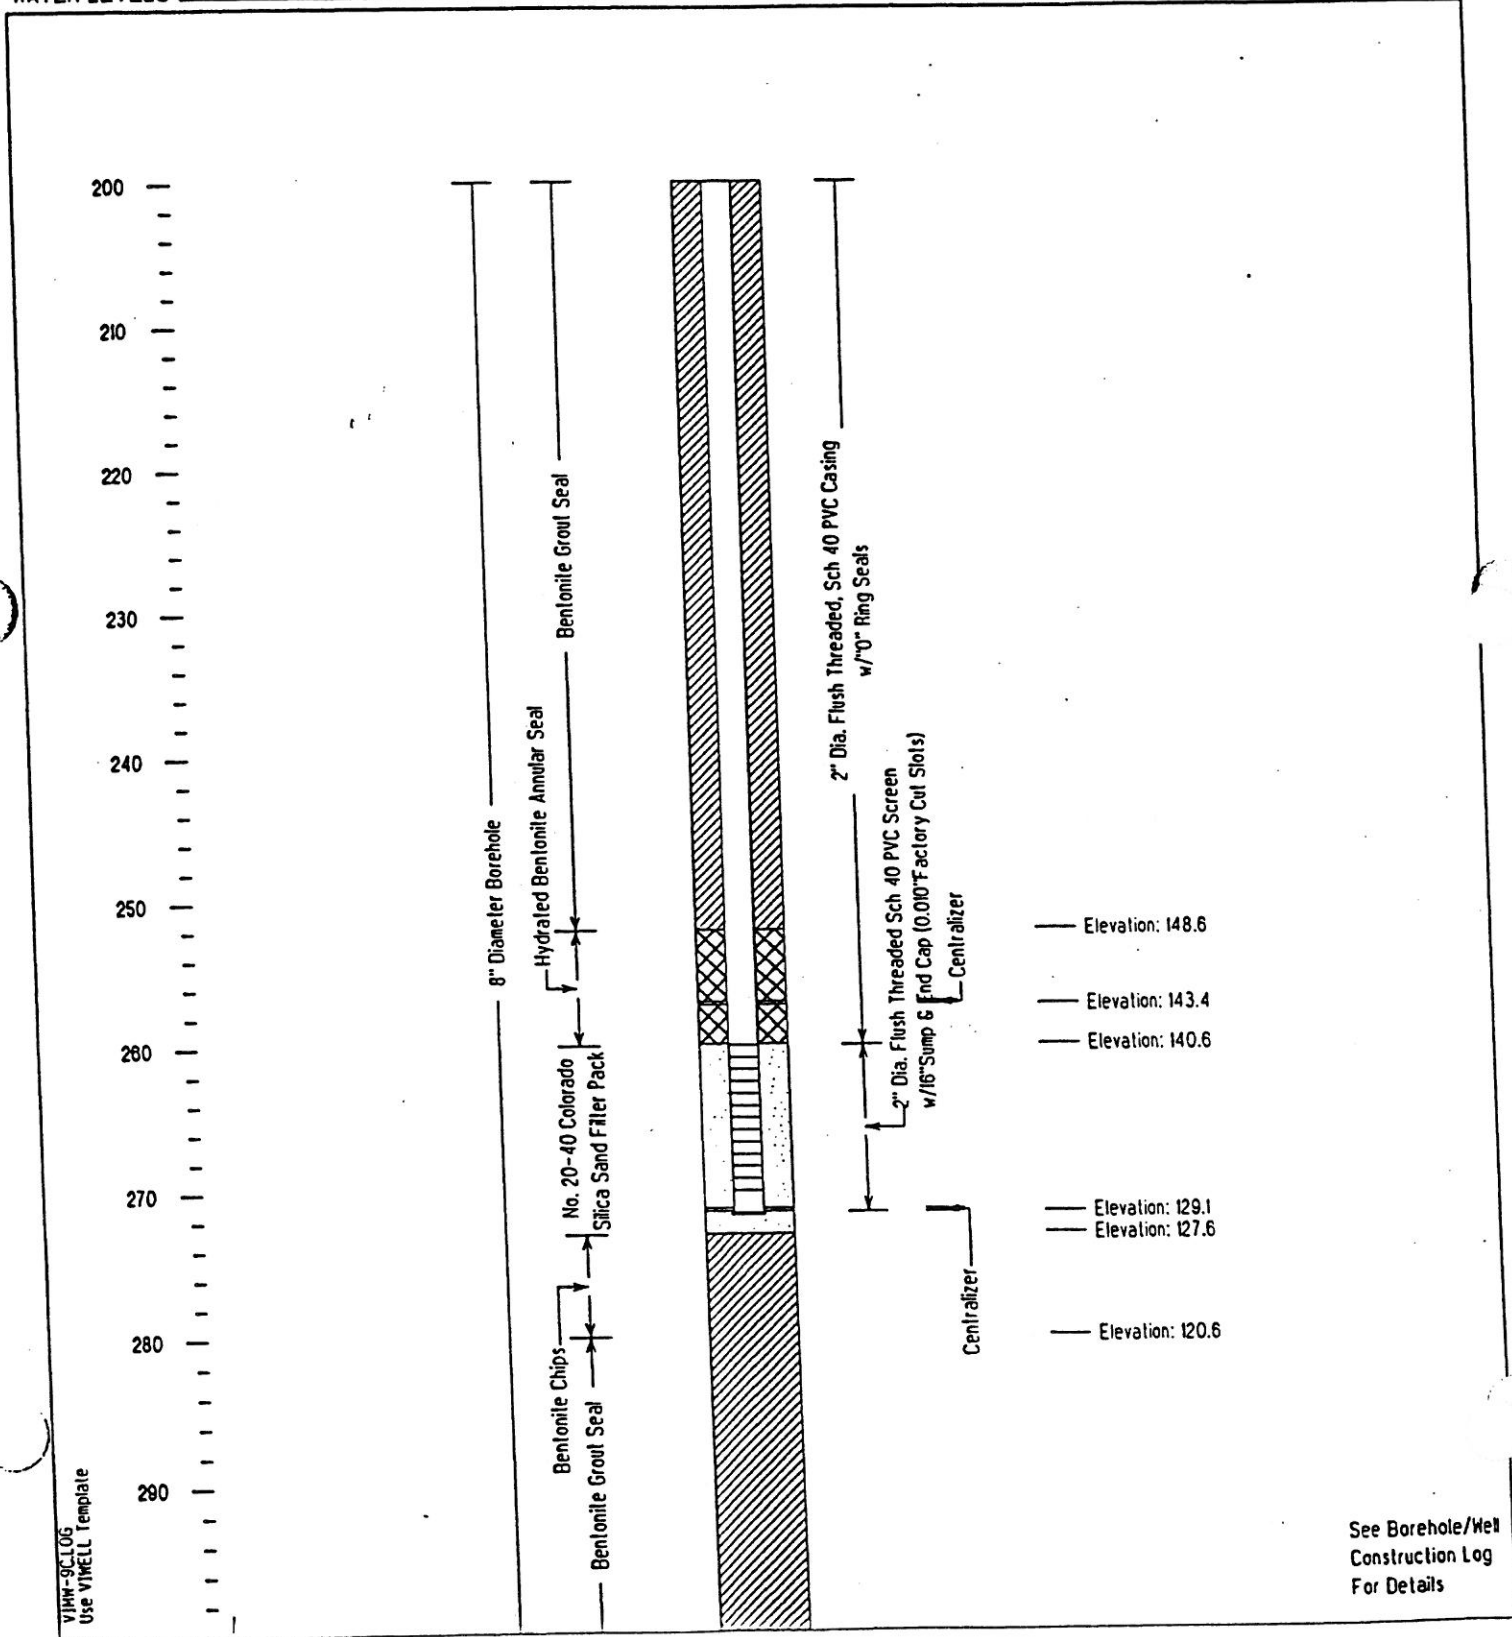

VIMW-9C.L05  
Use VIMWELL Template

See Borehole/Well  
Construction Log  
For Details


# EXPLANATION OF SYMBOLS ON EXPLORATORY BORING LOGS

## SAMPLE COLUMN



SAMPLE INTERVAL (Attempted)

## WELL DETAILS COLUMN

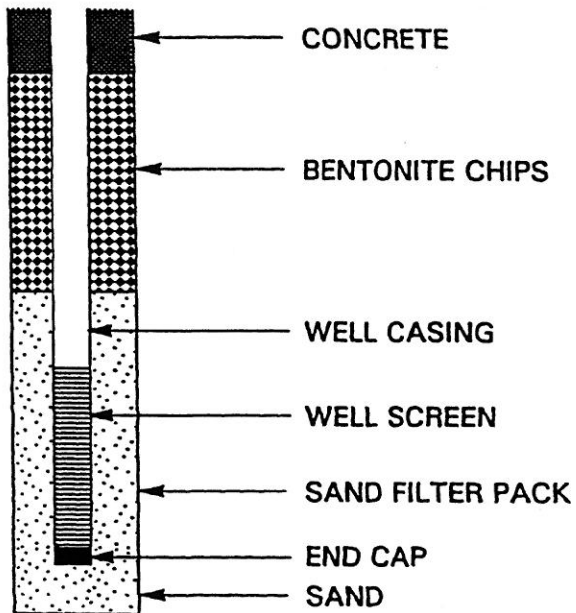

## WATER LEVELS

- ▽ LEVEL AT TIME OF DRILLING
- ▼ LEVEL AT SPECIFIED DATE

## LITHOLOGIC COLUMN




GW

GP

GM or GP-GM

GC

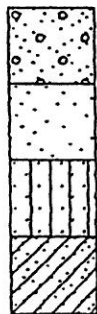

SW

SP

SM or SP-SM

SC



ML

CL

MH

CH




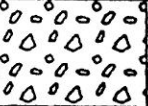



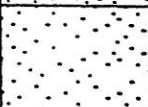
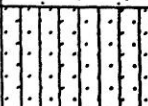
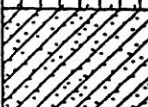







OL

OH

PT

# UDALOY ENVIRONMENTAL SERVICES

## SOIL CLASSIFICATION CHART

MAJOR DIVISIONS			SYMBOLS		TYPICAL DESCRIPTIONS	
			GRAPH	LETTER		
<b>COARSE GRAINED SOILS</b>  MORE THAN 50% OF MATERIAL IS SAND OR LARGER BASED ON VISUAL CRITERIA	<b>GRAVEL AND GRAVELLY SOILS</b>  MORE THAN 50% OF COARSE FRACTION IS GRAVEL BASED ON VISUAL CRITERIA	<b>CLEAN GRAVELS</b>  (MORE THAN 5% FINES BASED ON VISUAL CRITERIA)		<b>GW</b>	WELL-GRADED GRAVELS, GRAVEL - SAND MIXTURES, LITTLE OR NO FINES	
				<b>GP</b>	POORLY-GRADED GRAVELS, GRAVEL - SAND MIXTURES, LITTLE OR NO FINES	
		<b>GRAVELS WITH FINES</b>  (MORE THAN 5% FINES BASED ON VISUAL CRITERIA)		<b>GM</b>	SILTY GRAVELS, GRAVEL - SAND - SILT MIXTURES	
				<b>GC</b>	CLAYEY GRAVELS, GRAVEL - SAND - CLAY MIXTURES	
	<b>SAND AND SANDY SOILS</b>  MORE THAN 50% OF COARSE FRACTION IS SAND BASED ON VISUAL CRITERIA	<b>CLEAN SANDS</b>  (LESS THAN 5% FINES BASED ON VISUAL CRITERIA)		<b>SW</b>	WELL-GRADED SANDS, GRAVELLY SANDS, LITTLE OR NO FINES	
				<b>SP</b>	POORLY-GRADED SANDS, GRAVELLY SAND, LITTLE OR NO FINES	
		<b>SANDS WITH FINES</b>  (MORE THAN 15% FINES BASED ON VISUAL CRITERIA)		<b>SM</b>	SILTY SANDS, SAND - SILT MIXTURES	
				<b>SC</b>	CLAYEY SANDS, SAND - CLAY MIXTURES	
		<b>FINE GRAINED SOILS</b>  MORE THAN 50% OF MATERIAL IS SMALLER SILT OR FINES BASED ON VISUAL CRITERIA	<b>SILTS AND CLAYS</b>  NON-PLASTIC TO MEDIUM PLASTICITY (BASED ON TACTILE CRITERIA)		<b>ML</b>	INORGANIC SILTS AND VERY FINE SANDS, ROCK FLOUR, SILTY OR CLAYEY FINE SANDS OR CLAYEY SILTS WITH SLIGHT PLASTICITY
					<b>CL</b>	INORGANIC CLAYS OF LOW TO MEDIUM PLASTICITY, GRAVELLY CLAYS, SANDY CLAYS, SILTY CLAYS, LEAN CLAYS
	<b>OL</b>			ORGANIC SILTS AND ORGANIC SILTY CLAYS OF LOW PLASTICITY		
<b>SILTS AND CLAYS</b>  HIGHLY PLASTIC (BASE ON TACTILE CRITERIA)			<b>MH</b>	INORGANIC SILTS, MICACEOUS OR DIATOMACEOUS FINE SAND OR SILTY SOILS		
			<b>CH</b>	INORGANIC CLAYS OF HIGH PLASTICITY		
		<b>OH</b>	ORGANIC CLAYS OF MEDIUM TO HIGH PLASTICITY, ORGANIC SILTS			
<b>HIGHLY ORGANIC SOILS</b>				<b>PT</b>	PEAT, HUMUS, SWAMP SOILS WITH HIGH ORGANIC CONTENTS	

NOTE: DUAL SYMBOLS ARE USED TO INDICATE BORDERLINE SOIL CLASSIFICATIONS.

HYPHENATED SYMBOLS ARE USED TO INDICATE 5 TO 15 PERCENT FINES BASED ON VISUAL EXAMINATION.

# LOG OF EXPLORATORY BORING

**PROJECT NAME** Field Investigation Report  
**LOCATION** Vashon Island Landfill  
**DRILLED BY** Tacoma Pump & Drilling  
**DRILL METHOD** Hollow-stem Auger  
**LOGGED BY** A. Udaloy

**BORING NO.** MW-20  
**PAGE** 1 OF 8  
**GROUND ELEV.** 365.20'  
**TOTAL DEPTH** 121.30'  
**DATE COMPLETED** 10/21/98

SAMPLE TYPE	SAMPLE NUMBER	BLOWS PER 6 INCHES	GROUND WATER LEVELS	DEPTH IN FEET	SAMPLES	WELL DETAILS	LITHOLOGIC COLUMN	LITHOLOGIC DESCRIPTION
G	0							0 to 3.5 feet: <b>SANDY SILT (ML)</b> , reddish brown, some fine to coarse sand, nonplastic, damp. Predominantly boulders (road subgrade) from 1.0 to 3.5 feet. (TOPSOIL/FILL)
SS	5	50/5"		5				3.5 to 6.0 feet: <b>SANDY SILT (ML)</b> , yellowish gray to gray, little fine sand, trace coarse sand and fine gravel, dry, stiff. (TILL)
SS	10	40-50/5"		10				6.0 to 17.5 feet: <b>SILTY SAND (SM)</b> , yellowish gray with orange-brown mottles, lenses of SILT (ML), trace to few fine to medium subrounded gravel. Boulder from about 7 to 8 feet. Horizontal laminations with one gray silt lens (rip-up clast?) at 15.3 feet. Very slow drilling, very dense. (TILL)
SS	12.5	40						
SS	15	50		15				
SS	17.5	50/4"						17.5 to 28.5 feet: <b>SANDY SILT (ML)</b> , yellowish gray, some fine to medium sand, few coarse sand and fine gravel, very stiff to hard, damp. Common interbeds of SILTY SAND (SM), as above, gradational upper contact. Coarse
				20				

**REMARKS**

(1) Potable water added during drilling below 131.0 feet. (2) Top of steel casing elevation = 368.18 feet. (3) Northing = 333.12; Easting = 2739.35. (4) Static water elevation after well development = 244.61 feet, measured January 19, 1999. (5) SS = Nominal 2-inch-diameter split-spoon sampler. G = Grab.



# LOG OF EXPLORATORY BORING

**PROJECT NAME** Field Investigation Report  
**LOCATION** Vashon Island Landfill  
**DRILLED BY** Tacoma Pump & Drilling  
**DRILL METHOD** Hollow-stem Auger  
**LOGGED BY** A. Udaloj

**BORING NO.** MW-20  
**PAGE** 2 OF 8  
**GROUND ELEV.** 365.20'  
**TOTAL DEPTH** 121.30'  
**DATE COMPLETED** 10/21/98

SAMPLE TYPE	SAMPLE NUMBER	BLOWS PER 6 INCHES	GROUND WATER LEVELS	DEPTH IN FEET	SAMPLES	WELL DETAILS	LITHOLOGIC COLUMN	LITHOLOGIC DESCRIPTION
SS	20	9-50						content decreases with depth. Very slow drilling. (TILL)
SS	22.5	50						@ 23.0 feet: trace orange mottles.
SS	25	10-50		25				@ 25.8 to 26.0 feet: SAND (SP), yellowish gray, fine, wet.
SS	27.5	11-50						28.5 to 30.5 feet: SANDY SILT (ML), yellowish gray, little to some fine sand, few fine to medium subrounded gravel, stiff, wet. Trace thin wet beds of yellowish gray SAND (SP). (ADVANCE OUTWASH)
SS	30	20-50		30				30.5 to 49.0 feet: SAND (SP), white with brown and black, fine, trace subrounded coarse sand and fine gravel, damp to moist. Occasional thin (<2") SILT (ML) interbeds. Significantly faster drilling. (ADVANCE OUTWASH)
SS	32.5	50/5"						@ 30.5 feet: medium to coarse gravel. @ 32.5 feet: SANDY SILT (ML), brownish gray, firm to stiff, little fine sand, trace coarse sand and fine gravel, damp. Minimum 0.5-foot thickness.
SS	35	20-50		35				@ 38.0 feet: trace fine gravel.
SS	37.5	12-35						
				40				

**REMARKS**

(1) Potable water added during drilling below 131.0 feet. (2) Top of steel casing elevation = 368.18 feet. (3) Northing = 333.12; Easting = 2739.35. (4) Static water elevation after well development = 244.61 feet, measured January 19, 1999. (5) SS = Nominal 2-inch-diameter split-spoon sampler. G = Grab.

# LOG OF EXPLORATORY BORING

**PROJECT NAME** Field Investigation Report  
**LOCATION** Vashon Island Landfill  
**DRILLED BY** Tacoma Pump & Drilling  
**DRILL METHOD** Hollow-stem Auger  
**LOGGED BY** A. Udaloy

**BORING NO.** MW-20  
**PAGE** 3 OF 8  
**GROUND ELEV.** 365.20'  
**TOTAL DEPTH** 121.30'  
**DATE COMPLETED** 10/21/98

SAMPLE TYPE	SAMPLE NUMBER	BLOWS PER 6 INCHES	GROUND WATER LEVELS	DEPTH IN FEET	SAMPLES	WELL DETAILS	LITHOLOGIC COLUMN	LITHOLOGIC DESCRIPTION
SS	40	12-30-35						<p><b>30.5 to 49.0 feet: SAND (SP), see description on previous page.</b>                      @ 40.0 feet: trace medium subrounded gravel.</p> <p>@ 42.5 feet: trace fine to medium gravel.</p> <p><b>49.0 to 72.0 feet: SILTY SAND (SP-SM), white with brown and black, fine, few gray silt, trace clay, damp. Common thin (&lt; 1 mm) laminations. Gradational upper contact. (ADVANCE OUTWASH)</b></p> <p>@ 52.5 feet: moist.</p>
SS	42.5	20-50/3"						
SS	45	8-8-50		45				
SS	47.5	30-50/3"						
SS	50	20-50/4"		50				
SS	52.5	30-50						
SS	55	12-50		55				
SS	57.5	50/5"						
				60				

**REMARKS**

(1) Potable water added during drilling below 131.0 feet. (2) Top of steel casing elevation = 368.18 feet. (3) Northing = 333.12; Easting = 2739.35. (4) Static water elevation after well development = 244.61 feet, measured January 19, 1999. (5) SS = Nominal 2-inch-diameter split-spoon sampler. G = Grab.

**UDALOY ENVIRONMENTAL SERVICES**

# LOG OF EXPLORATORY BORING

**PROJECT NAME** Field Investigation Report  
**LOCATION** Vashon Island Landfill  
**DRILLED BY** Tacoma Pump & Drilling  
**DRILL METHOD** Hollow-stem Auger  
**LOGGED BY** A. Udalay

**BORING NO.** MW-20  
**PAGE** 4 OF 8  
**GROUND ELEV.** 365.20'  
**TOTAL DEPTH** 121.30'  
**DATE COMPLETED** 10/21/98

SAMPLE TYPE	SAMPLE NUMBER	BLOWS PER 6 INCHES	GROUND WATER LEVELS	DEPTH IN FEET	SAMPLES	WELL DETAILS	LITHOLOGIC COLUMN	LITHOLOGIC DESCRIPTION
SS	60	30-50/3"						49.0 to 72.0 feet: SILTY SAND (SP-SM), see description on previous page.
SS	62.5	50						
SS	65	20-50		65				@ 65.0 to 65.4 feet: SILTY SAND (SM), brown, fine, little fines, trace fine subrounded gravel.
SS	67.5	30-50						@ 67.5 feet: horizontal to subhorizontal laminae. @ 68.0 feet: one light brown SILT (ML) lamina.
SS	70	20-50/5"		70				@ 70.2 feet: SAND (SP), white with brown, fine, 1-inch thick.
SS	72.5	30-50/2"						72.0 to 75.0 feet: SILTY SAND (SM), grayish brown, fine, some fines, trace subrounded gravel, moist. Gradational upper contact. (ADVANCE OUTWASH)
SS	75	20-50/4"		75				75.0 to 75.5 feet: SANDY SILT (ML), light olive brown, some fine sand, firm, wet, gradational upper contact. (ADVANCE OUTWASH)
SS	77.5	20-50/5"						75.5 to 78.1 feet: SILT (ML), light olive brown, firm, wet, finely laminated. Abrupt upper contact. Interbeds of SAND (SP) and SILTY SAND (SP-SM) from 77.5 to 78.1 feet. (ADVANCE OUTWASH)
				80				78.1 to 88.0 feet: SAND (SP), white with brown and black, fine, trace fines, moist above

### REMARKS

(1) Potable water added during drilling below 131.0 feet. (2) Top of steel casing elevation = 368.18 feet. (3) Northing = 333.12; Easting = 2739.35. (4) Static water elevation after well development = 244.61 feet, measured January 19, 1999. (5) SS = Nominal 2-inch-diameter split-spoon sampler. G = Grab.

**UDALOY ENVIRONMENTAL SERVICES**

# LOG OF EXPLORATORY BORING

**PROJECT NAME** Field Investigation Report  
**LOCATION** Vashon Island Landfill  
**DRILLED BY** Tacoma Pump & Drilling  
**DRILL METHOD** Hollow-stem Auger  
**LOGGED BY** A. Udaloy

**BORING NO.** MW-20  
**PAGE** 5 OF 8  
**GROUND ELEV.** 365.20'  
**TOTAL DEPTH** 121.30'  
**DATE COMPLETED** 10/21/98

SAMPLE TYPE	SAMPLE NUMBER	BLOWS PER 6 INCHES	GROUND WATER LEVELS	DEPTH IN FEET	SAMPLES	WELL DETAILS	LITHOLOGIC COLUMN	LITHOLOGIC DESCRIPTION
SS	80	20-50/5"						80.0 feet, damp below 80.0 feet. (ADVANCE OUTWASH) @ 80.0 to 80.5 feet: SILT (ML), grayish brown with common 1- to 5-mm-diameter orange mottles, soft, damp.
SS	82.5	50/3"						
SS	85	50		85				
SS	87.5	50						
SS	90	20-50/5"		90				<b>88.0 to 127.5 feet: SILT (ML), gray, firm to stiff, moist to about 97.5 feet, wet (capillary saturation) below 97.5 feet. Occasional thin horizontal orange-stained layers below 90.4 feet. (LACUSTRINE PRE-VASHON DEPOSITS)</b> @ 90.0 to 90.4 feet: finely laminated. @ 90.4 to 90.9 feet: SANDY SILT (ML), brown, few to little fine sand, wet, soft, orange staining at 90.4 feet. @ 92.5 to 93.4 feet: mostly beds of wet brownish gray SANDY SILT (ML) with common fine orange-stained laminae.
SS	92.5	20-50/5"						
SS	95	20-50/5"		95				@ 95.3 to 95.4 feet: SANDY SILT (ML), orange staining, little fine sand, wet. @ 95.9 feet: brownish gray SANDY SILT (ML), with trace medium to coarse angular to subangular sand in sampler driveshoe.
SS	97.5	25-50						
				100				

**REMARKS**

(1) Potable water added during drilling below 131.0 feet. (2) Top of steel casing elevation = 368.18 feet. (3) Northing = 333.12; Easting = 2739.35. (4) Static water elevation after well development = 244.61 feet, measured January 19, 1999. (5) SS = Nominal 2-inch-diameter split-spoon sampler. G = Grab.

**UDALOY ENVIRONMENTAL SERVICES**

# LOG OF EXPLORATORY BORING

**PROJECT NAME** Field Investigation Report  
**LOCATION** Vashon Island Landfill  
**DRILLED BY** Tacoma Pump & Drilling  
**DRILL METHOD** Hollow-stem Auger  
**LOGGED BY** A. Udalay

**BORING NO.** MW-20  
**PAGE** 6 OF 8  
**GROUND ELEV.** 365.20'  
**TOTAL DEPTH** 121.30'  
**DATE COMPLETED** 10/21/98

SAMPLE TYPE	SAMPLE NUMBER	BLOWS PER 6 INCHES	GROUND WATER LEVELS	DEPTH IN FEET	SAMPLES	WELL DETAILS	LITHOLOGIC COLUMN	LITHOLOGIC DESCRIPTION
SS	100	30-50/5"						<p><b>88.0 to 127.5 feet: SILT (ML),</b> see description on previous page.</p> <p>@ 105.0 to 106.0 feet: SAND (SP), white with brown and black, fine, trace light brown fines, orange staining at 105.0 feet, moist.</p> <p>@ 113.5 to 114.0 feet: SAND (SP), white with brown and black, fine, moist.</p> <p>@ 115.0 feet: trace fine sand, fine horizontal laminae.</p> <p>@ 117.5 to 127.5 feet: varved, trace clay.</p>
SS	102.5	30-50						
SS	105	25-50		105				
SS	107.5	20-30-35						
SS	110	15-30-30		110				
SS	112.5	10-20-30						
SS	115	10-25-25		115				
SS	117.5	25-25-45						
				120				

**REMARKS**

(1) Potable water added during drilling below 131.0 feet. (2) Top of steel casing elevation = 368.18 feet. (3) Northing = 333.12; Easting = 2739.35. (4) Static water elevation after well development = 244.61 feet, measured January 19, 1999. (5) SS = Nominal 2-inch-diameter split-spoon sampler. G = Grab.

**UDALOY ENVIRONMENTAL SERVICES**

# LOG OF EXPLORATORY BORING

**PROJECT NAME** Field Investigation Report  
**LOCATION** Vashon Island Landfill  
**DRILLED BY** Tacoma Pump & Drilling  
**DRILL METHOD** Hollow-stem Auger  
**LOGGED BY** A. Udaloy

**BORING NO.** MW-20  
**PAGE** 7 OF 8  
**GROUND ELEV.** 365.20'  
**TOTAL DEPTH** 121.30'  
**DATE COMPLETED** 10/21/98

SAMPLE TYPE	SAMPLE NUMBER	BLOWS PER 6 INCHES	GROUND WATER LEVELS	DEPTH IN FEET	SAMPLES	WELL DETAILS	LITHOLOGIC COLUMN	LITHOLOGIC DESCRIPTION
SS	120	10-15-35	1/19/99					<b>88.0 to 127.5 feet: SILT (ML)</b> , see description on previous page. @ 121.1 to 121.5 feet: <b>SAND (SP)</b> , gray, fine, wet, with brown and gray silt interbeds.
SS	121.5	25-50/5"	Static					
SS	122.5	25-50	10/29/99					@ 125.3 to 126.0 feet: <b>SILTY SAND (SM)</b> , gray, fine, wet, with soft gray wet silt in sampler drive shoe.
SS	125	25-50	During Installation	125				
SS	126							
SS	127.5	20-50/5"						<b>127.5 to 131.5 feet: SAND (SP)</b> , gray, fine, dense, wet. (PRE-VASHON DEPOSITS)
SS	129							
SS	130	50		130				
SS	131	20-30-40						<b>131.5 to 134.9 feet: SILT (ML)</b> , dark gray, stiff, moist. Varved with trace clay as varves. (LACUSTRINE PRE-VASHON DEPOSITS)
SS	132.5	10-20-50						
SS	134	25-50/5"						Total depth drilled = 134.0 feet. Total depth sampled = 134.9 feet.
				135				See Page 8 for Well Completion Details.
				140				

**REMARKS**

(1) Potable water added during drilling below 131.0 feet. (2) Top of steel casing elevation = 368.18 feet. (3) Northing = 333.12; Easting = 2739.35. (4) Static water elevation after well development = 244.61 feet, measured January 19, 1999. (5) SS = Nominal 2-inch-diameter split-spoon sampler. G = Grab.