SITE ASSESSMENT REPORT


on

PETROLEUM RELEASE

CITY OF ELLENSBURG

WEST EIGHTH AVENUE RIGHT-OF-WAY

Ellensburg, Washington

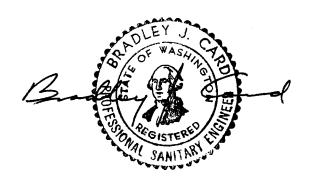

March 1991

Job No. 91052

Prepared by

PLSA ENGINEERING & SURVEYING WDOE LIC. NO. S000210 1120 West Lincoln Avenue Yakima, WA 98902 (509) 575-6990

SITE ASSESSMENT REPORT

on

PETROLEUM RELEASE

CITY OF ELLENSBURG

WEST EIGHTH AVENUE RIGHT-OF-WAY

Ellensburg, Washington

INTRODUCTION

During the course of a cleanup of petroleum contaminated soil (PCS) at Ward Rugh Inc., P.O. Box 68, Ellensburg, Washington, a petroleum product not originally characterized was encountered. This product increased in concentration as the soil excavation proceeded into 700 block of West Eighth Avenue. This petroleum release is located at SW1/4, SW 1/4, SEC 5, TWP 18N, R18E. See Figure 1.

All of the PCS related to the Ward Rugh, Inc. cleanup has been removed. This is documented in site closure report dated March 1991.

This report summarizes site conditions, and proposed cleanup and disposal of PCS including the results of laboratory testing of representative soil samples for characterization of the spilled petroleum by EPA 8015. A geotechnical engineer from PLSA Engineering and Surveying, WDOE Lic. No. S000210, experienced with local soil conditions will monitor removal of contaminated soil.

The owner's representative and contact person for this project is as follows:

Ms. Glenna Bradley-House, City Attorney City of Ellensburg City Hall 420 North Pearl Street Ellensburg, Washington 98926 phone (509) 962-7259

SURFACE CONDITIONS

A graveled street covers the spill area.

SUB-SURFACE CONDITIONS

Below the gravel street surface, local clayey silt topsoil approximately 4 feet thick overlies a stratum of alluvial cobbles, gravel, and sand. The water table is seasonally variable with the irrigation season. Water was found at approximately 8 feet below the surface at the time of opening the adjacent Ward Rugh, Inc. tank basin. The water table is expected to trend lower since the irrigation water was turned off in early October and will not return until approximately April 1. The volume of contaminated soil cannot not be accurately determined, but is estimated at approximately 2,000 cubic yards.

Excavation it appears that the groundwater hydraulic gradient is the southwest toward the small stream bordering the south Boundary of the Ward Rugh property.

SAMPLING PLAN

Representative soil and water samples will collected from the excavation. Sample containers will be supplied by the analytical laboratory and will be clean glass with Teflon lined, screwed caps. Sampling equipment will be cleaned between samplings. Water samples from below the surface will be collected using a clean, Teflon bailer.

All samples will be stored and shipped to the laboratory by overnight express in a refrigerated, insulated container.

CONTAMINANT CHARACTERIZATION

Petroleum odor was present when the soil in the spill was disturbed. Some free product, which was observed producing an oily sheen on the water, had accumulated in the bottom of the excavation. It appeared that the sheen was the result of contaminated soil from above coming into contact with the water. A sample was collected and submitted to a laboratory for analysis for contaminant characterization by EPA 8015. Results of the laboratory analyses are found in Appendix I listed under Sample No. 21. Heavy oil was the contaminant identified. This indicates that the contaminant is higher molecular weight than diesel. Heavy oil is usually less toxic and more environmentally inert than the lighter petroleum products.

A Burlington-Northern Railroad roundhouse was located on the other side of the stream from the spill location. The product in the subject spill characterized as heavy oil has the appearance of oil used by railroads in the past. It is possible that the spill has been present for more than 40 years.

Sent for more than 40 years.

CLEANUP PROCEDURE AND PCS REMOVAL

Locally available excavation equipment operated by a WDOE licensed contractor will be used for PCS removal and cleanup.

A Photovac TIP 1 photoanalyzer will be used to detect volatile organic compounds (VOC's) as contaminated soil is removed until significant readings are no longer obtained by testing headspace in sample jars that have been warmed to a uniform 70 degree F. Representative soil and water samples will then then collected and submitted for laboratory analysis to verify the TIP results.

There was no evidence that contamination had spread from the Ward Rugh, Inc. property into the City right of way. Rather, the reverse appeared to be true. A polyethylene membrane barrier separates the backfilled north edge of the existing cleanup excavation to delineate the boundary between the Ward Rugh cleanup and West Eighth Avenue.

DISPOSAL OF CONTAMINATED SOIL

The estimated volume of contaminated soil to be removed is 2,000 cubic yards. It is understood that the Kittitas County Sanitary Landfill at Ryegrass will soon be certified to receive PCS. The City proposes to delay cleanup until this disposal site is available. The nearest other available disposal site is at the Yakima County Sanitary Landfill at Terrace Heights, approximately forty miles south. The cost of hauling to this site is prohibitive.

7 SPRÉAD OF CONTAIN INATION

SITE CLOSURE

The excavation will be backfilled with clean fill and the surface restored for use as a street.

Ward Rugh, Inc. had recently cleaned up an adjacent diesel spill. This cleanup area was needed for their operations, so the excavation has been backfilled and a plastic membrane installed along the West Eighth Avenue boundary as a barrier and marker.

SCHEDULE

Uncontaminated water samples were obtained from the Ward Rugh, Inc. cleanup excavation located down gradient and between the subject spill and the stream. Therefore, there is no evidence that the heavy oil is contaminating water.

Seasonal rise in the water table is expected soon and certainly before the Kittitas County Sanitary Landfill becomes available as a disposal site. A higher water table will necessitate more excavation dewatering resulting in a greater hydraulic load on the Ellensburg sewage treatment plant which would be experiencing seasonal increased flow as well.


The City proposes to cleanup in late 1991 when the water table has again lowered, the wastewater treatment plant is experiencing seasonally low flow, and the Kittitas County Sanitary Landfill is available to receive PCS.

NEARBY WELLS

Locations and well logs for documented wells within one half mile of the spill area may be found in Appendix II.

APPENDIX I

Analytical Results

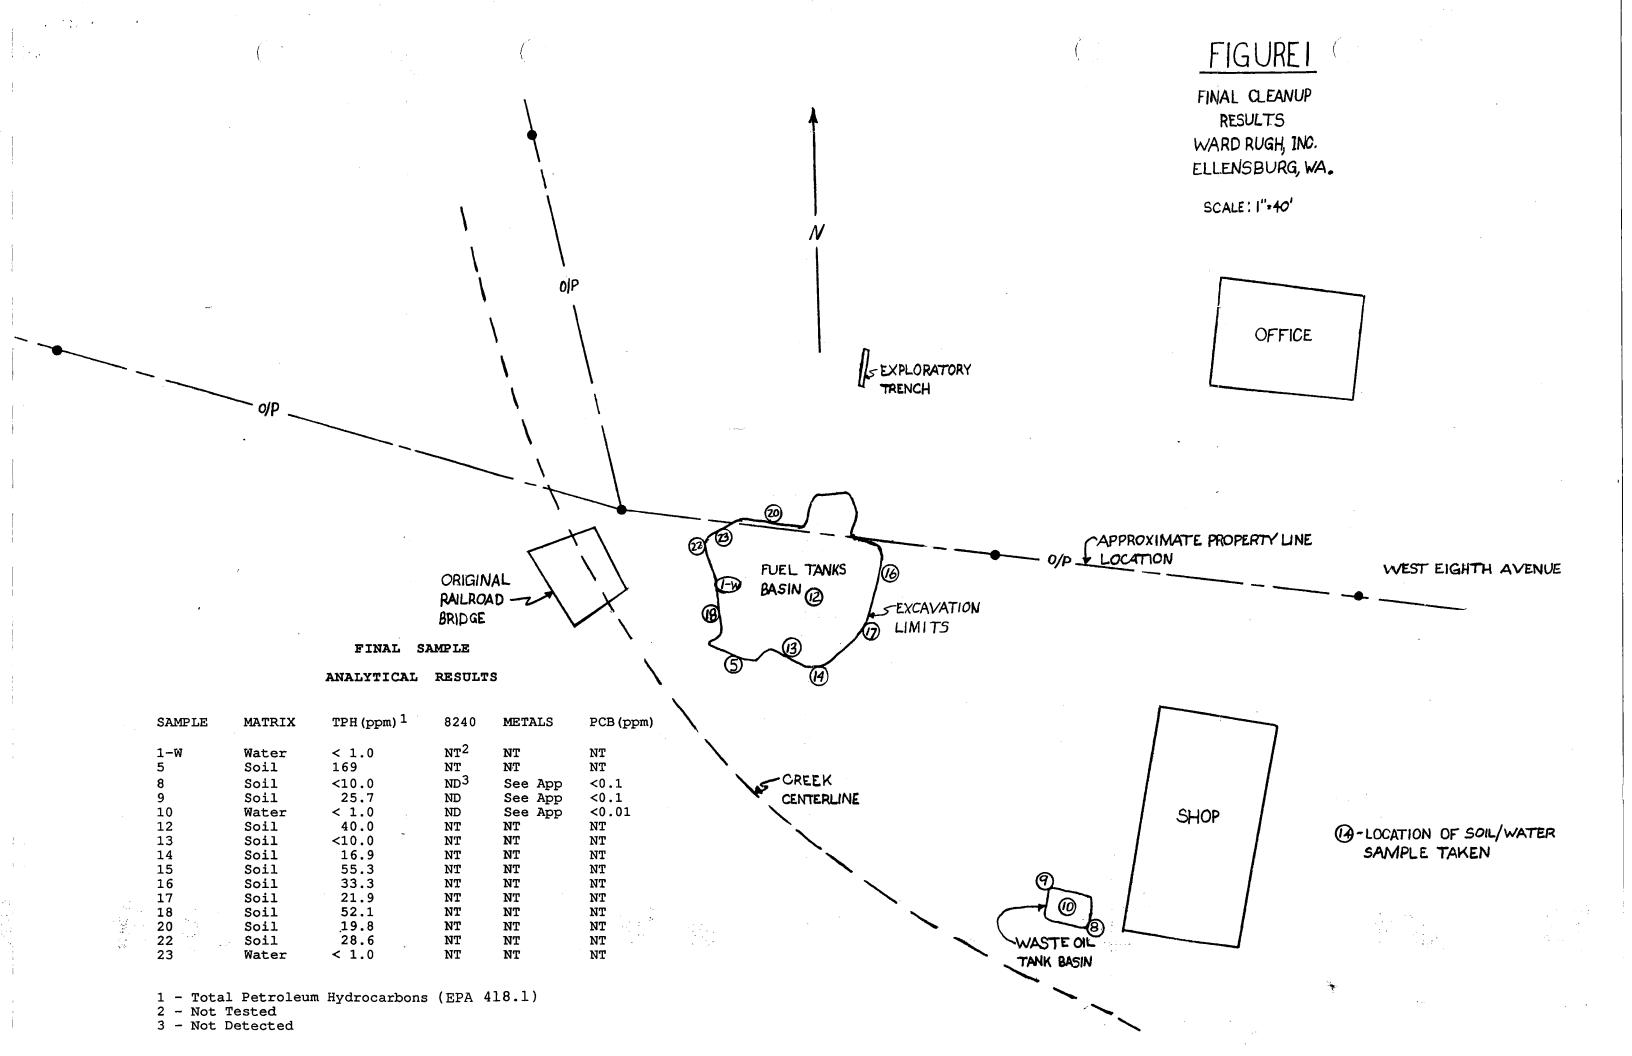

SOUND ANALYTICAL SERVICES, INC.

SPECIALIZING IN INDUSTRIAL & TOXIC WASTE ANALYSIS 4813 PACIFIC HIGHWAY EAST, TACOMA, WASHINGTON 98424 - TELEPHONE (206)922-2310 - FAX (206)922-5047

Report To: PLSA Engineering

Date: February 8, 1991

Report On: Analysis of Soil & Water Lab No.: 15875

IDENTIFICATION:

Samples Received on 02-07-91

Project: 90320

ANALYSIS:

Lab Sample No.	RUSH 1	RUSH 2	RUSH 3	RUSH 4
Client Identification	20	22	23	21
Matrix/Units	Soil ppm	Soil ppm	Water ppm	Soil ppm
Total Petroleum Hydrocarbons by EPA Method 418.1	19.8	28.6	< 1.0	37,200
Total Petroleum Fuel Hydrocarbons by EPA SW-846 Modified Method 8015	NT	NT	NT	348
TPH as				Hvy. Oil

NT = Not Tested


Note - Results reported on an as received, wet basis.

SOUND AMALYTICAL SERVICES

APPENDIX II

Documented Well Locations

FIGURE 2
WELL LOCATION
MAP
WARD RUGH, INC.
ELLENSBURG, WA.

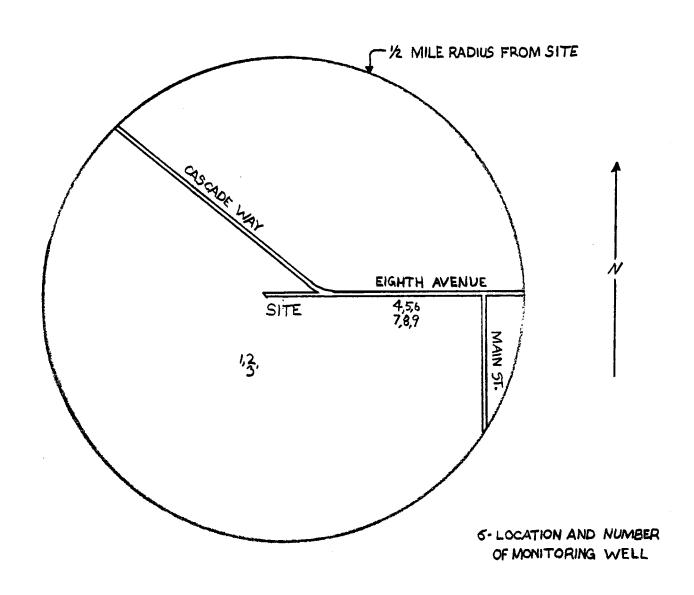

* NO DOCUMENTED WATER WELLS WERE FOUND WITHIN 1/2 MILE OF THE SITE

PROJECT NAME: Waste Management Svc. WELL IDENTIFICATION NO. X 3 DRILLING METHOD: Air Rotary DRILLER: Mike Robinson FIRM: Ponderosa Drilling SIGNATURE: Waste Management Svc. COUNTY: Kittitas LOCATION: NW 1/4 Sec 2 STREET ADDRESS OF WELL: Ellensi 607 N. RAilroad AVE. WATER LEVEL ELEVATION: GROUND SURFACE ELEVATION: INSTALLED:	Twn 17N R 18E ourg, WA
DRILLING METHOD: Air Rotary DRILLER: Mike Robinson FIRM: Ponderosa Drilling SIGNATURE: Make Robinson GROUND SURFACE ELEVATION:	Twn 1/N R 18E burg, WA
PRILLER: Mike Robinson 607 N. RAilroad AVE. FIRM: Ponderosa Drilling WATER LEVEL ELEVATION: GROUND SURFACE ELEVATION:	oury, WA
FIRM: Ponderosa Drilling WATER LEVEL ELEVATION: SIGNATURE: Water W. Water Level ELEVATION:	
SIGNATURE: Walter W. Robert GROUND SURFACE ELEVATION:	
	-
CONSULTING FIRM GOLDER ASSOCIATES INC. INSTALLED	
CONSULTING FIRM: GOLder Associates inc. INSTALLED:	
REPRESENTATIVE: Seth Brandonberger DEVELOPED:	
AS-BUILT WELL DATA FORMATION DES	CRIPTION
ill cement	
2" Blank 0-5 Coarse gravel & col	obles w/sand
0-15	
Spellets	
5 !	
Centrilizer	
10' x 2" Screen	
(5-15)	
T 1/2/18 0	
	1/2/
	77/11/
1 N 1 - 1890	r <i>1////</i>
	1011
	1
2" Screen(pvc) .ozo stat	
1 2 July 2007	-,
1 .020 3701	
-	
Application of the second of t	one an war.
The state of the s	1 3 Table 1
	المجيهة مديد أأوا الأوا
+	

ECY 050-12 (Rev. 11/89)

SCALE: 1" = ___

15

RESOURCE PROTECTION WELL REPORT

PROJECT NAME: Waste Management Well IDENTIFICATION NO. 2 2 DRILLING METHOD: Air Rotary DRILLER: Mike Robinson FIRM: Ponderosa Drilling SIGNATURE: CONSULTING FIRM: Golder Asset REPRESENTATIVE: Seth Brandon	dividence inc.	STREET ADDI 607 N. F WATER LEVE GROUND SUF INSTALLED:	Kittitas W1/4 NW 1/4 Sec 2 Twn 17N R 18E RESS OF WELL: Ellensburg WA Railroad AVE. L ELEVATION:
AS-BUILT Cement	WELL DATA		FORMATION DESCRIPTION
Bulpri Bertonte pellets	2" blank 0-5		Sand & Gravel w/clay 0-4
5+			Coarse gravel & cobbles w/sand _ 4-15
10 Sand	10' x 2" Screen (5-15)	
15_			10 E 3 E
centrilizes 2" puc screen 1 020 5/0+			MN 1 - NO STEEL OF STEEL
1			
<u> </u>			-
SCALE: 1" =	PAGE	OF	-


ECY 050-12 (Rev. 11/89)

3

RESOURCE PROTECTION WELL REPORT

		START CARD NO.
PROJECT NAME: Waste Manag	gement Svc.	COUNTY: Kittitas
WELL IDENTIFICATION NO1		LOCATION: NW 1/4 NW 1/4 Sec 2 Twn 17Nn 18E
DRILLING METHOD: Air Rota	rv	STREET ADDRESS OF WELL: Ellensburg WA
DRILLER: Mike Robinson		607 N. Railroad AVE.
FIRM: Ponderosa Drilling		
		WATER LEVEL ELEVATION:
SIGNATURE: MANNE (2) (pul	GROUND SURFACE ELEVATION:
	Associates Inc.	INSTALLED:
REPRESENTATIVE: Seth Branc	donberger	DEVELOPED:
AS-BUILT	WELL DATA	FORMATION DESCRIPTION
M Ce munt		
1 (1) 5 0 1 1	2" Blank 0-5	Coarse gravel & Cobbles
		with Sand 0-15
> pellets		
1 4 (
T	1	
1 医国际人	10' x 2" Sch 40 .	020 Screen
	(5-15)	
! sand	, ,	
	1	
수 기계활기 /		
SC reen		
1020		
Slot		(/n) /3
_		
 /		
Centrilizers		1 July 11 1 1 1 1 1 1 1 1 1 1 1 1 1 1 1 1 1
1 Centrilizers		De la constantina della consta
1		D555
1		SPONTENT
1		REGION FOOT
┰		6596y
1		
1		
1		
1		·
1		
┯		
1		
1		Committee of the second of the
1		
1		
1		
-		
Ţ.		
1		
1		`-{
l		
<u> </u>		
SCALE: 1" =	PAGE	OF
	FAGE	OF.

ECY 050-12 (Rev. 11/89)

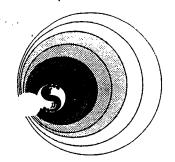

FEDERAL ID #: 91-0762274

(206) 927-3173 TELEX: 466762

WA CONT. #SOIL SS*344LO FAX: (206) 927-3478 Geotechnical, Engineering & Mineral Exploration Drilling • Instrumentation • Horizontal Drans [5]




RESOURCE PROTECTION WELL REPORT

	CENTRAL ALGION CITTLE
PROJECT NAME: Ellensburg Cheuron WELL IDENTIFICATION NO.:	JOB #: W2851 START CARD NO.: 075119 COUNTY: Kith, tas CITY: Ellensburg LOCATION: 1/4 2 1/4 1/4 SEC.: 2 TOWN: 177 RANGE: 18E
SIGNATURE: Howel newwork / Ell (Hei) CONSULTING FIRM: R: Hentowse + Zemon + Cassoc REPRESENTATIVE: Todd wentwerth	DATUM:

WELL DATA	AS BUILT	FORMATION DESCRIPTION
o' manment	ō, Hi	0'
· concrete	15'3	16
3 Chips	4"x 5" 3 ch 40	1 5 6 rass
do sand	5'	Saronith
Colorado Sand		Sand & Gravel Sand & Gravel Cobbles
20	\\\\\\\\\\\\\\\\\\\\\\\\\\\\\\\\\\\\\\	1 Co
10-20	7 X VOIX X 2013	
		13'
ué	15'	silty fine so Sand
		porter for the factor of the f

SCALE: 1" = ____5'

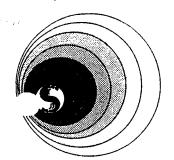

FEDERAL ID #: 91-0762274

WA CONT. #SOIL SS*344LO

(206) 927-3173 TELEX: 466762 :-

FAX: (206) 927-3478

Geotechnical, Engineering & Mineral Exploration Drilling • Instrumentation • Horizontal Drains Ground Water Monitoring • Hazardous Waste Identification • Well Abandonments


RESOURCE PROTECTION WELL REPORT

DEPARTMENT OF ECOLOGY

	CENTRAL REGION OFFICE
PROJECT NAME: Ellensburg Cheuron	JOB #: 1 2851 START CARD NO.: 075119
WELL IDENTIFICATION NO.: _ race '- S	COUNTY: Killitos CITY: Ellensburg LOCATION: 1/4 1/4 1/4
DRILLING METHOD: Oir rotury	LOCATION:
DRILLER: Harold Missiander / Edward Hints 1442	SEC.: TOWN: 171 RANGE: 18 E
	DATUM:
SIGNATURE: Howel A surandu / Elly	WATER LEVEL ELEVATION: 5'3"
CONSULTING FIRM: R. Hen House + Zenan Ciscoc.	INSTALLED: <u> </u>
REPRESENTATIVE: Todd Wentworth	DEVELOPED:

WELL DATA	AS BUILT	FORMATION DESCRIPTION
monment	Ľ Š	ó
r concrete		
3' Chips	A118 2 28 110	2020 3 650 JE
Colorado Sand	<u>├</u> ── {*	Sand of Grossel Williams Cobyles
10-0	P C C C C C C C C C C C C C C C C C C C	Sitty Fine Sand
15'	15'	IS'

SCALE: 1" = ______5"

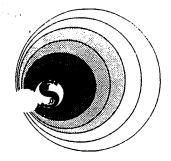

FEDERAL ID #: 91-0762274 WA CONT. #SOIL SS*344LO (206) 927-3173


TELEX: 466762 FAX: (206) 927-3478

Geotechnical, Engineering & Mineral Exploration Drilling • Instrumentation • Horizontal Drains Ground Water Monitoring • Hazardous Waste Identification • Well Abandonments

RESOURCE PROTECTION WELL REPORT

_	JOB #: 4 2851 START CARD NO.: 4 15 119
PROJECT NAME: £ llensburg Cheuron	JOB#: Li 2951 START CARDINO .: 275119
WELL IDENTIFICATION NO.: ~ &	COUNTY: kith has CITY: Filensburg LOCATION: 1/4 1/4 1/4
DRILLING METHOD: Gir rotary	LOCATION: 1/4 1/4 1/4
DRILLER: Harold niswander / Edward Hinds 144	SEC.: 2 TOWN: 171 RANGE: 18E
10/2/	DATUM:
SIGNATURE: Howeld Assumed Elity	WATER LEVEL ELEVATION: 8' 10"
CONSULTING FIRM: Ritentouses Zeman Cissoc	INSTALLED: <u>9-8-90</u>
REPRESENTATIVE: Todd Wentworth	DEVELOPED:


WELL DATA	AS BUILT	FORMATION DESCRIPTION
Chips Concrete Chips Concrete Conc	5 M M 5 X X Y Y Y Y Y Y Y Y Y Y Y Y Y Y Y Y Y	Sund + gravel with Cubyles
10-20	18'	Silty Fine Sand
	20-	
SCALE: 1" =		PAGE OF

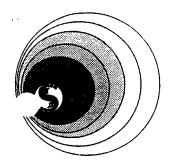

FEDERAL ID #: 91-0762274

WA CONT. #SOIL SS*344LO

Geotechnical, Engineering & Mineral Exploration Drilling • Instrumentation • Horizontal Draft Ground Water Monitoring • Hazardous Waste Identification • Well Abandonments

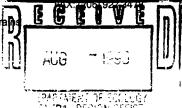

(206) 927-3173


TELEX: 466762

RESOURCE PROTECTION WELL REPORT

PROJECT NAME: <u>Ellenshurg</u> Chevron WELL IDENTIFICATION NO.: <u>Mw +2</u> DRILLING METHOD: <u>Qir rotery</u> DRILLER: <u>Harold Nisuander</u> <u>Fdu aed Kinds (4442</u> SIGNATURE: <u>Hawel</u> Nusuranda Ellenshure + Zeman assoc BEPBESENTATIVE: Tadd Lentwicth	NSTALLED: 8-7-90
REPRESENTATIVE: Todd Wentworth	DEVELOPED:

AS BUILT	FORMATION DESCRIPTION
7 8 F	o' Sand + gravel
5' H	Sand + gravel with Cobbles
1 1 1 1 1 1 1 1 1 1	12'
15"	Solly Fine Sond
<u> 20</u> -	
	A. X. S. X. M. A. M. A. A. M.

SCALE: 1" = 5'

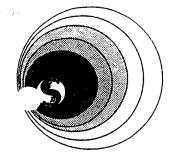

DRILLER: Harold N

REPRESENTATIVE: Todo

PROJECT NAME: <u>Ellersburg</u> <u>Chercon</u>
WELL IDENTIFICATION NO.: <u>mw-8</u>
DRILLING METHOD: <u>Qir</u> roture

SOIL SAMPLING SERVICE, INC.

1415 MERIDIAN EAST, PUYALLUP, WA 98371-1399

FEDERAL ID #: 91-0762274 WA CONT. #SOIL SS*344LO

(206) 927-3173 TELEX: 466762

FAX: (206) 927-3478

Geotechnical, Engineering & Mineral Exploration Drilling • Instrumentation • Horizontal Drains


Ground Water Monitoring • Hazardous Waste Identification • Well Abandonments

EGEIVE

RESOURCE PROTECTION WELL REPORT

	EPARTMENT OF ECOLOGY ENTRAL REGION OFFICE
	JOB #: 4 2851 START CARD NO .: 075119
	COUNTY: Kittite's CITY: Ellersburg
	LOCATION: NE 1/4 NW 1/4 1/4
_	SEC.: 2 TOWN: 171 RANGE: 15E
	DATUM:
,	WATER LEVEL ELEVATION: 9 4"
	INSTALLED: 8-7-90
	DEVELOPED:

WELL DATA	AS BUILT	FORMATION DESCRIPTION
monument	Q. F.	oʻ
e concrete	× 5,	Sand + gravel
3 chips	<u> </u>	with Cubbics
Co-0 5 a r d .	6 4 7 7 8 4 7 7 P	b' Silty Fine sand
157	15'	ÆS.
	·	

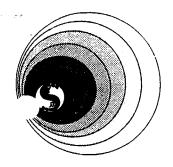

FEDERAL ID #: 91-0762274

1415 MERIDIAN EAST, PUYALLUP, WA 98371-1399

WA CONT. #SOIL SS*344LO

(206) 927-3173

TELEX: 466762

FAX: (206) 927-3478 Geotechnical, Engineering & Mineral Exploration Drilling • Instrumentation • Horizontal Prairies Ground Water Monitoring • Hazardous Waste Identification • Well Abandonments

RESOURCE PROTECTION WELL REPORT

PROJECT NAME: Ellenshing Cheuron	JOB #: 62851 START CARD NO .: 075119
WELL IDENTIFICATION NO.: 9	COUNTY: Kithiras CITY: Ellensburg LOCATION: 5 1/4 1/4 1/4
DRILLING METHOD: CLIF FOTOLY	LOCATION:
DRILLER: Harold Diswander / duraco Hints my	2 SEC.: 2 TOWN: 171 RANGE: 18E
	DATUM:
SIGNATURE: Hawd Rusward PA My	WATER LEVEL ELEVATION:
CONSULTING FIRM: Rittentouse + Zeman assec	INSTALLED: <u>\$-9-90</u>
REPRESENTATIVE: Todd wentworth	DEVELOPED:

WELL DATA	AS BUILT	FORMATION DESCRIPTION
monument	6' 4	.0
concrete	·	12
1	6 4.1x 5.74 HO	Sand & Brower Sand & Brower Cobyles
	<u> </u>	501, (**
Colorado Sand	ξ΄	Wiles
	\	/ O/O O
10-20	X,01X,	
	W-	
	020	Sifty Fine Sand
		Sand
15	16'	45´
		\$2.5 \$2.5
		The same of the sa