

January 14, 2021  
File No. 07216156.00

Ms. Tamara Welty  
Washington Department of Ecology – Toxics Cleanup Program  
Northwest Regional Office  
3190 160<sup>th</sup> Avenue Southeast  
Bellevue, WA 98008

Subject: Construction Summary for Repairs to the Landfill Gas Migration Control System at the Eastgate Landfill, Bellevue, Washington

Dear Ms.: Welty

The following provides a summary of construction activities for repair work to the landfill gas (LFG) migration control system at the former Eastgate Landfill. The City of Bellevue owns the Boeing Airfield Park located at 2997 160<sup>th</sup> Street SE, Bellevue, Washington. The park includes the former Eastgate Landfill which has a LFG migration control systems that has been in operation since the landfill closed in 1986. The City operates and maintains the environmental controls at the landfill subject to the 2008 Environmental Covenant.

This construction summary report is provided as a condition of the Work Plan approved by the Washington State Department of Ecology (Ecology). The repair work was implemented in compliance with the Environmental Protection Plan approved by Public Health - Seattle King County (July 1, 2020) and the Work Plan approved by Ecology (July 14, 2020). The repair work was supervised by John Richards of SCS Engineers (a professional engineer licensed in the State of Washington).

Repairs to the LFG migration control system were necessary to restore vacuum to a segment of the perimeter gas conveyance header pipe (and associated gas extraction wells) on the south and southeastern portion of the landfill, adjacent to the road (SE 30<sup>th</sup> Place). Differential settlement caused depressions or bellies in the LFG pipe, which resulted in LFG condensate accumulating in the bellies, restricting flow of LFG, and causing a loss of vacuum to the affected gas extraction wells.

Repair of the LFG system in the area involved replacement of the existing LFG pipe with new pipe in a new alignment and grade. The pipe that was replaced is located between the condensate drain Trap CT-6R and the cleanout access port CO-3 as shown on the attached drawings. A new condensate pump station (CT-5R2) was installed at the new low point created with the new pipe alignment and grades to replace the existing condensate drain trap CT-5R.

The construction activities commenced on July 20<sup>th</sup>, 2020 with exploratory excavation at select locations. The excavation, placement of pipe, and backfill activities occurred the week of July 27, 2020. The condensate pumps were installed in condensate trap CT-6R and new condensate pump station CT-5R2 during the week of September 14, 2020. Surface restoration with seeding and mulching occurred the week of October 5, 2020.



The following activities were implemented for the repair to the LFG migration control system:


1. Secured permit authorizations, including notification to proper parties: Public Health - Seattle King County, Advanta, Boeing, Microsoft, Department of Ecology, and the City of Bellevue.
2. Secured the work area with the installation of temporary fence to encompass the entire work area and prevent unauthorized entry.
3. Installed temporary erosion and sediment control (TESC) features. This included installation of silt fence around surface water features and installation of filter fabric on catch basin inlet grates.
4. Surveyed the alignment and grade for new pipe and components.
5. Located the existing utilities in the vicinity of the proposed work area.
6. Excavated trenches (1.5 feet to 6.0 feet deep) for inspection, repair and installation of new pipe.
  - a. Removed top layer of the final cover system soils and set aside the material for backfill. Excavated the pipe trenches to the required depth and grade.
  - b. In anticipation of encountering waste, provisions were made to manage waste encountered during excavation of the trenches. These provisions included the following:
    - i. Waste encountered would be removed and deposited in a 20- yard container located onsite.
    - ii. Waste would be sampled and analyzed for disposal as MSW, if needed.
    - iii. Waste would be sent to the proper disposal facility.
    - iv. The waste would be managed to prevent generation of leachate by direct loading into a container and covering with a tarp during periods of precipitation.
7. The following was noted during construction activities:
  - a. Waste was not encountered during the excavation process.
  - b. Groundwater was not encountered during the excavation process.
  - c. Methane gas was not detected in the work zone during construction activities.
8. Installed, connected, relocated, or decommissioned pipes, ports, and sumps, including the following:
  - a. 6-inch Dia. HDPE pipe along new alignment and grade (from CT-6R to CO-3).
  - b. 4-inch Dia. HDPE pipe along new alignment and grade (for gas extraction wells EW-4R, EW-3R, EW-2R, EW-18, EW-17, and EW-16).
  - c. 2-inch Dia. HDPE pipe for condensate discharge (in common trench with gas and air pipe).
  - d. 2-inch Dia. HDPE pipe for air supply (in common trench with gas and condensate pipe).
  - e. Decommissioned the abandoned HDPE pipe by cutting pipe and installing plugs with caps.
  - f. Relocated the cleanout access ports to a new high point on pipe grade.
  - g. Installed new condensate pump station (CT-5R2).
  - h. Connected the new pipe to existing condensate drain trap on the west end (CT-6R) and existing cleanout access port on the east end (CO-3).

- i. Installed a 2-inch Dia. HDPE pipe for condensate discharge from CT-6R and CT-5R2 to nearby sewer manhole (south of EW-17).
  - j. Connected to existing sewer manhole R11-61B.
- 9. Backfilled pipe trenches and compacted in lifts.
- 10. Imported general fill for new high points near cleanout access ports CO-3 and CO-5R, as needed.
- 11. Restored area to grade, broadcast the City of Bellevue standard seed mix over the disturbed areas, and covered with straw mulch.
- 12. Installed two pumps at condensate drain trap CT-6R and new condensate pump station CT-5R2, including:
  - a. Air supply valve trains.
  - b. Condensate discharge valve trains.
  - c. Low flow pneumatic pumps and associated hoses and fittings.

Construction activities were periodically inspected by Ted Massart and John Richards of SCS Engineers. A final inspection of the piping system was performed prior to backfill to confirm pipe depths and grades. Construction photos of these inspection activities are provided in the record drawings. Based on the construction inspection performed by SCS Engineers, the repairs to the LFG migration control system were performed in general accordance with the drawings and project requirements.

As you review the enclosed information, please contact Stephen Harquail at (503) 867-2369 or Ted Massart (425) 864-2146 if you have questions or comments.

Sincerely,

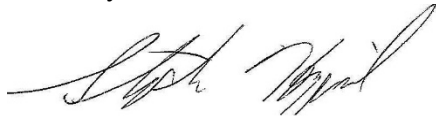

Stephen Harquail  
Project Manager  
SCS Field Services



Ted Massart  
Sr. Project Engineer  
SCS Engineers



John Richards  
Vice President  
SCS Engineers



cc: Mark Schwisow – City of Bellevue  
Tony Svorinich – SCS Field Services  
Greg Helland – SCS Engineers

Attachments:

Record Drawings – Landfill Gas Control System Modifications, Eastgate Landfill, September 18, 2020, SCS Engineers



# LANDFILL GAS CONTROL SYSTEM MODIFICATIONS EASTGATE LANDFILL

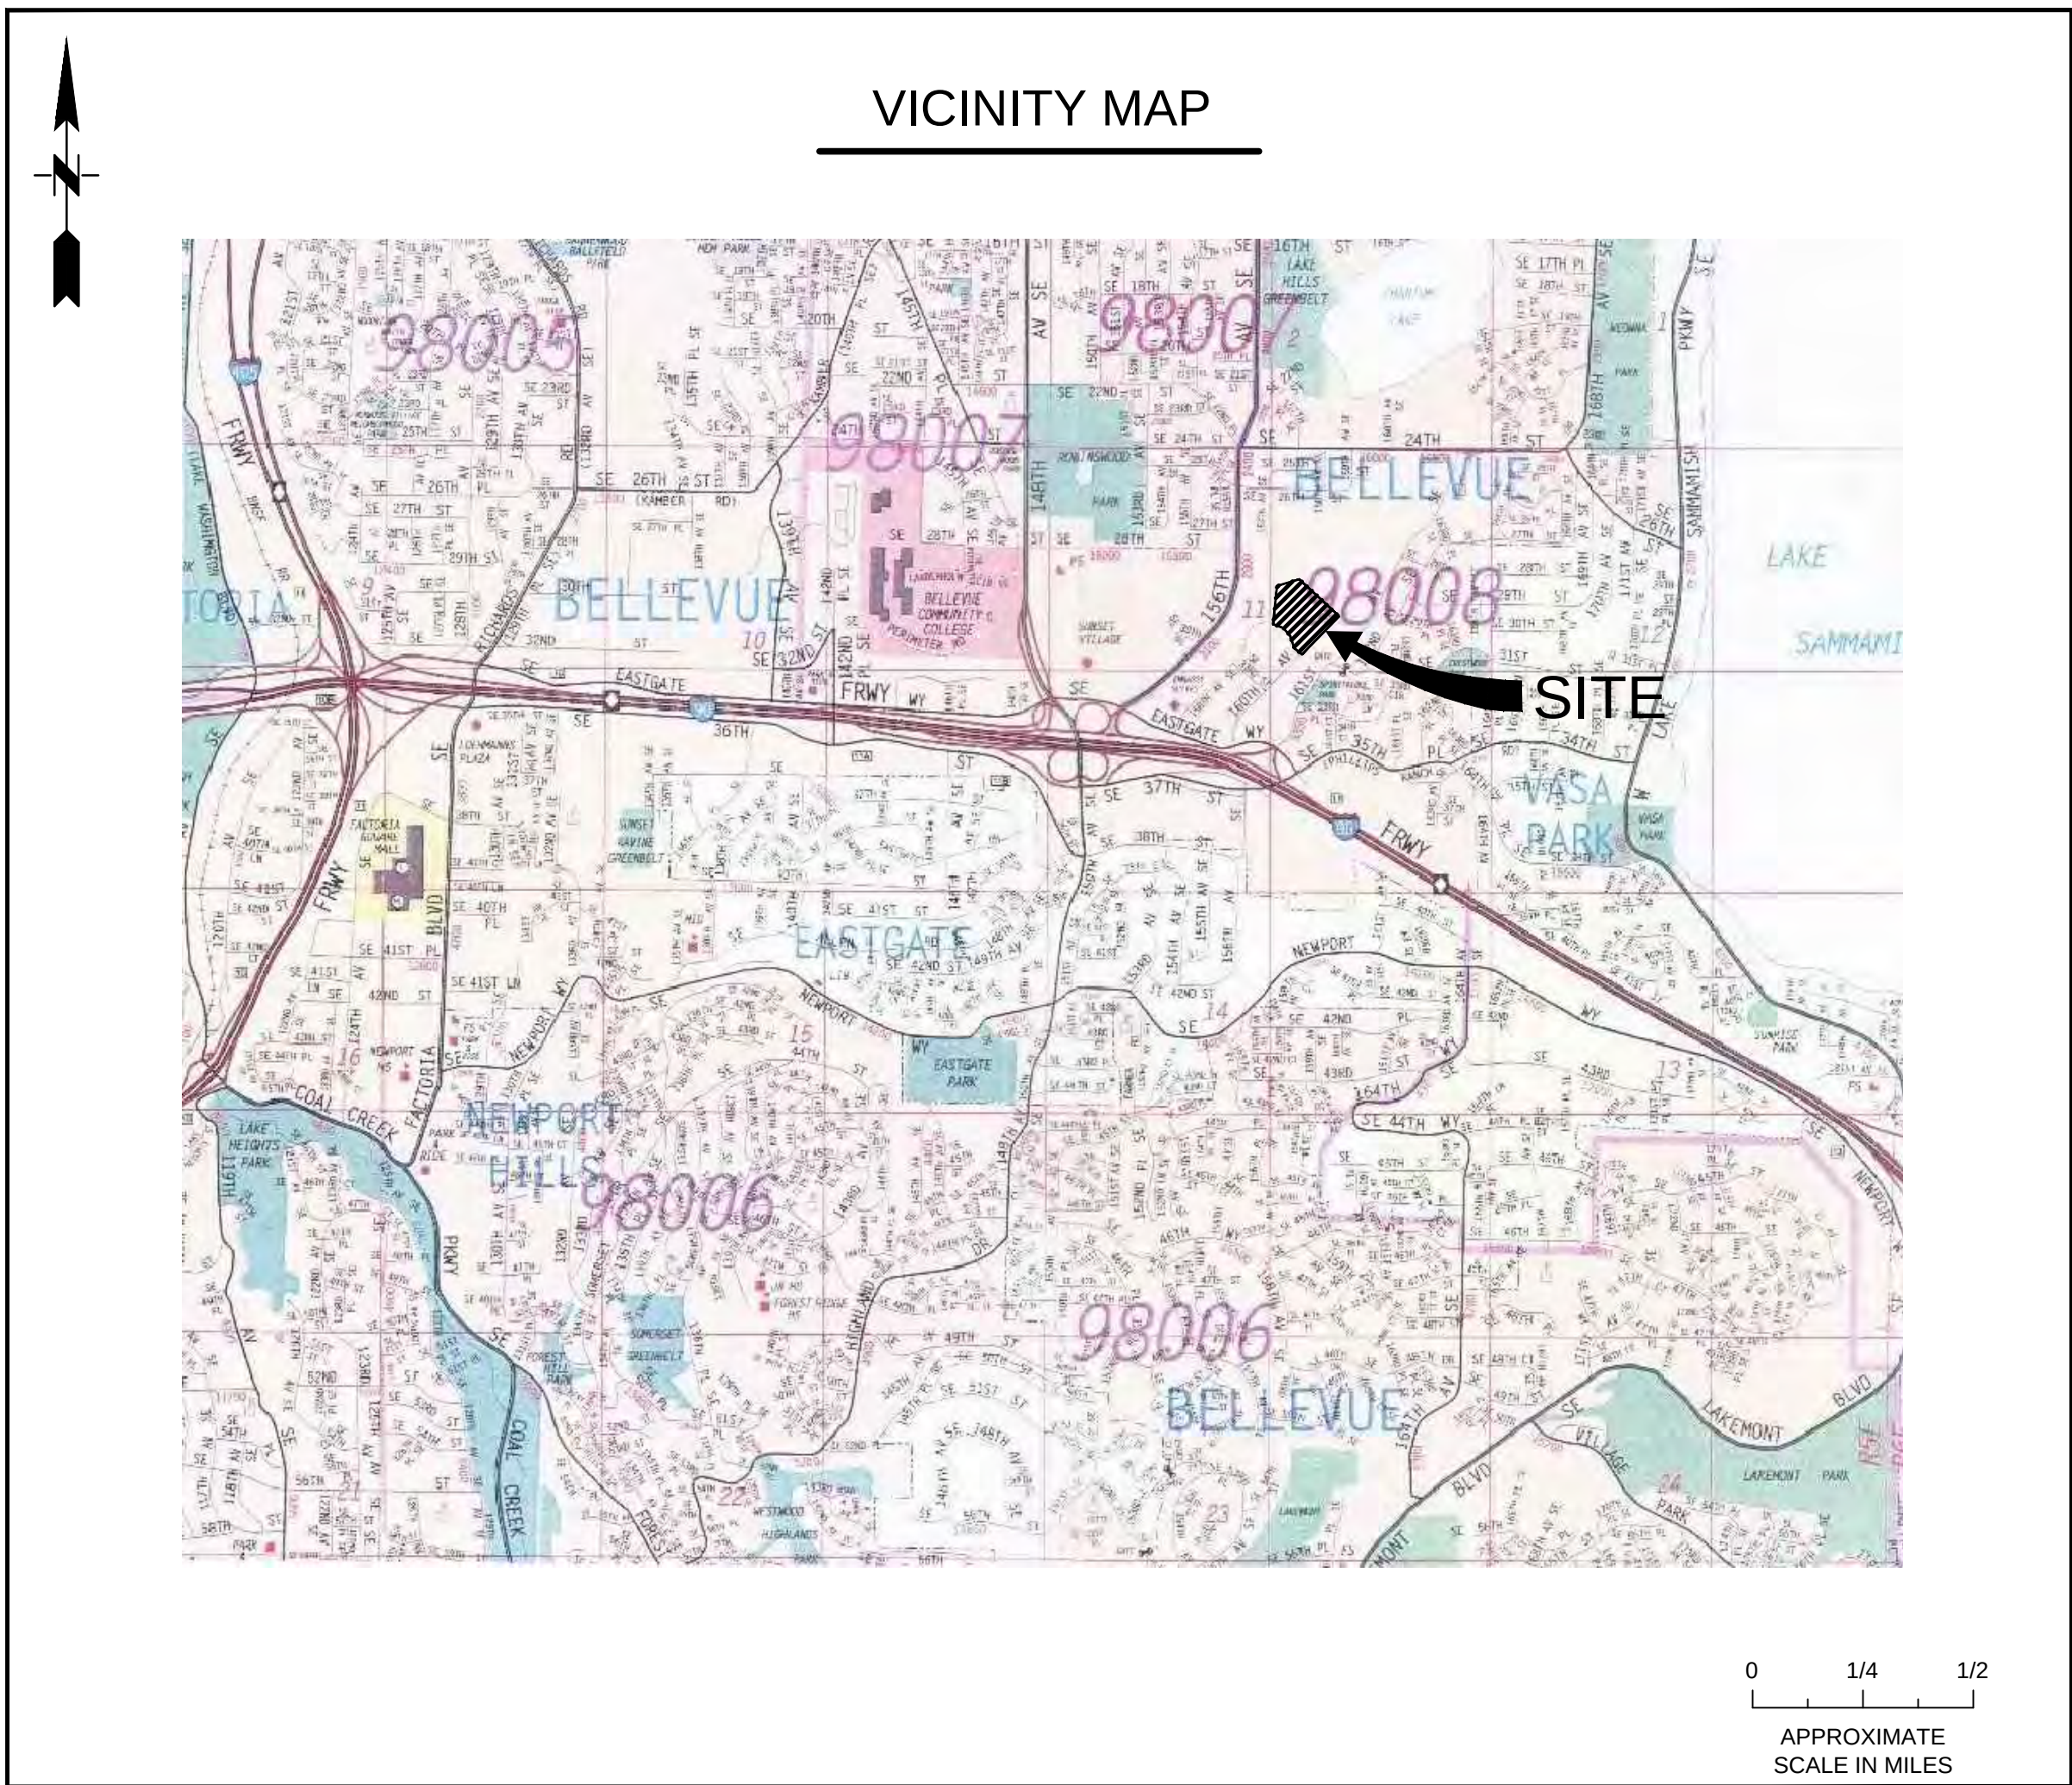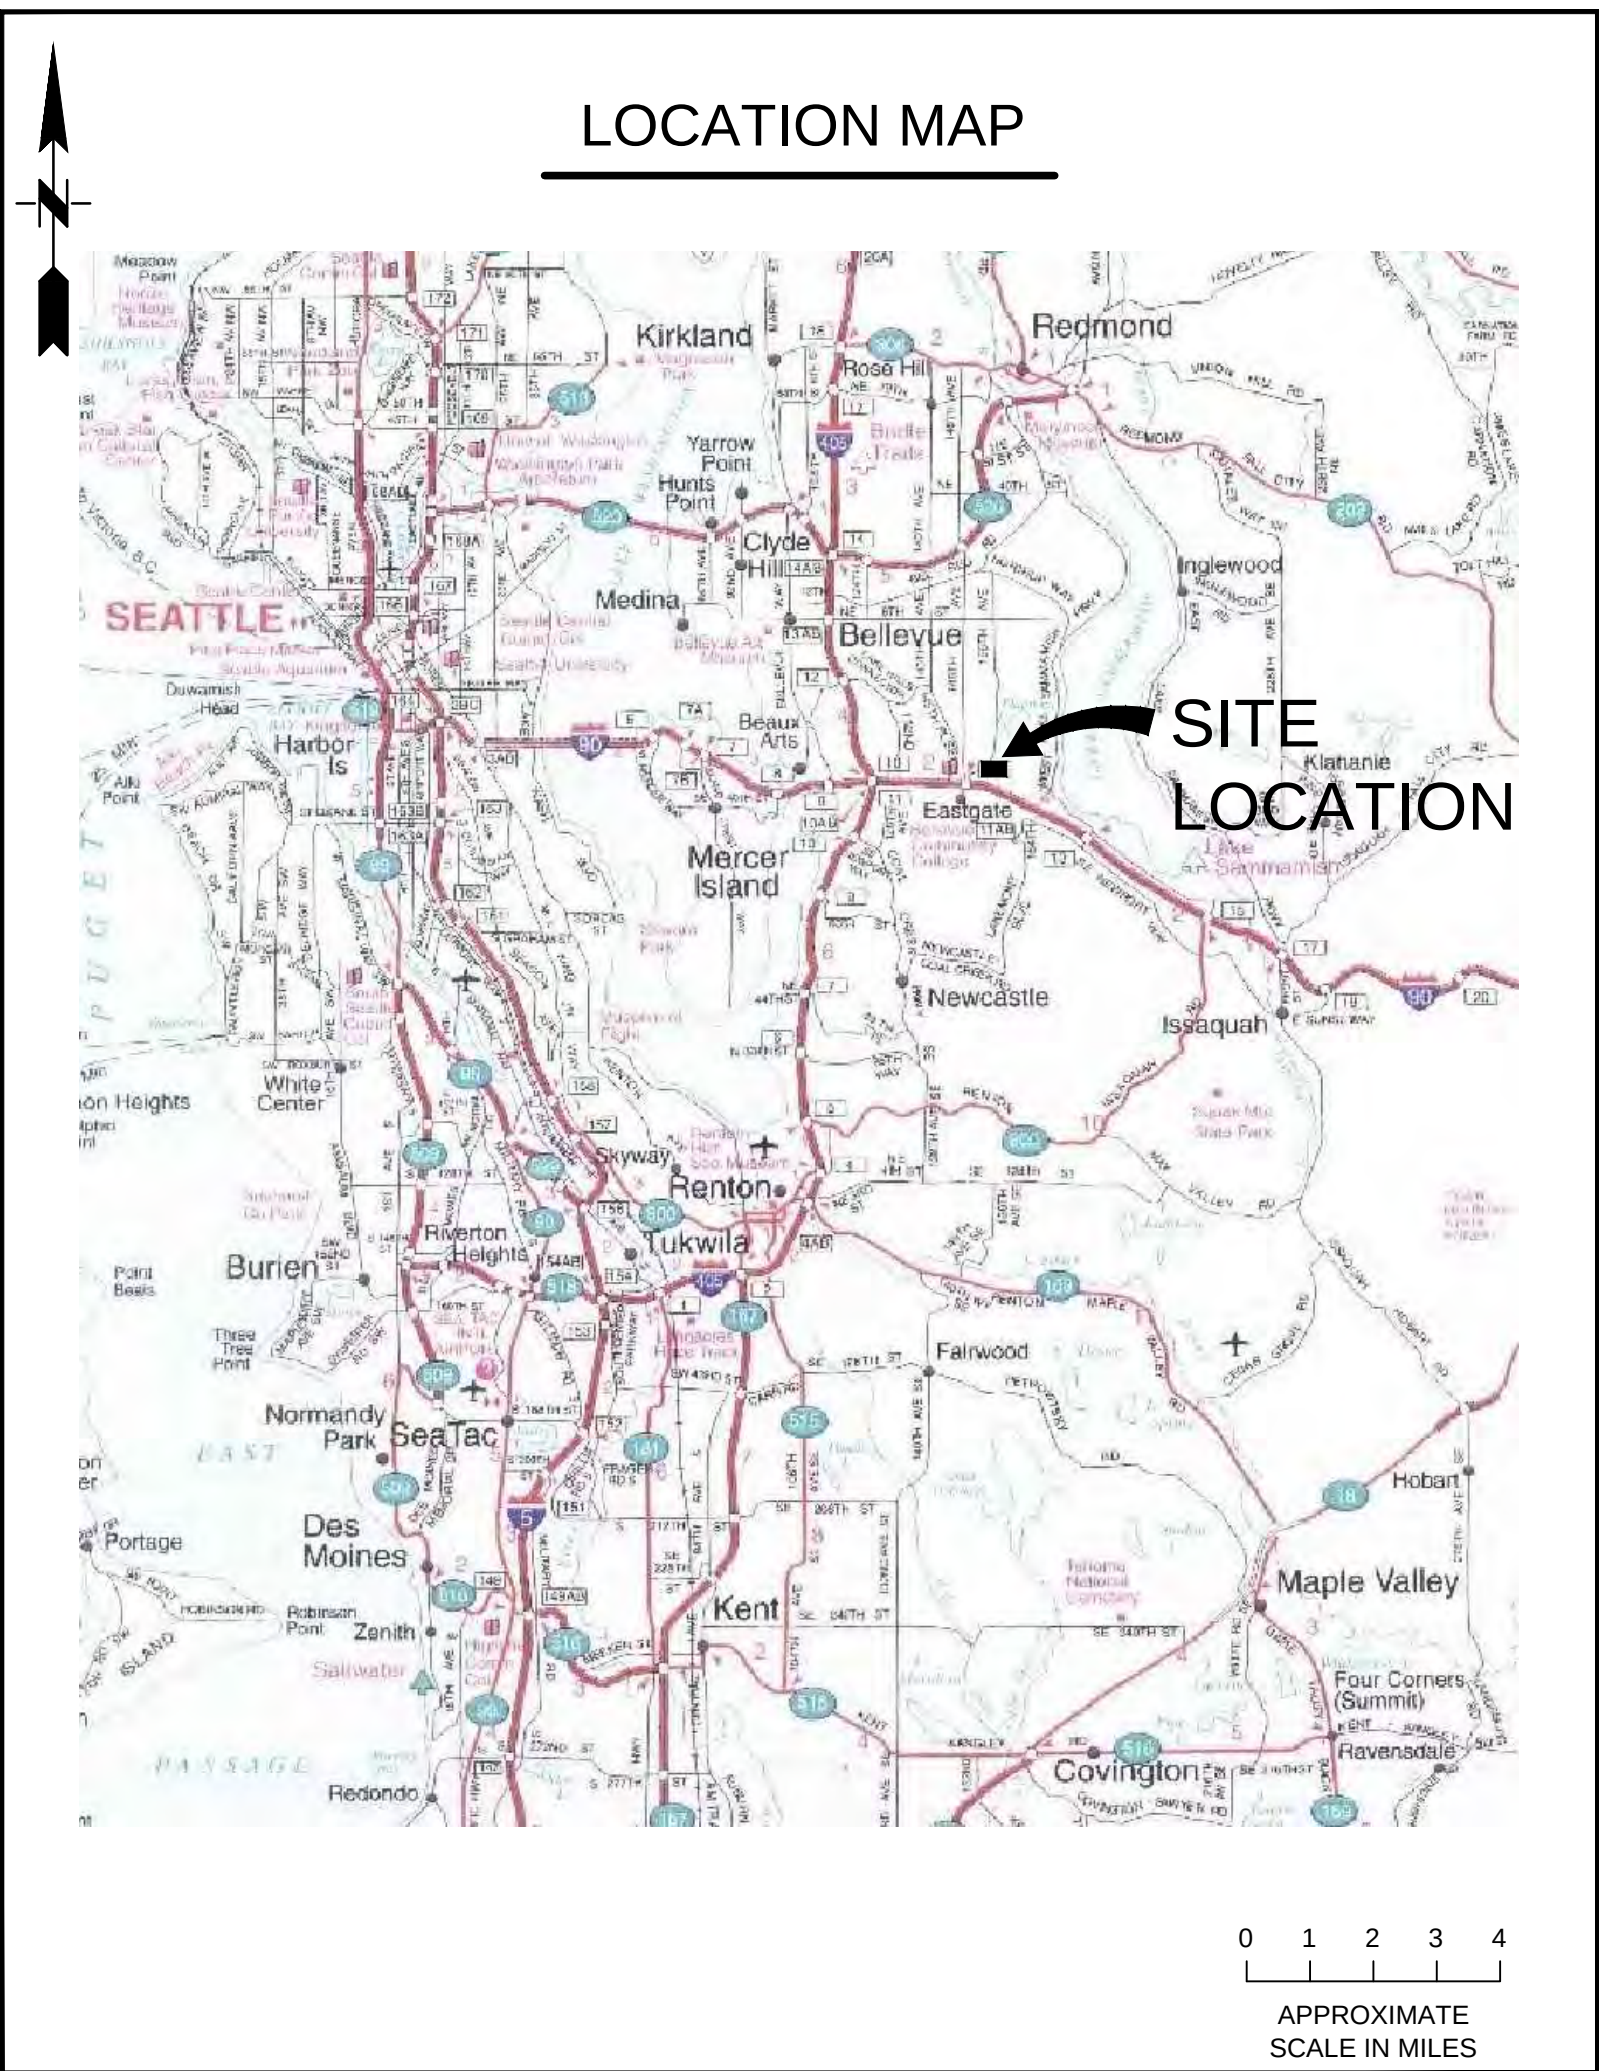

DRAWING INDEX


|    |                                               |
|----|-----------------------------------------------|
| G1 | COVER SHEET                                   |
| C1 | EXISTING LFG CONTROL SYSTEM                   |
| C2 | GAS EXTRACTION NETWORK<br>AND PIPING PLAN     |
| C3 | GAS AND CONDENSATE<br>CONVEYANCE PIPE DETAILS |
| -- | REFERENCE DRAWING<br>(TOPOGRAPHIC SURVEY)     |

RECORD DRAWING

THIS DRAWING IS A RECORD COMPILING THE DESIGN INFORMATION, FIELD CHANGES, AND SURVEY INFORMATION USED DURING CONSTRUCTION OF THE FACILITY. THE INTENT IS TO PROVIDE THE OWNER WITH A DOCUMENT TO FACILITATE THE OPERATION, MAINTENANCE, AND POSSIBLE FUTURE MODIFICATIONS DURING THE LIFE OF THE FACILITY. THIS RECORD DRAWING MAY NOT BE AN EXACT AND PRECISE DEPICTION OF THE FACILITY. NEITHER SCS NOR THE PROFESSIONAL ENGINEER ASSUMES LIABILITY OR RESPONSIBILITY FOR ANY ACTION OR ACTIVITY BASED UPON THIS DRAWING. IF NECESSARY, FIELD VERIFY THE FEATURES ON THIS DRAWING.

|                                                                                                                                                                                                                                                                                                                         |  |                                                                                       |  |             |     |          |      |
|-------------------------------------------------------------------------------------------------------------------------------------------------------------------------------------------------------------------------------------------------------------------------------------------------------------------------|--|---------------------------------------------------------------------------------------|--|-------------|-----|----------|------|
| <div>SCS ENGINEERS</div> <div>Environmental Consultants and Contractors</div> <div>2405 140th Avenue NE, Suite 107<br/>Bellevue, Washington 98005<br/>(425) 746-4600 FAX: (509) 684-6948</div> <div>PROJ. NO. 07216156-00    DWN. BY: LEL    ACAD. FILE: GLD.WGS<br/>DSN. BY: TAM    CHK. BY: TAM    APP. BY: JMR</div> |  | SHEET TITLE                                                                           |  | COVER SHEET | NO. | REVISION | DATE |
|                                                                                                                                                                                                                                                                                                                         |  | PROJECT TITLE                                                                         |  |             |     |          |      |
|                                                                                                                                                                                                                                                                                                                         |  | LANDFILL GAS CONTROL SYSTEM<br>MODIFICATIONS<br>EASTGATE LANDFILL                     |  |             |     |          |      |
|                                                                                                                                                                                                                                                                                                                         |  |  |  |             |     |          |      |
|                                                                                                                                                                                                                                                                                                                         |  |                                                                                       |  |             |     |          |      |
| DATE: SEPTEMBER 2020                                                                                                                                                                                                                                                                                                    |  |                                                                                       |  |             |     |          |      |
| SCALE: AS SHOWN                                                                                                                                                                                                                                                                                                         |  |                                                                                       |  |             |     |          |      |
| DRAWING NO. G1                                                                                                                                                                                                                                                                                                          |  |                                                                                       |  |             |     |          |      |



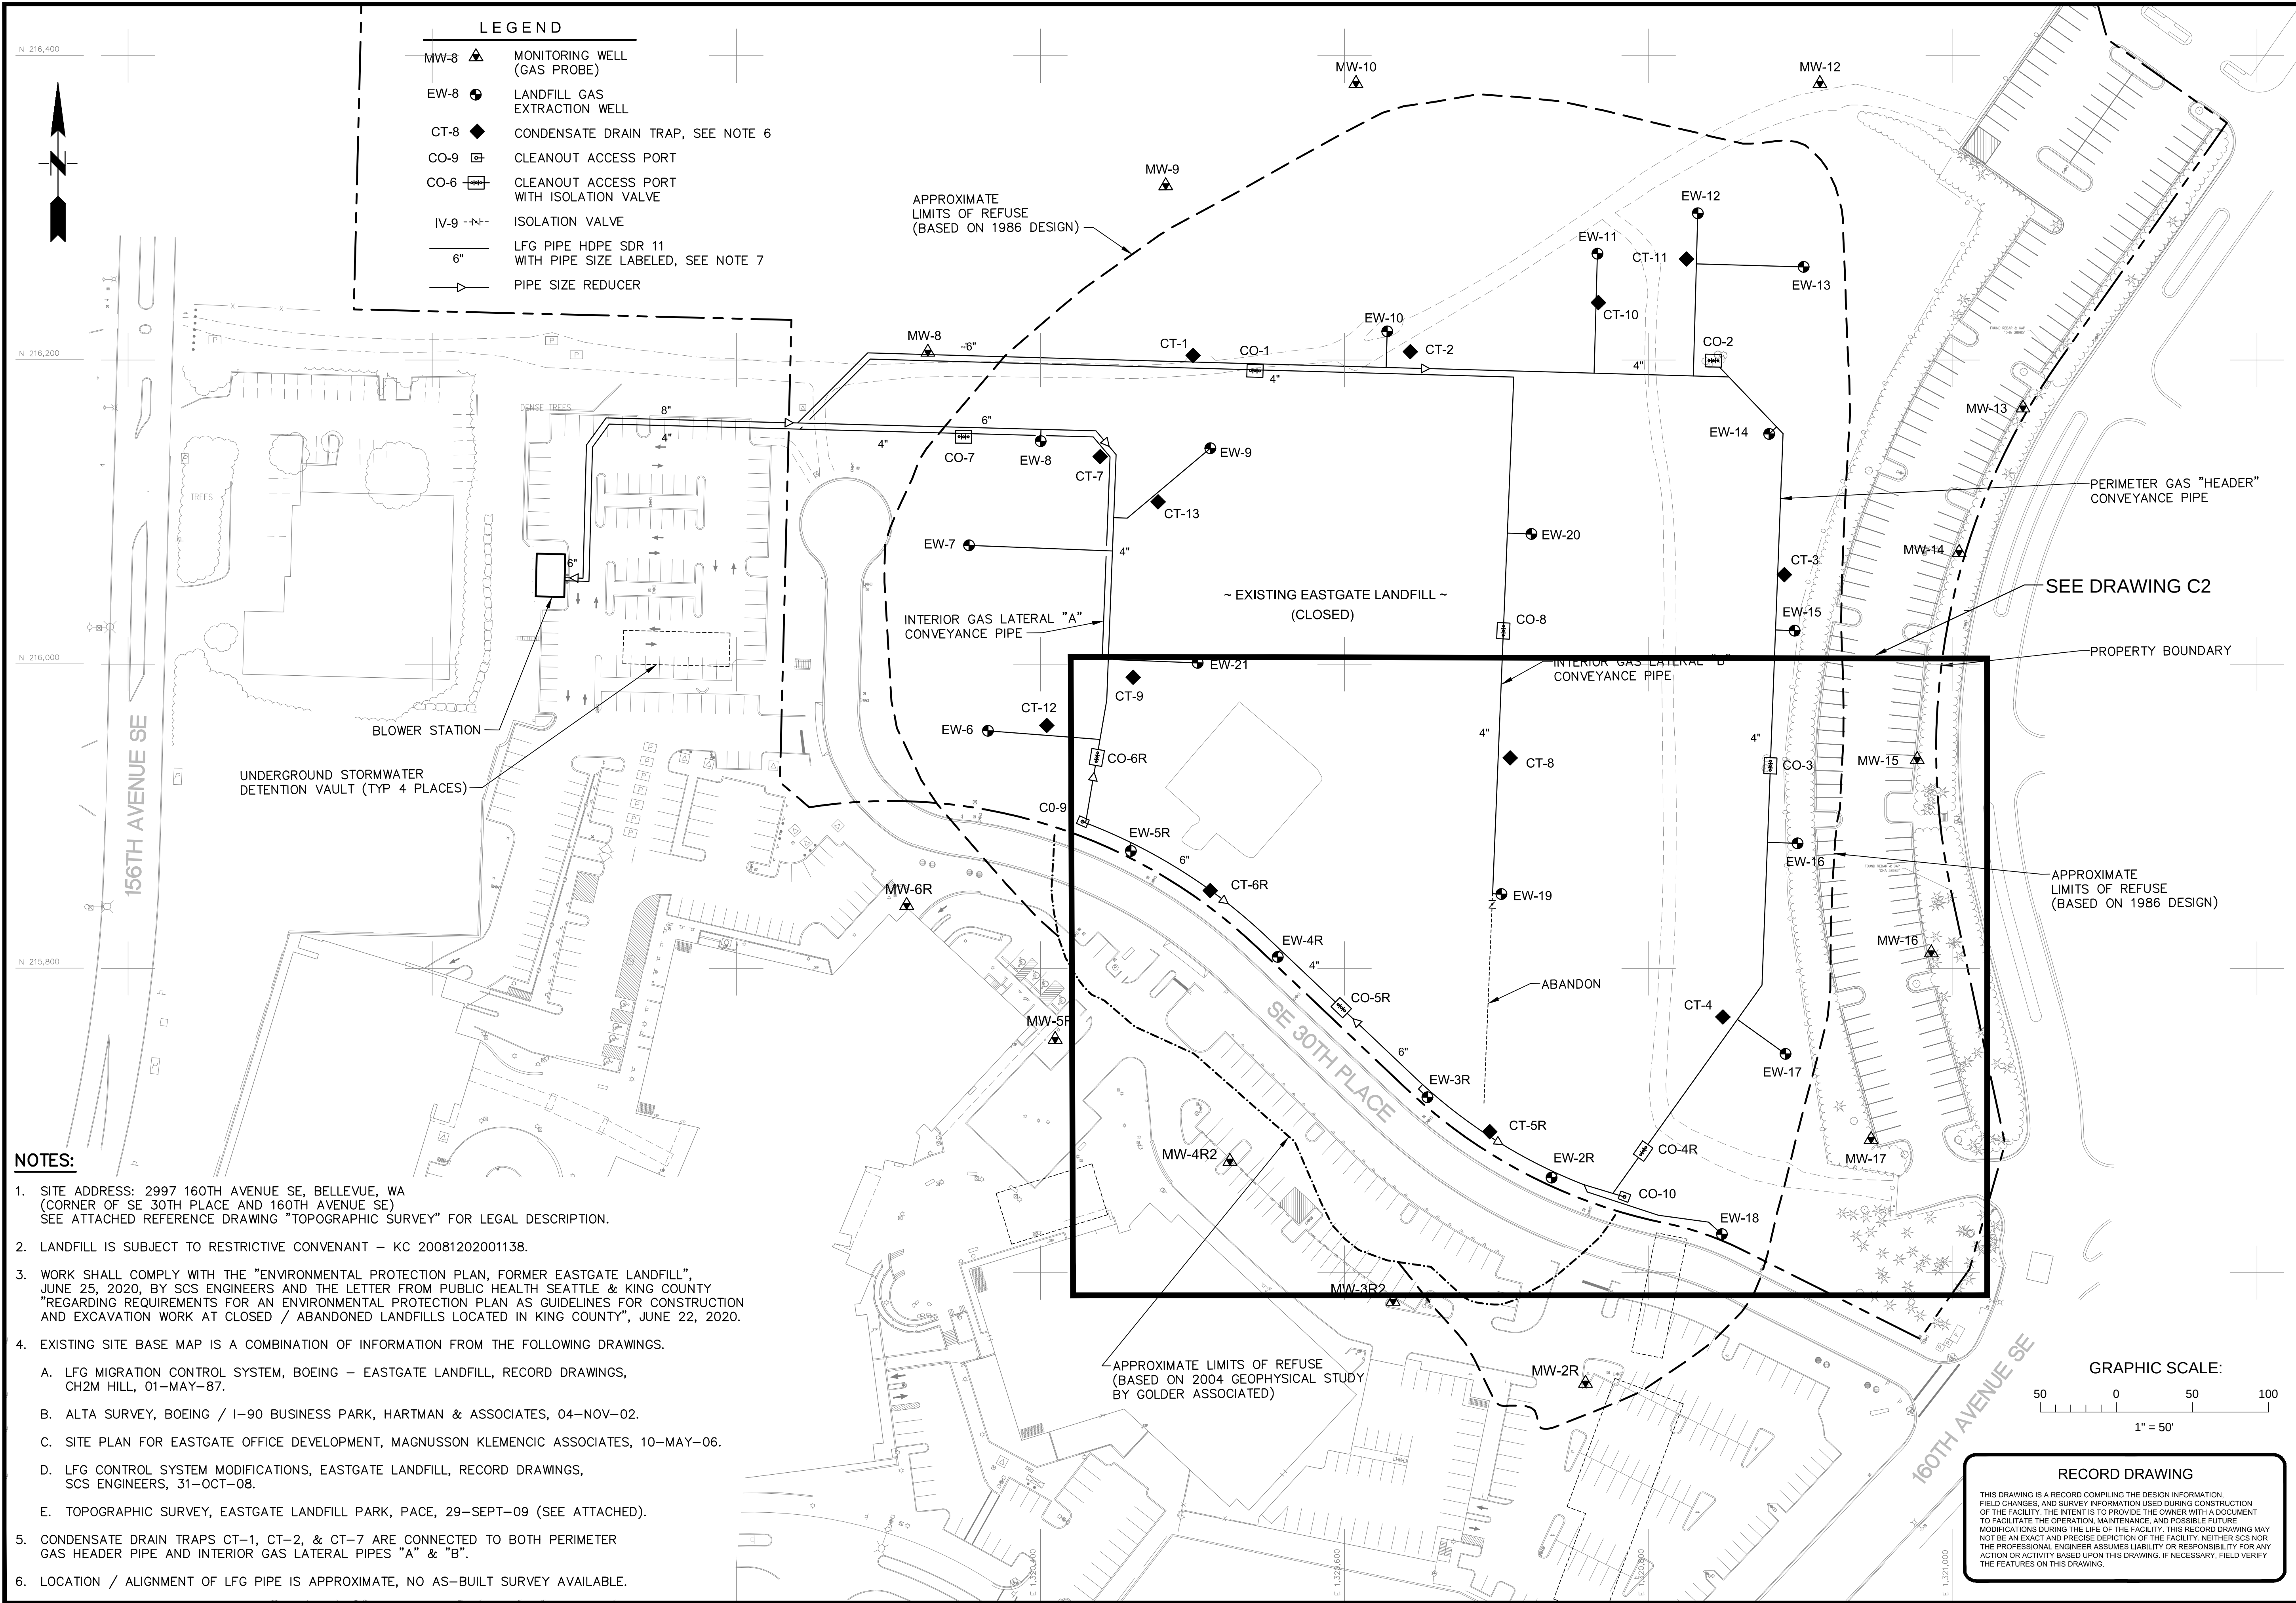

NOTES:

- SITE ADDRESS: 2997 160TH AVENUE SE, BELLEVUE, WA (CORNER OF SE 30TH PLACE AND 160TH AVENUE SE) SEE ATTACHED REFERENCE DRAWING "TOPOGRAPHIC SURVEY" FOR LEGAL DESCRIPTION.
- LANDFILL IS SUBJECT TO RESTRICTIVE CONVEYANCE – KC 20081202001138.
- WORK SHALL COMPLY WITH THE "ENVIRONMENTAL PROTECTION PLAN, FORMER EASTGATE LANDFILL", JUNE 25, 2020, BY SCS ENGINEERS AND THE LETTER FROM PUBLIC HEALTH SEATTLE & KING COUNTY "REGARDING REQUIREMENTS FOR AN ENVIRONMENTAL PROTECTION PLAN AS GUIDELINES FOR CONSTRUCTION AND EXCAVATION WORK AT CLOSED / ABANDONED LANDFILLS LOCATED IN KING COUNTY", JUNE 22, 2020.
- EXISTING SITE BASE MAP IS A COMBINATION OF INFORMATION FROM THE FOLLOWING DRAWINGS.
  - LFG MIGRATION CONTROL SYSTEM, BOEING – EASTGATE LANDFILL, RECORD DRAWINGS, CH2M HILL, 01–MAY–87.
  - ALTA SURVEY, BOEING / I-90 BUSINESS PARK, HARTMAN & ASSOCIATES, 04–NOV–02.
  - SITE PLAN FOR EASTGATE OFFICE DEVELOPMENT, MAGNUSSON KLEMENCIC ASSOCIATES, 10–MAY–06.
  - LFG CONTROL SYSTEM MODIFICATIONS, EASTGATE LANDFILL, RECORD DRAWINGS, SCS ENGINEERS, 31–OCT–08.
  - TOPOGRAPHIC SURVEY, EASTGATE LANDFILL PARK, PACE, 29–SEPT–09 (SEE ATTACHED).
- CONDENSATE DRAIN TRAPS CT-1, CT-2, & CT-7 ARE CONNECTED TO BOTH PERIMETER GAS HEADER PIPE AND INTERIOR GAS LATERAL PIPES "A" & "B".
- LOCATION / ALIGNMENT OF LFG PIPE IS APPROXIMATE, NO AS-BUILT SURVEY AVAILABLE.

RECORD DRAWING

THIS DRAWING IS A RECORD COMPILING THE DESIGN INFORMATION, FIELD CHANGES, AND SURVEY INFORMATION USED DURING CONSTRUCTION OF THE FACILITY. THE INTENT IS TO PROVIDE THE OWNER WITH A DOCUMENT TO FACILITATE THE OPERATION, MAINTENANCE, AND POSSIBLE FUTURE MODIFICATIONS DURING THE LIFE OF THE FACILITY. THIS RECORD DRAWING MAY NOT BE AN EXACT AND PRECISE DEPICTION OF THE FACILITY. NEITHER SCS NOR THE PROFESSIONAL ENGINEER ASSUMES LIABILITY OR RESPONSIBILITY FOR ANY ACTION OR ACTIVITY BASED UPON THIS DRAWING. IF NECESSARY, FIELD VERIFY THE FEATURES ON THIS DRAWING.

|            |  |                          |  |     |  |
|------------|--|--------------------------|--|-----|--|
| DATE       |  | REVISION                 |  | NO. |  |
| 06/17/2020 |  | ISSUED FOR CLIENT REVIEW |  | A   |  |
| 06/17/2020 |  | ISSUED FOR AGENCY REVIEW |  | B   |  |
| 06/25/2020 |  | ISSUED FOR AGENCY REVIEW |  | C   |  |
| 07/20/2020 |  | ISSUED FOR CONSTRUCTION  |  | D   |  |
| 09/18/2020 |  | RECORD DRAWINGS          |  | A   |  |

EXISTING LFG CONTROL SYSTEM

LANDFILL GAS CONTROL SYSTEM MODIFICATIONS EASTGATE LANDFILL

SCS ENGINEERS

Environmental Consultants and Contractors

2405 140th Avenue NE, Suite 107  
Bellevue, Washington 98005  
(425) 746-4600 FAX: (503) 684-6948

PROJ. NO. 07216156.00  
CON. BY: TAM  
APP. BY: JMR


ACAD. FILE: C1.dwg  
LEL  
TAM

DATE: SEPTEMBER 2020

SCALE: AS SHOWN

DRAWING NO. C1



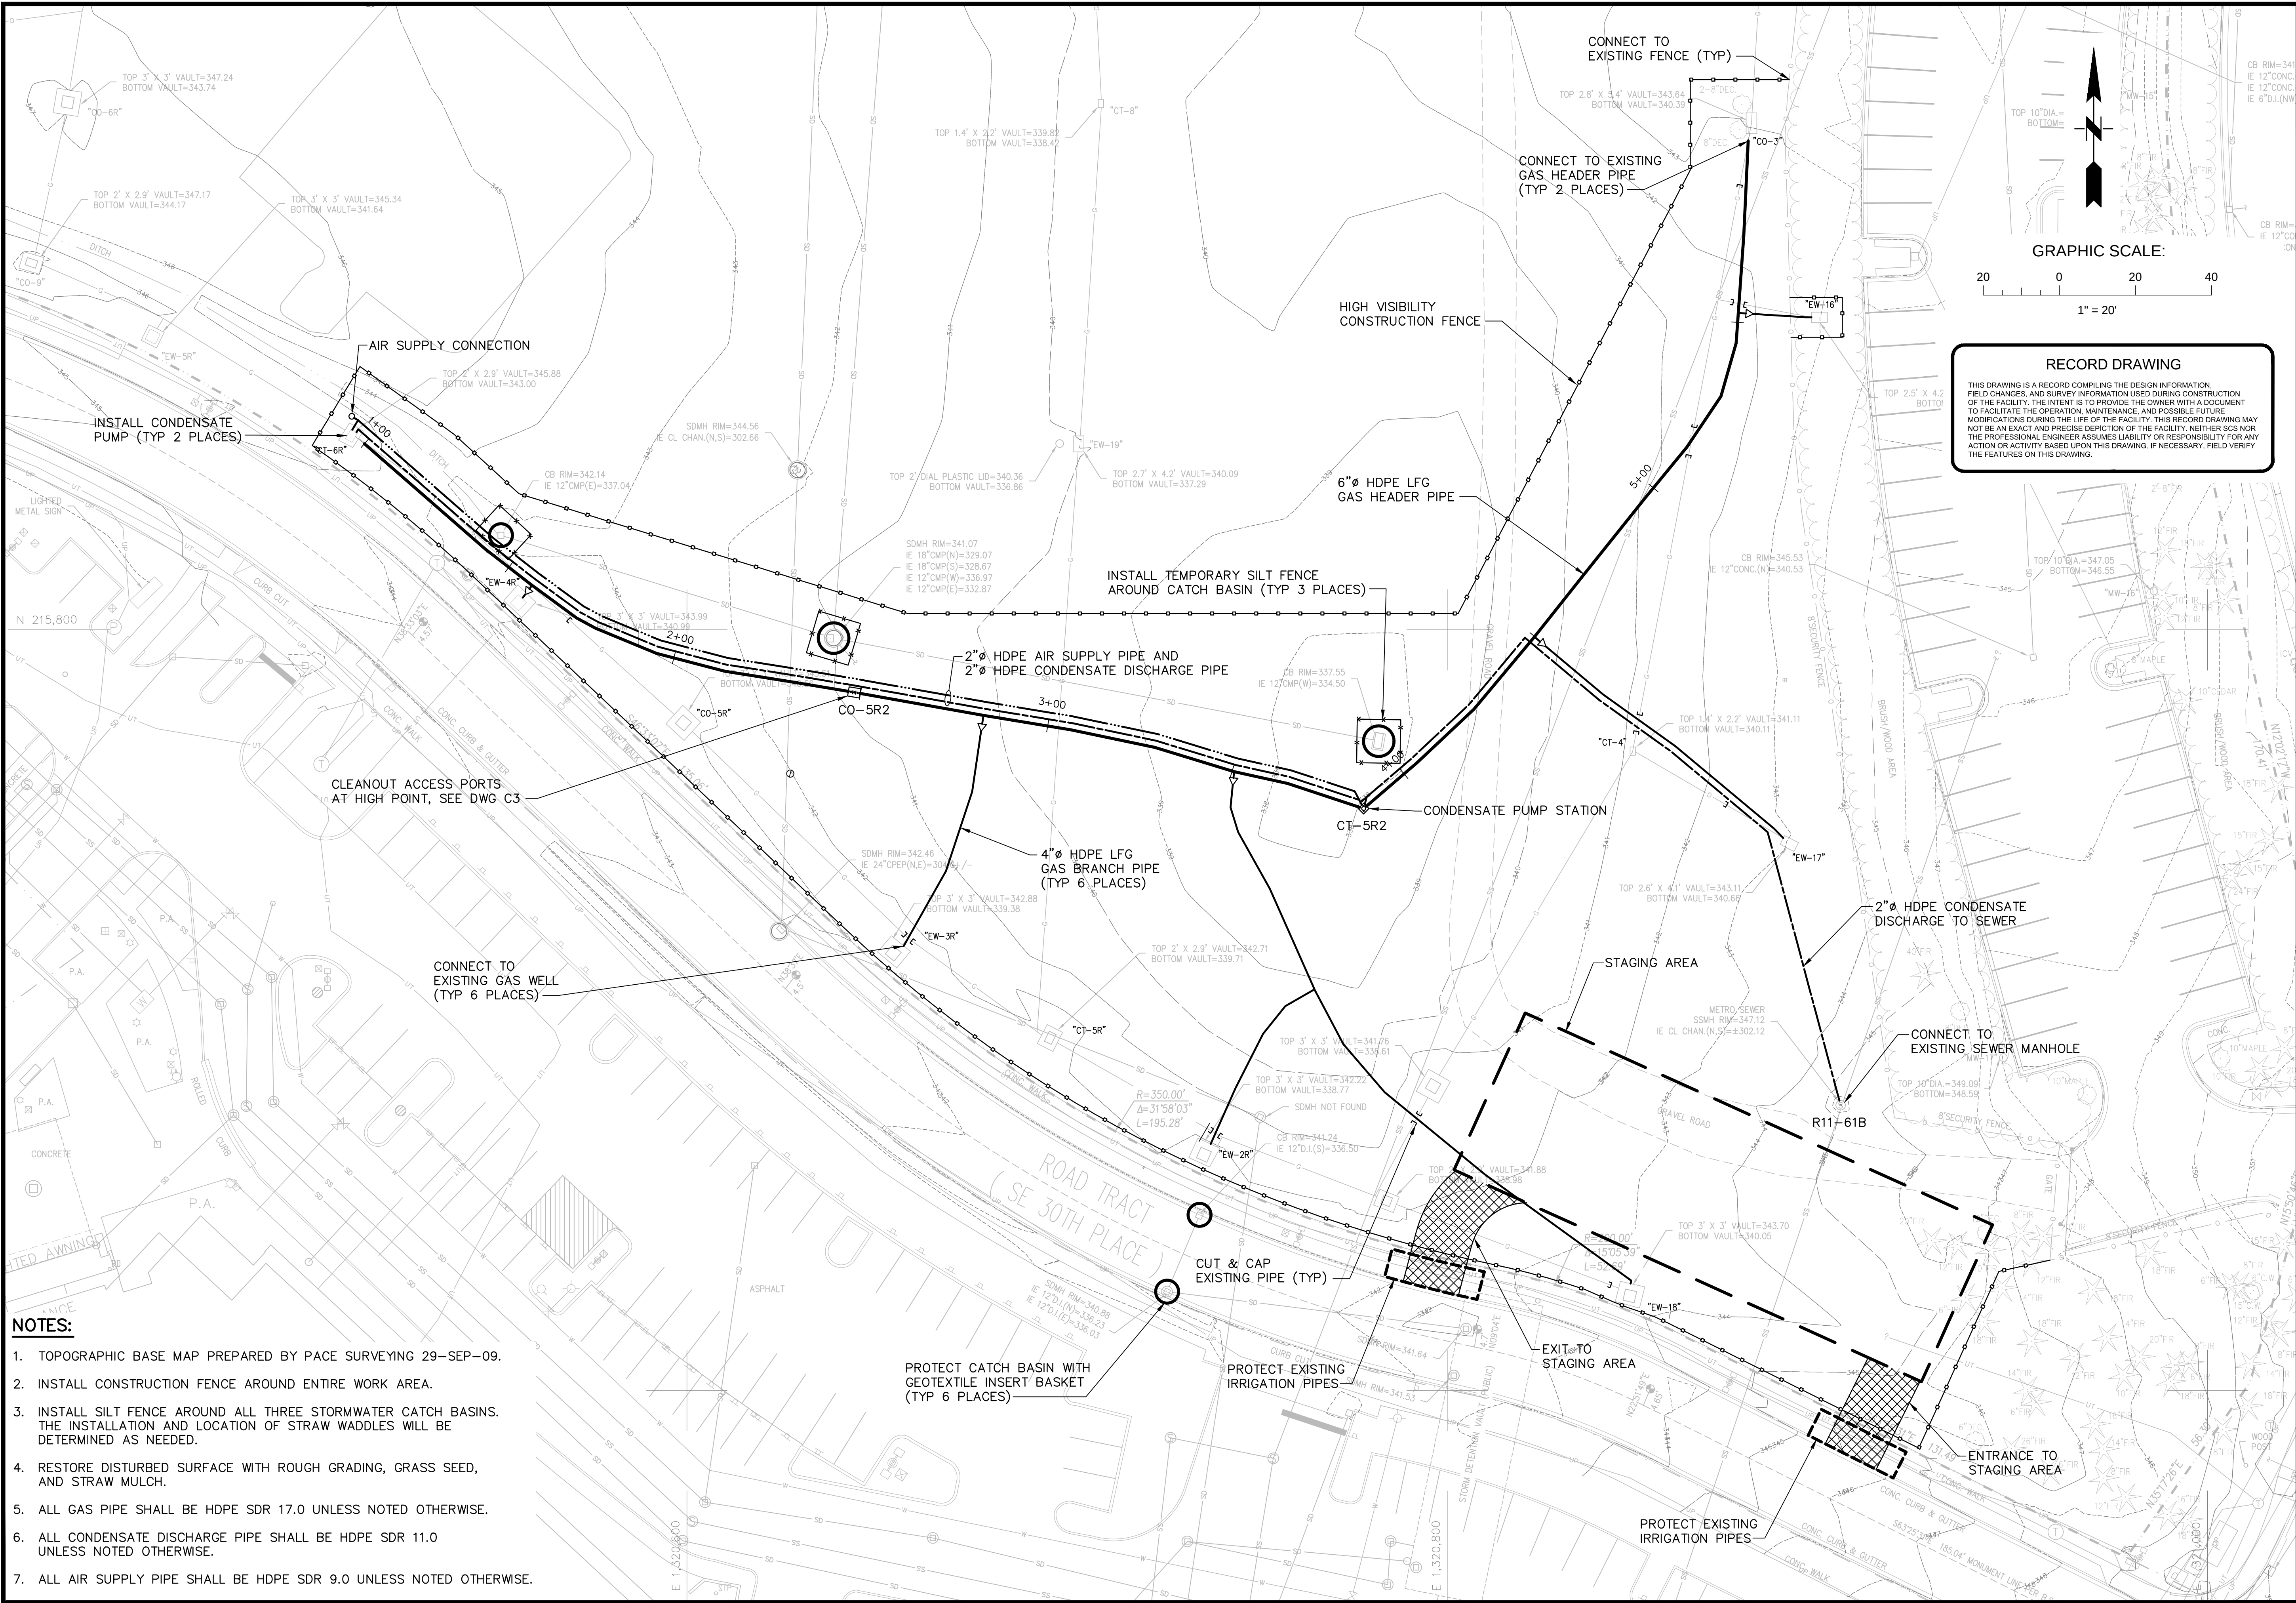

NOTES:

1. TOPOGRAPHIC BASE MAP PREPARED BY PACE SURVEYING 29-SEP-09.
2. INSTALL CONSTRUCTION FENCE AROUND ENTIRE WORK AREA.
3. INSTALL SILT FENCE AROUND ALL THREE STORMWATER CATCH BASINS. THE INSTALLATION AND LOCATION OF STRAW WADDLES WILL BE DETERMINED AS NEEDED.
4. RESTORE DISTURBED SURFACE WITH ROUGH GRADING, GRASS SEED, AND STRAW MULCH.
5. ALL GAS PIPE SHALL BE HDPE SDR 17.0 UNLESS NOTED OTHERWISE.
6. ALL CONDENSATE DISCHARGE PIPE SHALL BE HDPE SDR 11.0 UNLESS NOTED OTHERWISE.
7. ALL AIR SUPPLY PIPE SHALL BE HDPE SDR 9.0 UNLESS NOTED OTHERWISE.

**RECORD DRAWING**

THIS DRAWING IS A RECORD COMPILING THE DESIGN INFORMATION, FIELD CHANGES, AND SURVEY INFORMATION USED DURING CONSTRUCTION OF THE FACILITY. THE INTENT IS TO PROVIDE THE OWNER WITH A DOCUMENT TO FACILITATE THE OPERATION, MAINTENANCE, AND POSSIBLE FUTURE MODIFICATIONS DURING THE LIFE OF THE FACILITY. THIS RECORD DRAWING MAY NOT BE AN EXACT AND PRECISE DEPICTION OF THE FACILITY. NEITHER SCS NOR THE PROFESSIONAL ENGINEER ASSUMES LIABILITY OR RESPONSIBILITY FOR ANY ACTION OR ACTIVITY BASED UPON THIS DRAWING. IF NECESSARY, FIELD VERIFY THE FEATURES ON THIS DRAWING.


| REVISION |                          | DATE       |
|----------|--------------------------|------------|
| 1        | ISSUED FOR CLIENT REVIEW | 06/11/2020 |
| 2        | ISSUED FOR AGENCY REVIEW | 06/17/2020 |
| 3        | ISSUED FOR AGENCY REVIEW | 06/25/2020 |
| 4        | ISSUED FOR CONSTRUCTION  | 07/20/2020 |
| 5        | RECORD DRAWINGS          | 09/18/2020 |

| SHEET TITLE                                                    |  |
|----------------------------------------------------------------|--|
| GAS EXTRACTION NETWORK AND PIPING PLAN                         |  |
| PROJECT TITLE                                                  |  |
| LANDFILL GAS CONTROL SYSTEM MODIFICATIONS<br>EASTGATE LANDFILL |  |

|                                                                                                                                                                          |                 |
|--------------------------------------------------------------------------------------------------------------------------------------------------------------------------|-----------------|
|                                                                                                                                                                          |                 |
| <b>SCS ENGINEERS</b><br>Environmental Consultants and Contractors<br>2405 140th Avenue NE, Suite 107<br>Bellevue, Washington 98005<br>(425) 746-4600 FAX: (509) 884-6948 |                 |
| PROJ. NO. 07216156.00                                                                                                                                                    | APP. BY: JMR    |
| DSN. BY: TAM                                                                                                                                                             | CHK. BY: TAM    |
| DWN. BY: LEL                                                                                                                                                             | APP. BY: C2.ENG |

|             |                |
|-------------|----------------|
| DATE:       | SEPTEMBER 2020 |
| SCALE:      | AS SHOWN       |
| DRAWING NO. | C2             |



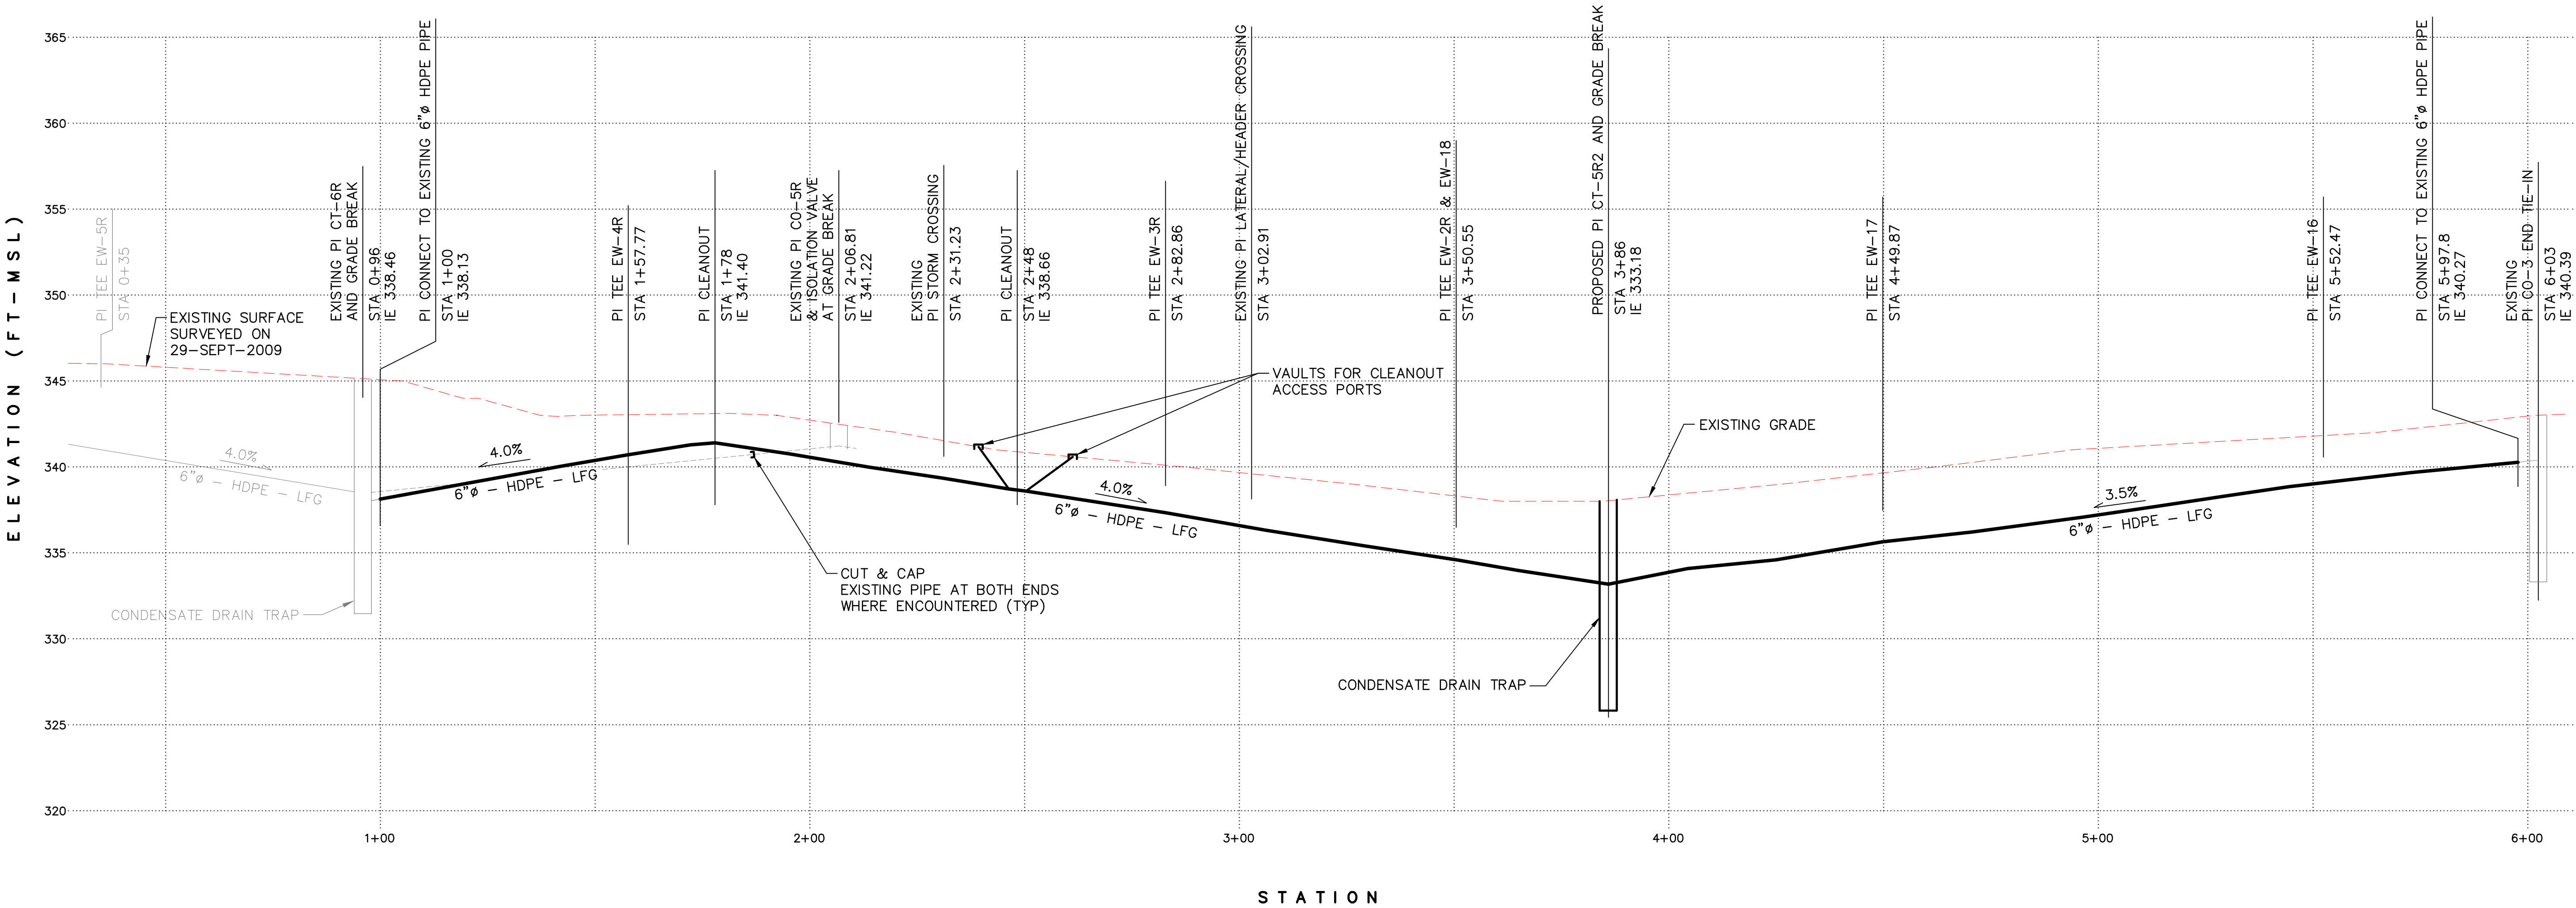


**GAS HEADER PIPE PROFILE**

SCALE: HORIZ 1" = 20'  
VERT 1" = 5'

**NOTES:**

- ALL GAS PIPE SHALL BE HDPE SDR 17.0 UNLESS NOTED OTHERWISE.
- ALL CONDENSATE DISCHARGE PIPE SHALL BE HDPE SDR 11.0 UNLESS NOTED OTHERWISE.
- ALL AIR SUPPLY PIPE SHALL BE HDPE SDR 9.0 UNLESS NOTED OTHERWISE.
- CONDENSATE DISCHARGE PIPE AND AIR SUPPLY PIPE TO BE INSTALLED IN A COMMON TRENCH WITH GAS CONVEYANCE PIPE. SEE DRAWING C2.
- SET ASIDE TOP 3 FEET OF SOIL FOR FINAL BACKFILL AND COVER SOIL RESTORATION.
- PROVIDE SHORING, BENCHING, AND/OR SLOPING FOR EXCAVATION DEEPER THAN 4 FEET IN COMPLIANCE WITH APPLICABLE REGULATIONS.
- REFUSE ENCOUNTERED DURING EXCAVATION SHALL BE PLACED IN A CONTAINED AREA FOR SAMPLING AND ANALYSIS.
- REFUSE SHALL BE HAULED OFF SITE TO AN APPROVED DISPOSAL FACILITY.

GRAPHIC SCALE:

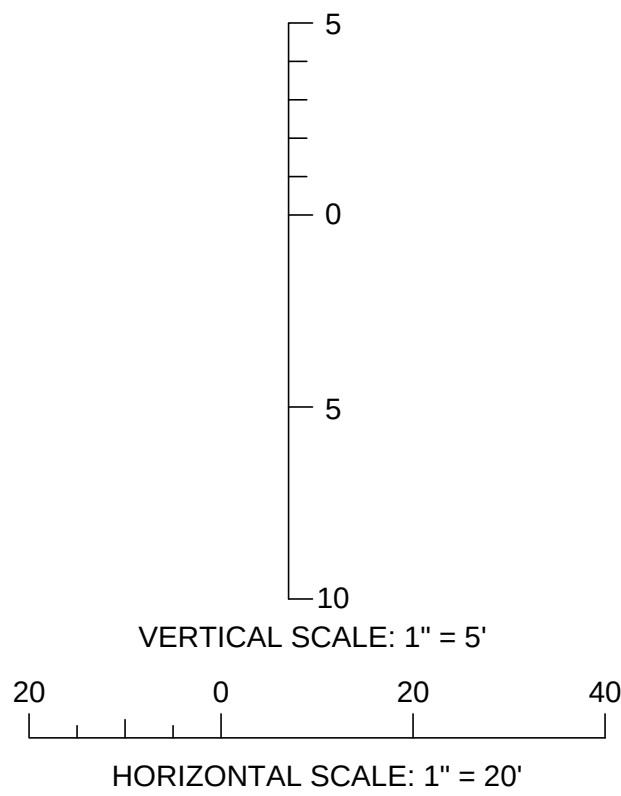


**RECORD DRAWING**

THIS DRAWING IS A RECORD COMPILING THE DESIGN INFORMATION, FIELD CHANGES, AND SURVEY INFORMATION USED DURING CONSTRUCTION OF THE FACILITY. THE INTENT IS TO PROVIDE THE OWNER WITH A DOCUMENT TO FACILITATE THE OPERATION, MAINTENANCE, AND POSSIBLE FUTURE MODIFICATIONS DURING THE LIFE OF THE FACILITY. THIS RECORD DRAWING MAY NOT BE AN EXACT AND PRECISE DEPICTION OF THE FACILITY. NEITHER SCS NOR THE PROFESSIONAL ENGINEER ASSUMES LIABILITY OR RESPONSIBILITY FOR ANY ACTION OR ACTIVITY BASED UPON THIS DRAWING. IF NECESSARY, FIELD VERIFY THE FEATURES ON THIS DRAWING.

|                                                                                                                                                                                                                                                                                                                                                          |                                                                                       |               |                                                                   |            |                          |            |
|----------------------------------------------------------------------------------------------------------------------------------------------------------------------------------------------------------------------------------------------------------------------------------------------------------------------------------------------------------|---------------------------------------------------------------------------------------|---------------|-------------------------------------------------------------------|------------|--------------------------|------------|
| <div>SCS ENGINEERS</div> <div>Environmental Consultants and Contractors</div> <div>2405 140th Avenue NE, Suite 107<br/>Bellevue, Washington 98005<br/>(425) 746-4600 FAX: (509) 884-6948</div> <div>PROJ. NO. 07216156.00</div> <div>ACAD FILE: C3.dwg</div> <div>DWN BY: LEL</div> <div>CHK BY: TAM</div> <div>APP BY: JMR</div> <div>DSN BY: TAM</div> |  | SHEET TITLE   | GAS AND CONDENSATE<br>CONVEYANCE PIPE PROFILE                     | NO.        | REVISION                 | DATE       |
|                                                                                                                                                                                                                                                                                                                                                          |                                                                                       | PROJECT TITLE | LANDFILL GAS CONTROL SYSTEM<br>MODIFICATIONS<br>EASTGATE LANDFILL |            |                          |            |
|                                                                                                                                                                                                                                                                                                                                                          |                                                                                       |               |                                                                   | A          | ISSUED FOR CLIENT REVIEW | 06/11/2020 |
|                                                                                                                                                                                                                                                                                                                                                          |                                                                                       |               |                                                                   | B          | ISSUED FOR AGENCY REVIEW | 06/17/2020 |
|                                                                                                                                                                                                                                                                                                                                                          |                                                                                       |               |                                                                   | C          | ISSUED FOR AGENCY REVIEW | 06/25/2020 |
|                                                                                                                                                                                                                                                                                                                                                          |                                                                                       |               |                                                                   | D          | ISSUED FOR CONSTRUCTION  | 07/20/2020 |
|                                                                                                                                                                                                                                                                                                                                                          |                                                                                       | E             | RECORD DRAWINGS                                                   | 09/18/2020 |                          |            |
|                                                                                                                                                                                                                                                                                                                                                          |                                                                                       | F             |                                                                   |            |                          |            |
| DATE: SEPTEMBER 2020                                                                                                                                                                                                                                                                                                                                     |                                                                                       |               |                                                                   |            |                          |            |
| SCALE: AS SHOWN                                                                                                                                                                                                                                                                                                                                          |                                                                                       |               |                                                                   |            |                          |            |
| DRAWING NO. C3                                                                                                                                                                                                                                                                                                                                           |                                                                                       |               |                                                                   |            |                          |            |



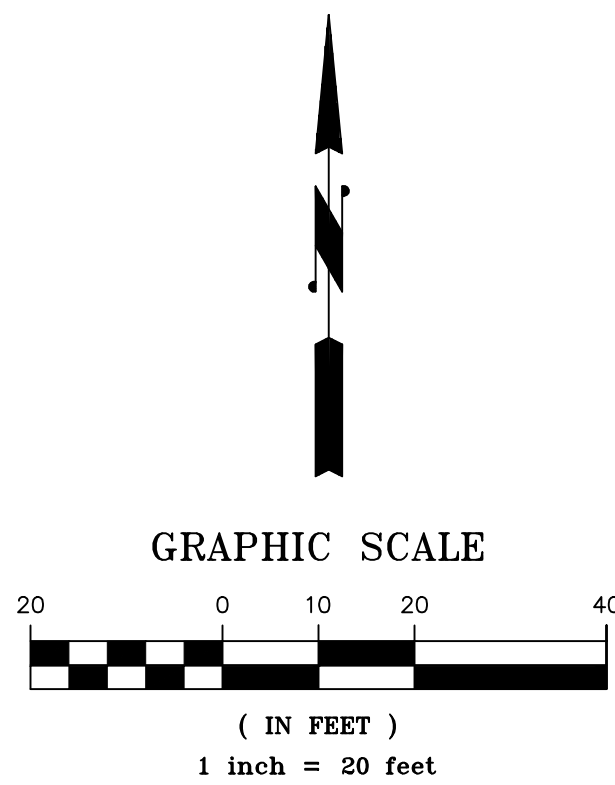

SEE SHEET 2

LEGEND

- WATER VALVE
- HYDRANT
- WATER METER
- MANHOLES (SS/SO)
- CB
- POWER/UTILITY POLE
- GUY ANCHOR
- POWER TRANSFORMER
- POWER/TELEPHONE VAULT
- POWER METER
- TELEPHONE/TV RISER
- GAS VALVE
- GAS METER
- STREET LIGHT
- LUMINAIRE
- SPOT ELEVATION
- SIGN
- MAILBOX
- ROCKERY
- CONFERRUS TREE
- DECIDUOUS TREE
- FOUND CASED MONUMENT

- CENTER LINES
- PROPERTY LINES
- RIGHT-OF-WAY LINES
- LOT LINES
- DITCH LINE
- FLOW LINE
- WATER LINE
- SANITARY SEWER LINE
- STORM DRAIN LINE
- GAS LINE
- UNDERGROUND POWER LINES
- UNDERGROUND TELEPHONE LINES
- UNDERGROUND CABLE TV LINES
- OVERHEAD POWER LINES
- OVERHEAD TELEPHONE LINES
- CHAIN LINK FENCE
- WOOD FENCE

NOTES:

HORIZONTAL DATUM: NAD 83/2007 PER CITY OF BELLEVUE CONTROL  
CITY OF BELLEVUE CONTROLLING MONUMENTS:  
NUMBER 0382 N: 215352.271, E: 1320870.967  
NUMBER 0381 N: 217070.193, E: 1319833.162

VERTICAL DATUM: NAVD83  
CITY OF BELLEVUE CONTROLLING MONUMENTS:  
NUMBER 116 ELEVATION: 344.29  
NUMBER 499 ELEVATION: 379.61

SITE AREA: 634,303 SQ. FT. OR 14.56 ACRES PER RECORD BLA

ALL DISTANCES SHOWN ARE GROUND DISTANCES UNLESS OTHERWISE NOTED.

THE LOCATION AND DESCRIPTION OF ALL SURVEY MARKERS SHOWN HEREON ARE BASED ON FIELD OBSERVATIONS TAKEN IN AUGUST 2009 UNLESS OTHERWISE INDICATED.

WORK PERFORMED IN CONJUNCTION WITH THIS SURVEY UTILIZED THE FOLLOWING EQUIPMENT AND PROCEDURES: (A) 2" GEODIMETER 600 SERIES ELECTRONIC TOTAL STATION, MAINTAINED TO THE MANUFACTURER'S SPECIFICATIONS PER W.A.C. 332-130-100. (B) FIELD TRAVERSE, EXCEEDING REQUIREMENTS SET FORTH IN W.A.C. 332-130-090.

THIS SURVEY WAS PERFORMED WITHOUT THE BENEFIT OF A TITLE REPORT AND DOES NOT PURPORT TO SHOW ALL EASEMENTS.

THIS TOPOGRAPHIC SURVEY DRAWING PRESENTS SURFACE FEATURES LOCATED DURING THE COURSE OF THIS SURVEY. UNDERGROUND UTILITIES SHOWN HEREON ARE BASED SOLELY UPON INFORMATION PROVIDED BY OTHERS AND PACE ENGINEERS, INC. DOES NOT ACCEPT RESPONSIBILITY OR ASSUME LIABILITY FOR THEIR ACCURACY OR COMPLETENESS. CONTRACTOR/ENGINEERS SHALL VERIFY EXACT SIZE AND LOCATION PRIOR TO CONSTRUCTION.

CALL FOR LOCATE: UTILITY LOCATION SERVICE: 1-800-424-5555.

LEGAL DESCRIPTION:

RECORD DESCRIPTION FROM DEED REC. NO. 20030404000873:

Legal Description of OLB-OS Property

That portion of Section 11, Township 24 North, Range 5 East, W.M., in King County, Washington, described as follows:

Commencing at the intersection of the Northwesterly extension of the Southerly line of Lot 3, Block 1, CC and F I-90/Bellevue Business Park Division 1, as recorded in Volume 121 of Plots, Pages 1-3 and the centerline of 160th Avenue SE, thence North 40°37'44" East along said centerline 647.92 feet, a point on a 300.70 foot radius non-tangent curve the center of which bears North 23°02'42" East and the True Point of Beginning, thence Northwesterly along said non-tangent curve a distance of 235.42 feet to the beginning of a 300.70 foot radius reverse curve the center of which bears South 67°54'07" West, thence Westerly along said reverse curve a distance of 590.42 feet to the beginning of a 20.00 foot radius reverse curve the center of which bears North 44°35'53" West, thence Northwesterly along said reverse curve a distance of 29.93 feet, thence North 48°50'37" West to the centerline of 156th Avenue SE, thence Northerly along said centerline to the Westerly extension of the Northerly line of Lot 14, Block 4 of CC and F I-90/Bellevue Business Park Division 3, as recorded in Volume 127 of Plots, Page 29-31, thence Easterly along said Westerly extension and Northerly line to an angle point on the North line of said Lot 14, thence North 12°52'22" East parallel with the West line of the Northeast quarter of said Section 11 to the North line of the Southwest quarter of the Northeast quarter of said Section 11, thence Easterly along the North line to the Southwest corner of the Southeast quarter of the Northwest quarter of the Northeast quarter of said Section 11, thence Northerly along the West line thereof 116.64 feet, thence Northeasterly to a point on the East line of the West 250.00 feet of the Southeast quarter of the Northwest quarter of the Northeast quarter of said Section 11 a distance of 430.00 feet South of the North line of said subdivision, thence Easterly along said North line to Northwest corner of the Southwest quarter of the Northeast quarter of the Northeast quarter of said Section 11, thence South 88°37'01" East along the North line thereof 83.37 feet, thence South 2°29'22" West 10.94 feet, thence South 5°53'15" West 10.98 feet, thence South 24°57'53" West 83.50 feet to the beginning of a 175.35 foot radius curve to the right, thence Southwesterly along said curve a distance of 98.48 feet, thence South 34°58'37" West 20.50 feet, thence South 55°01'23" East 46.05 feet, thence South 35°12'43" West 519.07 feet to the beginning of a 444.00 foot radius curve to the left, thence Southerly along said curve a distance of 366.15 feet, thence South 12°02'17" East 170.41 feet, thence South 15°50'46" West 85.48 feet, thence South 35°17'26" West 15.65 feet to the Northerly line of said CC and F I-90/Bellevue Business Park Division 3, thence South 68°29'10" East along said Northerly line and the Northerly line of said CC and F I-90/Bellevue Business Park Division 1 a distance of 49.38 feet to the centerline of 160th Avenue SE, thence Southwesterly along said centerline to the True Point of Beginning.

FOR REFERENCE



11255 Kirkland Way, Suite 300  
Kirkland, WA 98033  
p. 425.827.2014 | f. 425.827.5043  
Civil | Structural | Planning | Survey  
paceengr.com

EASTGATE LANDFILL PARK

DATE: 9/29/2009  
SCALE: 1" = 30'  
SURVEY TEAM: GW/BD/DB  
FIELD BOOK: 611C, 611D  
DWG FILE: 9398-SRV.dwg

TOPOGRAPHIC SURVEY  
FOR  
CITY OF BELLEVUE  
PARKS & COMMUNITY DEVELOPMENT DEPARTMENT

PROJECT NO.  
09398.10  
SHEET 1 OF 3






STA 0+80 LOOKING EAST TO CT-6R



STA 1+00 LOOKING EAST



STA 1+50 LOOKING EAST

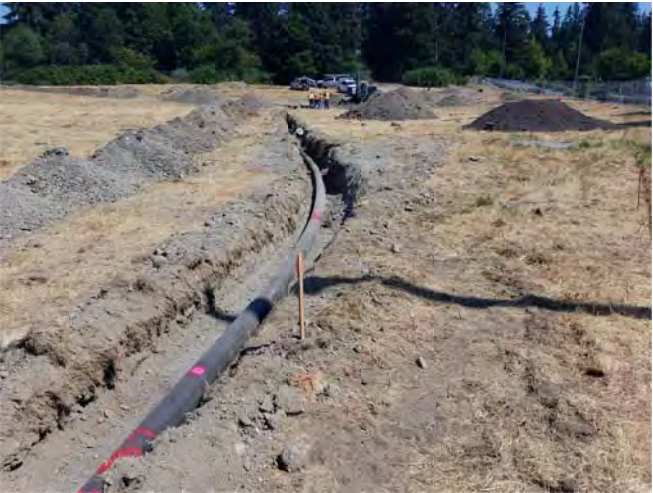

STA 2+00 LOOKING EAST



STA 2+25 LOOKING EAST



STA 2+40 LOOKING EAST



STA 2+75 LOOKING EAST



STA 2+82 LOOKING SOUTH TO EW-3R



BRANCH PIPE TO EW-3R LOOKING SOUTH



STA 3+20 LOOKING EAST



STA 3+45 LOOKING EAST



STA 3+50 LOOKING SOUTH TO EW-2R & EW-18

|     |  |                 |            |
|-----|--|-----------------|------------|
| NO. |  | REVISION        | DATE       |
| A   |  | RECORD DRAWINGS | 09/18/2020 |
| B   |  |                 |            |
| C   |  |                 |            |
|               |  |                                                             |  |
|---------------|--|-------------------------------------------------------------|--|
| SHEET TITLE   |  | CONSTRUCTION PHOTOS                                         |  |
| PROJECT TITLE |  | LANDFILL GAS CONTROL SYSTEM MODIFICATIONS EASTGATE LANDFILL |  |



CITY OF BELLEVUE

|                                           |            |             |                 |
|-------------------------------------------|------------|-------------|-----------------|
| SCS ENGINEERS                             |            |             |                 |
| Environmental Consultants and Contractors |            |             |                 |
| 2405 140th Avenue NE, Suite 107           |            |             |                 |
| Bellevue, Washington 98005                |            |             |                 |
| (425) 746-4600 FAX: (509) 864-6948        |            |             |                 |
| PROJ. NO.                                 | 0721615600 | DWN. BY:    | TAM             |
| DSN. BY:                                  | TAM        | CHK. BY:    | TAM             |
| APP. BY:                                  | JMR        | ACAD. FILE: | P1 - Photos.dwg |

|             |                |
|-------------|----------------|
| DATE:       | SEPTEMBER 2020 |
| SCALE:      | AS SHOWN       |
| DRAWING NO. | P1             |









|                                                                                       |                                                                                                                                                                          |  |                                                                                       |  |
|---------------------------------------------------------------------------------------|--------------------------------------------------------------------------------------------------------------------------------------------------------------------------|--|---------------------------------------------------------------------------------------|--|
|  | <b>SCS ENGINEERS</b><br>Environmental Consultants and Contractors<br>2405 140th Avenue NE, Suite 107<br>Bellevue, Washington 98005<br>(425) 746-4600 FAX: (503) 684-6948 |  | PROJECT NO. 07216156.00<br>CS&S FILE LEL<br>PL Drawing<br>CS&S FILE LEL<br>PL Drawing |  |
|                                                                                       | DATE: SEPTEMBER 2020                                                                                                                                                     |  | PROJ. NO. 07216156.00<br>CS&S FILE LEL<br>PL Drawing                                  |  |
|                                                                                       | SCALE: AS SHOWN                                                                                                                                                          |  | PROJ. NO. 07216156.00<br>CS&S FILE LEL<br>PL Drawing                                  |  |
|                                                                                       | DRAWING NO.                                                                                                                                                              |  | PROJ. NO. 07216156.00<br>CS&S FILE LEL<br>PL Drawing                                  |  |
|                                                                                       | P3                                                                                                                                                                       |  | PROJ. NO. 07216156.00<br>CS&S FILE LEL<br>PL Drawing                                  |  |





STA 4+75 LOOKING SOUTHWEST



STA 4+55 LOOKING SOUTHWEST



STA 4+15 LOOKING SOUTHWEST



VIEW LOOKING WEST TO CT-5R2



STA 3+86 LOOKING WEST



STA 3+70 LOOKING WEST



STA 3+55 LOOKING WEST



STA 3+20 LOOKING WEST



STA 3+10 LOOKING WEST



STA 2+85 LOOKING WEST



STA 2+50 LOOKING WEST



STA 2+20 LOOKING WEST

|     |  |                 |            |
|-----|--|-----------------|------------|
| NO. |  | REVISION        | DATE       |
| A   |  | RECORD DRAWINGS | 09/16/2020 |
| B   |  |                 |            |
| C   |  |                 |            |
|               |  |                                                             |  |
|---------------|--|-------------------------------------------------------------|--|
| SHEET TITLE   |  | CONSTRUCTION PHOTOS                                         |  |
| PROJECT TITLE |  | LANDFILL GAS CONTROL SYSTEM MODIFICATIONS EASTGATE LANDFILL |  |



**SCS ENGINEERS**  
Environmental Consultants and Contractors  
2405 140th Avenue NE, Suite 107  
Bellevue, Washington 98005  
(425) 746-4600 FAX: (509) 864-6948

|           |            |          |     |     |
|-----------|------------|----------|-----|-----|
| PROJ. NO. | 0721615600 | DWN. BY: | LEL | TAM |
| DSN. BY:  | TAM        | CHK. BY: | TAM | JMR |
| APP. BY:  |            |          |     |     |

|             |                |
|-------------|----------------|
| DATE:       | SEPTEMBER 2020 |
| SCALE:      | AS SHOWN       |
| DRAWING NO. | P4             |





STA 1+90 LOOKING WEST



STA 1+78 LOOKING WEST



STA 1+65 LOOKING WEST



STA 1+57 LOOKING WEST TO CT-6R



CT-5R2



CT-5R2



CT-5R2



6"Ø GAS, 2"Ø CONDENSATE & 2"Ø AIR SUPPLY PIPE



CONDENSATE PIPE CONNECTION TO SEWER PIPE



CT-5R2



CT-5R2



SDR OF 2"Ø CONDENSATE & AIR SUPPLY PIPE

|     |  |                 |            |
|-----|--|-----------------|------------|
| NO. |  | REVISION        | DATE       |
| A   |  | RECORD DRAWINGS | 09/18/2020 |
| B   |  |                 |            |
| C   |  |                 |            |
|               |  |                                                             |  |
|---------------|--|-------------------------------------------------------------|--|
| SHEET TITLE   |  | CONSTRUCTION PHOTOS                                         |  |
| PROJECT TITLE |  | LANDFILL GAS CONTROL SYSTEM MODIFICATIONS EASTGATE LANDFILL |  |



|                                                                                                                                                                          |            |          |                |
|--------------------------------------------------------------------------------------------------------------------------------------------------------------------------|------------|----------|----------------|
| <b>SCS ENGINEERS</b><br>Environmental Consultants and Contractors<br>2405 140th Avenue NE, Suite 107<br>Bellevue, Washington 98005<br>(425) 746-4600 FAX: (509) 884-6948 |            |          |                |
| PROJ. NO.                                                                                                                                                                | 0721615600 | DWN. BY: | TAM            |
| DSN. BY:                                                                                                                                                                 | TAM        | CHK. BY: | TAM            |
| APP. BY:                                                                                                                                                                 | JMR        | DATE:    | SEPTEMBER 2020 |
| SCALE: AS SHOWN                                                                                                                                                          |            |          |                |
| DRAWING NO. P5                                                                                                                                                           |            |          |                |





|                                                                                     |                                                                                                                                                                         |  |                                                                                |  |
|-------------------------------------------------------------------------------------|-------------------------------------------------------------------------------------------------------------------------------------------------------------------------|--|--------------------------------------------------------------------------------|--|
|  | <b>SC ENGINEERS</b><br>Environmental Consultants and Contractors<br>2405 140th Avenue NE, Suite 107<br>Bellevue, Washington 98005<br>(425) 746-4500 FAX: (503) 684-6948 |  | DATE: <b>SEPTEMBER 2020</b><br>SCALE: <b>AS SHOWN</b><br>DRAWING NO. <b>P6</b> |  |
|                                                                                     | PROJ. NO. 07216156.00<br>DWN. BY: LEL<br>CHK. BY: TAM<br>APP. BY: JMR                                                                                                   |  | ACAD FILE:<br>P1 - Photos.dwg                                                  |  |
|                                                                                     | SHEET TITLE<br><b>CONSTRUCTION PHOTOS</b>                                                                                                                               |  | NO. REVISION DATE                                                              |  |
|                                                                                     | PROJECT TITLE<br><b>LANDFILL GAS CONTROL SYSTEM<br/>         MODIFICATIONS<br/>         EASTGATE LANDFILL</b>                                                           |  | RECORD DRAWINGS<br>09/18/2020                                                  |  |
|                                                                                     |                                                                                                                                                                         |  |                                                                                |  |