


- Stationing or Road Alignments
Road Names
Beginning and Distances of roads, survey lines, and property lines
Erection stations for alignment
All existing top layers
Point block layers
thowed and rotated 45° to northeast edge of asphalt, gravel and gravel stock, 100' side
Label property corners
Symbol for property corners
Does project require the truck turn-around
Does project require location for mail box
Size and label stails
Dimension overall bldg.
paved, streets,
Section & offsets for
As Built location of
Utilities:
Sewer
Water
City
Power
Fiber
Optics
Telephone

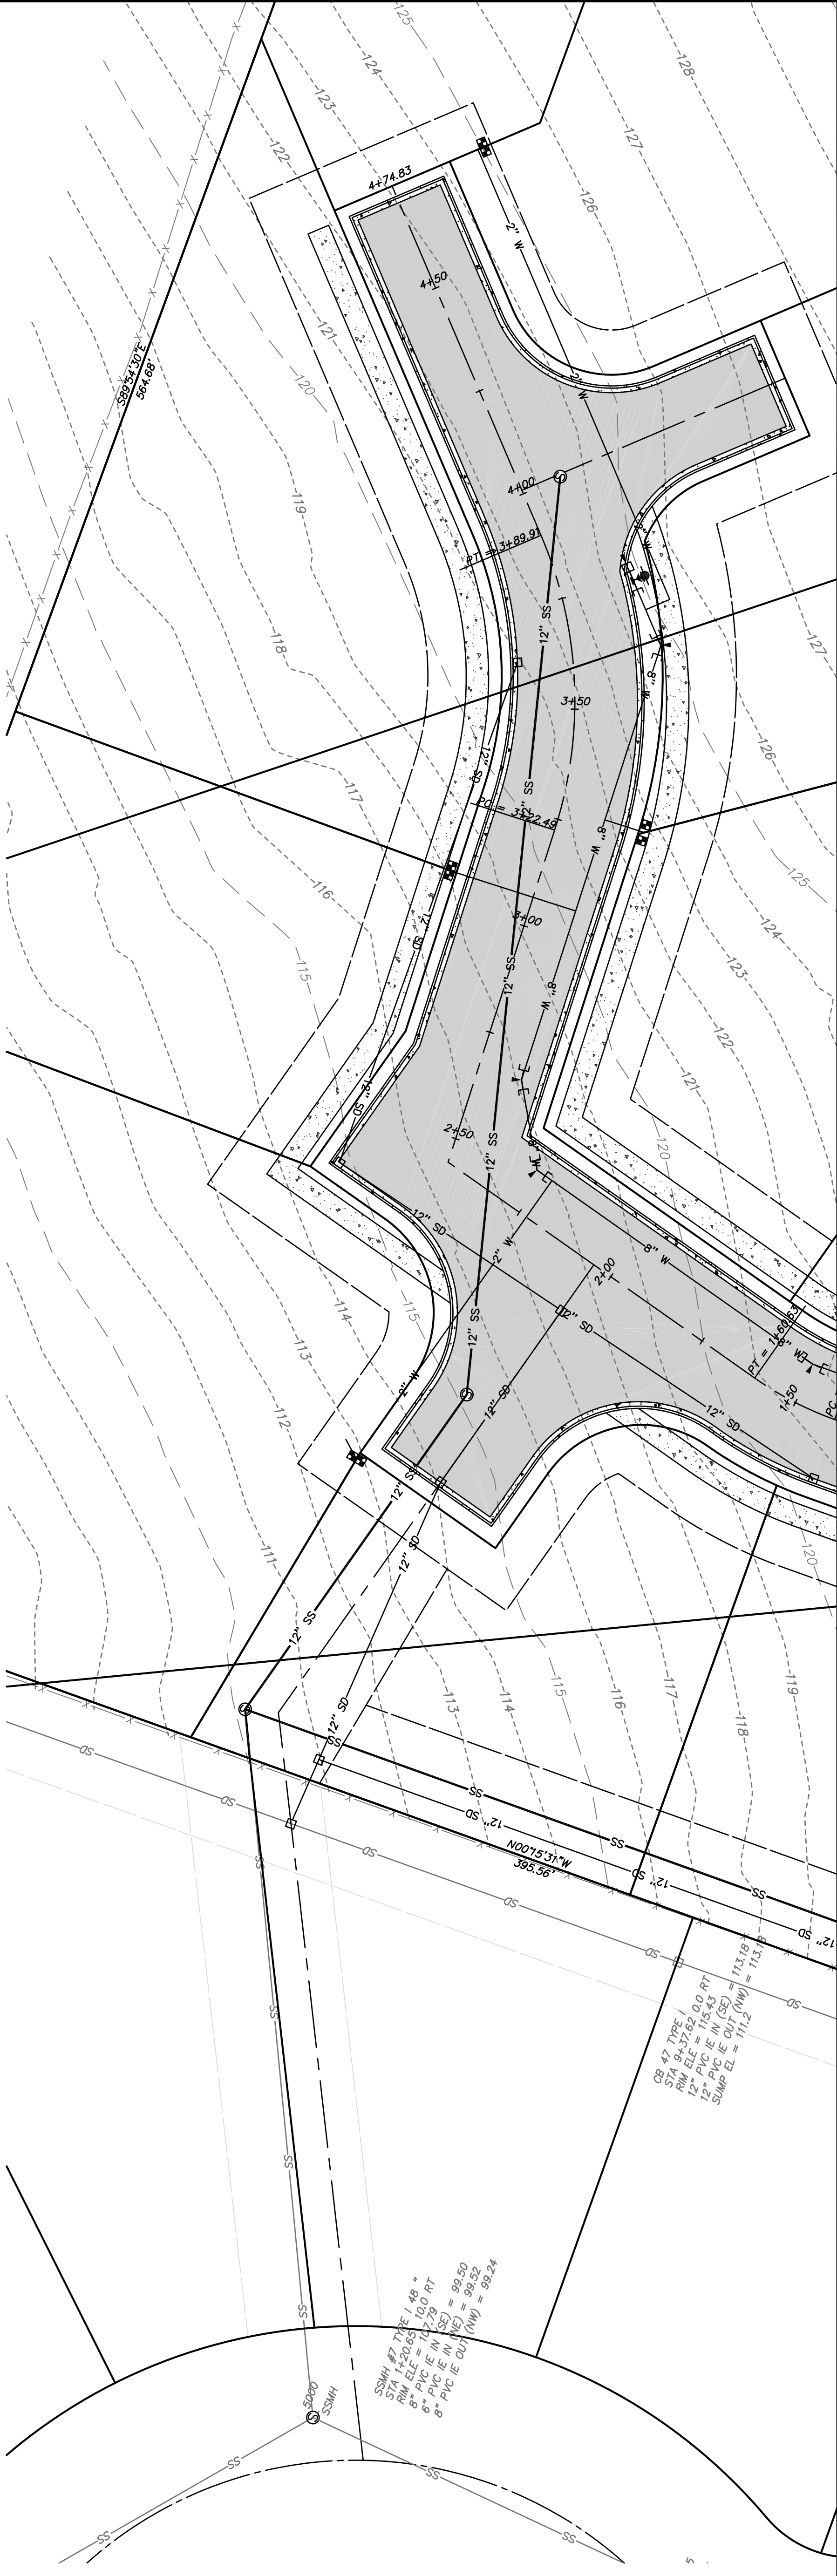


- SANITARY SEWER CONSTRUCTION NOTES:**
1. EXCAVATE EXISTING SEWER LINE & REPLACE WITH NEW 8" CONCRETE PIPE. MATCH GRADE AND SERVICING LINE & VERIFY CONNECTION LOCATION & NOTE FOR ASBULTING OF SEWER LINE.
 2. TIE TO EXISTING SEWER MANHOLE. RECAST CHANNELS IN BASE TO DIRECT FLOWS TO DOWNSTREAM INVERT.
 3. BRING EXISTING SS&H TO GRADE.
 4. INSTALL 8" SS LINE TO FUTURE BUILDING. MIN

- WATER CONSTRUCTION NOTES:**
- WATER INSTALLATION SHALL BE PER SLOAT COUNTY BLDG #1 SPEC SHEETS C11 & C12 WHERE TAPPING SLEEVE OCCURS. TAP TO BE BY CERTIFIED TAPPING COMPANY APPROVED BY PUD.
1. EXCAVATE EXISTING WATER SERVICE & REPLACE AND FACE OF BLDG WITH NEW 4" GALVANIZED IRON PIPE.
 2. RELOCATE HYDRANT.
 3. DEDUCT METER FOR IRRIGATION SEE DETAIL.

WATERLINE NOTES

THE DEVELOPER'S PRIVATE CONTRACTOR WILL BE RESPONSIBLE FOR ALL EXCAVATION, SHORING, DEWATERING, TRAFFIC CONTROL, COMPACTED AND SURFACE RESTORATION WORK NECESSARY FOR THE DISTRICT'S WORK.

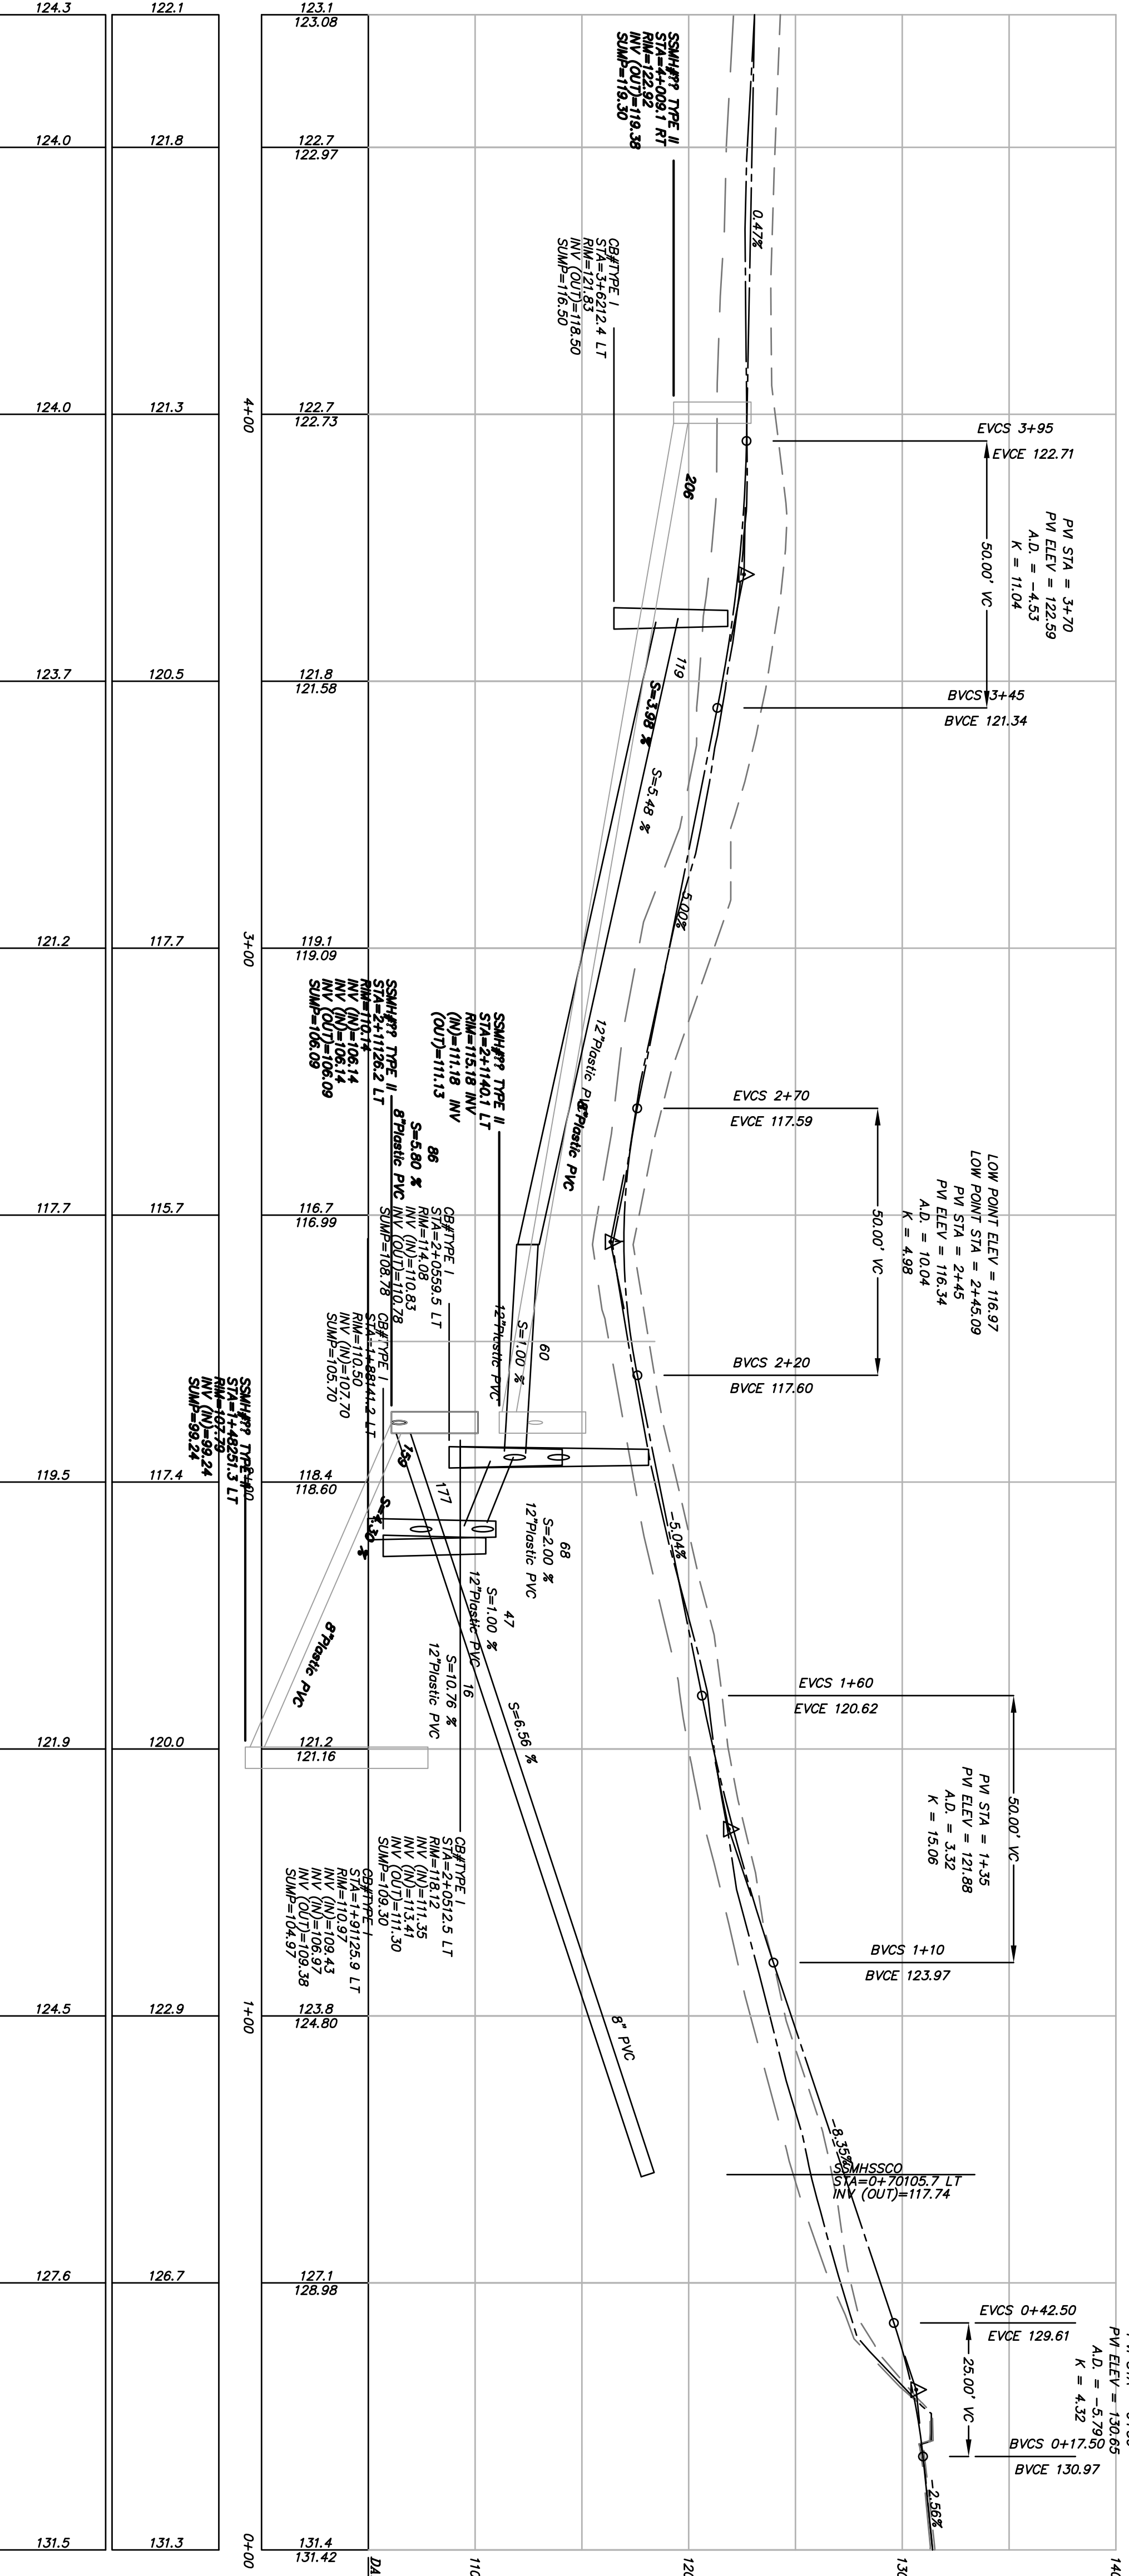

GRAPHIC SCALE

1 inch = 10' (IN FEET)
? FOOT CONTOURS

PROJECT

DRAWING

SHEET

CX OF C

CALL 48 HOURS BEFORE YOU DIG 811

PROJECT FOR CLIENT

SECTION 18, T 34 N, R 4 E, W.M.

NORTHWEST DATUM & DESIGN, Inc.

CIVIL ENGINEERING AND SURVEYING SOLUTIONS

2209 MONICA DRIVE
MOUNT VERNON, WASHINGTON 98273
PH: (360) 424-4885 FAX: (360) 424-4886

DOUGLAS E. SCHINDL P.E., P.L.S.

PROJECT

DRAWING

SHEET

CX OF C