

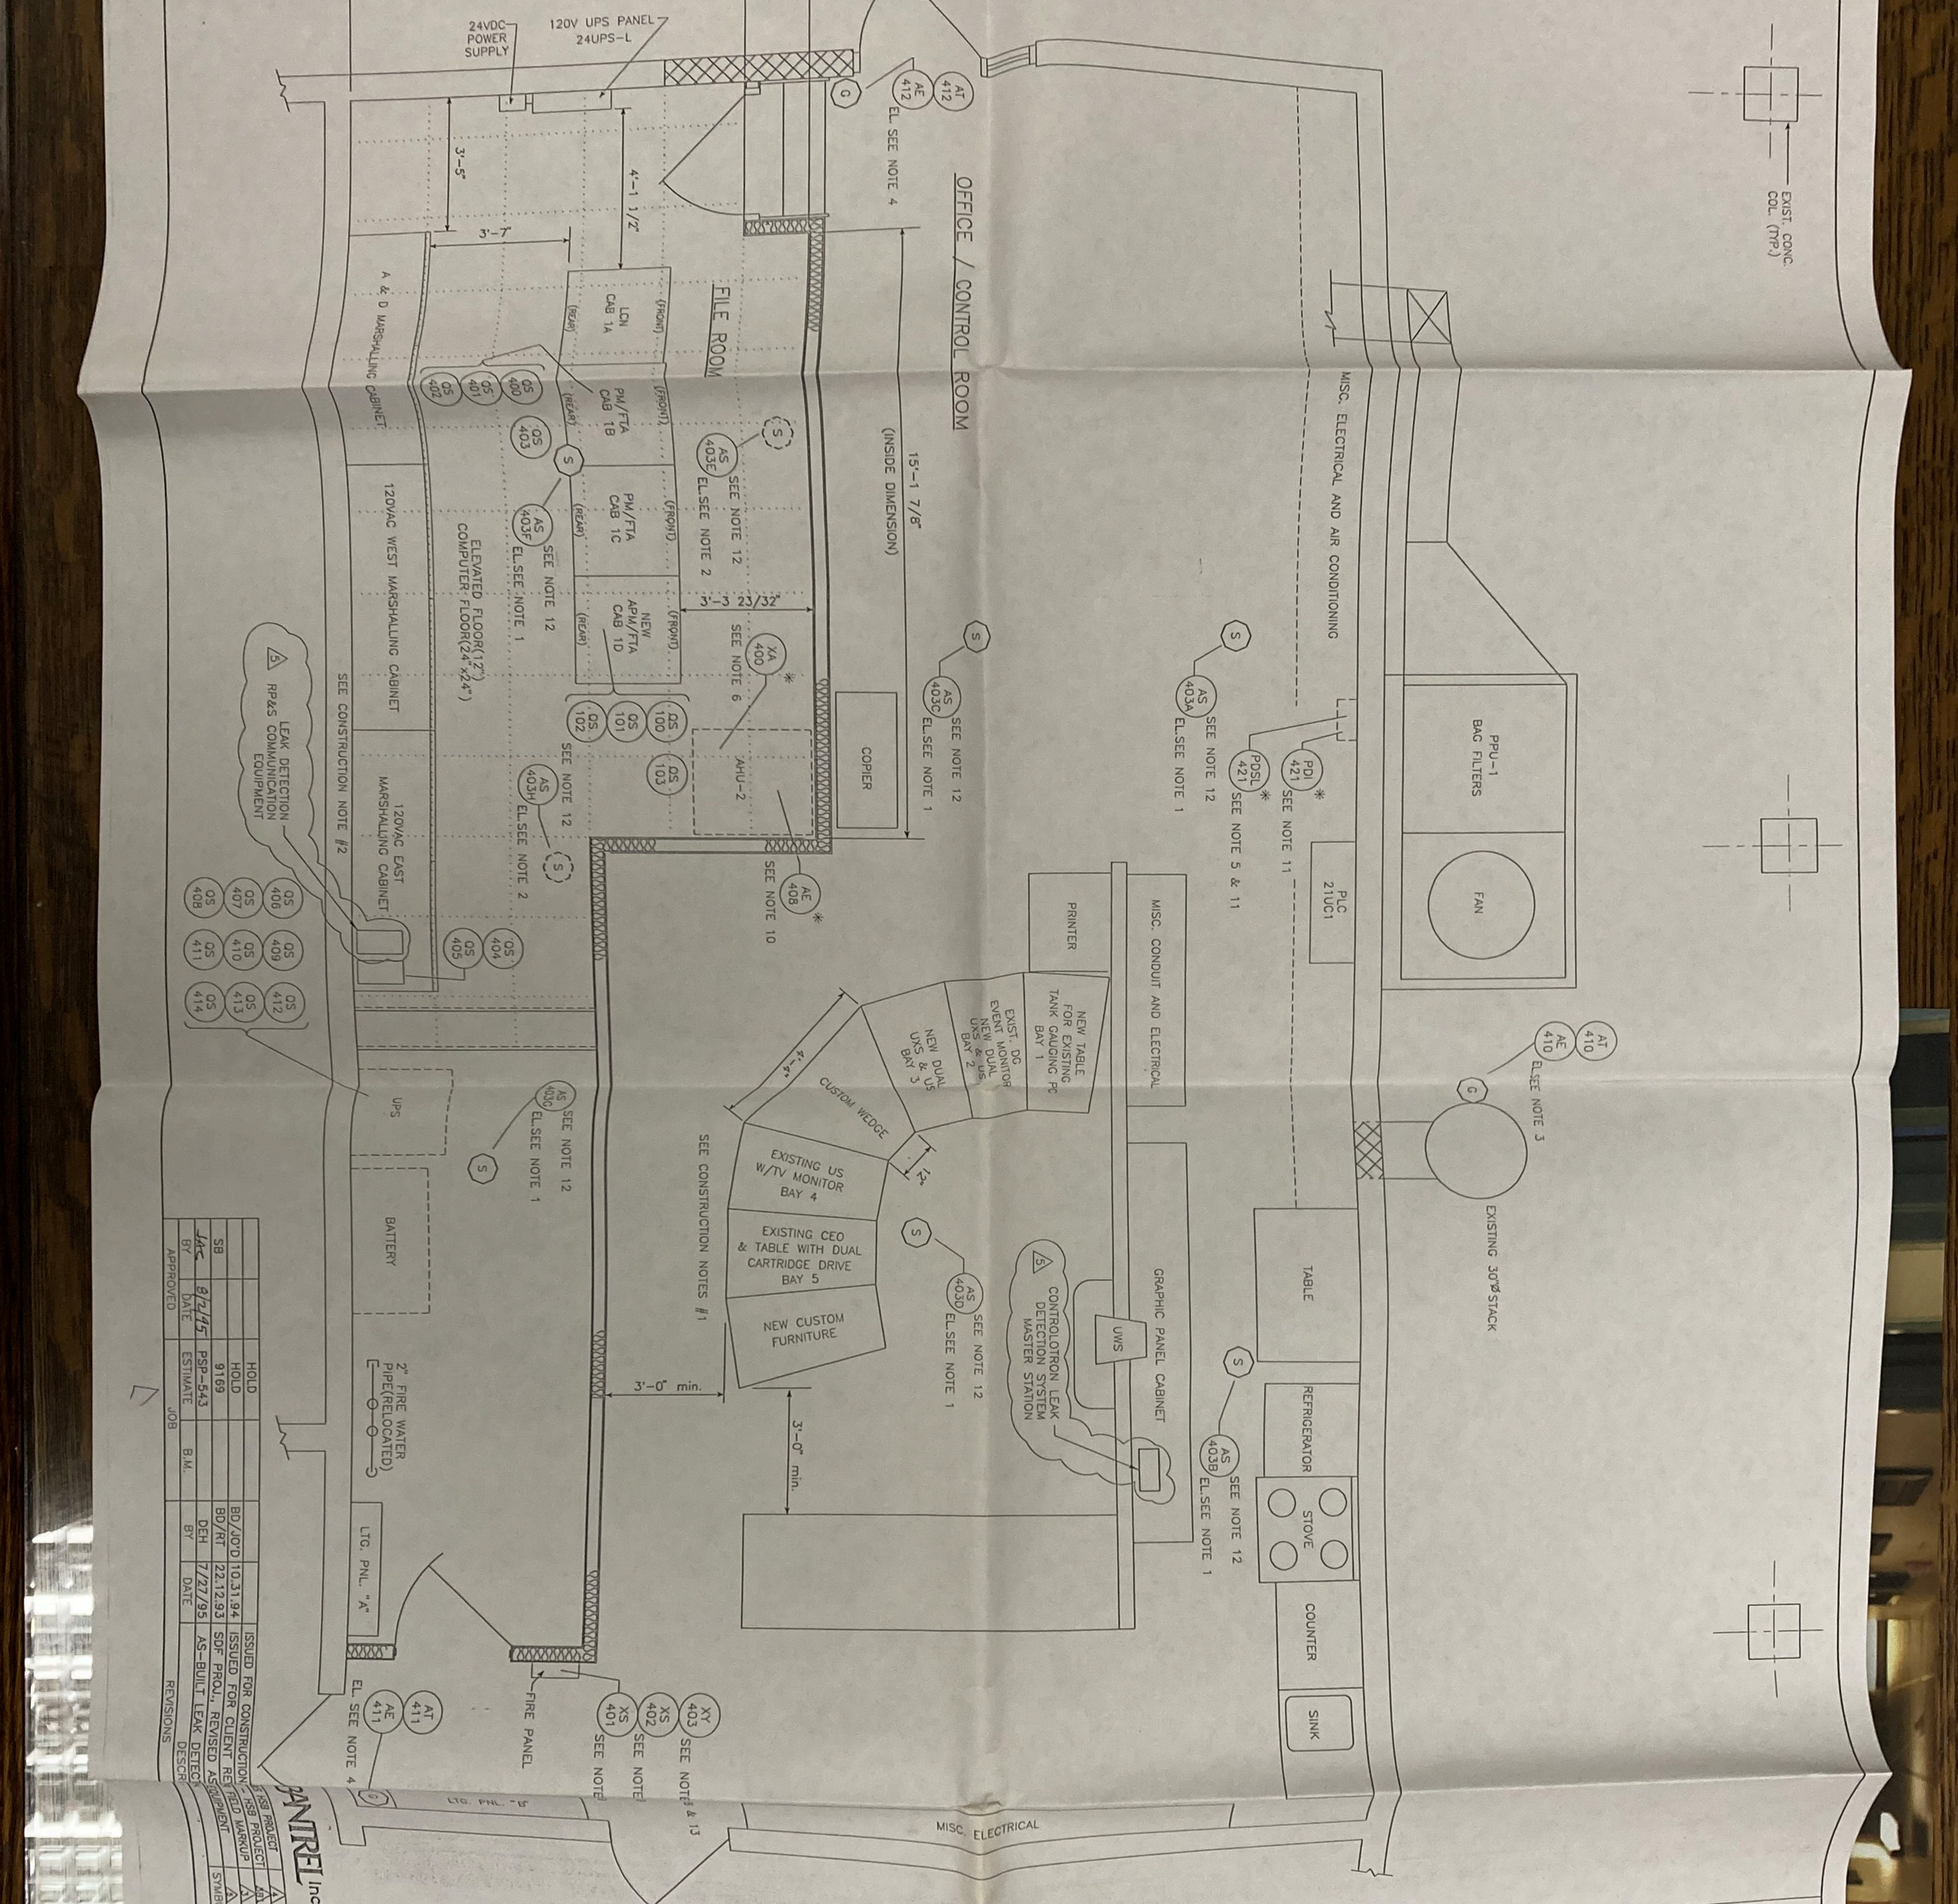
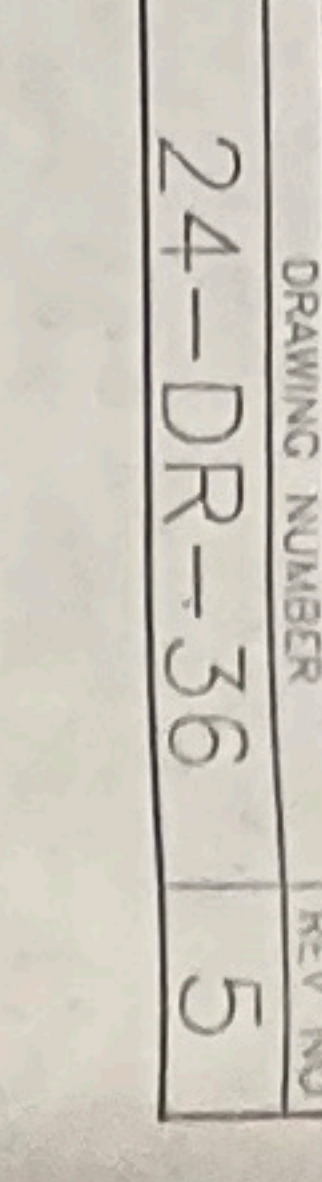
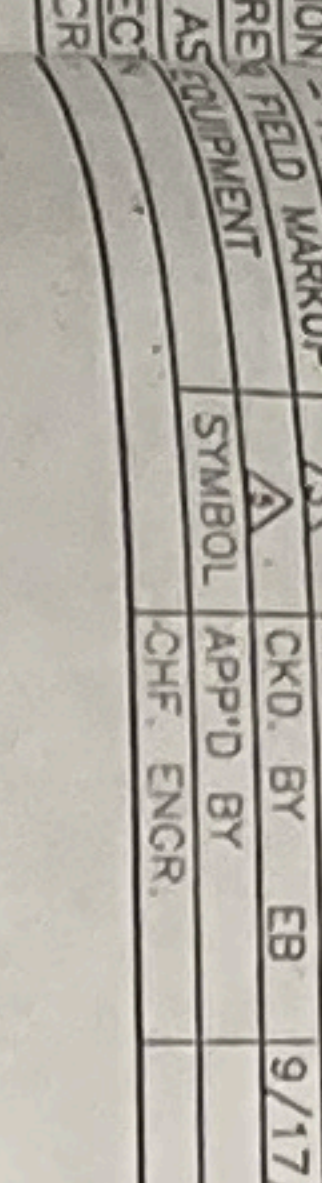
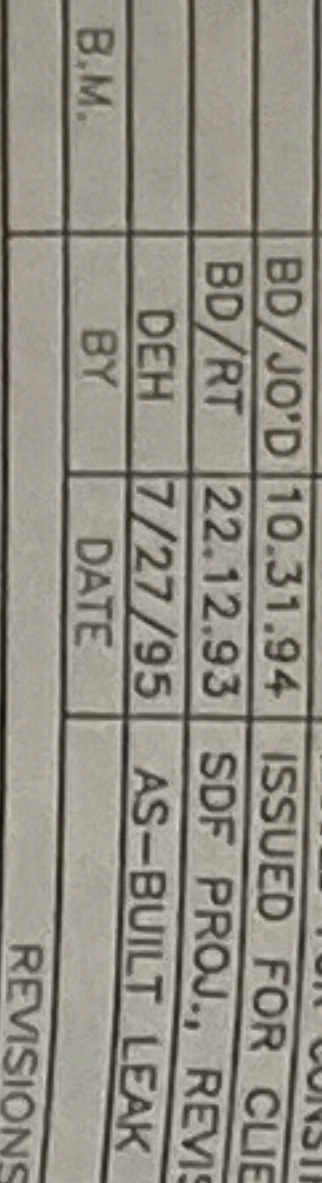
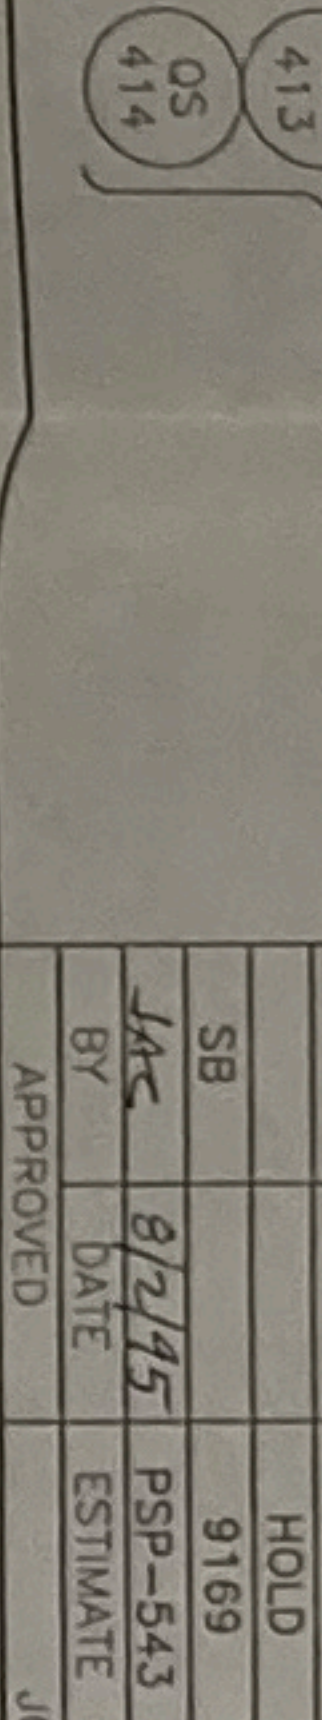
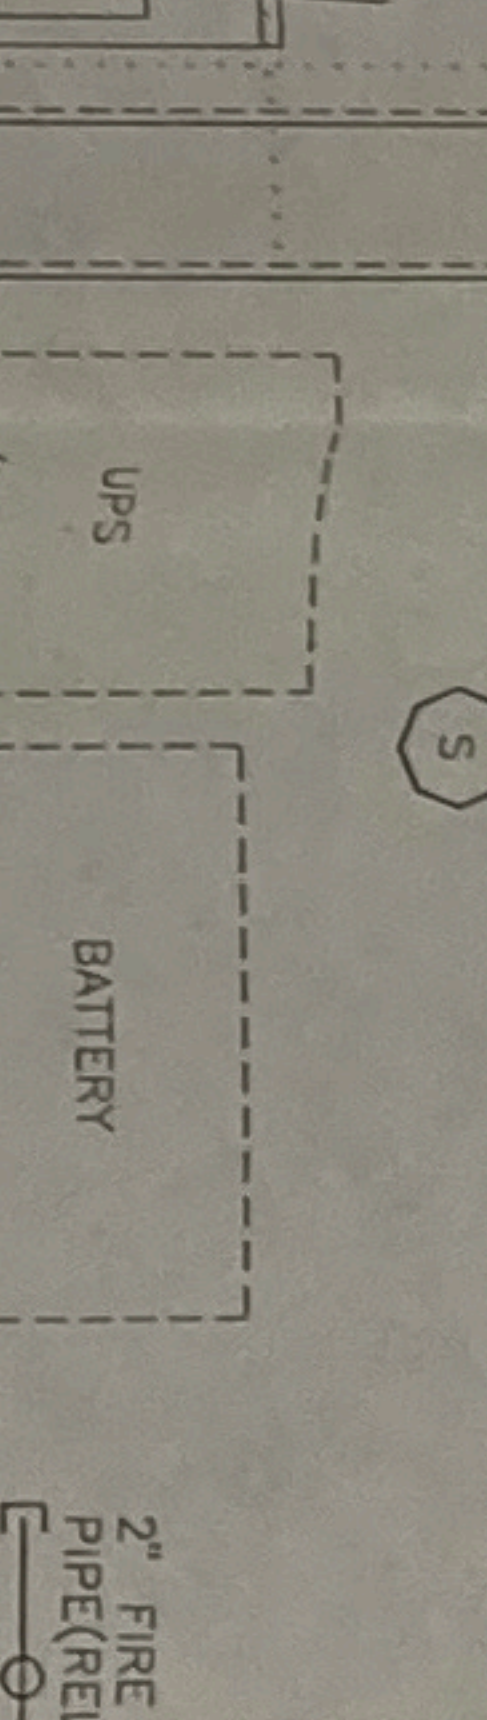
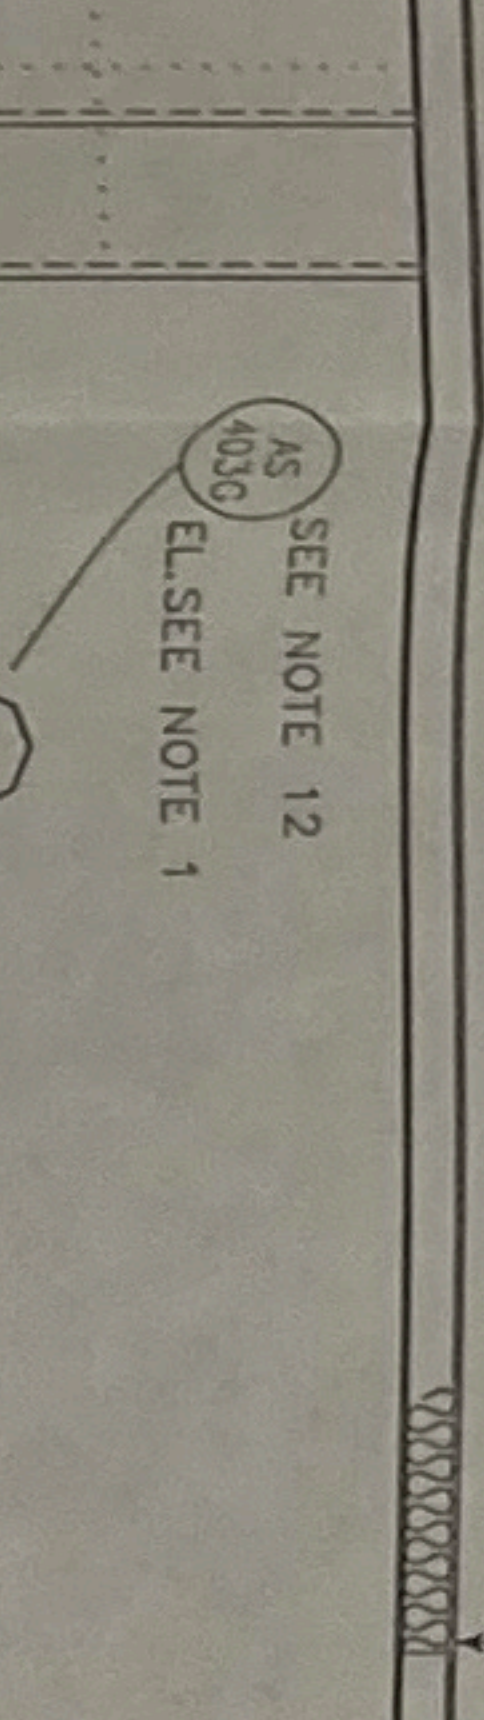
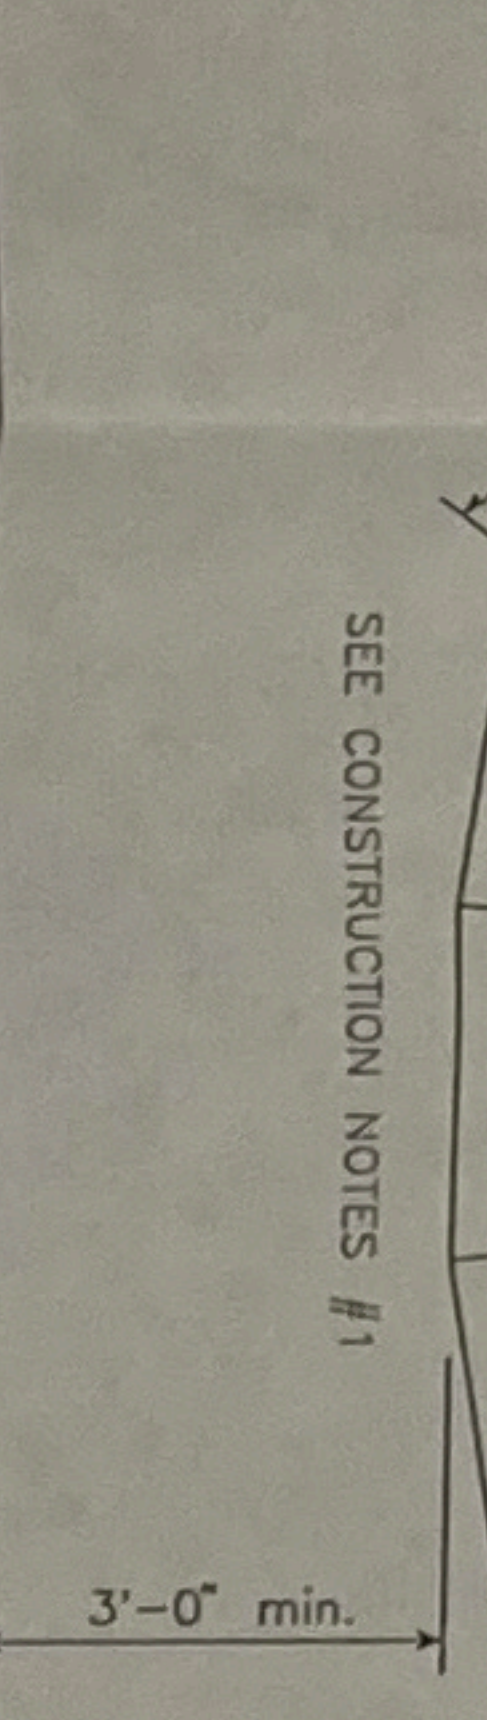
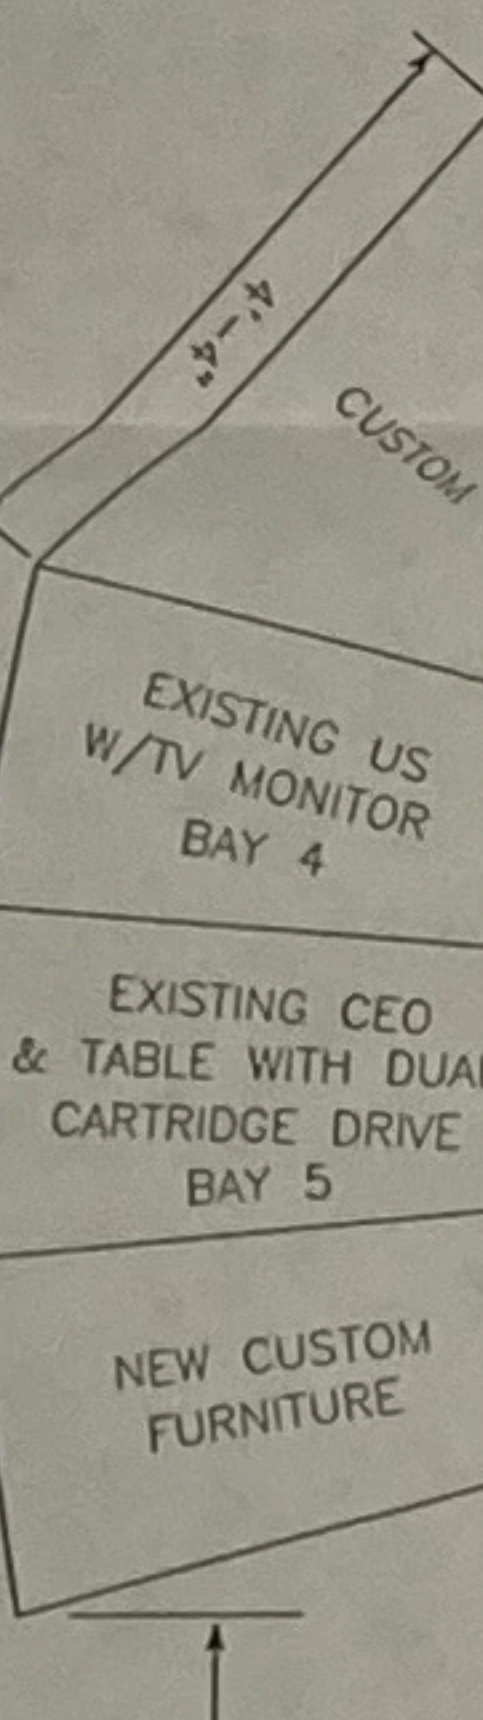
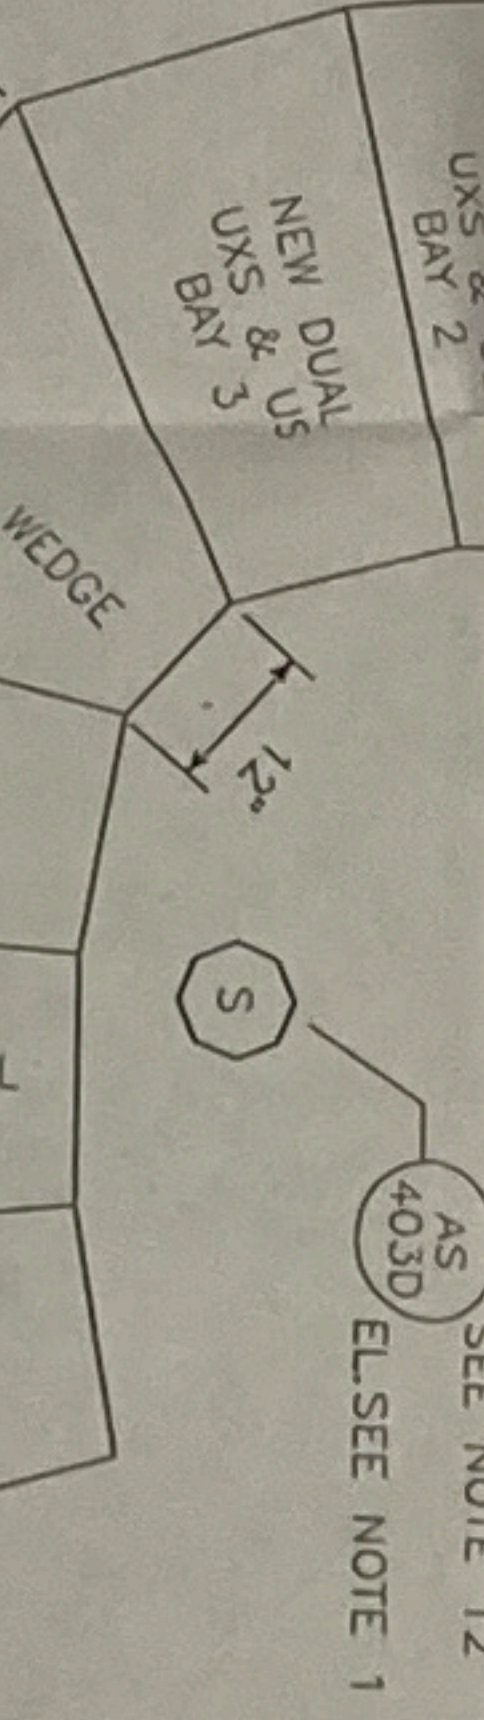
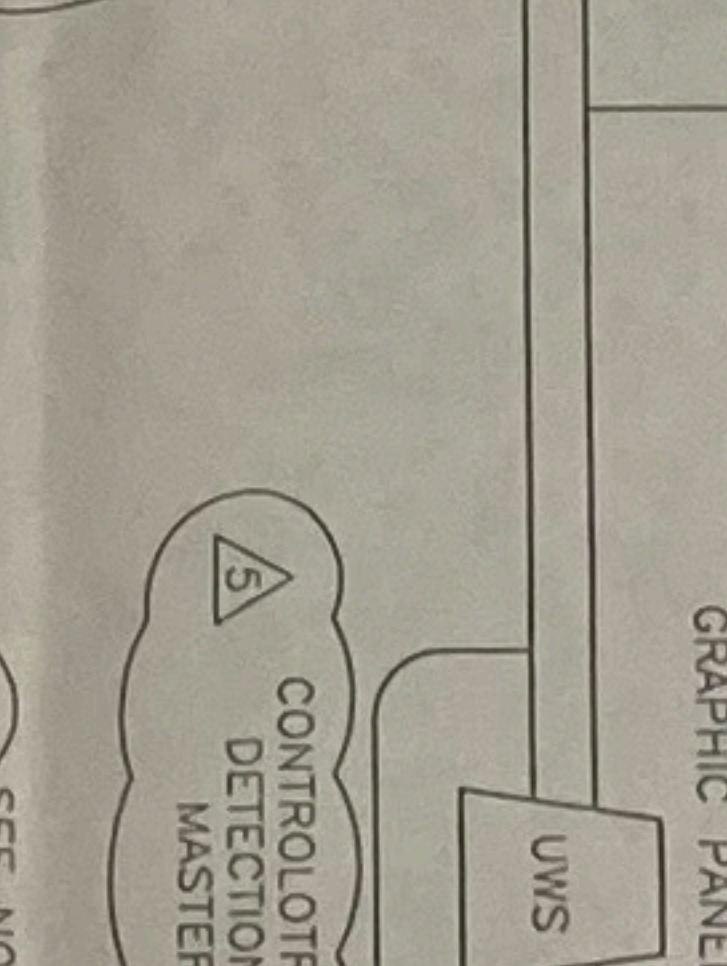
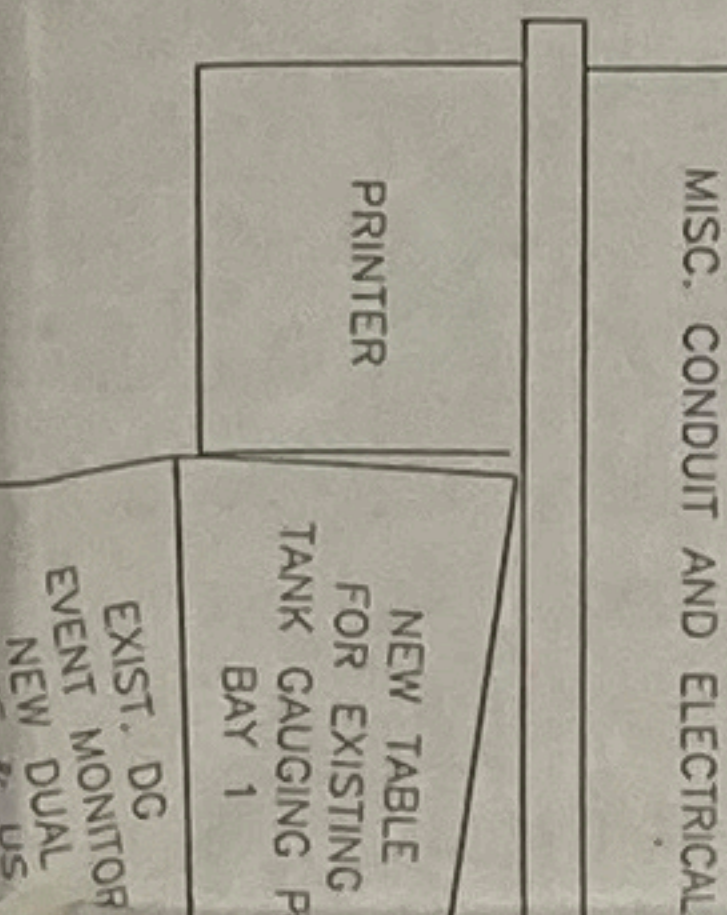
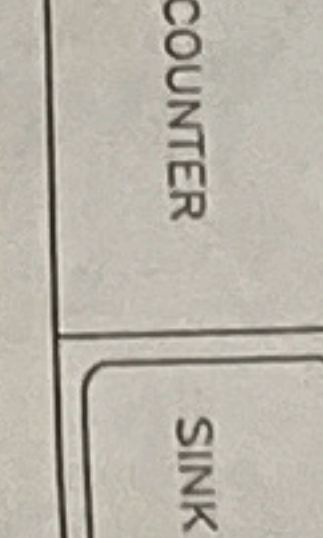
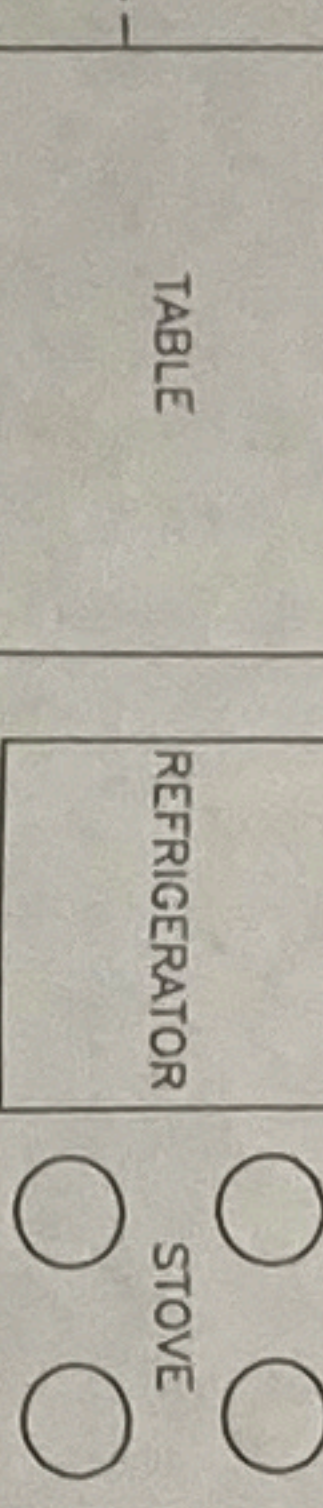
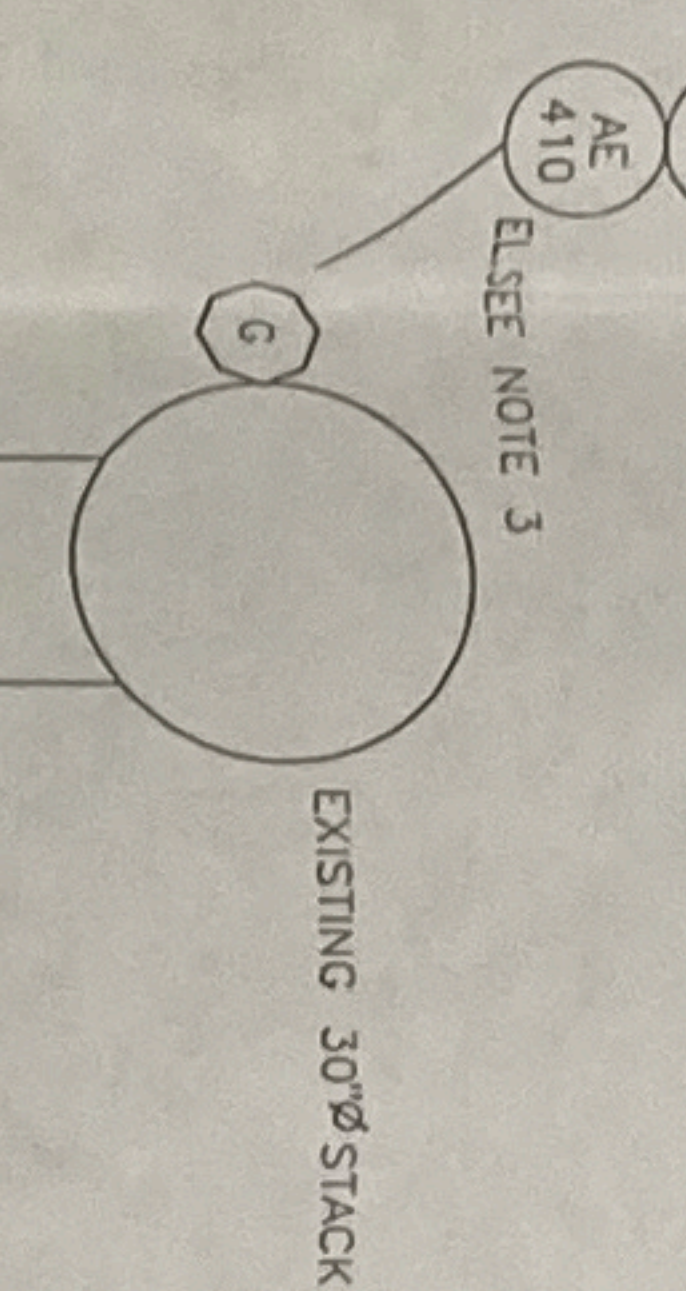
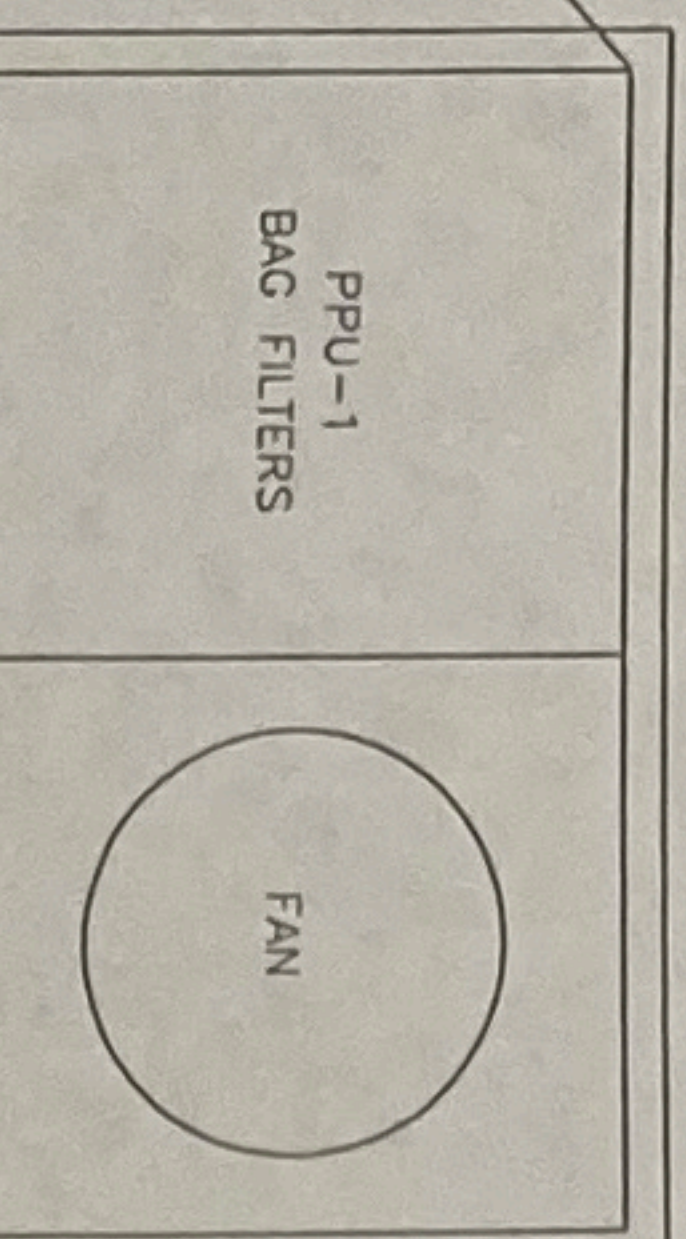


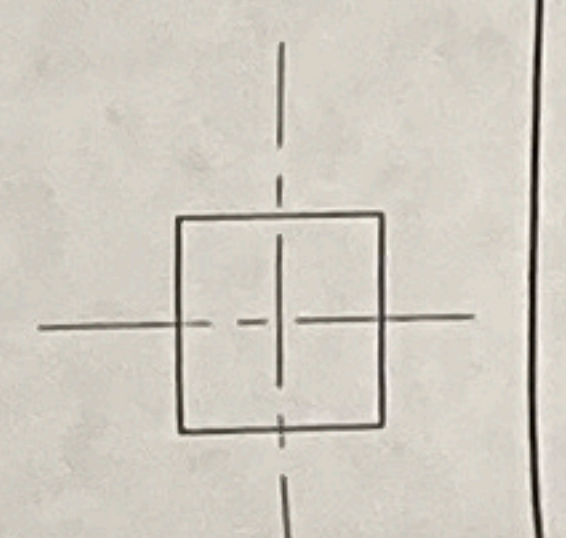

EXIST. CONC. COL. (MP)

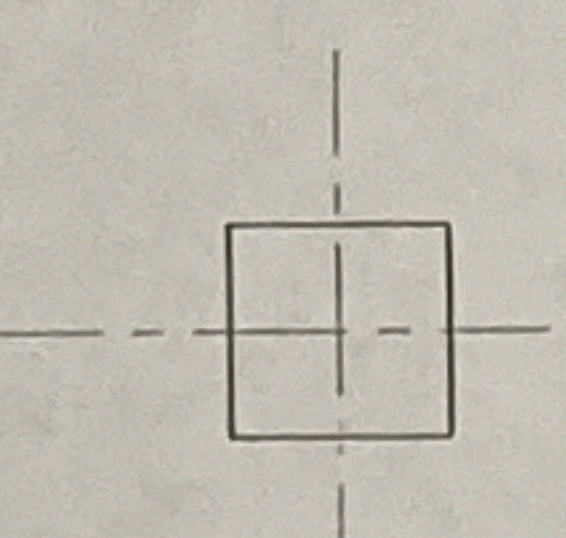

NOTES:

- 1) SMOKE DETECTOR - CEILING MOUNT
- 2) SMOKE DETECTOR - MOUNTED BELOW COMPUTER FLOOR
- 3) COMBUSTIBLE GAS DETECTOR - DUCT MOUNT (ELEVATION TO BE CONFIRMED LATER)
- 4) COMBUSTIBLE GAS DETECTOR - MOUNTED 6' ABOVE FLOOR WIRING BACK TO TDC.
- 5) LOSS OF CONTROL BLDG. POSITIVE PRESSURE
- 6) COMMON TROUBLE ALARM WIRING BACK TO TDC.
- 7) \* SUPPLIED BY TEXACO.
- 8) COMMON FIRE ALARM WIRING BACK TO TDC.
- 9) HVAC TRIP OUTPUTS.
- 10) 4E408 SMOKE DETECTOR OUTPUT TRIPS AHU-2.
- 11) CONTRACTOR TO RETIE 24PDS100 & 24PDS100 TO 24PDS101 & 24PDS102 RESPECTIVELY.
- 12) CONTRACTOR TO RETIE SMOKE DETECTORS 244E400 TO 244E407 INCLUSIVE TO 244E404 TO 244E408.
- 13) CONTRACTOR TO RETIE COMMON FIRE ALARM 244E403 TO 244E403.

REFERENCE DRAWINGS

CONTROL ROOM ELECTRICAL LAYOUT	24-0P-56
CONTROL ROOM LAYOUT ARCHITECTURAL	24-0R-31
PM CABINET AND FTA CABINET LAYOUT	24-0J-25
120 VAC WEST MARSHALLING CABINET LAYOUT	24-0J-21
A & D MARSHALLING CABINET LAYOUT	24-0J-20
120 VAC EAST MARSHALLING CABINET LAYOUT	24-0J-22

CONSTRUCTION NOTES:

- 1) 2 RADIOS, 2 TELEPHONES, 1 FAX AND CCTV CONTROL PAD LOCATIONS TO BE DETERMINED.
- 2) SUITABLE SHELVING TO BE INSTALLED IN TOP LEFT CORNER OF 120 VAC EAST MARSHALLING CABINET FOR RELOCATED 24V BULK DC CTTS SUPPLIES AS PER Dwg. 24-0J-78. EXISTING 24V DC SUPPLIES, NEW 24V-DCCT1 & 2 TO BE CONNECTED TO POWER SUPPLIES. NEW CTTS FOR 24V DC & COM. BY BULK DC SUPPLY #1 & 2 SHALL TO BE INSTALLED AND CONNECTED BETWEEN POWER SUPPLIES AND A & D MARSHALLING CABINET AS PER Dwg. 24-0J-73.

Professional Engineer Seal for Jeffrey A. Curtis, License No. 012145, State of Washington. Includes expiration date: EXPIRES 10-31-95.

PANTREL Inc. logo and contact information for PUGET SOUND PLANT. Includes drawing number 24-DR-36 and revision 5. Also includes a project schedule table.

NO.	DESCRIPTION	DATE	BY	CHKD.	APPD.
1	ISSUED FOR CONSTRUCTION	8/2/95	JAC		
2	ISSUED FOR CLIENT REVIEW	8/17/95	JAC		
3	REVISED AS PER COMMENTS	8/17/95	JAC		
4	REVISED AS PER COMMENTS	8/17/95	JAC		
5	REVISED AS PER COMMENTS	8/17/95	JAC		



## Appendix B

**3.12.0 Within 12 months of Ecology's oil spill prevention operation standards, install, test and maintain automated line shutoff equipment for the crude oil transfer pipelines in accordance with the state regulations. Within 2 months of the installation of this equipment, submit documentation to Ecology which includes an itemized description of the shutoff equipment installed, where the equipment was installed, and the results of the performance tests conducted which demonstrate that the installed shutoff equipment will meet shutoff standards.**

**Status:** Item Closed. The Facility Oil Handling Operations and Design Standards Rule Chapter 173-180A-100, Transfer Pipeline requirements did not set forth requirements to install automated line shutoff equipment.



## Appendix B

**3.13.0 Identify all remaining pumps in the refinery which have cast iron casings and have the potential to impact the waters of the state. Internally and externally inspect each pump and verify structural and mechanical integrity. Remove pumps with cracked casings from operation. All replacement pumps must meet current API pump standards. Cast iron pumps which are found to be mechanically and structurally sound may remain in service. Texaco shall develop a replacement schedule for all cast iron pumps which is prioritized on the protection of worker health and safety and environmental protection.**

**Status:** Item Closed. Information relating to the pumps which were identified and changed as a result of the consent decree from cast iron casings to carbon steel casings are as follows;

• Crude Booster Pump	22RG-2	Cast Iron to Carbon Steel
• Crude Booster Pump	22RG-3	Removed from Service
• Clean Systems LFR/LFP Inj.	22RG-13	Cast Iron to Carbon Steel (Dock)
• Clean Systems LR Inj.	22RG-16	Cast Iron to Carbon Steel (Dock)
• Butane Unloading Pump	22NG-5	Cast Iron to Carbon Steel (Truck Rack)
• Jiskoot Pump	22RG-35	Carbon Steel (Dock), Installed new in 1984
• A-Anchor Sump Pump	22RG-39	Stainless Steel (A-Anchor Sump), Installed new 1995.
• Dock Slop Pump	22RG-1	Carbon Steel Dock Berth #3
• MLA Pump Out	22RG-25	Carbon Steel Dock Berth #1
• MLA Pump Out	22RG-26	Carbon Steel Dock Berth #2

Pump specification information is provided in Volume II on the following pumps; 22RG2, 22RG-13, 22RG-16 and 22NG-5 resulting in the change in kind from cast iron to carbon steel.. All other pumps were installed new as carbon steel or stainless prior to or after the 91 Fidalgo Bay Spill.



## **Appendix B**

### **3.14.0 Expose and radiologically examine segments of underground transfer pipeline in intervals not exceeding five years and submit operating practices to Ecology.**

**Status:** Active. The first inspection was completed on March 2, 1992, the procedure and the inspectors comments are enclosed in this section.



TEXACO -- PSP INSPECTION DEPARTMENT	<b>UNDERGROUND LINES EXCAVATION, INSPECTION, BACKFILL</b>	INSP. PROCEDURE Rev. 0 March 22, 1995 Page 1 of 2
AUTHORIZED BY: <i>J. C. Owen</i>		DATE: <i>4/24/95</i>

The excavation, installation, repair, inspection, and backfilling of underground lines must be accomplished using the following guides to assure that coatings are properly installed and intact in order to provide corrosion protection and minimize the possibility of line failure.

Prior to excavating, either for new installations or for work on existing lines, obtain the proper permits to assure safety and to establish the location of other lines or electrical lines. (See section XIII SPECIAL HAZARDS, paragraph A. DITCHING OR EXCAVATING in the SAFETY WORK PERMIT instruction book.) If the piping is under cathodic protection, see STANDING INSTRUCTION NO. 38 for additional instructions.

Care should be exercised in removing soil from above and around the piping to prevent damaging the line or line coating. The last few inches of soil should be removed manually to avoid this possibility. If the excavation is sufficiently deep, the sides of the trench should be properly shored to prevent their collapse, in accordance with OSHA regulations, where applicable. If the coating or wrapping is deteriorated or damaged, it should be removed in that area to inspect the condition of the underlying metal. (API 570 7.1.6c)

Excavate the piping full circumference for a length of six to eight feet for inspection of the type and extent of corrosion and the condition of the coating. If inspection reveals damaged coating or corroded piping, additional piping shall be excavated until the extent of the condition is identified. (API 570 7.2.6)

All ungalvanized carbon steel pipe (buried in soil or sand) whose normal operating temperature is 150 degrees F or lower shall be protected by an external coating. (GEMS J-1D19 6.11.2)

Coated lines shall be handled in a manner which will not damage the coating. Use padded slings for lifting lines, support lines with materials which will not gouge or crush the coating, etc.

Pressure test new or repaired lines before coating welds.

Lines shall be coated as specified in GEMS J-6M6.

Primer and prefabricated tape shall be from the same manufacturer. Application of cold-applied tape and mastic shall conform to American Water Works Association C-209, Section 3. (GEMS J-6M6 4.3)

Valves, flanges, and other irregular surfaces in underground service shall have a mastic coating over entire exposed surface. Coverage shall be complete and a tight seal made with adjacent pipe wrap. (GEMS J-6M6 4.3)

*DB A*  
*MAF*  
*LWA*  
*PLM*  
*GLA*  
*GLJ 2*



TEXACO -- PSP INSPECTION DEPARTMENT	UNDERGROUND LINES EXCAVATION, INSPECTION, BACKFILL	INSP. PROCEDURE Rev. 0 March 22, 1995 Page 2 of 2
---	---	--

Risers from underground pipe shall be wrapped with tape to a minimum of 6 in. above finish grade (top of paving) and neatly terminated with two full laps of tape. (GEMS J-6M6 4.3)

After a line has been coated, use an electric holiday detector to determine if there are any defects in the coating. Repair all defects in the coating and repeat the holiday test on the repaired area.

After successful testing, backfill with washed sand a minimum of six inches below and above the line. Rocks, welding rod, construction debris, roots, etc. shall not be permitted to contact the coating. Native backfill material may be placed over the sand. All backfill material should be compacted to prevent settling.



TEXACO -- PSP INSPECTION DEPARTMENT	WHARF TRANSFER LINES	INSP. PROCEDURE Rev. 0 January 5, 1995 Page 1 of 2
AUTHORIZED BY: <i>J. C. Owen</i>		DATE: <i>3/10/85</i>

**OBJECTIVE:** The purpose of this procedure is to define the extent, location and type of inspection to be performed on transfer lines from the refinery to the wharf to ensure the integrity of the lines.

**INSPECTION FREQUENCY:**

- Visual -- monthly
- Pressure testing -- annually
- Ultrasonic thickness -- three years
- Radiographic -- five years

**PROCEDURE:**

The transfer lines between "A" anchor and the wharf shall be visually inspected monthly to check the general condition of the piping, insulation or paint. The top sides of the lines will be inspected from the causeway, and the bottom sides of the lines will be inspected from a boat. The results of this inspection are recorded on a MONTHLY FACILITY INSPECTION SHEET provided by the EH&S department. A copy of the form is filed in the inspection department's zone 4 - wharf files, and the original form is returned to EH&S.

*DB DB*  
~~MAF~~  
~~LWA~~  
~~PLM~~  
~~GLA~~  
~~CLT~~

Annually, when directed by the monthly inspection work list, the inspector for zone 4 will issue a work order to M&C to pressure test the transfer lines at 1.5 times the MAWP. The section of lines to be tested is from the end of the lines at the wharf to the first block valve inside secondary containment. "Inside secondary containment" is within the tank No. 1 dike for the crude line and at the shipping pumps for the other product lines. Lines will be tested using the product normally in the line. The test is held for a minimum of twenty minutes with the initial and final pressures recorded. Results of each test are recorded on the inspection department's WHARF LINE PRESSURE TESTING form and filed in the inspection department's zone 4 - wharf - loading lines file.

The drain lines from the transfer lines at "A" anchor will be inspected annually using ultrasonic and / or radiographic NDE in conjunction with the annual pressure test.

Ultrasonic thickness measurements shall be taken every three years on the above ground transfer lines, as scheduled by the monthly inspection list, at locations set up in the PLANT CORROSION MONITORING SYSTEM (PCMS). Results of the thickness survey will be recorded in PCMS where the corrosion rate and next inspection date for each point will be calculated. If the next inspection date is less than three years, a special inspection date will be established for that point and added to the monthly inspection list for zone 4.

At the time the ultrasonic inspections are made, visual inspections will be made on the lines where they slide on the pipe supports.



TEXACO -- PSP INSPECTION DEPARTMENT	WHARF TRANSFER LINES	INSP. PROCEDURE Rev. 0 January 5, 1995 Page 2 of 2
---	-------------------------	---

The underground portions of the transfer lines will have three areas ten feet long exposed for visual and radiographic inspections every five years. When scheduled by the monthly inspection list, the zone 4 inspector will issue a TMASS work order to initiate the excavation of the lines. Radiographs will be made by an authorized NDE contractor on at least five feet of each line. Results of these inspections will be recorded in the inspection department's zone 4 wharf files.

The inspector will issue a TMASS work order to correct deficiencies observed in the transfer line inspections.



3/2/92

THE UNDERGROUND LINES GOING TO THE DOCK WERE EXPOSED AT THREE LOCATIONS TO CHECK FOR CORROSION. THE FIRST LOCATION WAS AT THE LEAK IN THE BUNKER LINE - THE LINES WERE IN GOOD CONDITION. THE SECOND LOCATION WAS AT THE CORNER OF NORTH TEXAS ROAD AND WEST MARCHES POINT ROAD - THE LINES WERE IN GOOD CONDITION. THE THIRD LOCATION WAS ACROSS THE WEST MARCHES POINT ROAD FROM TERA - THE LINES WERE IN GOOD CONDITION. THE LINES WERE UT CALIPERED AND RADIOGRAPHED (X-RAYED) AT ALL LOCATIONS WITH NO PROBLEMS NOTED, JRV THIS INSPECTION WAS APPROVED BY J.C. OIEN NAT BD OWNER USER COMM NO 304.



## **Appendix B**

**3.15.0 Pressure test all dock lines annually and submit standard operating practices to Ecology.**

**Status:** Active. The procedure and annual test results are provided in this section.



TEXACO -- PSP INSPECTION DEPARTMENT	WHARF TRANSFER LINES	INSP. PROCEDURE Rev. 0 January 5, 1995 Page 1 of 2
AUTHORIZED BY: <i>J. C. Owen</i>		DATE: <i>3/10/85</i>

**OBJECTIVE:** The purpose of this procedure is to define the extent, location and type of inspection to be performed on transfer lines from the refinery to the wharf to ensure the integrity of the lines.

**INSPECTION FREQUENCY:**

- Visual -- monthly
- Pressure testing -- annually
- Ultrasonic thickness -- three years
- Radiographic -- five years

**PROCEDURE:**

The transfer lines between "A" anchor and the wharf shall be visually inspected monthly to check the general condition of the piping, insulation or paint. The top sides of the lines will be inspected from the causeway, and the bottom sides of the lines will be inspected from a boat. The results of this inspection are recorded on a MONTHLY FACILITY INSPECTION SHEET provided by the EH&S department. A copy of the form is filed in the inspection department's zone 4 - wharf files, and the original form is returned to EH&S.

*DB DB*  
*MAS*  
*LWH*  
*PLM*  
*GLA*  
*GLT*

Annually, when directed by the monthly inspection work list, the inspector for zone 4 will issue a work order to M&C to pressure test the transfer lines at 1.5 times the MAWP. The section of lines to be tested is from the end of the lines at the wharf to the first block valve inside secondary containment. "Inside secondary containment" is within the tank No. 1 dike for the crude line and at the shipping pumps for the other product lines. Lines will be tested using the product normally in the line. The test is held for a minimum of twenty minutes with the initial and final pressures recorded. Results of each test are recorded on the inspection department's WHARF LINE PRESSURE TESTING form and filed in the inspection department's zone 4 - wharf - loading lines file.

The drain lines from the transfer lines at "A" anchor will be inspected annually using ultrasonic and / or radiographic NDE in conjunction with the annual pressure test.

Ultrasonic thickness measurements shall be taken every three years on the above ground transfer lines, as scheduled by the monthly inspection list, at locations set up in the PLANT CORROSION MONITORING SYSTEM (PCMS). Results of the thickness survey will be recorded in PCMS where the corrosion rate and next inspection date for each point will be calculated. If the next inspection date is less than three years, a special inspection date will be established for that point and added to the monthly inspection list for zone 4.

At the time the ultrasonic inspections are made, visual inspections will be made on the lines where they slide on the pipe supports.



TEXACO -- PSP INSPECTION DEPARTMENT	WHARF TRANSFER LINES	INSP. PROCEDURE Rev. 0 January 5, 1995 Page 2 of 2
---	-------------------------	---

The underground portions of the transfer lines will have three areas ten feet long exposed for visual and radiographic inspections every five years. When scheduled by the monthly inspection list, the zone 4 inspector will issue a TMASS work order to initiate the excavation of the lines. Radiographs will be made by an authorized NDE contractor on at least five feet of each line. Results of these inspections will be recorded in the inspection department's zone 4 wharf files.

The inspector will issue a TMASS work order to correct deficiencies observed in the transfer line inspections.



Summer 1995

WHARF LINE PRESSURE TESTING

DATE 5-30-95	DATE 5/30/95
LINE AVJET NO 1	LINE AVJET NO 2
PRESS START 325 PSI	PRESS START 325 PSI
PRESS FINISH 340	PRESS FINISH 340
TIME START 1330	TIME START 1330
TIME FINISH 1350	TIME FINISH 1350
DATE 6-1-95	DATE 6-1-95
LINE DIESEL #1	LINE DIESEL #2
PRESS START 350 PSI	PRESS START 350 PSI
PRESS FINISH 375	PRESS FINISH 370
TIME START 0910	TIME START 1250
TIME FINISH 0930	TIME FINISH 1310
DATE 6-1-95	DATE 5-31-95
LINE DIESEL #3	LINE BUNKER
PRESS START 350 PSI	PRESS START 250 PSI
PRESS FINISH 370	PRESS FINISH 260
TIME START 1230	TIME START 1030
TIME FINISH 1250	TIME FINISH 1050
DATE 5-31-95	DATE 5-30-95
LINE SUPR LD FREE SKY CHIEF	LINE FIRE CHIEF
PRESS START 225 PSI	PRESS START 225 PSI
PRESS FINISH 250	PRESS FINISH 250
TIME START 1030	TIME START 11 AM
TIME FINISH 1050	TIME FINISH 11:20 AM
DATE 7-14-95	DATE 6-29-95
LINE BALLAST	LINE CRUDE
PRESS START 125 PSI 100	PRESS START 200 PSI
PRESS FINISH 100	PRESS FINISH 200
TIME START 3 PM 7/13/95	TIME START 10:00
TIME FINISH 3 PM 7/14/95	TIME FINISH 10:20
DATE 5-30-95	DATE 6-1-95
LINE LEAD FREE	LINE FLUSHING OIL
PRESS START 225 PSI	PRESS START 200 PSI
PRESS FINISH 250	PRESS FINISH 230 "
TIME START 11 AM	TIME START 1030 AM
TIME FINISH 11:20 AM	TIME FINISH 1100

INSPECTOR

*D. Bugg*



**WHARF LINE PRESSURE TESTING**

DATE 7/18/94	DATE 7-19-94
LINE AVJET NO 1	LINE AVJET NO 2
PRESS START 325 PSI	PRESS START 325 PSI
PRESS FINISH 345	PRESS FINISH 325
TIME START 11:05	TIME START 12:55
TIME FINISH 11:30 O/B	TIME FINISH 13:20 O/B
DATE 7/19/94	DATE 7/19/94
LINE DIESEL #1	LINE DIESEL #2
PRESS START 350 PSI	PRESS START 350 PSI
PRESS FINISH 365	PRESS FINISH 365
TIME START 11:15	TIME START 11:15
TIME FINISH 11:35 O/B	TIME FINISH 11:35 O/B
DATE 7/20/94	DATE 7/14/94
LINE DIESEL #3	LINE BUNKER
PRESS START 350 PSI	PRESS START 250 PSI
PRESS FINISH 365	PRESS FINISH 255
TIME START 11:15	TIME START 13:30
TIME FINISH 11:35 O/B	TIME FINISH 14:00 O/B
DATE 7/20/94	DATE 7/13/94
LINE SUPR LD FREE SKY CHIEF	LINE FIRE CHIEF
PRESS START 225 PSI	PRESS START 225 PSI
PRESS FINISH 245	PRESS FINISH 235
TIME START 1500	TIME START 15:15
TIME FINISH 1525 O/B	TIME FINISH 15:45 O/B
DATE 7/22/94	DATE 7/22/94
LINE BALLAST	LINE CRUDE
PRESS START 125 PSI	PRESS START 200 PSI
PRESS FINISH 185	PRESS FINISH 220
TIME START 0915	TIME START 1255
TIME FINISH 0930 O/B	TIME FINISH 1327 O/B
DATE 7/13/94	DATE 7/22/94
LINE LEAD FREE	LINE FLUSHING OIL
PRESS START 225 PSI	PRESS START 200 PSI
PRESS FINISH 250	PRESS FINISH 220
TIME START 11:30 AM	TIME START 1255
TIME FINISH 12:00 Noon O/B	TIME FINISH 1327 O/B

INSPECTOR

*J. Berg*



7/29/93 these are due.

WHARF LINE PRESSURE TESTING

DATE 9-17-93	DATE 9/17/93
LINE AVJET NO 1	LINE AVJET NO 2
PRESS START 325 PSI	PRESS START 325 PSI
PRESS FINISH 370 PSI	PRESS FINISH 325
TIME START 9:15 AM	TIME START 1450
TIME FINISH 10:00 AM <i>YWT</i>	TIME FINISH 1510 <i>DB</i>
DATE 9/16/93	DATE 9/16/93
LINE DIESEL #1	LINE DIESEL #2
PRESS START 350 PSI <i>8</i>	PRESS START 350 PSI
PRESS FINISH 375	PRESS FINISH 360
TIME START 09:55	TIME START 10:50
TIME FINISH 10:15 <i>DB</i>	TIME FINISH 11:10 <i>DBuggy</i>
DATE 9-16-93	DATE 11/5/93
LINE DIESEL #3	LINE BUNKER
PRESS START 350 PSI	PRESS START 250 PSI
PRESS FINISH 360	PRESS FINISH 255
TIME START 11:30	TIME START 10:30
TIME FINISH 11:50 <i>DB</i>	TIME FINISH 10:50
DATE 8-9-93 9-14-93	DATE 8-9-93
LINE SUPR LD FREE SKY CHIEF	LINE FIRE CHIEF
PRESS START 225 PSI 240 240	PRESS START 225 PSI
PRESS FINISH 250 250	PRESS FINISH <del>225</del> 225
TIME START 13:25 14:00	TIME START 14:20
TIME FINISH 13:50 14:25 <i>DBuggy</i>	TIME FINISH 14:45 <i>DBuggy</i>
DATE 3/93	DATE 10/26/93
LINE BALLAST	LINE CRUDE 10-26-93
PRESS START 125 PSI	PRESS START 200 PSI
PRESS FINISH 124	PRESS FINISH 200
TIME START 09:00	TIME START 12:30 PM
TIME FINISH 09:30 <i>GLT</i>	TIME FINISH 12:50 PM <i>DBuggy</i>
DATE 9-13-93	DATE 9-13-93
LINE LEAD FREE	LINE FLUSHING OIL
PRESS START 225 PSI	PRESS START 200 PSI
PRESS FINISH 240	PRESS FINISH 305
TIME START 14:00	TIME START 12:40
TIME FINISH 14:30 <i>DBuggy</i>	TIME FINISH 1:10 <i>GLT</i>

INSPECTOR *DBuggy*

*In April 1993  
Copy*



**WHARF LINE PRESSURE TESTING**

DATE <u>12/18/92</u>	DATE <u>12/22/92</u>
LINE AVJET NO 1	LINE AVJET NO 2
PRESS START 325 PSI	PRESS START 325 PSI 266
PRESS FINISH 325	PRESS FINISH 266
TIME START 14:50	TIME START 15:00
TIME FINISH 15:10 DB	TIME FINISH 15:30 DB
DATE	DATE <u>12/21/92</u>
LINE DIESEL #1	LINE DIESEL #2
PRESS START 350 PSI	PRESS START 350 PSI
PRESS FINISH 380	PRESS FINISH 360
TIME START 0900	TIME START 13:25
TIME FINISH 0925 DB	TIME FINISH 13:45 DB
DATE <u>12/21/92</u>	DATE <u>12/18/92</u>
LINE DIESEL #3	LINE BUNKER
PRESS START 350 PSI	PRESS START 250 PSI
PRESS FINISH 366	PRESS FINISH 250
TIME START 10:35	TIME START 10:30
TIME FINISH 10:56 DB	TIME FINISH 11:00 DB
DATE <u>12/17/92</u>	DATE
LINE SUPR LD FREE SKY CHIEF	LINE FIRE CHIEF
PRESS START 225-PSI 245	PRESS START 225 PSI
PRESS FINISH 250	PRESS FINISH
TIME START 10:20 AM	TIME START
TIME FINISH 10:40 AM DB	TIME FINISH
DATE <u>3/93</u> Approx.	DATE
LINE BALLAST	LINE CRUDE
PRESS START 125 PSI	PRESS START 200 PSI
PRESS FINISH 124	PRESS FINISH 200
TIME START 09:00 P.M. HA	TIME START 10:55
TIME FINISH 09:30 P.M. HA	TIME FINISH 11:25 DB
DATE <u>12/17/92</u>	DATE
LINE LEAD FREE	LINE FLUSHING OIL MTBE
PRESS START 225 PSI 230	PRESS START 200 PSI
PRESS FINISH 260	PRESS FINISH 200
TIME START 13:15	TIME START 14:15
TIME FINISH 13:40 DB	TIME FINISH 14:35 DB

Normal Pressure  
Not Used Because  
No Water at Dock  
To Use Test Pump +  
S.D.P. Pump would Not  
Produce Any Higher PSI.  
DB

INSPECTOR

*Dick L. Bugg*



10-91

WHARF LINE PRESSURE TESTING

DATE 10-1-91	JRV	DATE 10-1-91	JRV
LINE AVJET NO 1		LINE AVJET NO 2	
PRESS START 325 PSI		PRESS START 325 PSI	
PRESS FINISH 360 PSI		PRESS FINISH 360 PSI	
TIME START 2:00 PM		TIME START 2:00 PM	
TIME FINISH 2:20 PM		TIME FINISH 2:00 PM	
DATE 10-1-91	JRV	DATE 10-1-91	JRV
LINE DIESEL #1		LINE DIESEL #2	
PRESS START 350 PSI		PRESS START 350 PSI	
PRESS FINISH 380 PSI		PRESS FINISH 380 PSI	
TIME START 9:35 AM		TIME START 9:35 AM	
TIME FINISH 9:55 AM		TIME FINISH 9:55 AM	
DATE 10-1-91	JRV	DATE 10-1-91	RB
LINE DIESEL #3		LINE BUNKER	
PRESS START 350 PSI		PRESS START 250 PSI	
PRESS FINISH 380 PSI		PRESS FINISH 260 PSI	
TIME START 9:55 AM		TIME START 1550	
TIME FINISH 9:55		TIME FINISH 1610	
DATE 9-26-91	DB	DATE 9-26-91	LWH
LINE SUPR LD FREE SKY CHIEF		LINE FIRE CHIEF	
PRESS START 225 PSI		PRESS START 225 PSI	
PRESS FINISH 250 PSI		PRESS FINISH 250 PSI	
TIME START 4:00 PM		TIME START 2:25 PM	
TIME FINISH 4:25 PM		TIME FINISH 3:00 PM	
DATE		DATE 10-2-91	JRV
LINE BALLAST		LINE CRUDE	
PRESS START 125 PSI		PRESS START 200 PSI	
PRESS FINISH		PRESS FINISH 200 PSI	
TIME START	NEED PAIRS	TIME START 11:10 PM	
TIME FINISH	20 PAIRS	TIME FINISH 1:30 PM	
DATE 9-30-91	DB	DATE 10-2-91	JRV
LINE LEAD FREE		LINE FLUSHING OIL	
PRESS START 225 PSI	225	PRESS START 200 PSI	
PRESS FINISH 250 PSI		PRESS FINISH 200 PSI	
TIME START 15:55		TIME START 1:10 PM	
TIME FINISH 16:15		TIME FINISH 1:50 PM	

INSPECTOR J. P. Valentin



## **Appendix B**

**3.16.0 Pressure test all marine loading arms annually and submit standard operating practices to Ecology.**

**Status:** Active. The procedure and annual test results are provided in this section.



TEXACO -- PSP INSPECTION DEPARTMENT	WHARF MARINE LOADING ARMS	INSP. PROCEDURE Rev. 0 January 6, 1995 Page 1 of 1
AUTHORIZED BY: <i>J.C. Davis</i>		DATE: <i>3/10/95</i>

**OBJECTIVE:** The purpose of this procedure is to define the extent and type of inspections to be performed on marine loading arms.

**INSPECTION FREQUENCY:** Marine loading arms are inspected and tested annually.

**PROCEDURE:** Issue a TMASS work order for hydrotesting of marine loading arms per Standing Instruction No. 99 when scheduled by the monthly inspection list.

Witness the testing and conduct a visual inspection of the loading arms. The loading arm and swing joints must be leak free.

Issue a TMASS work order to correct deficiencies found during the inspection and test.

Update the monthly work list.

**DOCUMENTATION:** Record the results of the inspection and test on the *Dock Loading Arm Test* form and file it in the Wharf Loading Arms binder located in the zone 4 - Wharf filing cabinet.

*DB*  
*MAF*  
*LWH*  
*PLM*  
*CLA*  
*GLT*



## DOCK LOADING ARM TEST

pg #1

BERTH NO	ARM NO	JOINT NO	MANUF	PRODUCT	MWAP	TEST PRESS	DATE LAST TEST	NEXT TEST DUE
1	1	1	FMC	GASO/DIESEL AVJET	265	400	8/4/94 DB	
		2			"	"	8/4/94 DB	
		3			"	"	8/4/94 DB	
1	2	1	FMC	GASO/DIESEL AVJET	265	400	5/10/94 DB	
		2			"	"	5/10/94 DB	
		3			"	"	5/10/94 DB	
1	3	1	FMC	BUNKER BALLAST	265	400	5/12/94 DB	
		2			"	"	5/12/94 DB	
		3			"	"	5/12/94 DB	
1	4	1	FMC	CRUDE	265	400	6/94 PFM	
		2			"	"	6/94 PFM	
		3			"	"	6/94 PFM	
1	5	1	FMC	CRUDE	265	400	6/94 PFM	
		2			"	"	6/94 PFM	
		3			"	"	6/94 PFM	

ARMS ARE NUMBERED WEST TO EAST  
JOINTS ARE NUMBERED FROM UPSTREAM TO END OF NOZZLE



1800 0127  
19

DOCK LOADING ARM TEST

BERTH NO	ARM NO	JOINT NO	MANUF	PRODUCT	MWAP	TEST PRESS	DATE LAST TEST	NEXT TEST DUE
2	1	1	FMC	GASO/DIESEL AVJET	265	400	8/4/94	N.A.
		2			"	"	8/4/94	N.A.
		3			"	"	8/4/94	N.A.
2	2	1	FMC	GASO/DIESEL AVJET	265	400	8/3/94	DB
		2			"	"	8/3/94	DB
		3			"	"	8/3/94	DB
2	3	1	FMC	BALLAST BUNKER/CRUDE	265	400	8/3/94	DB
		2			"	"	8/3/94	DB
		3			"	"	8/3/94	DB

ALUMINUM SPOOL PICES (8 TOTAL)

NO	PIPE SIZE	FLANGE SIZE	INSPECTOR	TEST PRESS	DATE LAST TEST	NEXT TEST DUE
10	12"	12X16	DB	400	7/94	7/95
20	12"	12X16	DB	"	7/94	
30	10"	10X12	DB	"	7/94	
40	8"	8X8 8X10	DB	"	7/94	
50	6"	6X8	DB	"	7/94	

ARMS ARE NUMBERED EAST TO WEST  
JOINTS ARE NUMBERED FROM UPSTREAM TO END OF NOZZLE

28  
205-  
-5902



DOCK LOADING ARM TEST

BERTH NO	ARM NO	JOINT NO	MANUF	PRODUCT	MWAP	TEST PRESS	DATE LAST TEST	NEXT TEST DUE
ME 1	1	1	FMC	GASO/DIESEL AVJET	265	400	<i>[Handwritten scribble]</i>	
		2			"	"		
		3			"	"		
1	2	1	FMC	GASO/DIESEL AVJET	265	400		
		2			"	"	<i>5/4/94 Temp seal installed. TEST OK @ 400. DB</i>	
		3			"	"		
1	3	1	FMC	BUNKER BALLAST	265	400	<i>[Handwritten scribble]</i>	
		2			"	"		
		3			"	"	<i>[Handwritten scribble]</i>	
1	4	1	FMC	CRUDE	265	400		
		2			"	"	<i>NEW seal installed OK, 9/17/93 DB</i>	
		3			"	"		
1	5	1	FMC	CRUDE	265	400	<i>[Handwritten scribble]</i>	
		2			"	"	<i>10/11/93 New seal installed</i>	
		3			"	"	<i>TEST OK @ 400 DB</i>	

ARMS ARE NUMBERED WEST TO EAST  
JOINTS ARE NUMBERED FROM UPSTREAM TO END OF NOZZLE



## DOCK LOADING ARM TEST

pg #1

BERTH NO	ARM NO	JOINT NO	MANUF	PRODUCT	MWAP	TEST PRESS	DATE LAST TEST	NEXT TEST DUE
1	1	1	FMC	GASO/DIESEL AVJET	265	400	8-5-93 <i>YJA</i>	
		2			"	"	8-5-93 <i>YJA</i>	
		3			"	"	8-5-93 <i>YJA</i>	
1	2	1	FMC	GASO/DIESEL AVJET	265	400	8-5-93 <i>YJA</i>	
		2			"	"	8-5-93 <i>YJA</i>	
		3			"	"	8-5-93 <i>YJA</i>	
1	3	1	FMC	BUNKER BALLAST	265	400	7-6-93 <i>YJA</i>	
		2			"	"	7-6-93 <i>YJA</i>	
		3			"	"	7-6-93 <i>YJA</i>	
1	4	1	FMC	CRUDE	265	400	7-6-93 <i>YJA</i>	
		2			"	"	7-6-93 <i>YJA</i>	
		3			"	"	7-6-93 <i>YJA</i>	
1	5	1	FMC	CRUDE	265	400	7-8-93 <i>YJA</i>	
		2			"	"	7-8-93 <i>YJA</i>	
		3			"	"	7-8-93 <i>YJA</i>	

ARMS ARE NUMBERED WEST TO EAST  
 JOINTS ARE NUMBERED FROM UPSTREAM TO END OF NOZZLE



BERTH NO	ARM NO	JOINT NO	MANUF	PRODUCT	MWAP	TEST PRESS	DATE LAST TEST	NEXT TEST DUE
2	1	1	FMC	GASO/DIESEL AVJET	265	400	5/6/93 PPM	
		2			"	"	5/6/93 PPM	
		3			"	"	5/6/93 PPM	
2	2	1	FMC	GASO/DIESEL AVJET	265	400	5/6/93 PPM	
		2			"	"	5/6/93 PPM	
		3			"	"	5/6/93 PPM	
2	3	1	FMC	BALLAST BUNKER/CRUDE	265	400	5/6/93 PPM	
		2			"	"	5/6/93 PPM	
		3			"	"	5/6/93 PPM	

Tested OK 9/10/93  
after changing gasket  
Leaking 1-16-93  
Order # 9308440

only one 6"

ALUMINUM SPOOL PICES (8 TOTAL)

NO	PIPE SIZE	FLANGE SIZE	INSPECTOR	TEST PRESS	DATE LAST TEST	NEXT TEST DUE
10	12"	12X16	GLJ-LWH	400	9-3-93	
20	12"	12X16	GLJ-LWH	"	9-3-93	
30	10"	10X12	GLJ-LWH	"	9-3-93	
40	8"	8X10	GLJ-LWH	"	9-3-93	
50	6"	6X8	GLJ-LWH	"	9-3-93	

ARMS ARE NUMBERED EAST TO WEST  
JOINTS ARE NUMBERED FROM UPSTREAM TO END OF NOZZLE

9-3-93  
9-3-93

#5 8" 8x8  
#6 8" 8x8



DOCK LANDING ARM TEST

BERTH NO	ARM NO	JOINT NO	MANUF	PRODUCT	MWAP	TEST PRESS	DATE LAST TEST	NEXT TEST DUE
1	1	1	FMC	GASO/DIESEL AVJET	265	400	6/29/93	Seal was
		2			"	"	Changed.	Tested
		3			"	"	@ 250 PSI	NITROGEN.
1	2	1	FMC	GASO/DIESEL AVJET	265	400		
		2			"	"		
		3			"	"		
1	3	1	FMC	BUNKER BALLAST	265	400		
		2			"	"		
		3			"	"		
1	4	1	FMC	CRUDE	265	400		
		2			"	"		
		3			"	"		
1	5	1	FMC	CRUDE	265	400		
		2			"	"		
		3			"	"		

PLM/  
GLA

ARMS ARE NUMBERED WEST TO EAST  
JOINTS ARE NUMBERED FROM UPSTREAM TO END OF NOZZLE



DOCK L...ING ARM TEST

BERTH NO	ARM NO	JOINT NO	MANUF	PRODUCT	MWAP	TEST PRESS	DATE LAST TEST	NEXT TEST DUE
1	1	1	FMC	GASO/DIESEL AVJET	265	400	4-9-92	SEALS CHANGED SRV
		2			"	"		FOR MTBE
		3			"	"		
1	2	1	FMC	GASO/DIESEL AVJET	265	400		
		2			"	"		
		3			"	"		
1	3	1	FMC	BUNKER BALLAST	265	400		
		2			"	"		
		3			"	"		
1	4	1	FMC	CRUDE	265	400		
		2			"	"		
		3			"	"		
1	5	1	FMC	CRUDE	265	400		
		2			"	"		
		3			"	"		

ARMS ARE NUMBERED WEST TO EAST  
JOINTS ARE NUMBERED FROM UPSTREAM TO END OF NOZZLE



DOCK LANDING ARM TEST

BERTH NO	ARM NO	JOINT NO	MANUF	PRODUCT	MWAP	TEST PRESS	DATE LAST TEST	NEXT TEST DUE
2	1	1	FMC	GASO/DIESEL AVJET	265	400	4-10-92	SEALS CHANGED FOR MTE. JR ✓
		2			"	"		
		3			"	"		
2	2	1	FMC	GASO/DIESEL AVJET	265	400		
		2			"	"		
		3			"	"		
2	3	1	FMC	BALLAST BUNKER/CRUDE	265	400		
		2			"	"		
		3			"	"		

ALUMINUM SPOOL PICES (8 TOTAL)

NO	PIPE SIZE	FLANGE SIZE	INSPECTOR	TEST PRESS	DATE LAST TEST	NEXT TEST DUE
10	12"	12X16		400	11/92	11/94
20	12"	12X16		"		
30	10"	10X12		"		
40	8"	8X10		"		
50	6"	6X8		"	DB	

EAST WEST  
WEST TO EAST

ARMS ARE NUMBERED FROM UPSTREAM TO END OF NOZZLE  
JOINTS ARE NUMBERED FROM UPSTREAM TO END OF NOZZLE



## DOCK LOADING ARM TEST

pg #1

BERTH NO	ARM NO	JOINT NO	MANUF	PRODUCT	MWAP	TEST PRESS	DATE LAST TEST	NEXT TEST DUE
1	1	1	FMC	GASO/DIESEL AVJET	265	400	10-18-91 JRV	10-92
		2			"	"	"	
		3			"	"	"	
1	2	1	FMC	GASO/DIESEL AVJET	265	400	10-18-91 JRV	
		2			"	"	"	
		3			"	"	"	
1	3	1	FMC	BUNKER BALLAST	265	400	10-29-91 JRV	
		2			"	"	"	
		3			"	"	"	
1	4	1	FMC	CRUDE	265	400	10-30-91 JRV	
		2			"	"	"	
		3			"	"	"	
1	5	1	FMC	CRUDE	265	400	10-30-91 JRV	
		2			"	"	"	
		3			"	"	"	Y

ARMS ARE NUMBERED WEST TO EAST  
JOINTS ARE NUMBERED FROM UPSTREAM TO END OF NOZZLE



## DOCK LOADING ARM TEST

pg #1

BERTH NO	ARM NO	JOINT NO	MANUF	PRODUCT	MWAP	TEST PRESS	DATE LAST TEST	NEXT TEST DUE
1	1	1	FMC	GASO/DIESEL AVJET	265	400	8-1-91	8-1-92
		2			"	"	"	"
		3			"	"	"	"
1	2	1	FMC	GASO/DIESEL AVJET	265	400	9-17-91	9-17-92
		2			"	"	"	"
		3			"	"	"	"
1	3	1	FMC	BUNKER BALLAST	265	400	9-17-91	9-17-92
		2			"	"	"	"
		3			"	"	"	"
1	4	1	FMC	CRUDE	265	400	9-21-91	9-21-92
		2			"	"	"	"
		3			"	"	"	"
1	5	1	FMC	CRUDE	265	400	10-1-91	10-1-92
		2			"	"	"	"
		3			"	"	"	"

ARMS ARE NUMBERED WEST TO EAST  
 JOINTS ARE NUMBERED FROM UPSTREAM TO END OF NOZZLE



## DOCK LOADING ARM TEST

pg #2

BERTH NO	ARM NO	JOINT NO	MANUF	PRODUCT	MWAP	TEST PRESS	DATE LAST TEST	NEXT TEST DUE
2	1	1	FMC	GASO/DIESEL AVJET	265	400	10-10-91 <i>PLH</i>	10-92
		2			"	"	"	
		3			"	"	"	
"	2	1	FMC	GASO/DIESEL AVJET	265	400	10-15-91 <i>PLH</i>	
		2			"	"	"	
		3			"	"	"	
2	3	1	FMC	BALLAST BUNKER/CRUDE	265	400	10-18-91 <i>PLH</i>	
		2			"	"	"	
		3			"	"	"	

## ALUMINUM SPOOL PICES (8 TOTAL)

NO	PIPE SIZE	FLANGE SIZE	INSPECTOR	TEST PRESS	DATE LAST TEST	NEXT TEST DUE
10	12"	12X16	<i>JRV</i>	400	11-1-91	11-92
20	12"	12X16	<i>JRV</i>	"	11-1-91	
30	10"	10X12	<i>JRV</i>	"	11-1-91	
40	8"	8X10	<i>JRV</i>	"	11-1-91	
50	6"	6X8	<i>JRV</i>	"	11-1-91	

ARMS ARE NUMBERED WEST TO EAST  
JOINTS ARE NUMBERED FROM UPSTREAM TO END OF NOZZLE



## **Appendix B**

**3.17.0 Conduct ultrasonic tests on all above ground transfer lines at intervals not exceeding three years and submit standard operating practices to Ecology.**

**Status:** Active. The procedure and test results are provided in this section.



TEXACO -- PSP INSPECTION DEPARTMENT	WHARF TRANSFER LINES	INSP. PROCEDURE Rev. 0 January 5, 1995 Page 1 of 2
AUTHORIZED BY: <i>J. C. Owen</i>		DATE: <i>3/10/95</i>

**OBJECTIVE:** The purpose of this procedure is to define the extent, location and type of inspection to be performed on transfer lines from the refinery to the wharf to ensure the integrity of the lines.

**INSPECTION FREQUENCY:**

- Visual -- monthly
- Pressure testing -- annually
- Ultrasonic thickness -- three years
- Radiographic -- five years

**PROCEDURE:**

The transfer lines between "A" anchor and the wharf shall be visually inspected monthly to check the general condition of the piping, insulation or paint. The top sides of the lines will be inspected from the causeway, and the bottom sides of the lines will be inspected from a boat. The results of this inspection are recorded on a MONTHLY FACILITY INSPECTION SHEET provided by the EH&S department. A copy of the form is filed in the inspection department's zone 4 - wharf files, and the original form is returned to EH&S.

*DB DB*  
*MAF*  
*LWH*  
*PLM*  
*GLA*  
*CLS*

Annually, when directed by the monthly inspection work list, the inspector for zone 4 will issue a work order to M&C to pressure test the transfer lines at 1.5 times the MAWP. The section of lines to be tested is from the end of the lines at the wharf to the first block valve inside secondary containment. "Inside secondary containment" is within the tank No. 1 dike for the crude line and at the shipping pumps for the other product lines. Lines will be tested using the product normally in the line. The test is held for a minimum of twenty minutes with the initial and final pressures recorded. Results of each test are recorded on the inspection department's WHARF LINE PRESSURE TESTING form and filed in the inspection department's zone 4 - wharf - loading lines file.

The drain lines from the transfer lines at "A" anchor will be inspected annually using ultrasonic and / or radiographic NDE in conjunction with the annual pressure test.

Ultrasonic thickness measurements shall be taken every three years on the above ground transfer lines, as scheduled by the monthly inspection list, at locations set up in the PLANT CORROSION MONITORING SYSTEM (PCMS). Results of the thickness survey will be recorded in PCMS where the corrosion rate and next inspection date for each point will be calculated. If the next inspection date is less than three years, a special inspection date will be established for that point and added to the monthly inspection list for zone 4.

At the time the ultrasonic inspections are made, visual inspections will be made on the lines where they slide on the pipe supports.




TEXACO -- PSP INSPECTION DEPARTMENT	WHARF TRANSFER LINES	INSP. PROCEDURE Rev. 0 January 5, 1995 Page 2 of 2
---	-------------------------	---

The underground portions of the transfer lines will have three areas ten feet long exposed for visual and radiographic inspections every five years. When scheduled by the monthly inspection list, the zone 4 inspector will issue a TMASS work order to initiate the excavation of the lines. Radiographs will be made by an authorized NDE contractor on at least five feet of each line. Results of these inspections will be recorded in the inspection department's zone 4 wharf files.

The inspector will issue a TMASS work order to correct deficiencies observed in the transfer line inspections.



North

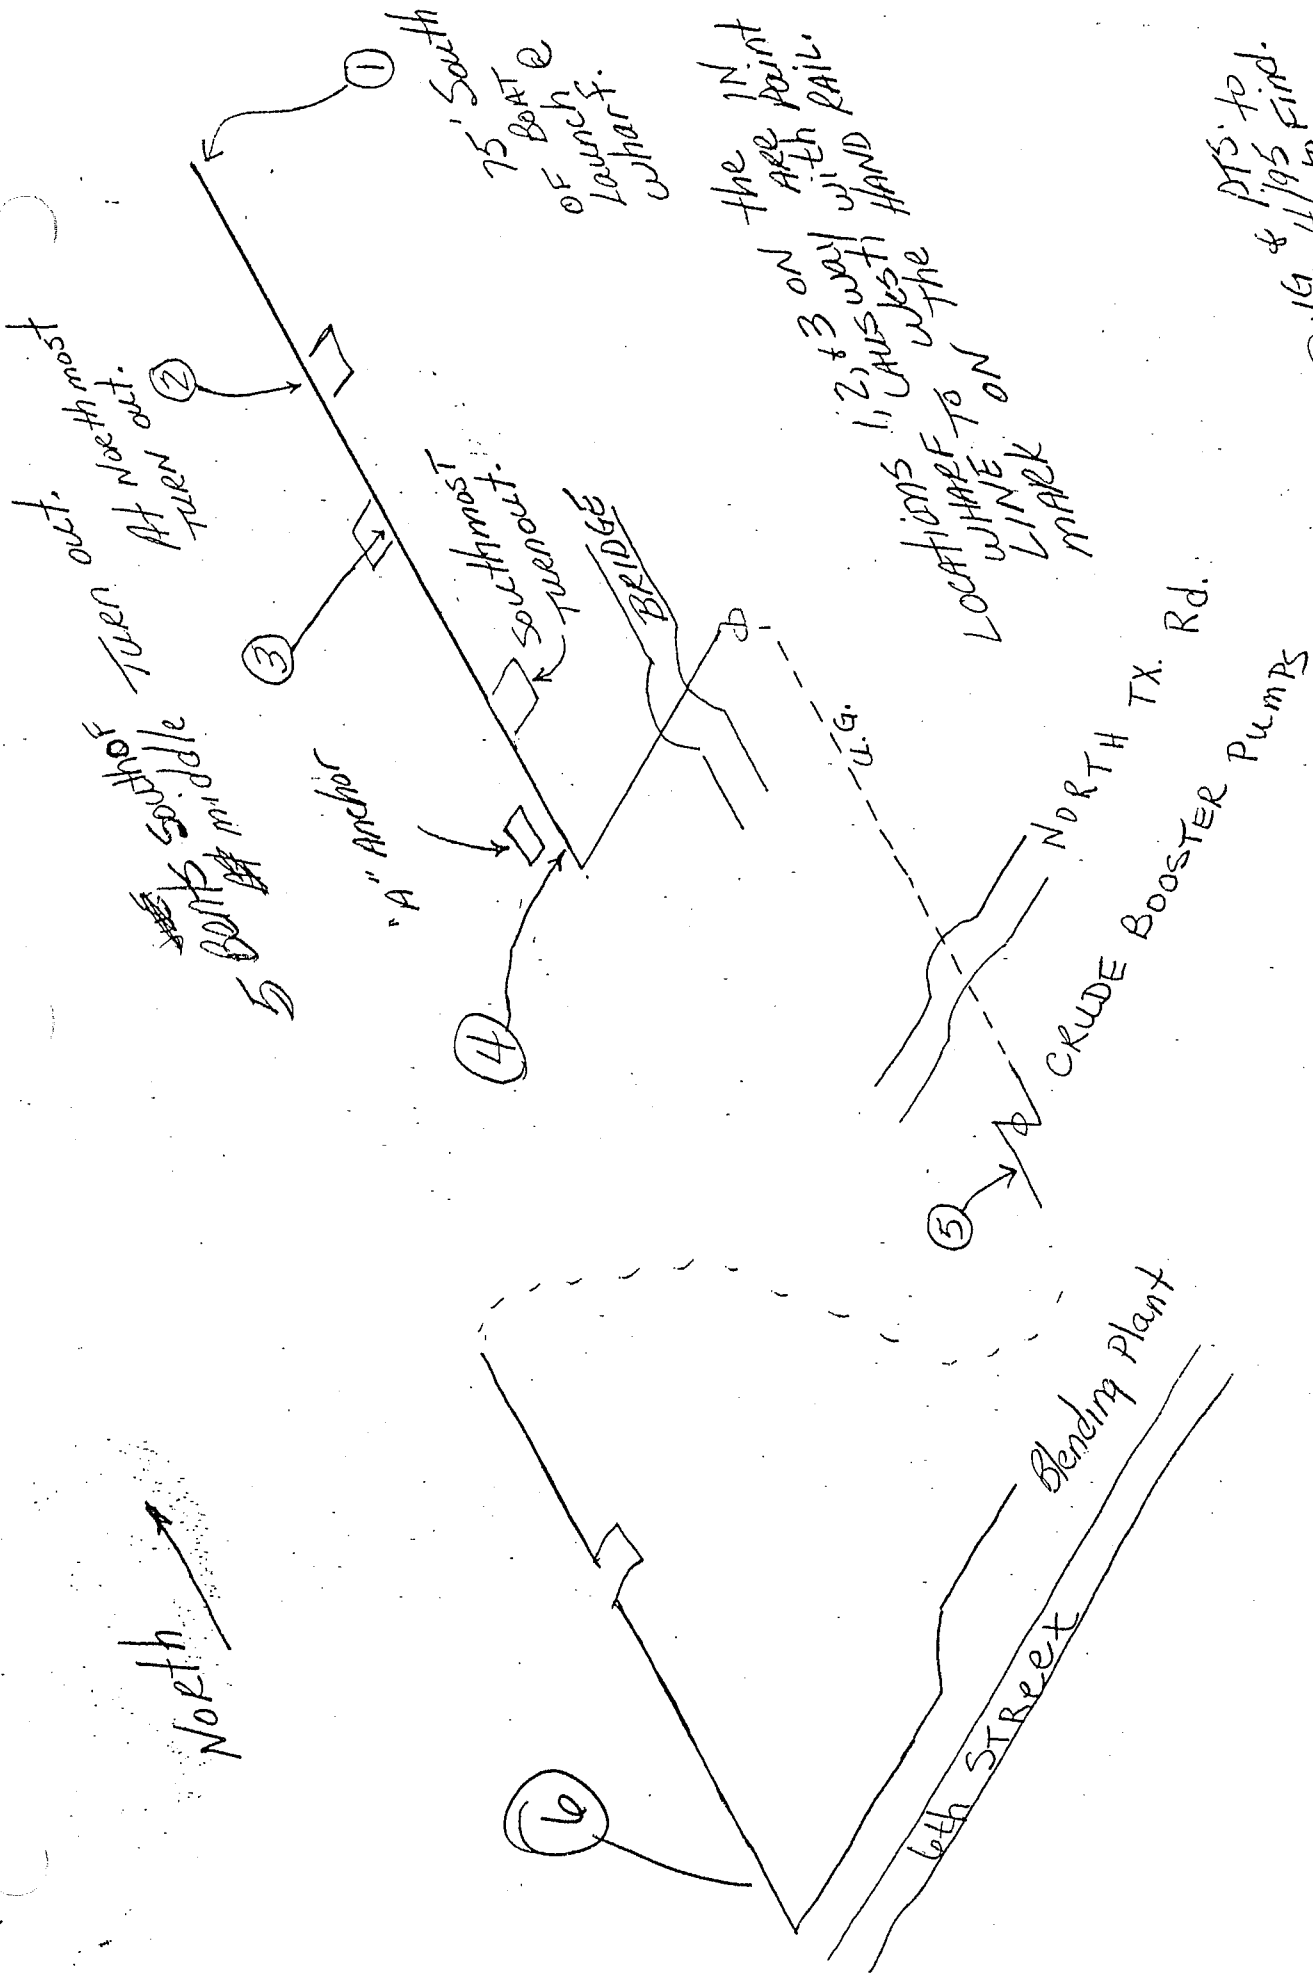



PTS. to DWG & 1/95 FIND. Revised 4/195 BB make easier




North

F01  
F02  
F03  
F04

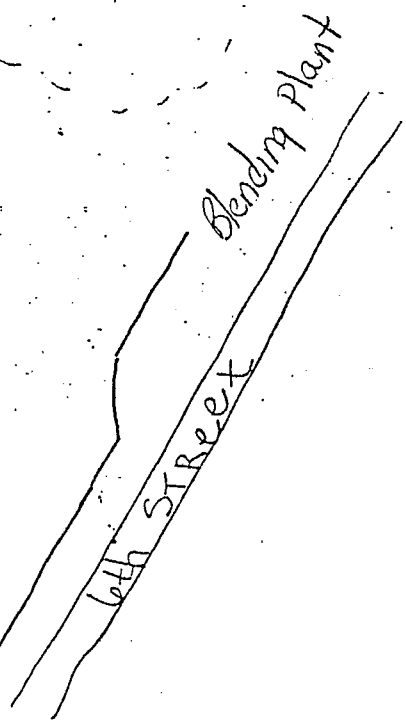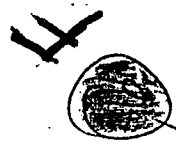

A  
A01  
A02  
A03  
A04  
75' South  
of Boat @  
Lunch  
Wharf.

the IN  
point  
are  
with  
RAIL.

PTS. to  
Dwg & P/95 Find.  
Revise & ease AB  
make

B01  
B02  
B03  
B04



TURN  
At North  
out.

C01  
C02  
C03  
C04



TURN  
At South

5  
B01  
B02  
B03  
B04  
middle

Southmost  
TURN

BRIDGE

D01  
D02  
D03  
D04



A  
Anchor

E01  
E02  
E03  
E04



CRUDE BOOSTER PUMPS  
NORTH TX. Rd.

LOCATIONS  
WHERE TO  
WINE ON  
WINK  
MARK

U.S.



\*TP= Through Paint  
 \*CG= Couldn't Get

WHARF PRODUCT LINE CALIPERINGS PT. NO. 2 NEW PTS ESTABLISHED

LINE NO.	SERVICE	ORIG.	DATE 3/20/86			DATE 3/90			DATE 3/92			DATE 4/95		
			T	B	M	T	B	M	T	B	M	T	B	M
6" 22R-0-DW-1	Fire and Drinking Water	.28	30		27	31	29		26	30		27	27	
24" 22R-SW-2	Effluent	.375	52		54	51	51		37	40		36	37	
30" 22R-0-1	Crude <i>INSULATED</i>	.325	35		37	35		36						
16" 22R-SW-4	Ballast	.375	30		30	30	29		30	32		30	31	
6" 22R-ST-500	.80# Steam <i>INSULATED</i>	.28			35			35						
12" 22R-0-18	Bunker <i>INSULATED</i>	.33			37			36						
12" 22R-0-115	Flush Oil to Wharf	.375	40		40	37	40		39	36		38	39	
14" 22R-0-120	Lead Free	<del>.250</del> .312	25		29	25	24		29	25		27	24	
14" 22R-0-6	Regular Gas	.312	31		30	31	30		31	31		32	30	
14" 22R-0-4	Premium Gas	.312	32		32	32	31		32	31		30	30	
8" 22R-0-16	431 Burner <i>burns</i>	<del>.277</del> .277	35		33	36	36		34	35		28	29	
8" 22R-0-8	Avjet #2	.277	31		31	32	30		30	32		28	28	
8" 22R-0-10	Avjet #1	.277	32		32	32	32		32	32		27	28	
8" 22R-0-14	<del>431</del> Diesel 2	.277	32		32	33	31		31	30		27	28	
8" 22R-0-12	<del>431</del> Diesel 1	.277	32		34	32	31		34	35		27	28	
6" 22R-A-21	Plant Air	.28	30		27	30	29		26	29				



# WHARF PRODUCT LINE CALIPERINGS

PT. NO 4

ESTABLISHED NEW  
POINTS

LINE NO.	SERVICE	ORIG.	DATE 3/20/86			DATE 3/90			DATE 3/92			DATE 4/95					
			T	B	E	T	B	E	T	B	E	T	B	E			
6" 22R-0-DW-1	Fire and Drinking Water	.28	31	32	32	30	31	31	30	31	31						
24" 22R-SW-2	Effluent EIL (T.P.A.)	.375	36	36	36	36	35	36	34	35	34						
30" 22R-0-1	Crude	.325	38	39		34	35	38	33								
16" 22R-SW-4	Ballast	.375	32	32	33	32	31	32	32	31	31	32	34	33			
6" 22R-ST-500	80# Steam EIL Only <i>INSULATED</i>	.28			31			30									
12" 22R-0-18	Bunker EIL Only <i>INSULATED</i>	.33			41			40									
12" 22R-0-115	Flush Oil to Wharf	.375	27	37	37	37	36	36	37	36	37	36	36	36	38	NA	31
14" 22R-0-120	Lead Free	<del>.250</del> .312	26	26	26	26	25	25	24	24	25	25	25	25	27	NA	26
14" 22R-0-6	Regular Gas	.312	30	33	32	30	30	33	32	32	30	30	34	31	32	TP	30
14" 22R-0-4	Premium Gas	.312	30	32	33	29	30	31	32	30	30	30	TP	29	33	TP	33
14" 22R-0-16	431 Burner	.277	27	27	29	30	26	26	28	26	29	29	TP	28	30	TP	27
14" 22R-0-8	Avjet #2	.277	31	28	32	28	31	28	32	28	28	28	TP	26	27	TP	27
14" 22R-0-10	Avjet #1	.277	30	28	30	28	30	28	29	28	29	29	TP	29	27	TP	28
14" 22R-0-14	<del>45#</del> Diesel 2	.277	27	27	28	26	26	27	27	26	27	27	TP	26	27	TP	28
14" 22R-0-12	<del>45#</del> Diesel 1	.277	27	27	28	27	26	26	28	26	26	26	TP	26	28	TP	27
14" 22R-A-21	Plant Air	.28	31	30	28	31	30	28	28	30	28	28	TP	32	32	TP	32
14" 22R-0-121	Pumpout	.237	27	27	28	27	27	28	27	27	28	27					



# WHARF PRODUCT LINE CALIPERING

PT. NO 5.

ESTABLISHED  
NEW POINTS

LINE NO.	SERVICE	ORIG.	DATE 3/20/86			DATE 3/90			DATE 3/92			DATE 4/95		
			T	B	E	T	B	E	T	B	E	T	B	E
30" 22R-0-1	Crude	.328	41	42	42	40	41	41						
12" 22R-0-89	Flush Oil from Storage	.33	32	40	30	33	31	29	32			TP 33	38	33
6" 22R-OW-1	Fire and Drinking Water	.28	30	29	29	38	31	30	37					
6" 22R-ST-500	80# Stm Ell Only <i>insulated</i>	.28												
12" 22R-0-18	Bunker Ell Only <i>insulated</i>	.33												
14" 22R-0-120	Lead Free	.250 <del>.312</del>	26	27	27	26	27	27	26			TP 25	31	25
14" 22R-0-6	Reg Gas	.312	30	30	31	30	29	30	29			TP 31	33	32
14" 22R-0-4	Pre Gas	.312	30	30	31	31	31	30	31			TP 31	35	30
8" 22R-0-16	431 Burner	.277	30	28	28	29	28	28	29			TP 27	30	28
8" 22R-0-8	Avjet #2	.277	30	33	32	32	30	31	31			TP 31	33	30
8" 22R-0-10	Avjet #1	.277	29	30	31	31	29	29	30			TP 31	32	29
8" 22R-0-14	<del>431</del> Diesel 2	.277	29	29	30	32	29	29	31			TP 30	32	29
8" 22R-0-12	<del>431</del> Diesel 1	.277	28	29	31	31	28	28	30			TP 29	31	29
6" 22R-A-21	Plant Air	.28	31	31	32	32	31	31	30					
12" 22R-0-115	Flush Oil to Wharf (N-S-E-W)	.375	N	S	E	W	N	S	E	W	N	S	E	W
			37	38	37	40	36	36	39			Deplete		







Established

New Pts.

PT. N.E. / SOUTH OF BOAT LAUNCH

WHARF PRODUCT LINE CALIPERINGS

LINE NO.	SERVICE	ORIG.	DATE 3/20/86			DATE 3/90			DATE 3/92			DATE 3/95					
			T	B	E	T	B	E	T	B	E	T	B	E			
8" 22R-FW-3	Fire Water	.277	26			26						29	30	30	30	30	30
6" 22R-O-DW-1	Fire and Drinking Water	.28	31			30	31	30	30	30		36	35	36	36	36	36
24" 22R-SW-2	BALLAST Effluent Ell (E-W-N)	.375		40	47	40	45	47				38	38	38	38	38	38
30" 22R-O-1	Crude	.325		41	39	40	40	40				38	39	38	38	38	38
16" 22R-SW-4	Ballast	.375	31	31	31	31	31	31	31	31	SCANNED	31	31	31	31	31	31
6" 22R-ST-500	80# Steam	.28		32		31		31			By						
12" 22R-O-18	Bunker	.33	N6	40	LE												
12" 22R-O-115	Flush Oil to Wharf	.375	37	37	38	36	36	37	37	37		38	38	38	38	38	38
14" 22R-O-120	Lead Free	.250	25	25	25	25	25	25	25	25	ANVIL	25	25	25	25	25	25
14" 22R-O-6	Regular Gas	.312	29	30	30	29	29	29	29	30	See	37	38	NA	37	NA	37
14" 22R-O-4	Premium Gas	.312	29	32	30	29	31	30	30	30	See	31	33	NA	31	NA	32
8" 22R-O-16	431 Burner	.277	32	34	34	32	33	33	33	33	Manilla	29	28	29	29	29	29
8" 22R-O-8	Avjet #2	.277	31	32	32	30	31	31	31	31	Folder	29	29	29	29	29	30
8" 22R-O-10	Avjet #1	.277	31	32	32	31	32	32	32	32	THIS	28	27	28	28	28	28
8" 22R-O-14	<del>431</del> Diesel 2	.277	32	32	32	32	31	32	31	32	FILE	29	28	28	29	28	29
8" 22R-O-12	<del>431</del> Diesel 1	.277	32	32	32	31	32	32	32	32		29	27	31	29	30	30
6" 22R-A-21	Plant Air	.28	30	29	28	30	29	29	30	29							

16  
15  
14  
13 INS.  
12  
11 INS.  
10 INS.

WEST

## **Appendix B**

### **3.3.0**

#### **Bill of Materials 5129 / 5129A Installation of Video Cameras and Radio at Crude Booster Pump and A-Anchor**



TEXACO  
BILL OF MATERIAL  
PUGET SOUND PLANT

B.M. 5129

W.O. 9315352

SHEET 1 of 5

TITLE: RP&S - INSTALL VIDEO CAMERAS AND RADIO AT BOOST PUMP AND "A" ANCHOR AND RECEIVERS AND CONTROLS AT RP&S CONTROL ROOM.

CHARGE: PSP 305 MODIFICATION REVIEW CONDUCTED N

APPROVAL: JAC P&ID'S REVISED N/A REV 0

MASTER	PM	AMM	AMO	AMT	OPR	PWR	PRO	ER	EH&S	LAB	ENG	CA	GMF
DIST.		X	X	X	X	X					X	X	X
REVISIONS	0	0	0	0	0	0							
	SK	22	22	22	SK	SK							
	11	-	-	-	11	11							
B	D	-	EJ	EJ	EJ	-	-						
M	R	11	-	-	-	13	14						
	A	-	13	14	15	-	-						
C	W	93				93	93						
O	I												
P	N												
I	G												
E	S												
S													
21	TOTALS	18	18	18	18	18	18						
1	M&C	1	1	1	1	1	1						
1	STOREHOUSE												
3	PF/I&T	3	3	3	3	3	3						
4	PF/I&E	4	4	4	4	4	4						
1	I&E (WEO)	1	1	1	1	1	1						
	AF/NS												
	AF/SS												
	AF/OFF PLT												
	AF/SHOPS												
	F/MACH SHP												
	F/MT-BT												
	F/FCU-BoHo												
	F/POLY-ALK												
	F/CRU-HTU												
	F/CPD												
3	F/RP&S	3	3	3	3	3	3						
2	INSP DEPT	2	2	2	2	2	2						
1	ENG'R DEPT												
1	EQUIP FILE												
	"R" STAMP												
1	RAM												
1	JAC/PWR	1	1	1	1	1	1						
1	DEL/PWR	1	1	1	1	1	1						
1	RNW/PWR	1	1	1	1	1	1						

Jeffrey A. Curtis  
7/27/94

10/31/95

TEXACO  
PUGET SOUND PLANT  
BILL OF MATERIAL

BM 5129

WO 9315352

SHEET 2 OF 5

TITLE: RP&S, INSTALL VIDEO CAMERAS AND RADIO AT BOOST PUMP AND "A" ANCHOR AND RECEIVERS AND CONTROLS AT RP&S CONTROL ROOM.

CHARGE PSP305      MADE BY DEL      CHECKED BY      ISSUE DATE 11 - 16 - 93

PURPOSE: IT IS THE PURPOSE OF THIS BM TO PROVIDE A VIDEO SYSTEM TO MONITOR THE AREA AROUND THE DOCK LINE CRUDE BOOST PUMP AND THE AREA AROUND "A" ANCHOR. THE VIDEO FROM THESE AREAS WILL BE MONITORED BY THE OPERATOR THE RP&S CONTROL ROOM. INSTALLATION BUDGET IS ESTIMATED AT \$30,000. THE INSTALLATION OF THIS SYSTEM IS A COMPLIANCE ISSUE FOR THE STATE OF WASHINGTON. INSTALLATION MUST BE COMPLETED BY 12-17-93.

SCOPE: MOVEABLE CLOSED CIRCUIT VIDEO CAMERAS ARE MOUNTED ON TWO TOWERS, ONE 30' HIGH AT THE CRUDE BOOST PUMP NAMED VIDEO SYSTEM #1 AND ONE 40' HIGH AT THE TERA CAMPGROUND OVERLOOKING "A" ANCHOR NAMED VIDEO SYSTEM #2. POWER IS TO BE PROVIDED AT BOTH SITES UNDER BM 5129A.

- AT THE CAMERA TOWERS -

1. BUILD AND INSTALL CONTROL PANEL ON EACH CAMERA TOWER (ONE SOUTH OF BOOST PUMP AND ONE BY FENCE AT TERA) PER DWGS 22-EJ-13, 22-EJ-14, AND 22-EJ-15. INSTALL GROUNDING. NOTE: DO NOT REMOVE ANY METAL FROM TOWER STRUCTURE BY DRILLING OR ANY OTHER MEANS.
2. MAKE UP BACKING PLATES FOR THE REAR OF EACH CAMERA ENCLOSURE AND ATTACH. REF SK111393. INSTALL CAMERAS IN ENCLOSURES AND ENCLOSURES ON PAN/TILT MECHANISMS. CHECK CAMERAS, LENSES, PAN/TILT UNITS, AND ENCLOSURE HEATERS AND DE-FOGGERS IN THE SHOP FOR PROPER OPERATION. MOUNT ASSEMBLIES ON TOWERS. MOUNT VIDEO TRANSMITTERS AND REVERSE LINK RECEIVER ANTENNAE ON TOWERS. MOUNT THE RECEIVER ANTENNAE AS HIGH AS PRACTICAL LEAVING JUST ENOUGH OF THE FACTORY ATTACHED LEAD-IN TO REACH THE RECEIVER ON THE INSIDE OF THE ENCLOSURES.
3. INSTALL THE CONDUIT AND FITTINGS ON THE TOWERS PER 22-EJ-13 AND PULL THE FOLLOWING CONDUCTOR CABLES:
  - FROM THE CONTROL ENCLOSURE TO THE VIDEO TRANSMITTER (IN THE DC CONDUIT) PULL A 2-CONDUCTOR 18 AWG CABLE.
  - FROM THE CAMERA ENCLOSURE TO THE VIDEO TRANSMITTER PULL A COAX WITH BNC CONNECTORS ON EACH END.
  - FROM THE CONTROL ENCLOSURE TO THE CAMERA ENCLOSURE, PULL A 5-CONDUCTOR 18 AWG CABLE. (IN THE DC CONDUIT)
  - FROM THE CONTROL ENCLOSURE TO THE CAMERA ENCLOSURE, PULL A 3-CONDUCTOR 18 AWG CABLE. (IN THE AC CONDUIT)
  - FROM THE CONTROL ENCLOSURE TO THE BASE OF THE PAN/TILT MECHANISM, PULL A 6-CONDUCTOR 18 AWG CABLE. (IN THE AC CONDUIT) NOTE: THIS CABLE REQUIRES INSTALLATION OF THE SUPPLIED PLUG ON THE TOP END.



TITLE: INSTALL VIDEO CAMERAS AND RADIOS AT BOOST PUMP AND "A" ANCHOR AND  
RECEIVERS AND CONTROLS AT RP&S CONTROL ROOM.

CHARGE PSP 305      MADE BY DEL      CHECKED BY      ISSUE DATE      -      -      93

4. MAKE ALL TERMINATIONS PER 22-EJ-15 AND APPLICABLE INSTALLATION  
MANUALS. CHECK FOR CONTINUITIES AND FAULTS BEFORE APPLYING POWER.

- BLENDING PLANT CONTROL ROOM -

5. FABRICATE ANTENNA MAST PER SK-111193. INSTALL THE SUPPORT BRACKET ON THE WEST WALL OF THE BLENDING PLANT CONTROL ROOM, RELOCATING AS NECESSARY TO AVOID THE REBAR IN THE CINDERBLOCK WALL. BOLT THROUGH THE BLOCK WALL THROUGH THE BACKING PLATE TO ATTACH THE SUPPORT, USING SHIM AS NECESSARY TO ENSURE PLUMB.

6. LOCATE, EXCAVATE, AND FORM THE MAST FOOTING DIRECTLY BELOW THE MAST SUPPORT BRACKET.

7. INSTALL THE MAST AND CLAMP IN PLACE AT THE PROPER ELEVATION. NOTE: THE MAST MUST BE INSTALLED BY LIFTING OVER THE 2" VENT PIPE SHOWN ON SK-11-11-93 AND LOWERED BETWEEN IT AND THE BUILDING. POUR THE FOOTING WITH THE ANCHOR BOLTS INSTALLED IN THE BASEPLATE OF THE MAST. STRIP FORMS WHEN CONCRETE IS CURED AND BACKFILL TO MATCH AREA.

8. BUILD AND INSTALL CONTROL ENCLOSURE PER DWGS 22-EJ-13, 22-EJ-14, 22-EJ-15, AND SK-11-14-93. INSTALL ANTENNAE ON MAST PER THE SAME DWGS PLACING THE REVERSE LINK TRANSMITTER ANTENNA AT THE TOP OF THE MAST AND KEEPING THE TWO VIDEO RECEIVER YAGI ANTENNAE AT LEAST 5' BELOW.

9. MOUNT VICON COLOR MONITOR IN THE UPPER TIER OF THE BLENDER'S HONEYWELL OP STATION USING THE HONEYWELL BEZEL KIT PROVIDED.

10. CONNECT VIDEO CABLES, POWER, AND CONTROL WIRING TO MONITOR AND CONTROLLER.

8. POWER UP ENTIRE SYSTEM AND CHECK FOR PROPER OPERATION.

TEXACO  
 PUGET SOUND PLANT  
 BILL of MATERIALS

ITEM	QUAN	DESCRIPTION	FURNISHED BY
1	2	CAMERA ENCLOSURE, PELCO EH4500	PO 01670
2	2	PAN/TILT UNIT, PELCO PT1250P	PO 01670
3	2	TRANSMITTER, VIDEO, WIRELESS FSTX-900B	PO 01670
4	2	ANTENNA, REVERSE LINK RECEIVER, WIRELESS	PO 01670
5	2	FITTING, 3/4" TEE, FORM 7, C-H #T27	I&E
6	1	ENCLOSURE, NEMA 12, HOFFMAN A363608LP	R 347045
7	2	ENCLOSURE, NEMA 4X, HOFFMAN A24H2008SSLP	R 347045
8	5	FITTING, UNIV BREATHER/DRAIN, C-H #ECD15	I&E
9	3	FITTING, 1" X 1/2" REDUCER, C-H #RE31	I&E
10	A/R	CHANNEL, 1 5/8" X 1 5/8", B-LINE #B-22SH	I&E
11	22	U-BOLT, 1/4-20, GALVANIZED	I&E
12	A/R	CONDUIT, 1-1/2 RIGID, GALVANIZED	I&E
13	4	FITTING, 1-1/2" HUB, MYERS #ST-5	I&E
14	3	FITTING, 1" GROUND HUB, MYERS #STG-3	I&E
15	2	FITTING, 1-1/2" X 1/2" REDUCER, C-H #RE51	I&E
16	A/R	CONDUIT, 3/4" LIQUITITE, TYPE UA	I&E
17	6	FITTING, 3/4" ELL, FORM 7, C-H #LB27	I&E
18	9	CLAMP, CONDUIT, 1" B-LINE #B2010	I&E
19	9	CLAMP, CONDUIT, 1-1/2" B-LINE #B2012	I&E
20	A/R	CONDUIT, 1" RIGID, GALVANIZED	I&E
21	11	FITTING, 1-1/2" TEE, C-H #TB57	I&E
22	2	FITTING, 3/4" CORD, BUSHING A/R, C-H #CGB	I&E
23	2	FITTING, 1" CORD, BUSHING A/R, C-H #CGB	I&E
24	2	FITTING, 1-1/2" CORD, BUSHING A/R, C-H #CGB	I&E
25	8	FITTING, OUTLET BODY, 3/4" C-H #GUAW26	I&E
26	4	FITTING, 1/2" CORD, BUSHING A/R, C-H #CGB	I&E
27	1	SERVICE ENTRANCE, 1", C-H #F385	I&E
28	2	FITTING, 3/4" X 2" NIPPLE, RIGID, GALVANIZED	I&E
29	9	FITTING, 1" ELL, C-H #LB37	I&E
30	4	FITTING, 1/2" GROUND HUB, MEYERS #STG-1	I&E
31	2	FITTING, 3/4" HUB, MYERS #ST-2	I&E
32	1	VIDEO SYSTEM INTERFACE, WIRELESS RL-450-SI	PO 01670
33	2	VIDEO RECEIVER, WIRELESS FSRX900B	PO 01670
34	1	REVERSE LINK TRANSMITTER, WIRELESS RL-450-TX	PO 01670
35	1	QUAD PROCESSOR, WIRELESS QP-256	PO 01670
36	1	BACK PANEL, HOFFMAN A36P36	R 347045
37	1	AC ADAPTER, 120VAC/24VAC, CALRAD 45774	PO 01670



ITEM	QUAN	DESCRIPTION	FURNISHED BY
38	3	OUTLET, DUPLEX W/GFCI, LEVITON 6598-HG1	I&E
39	3	POWER SUPPLY, 120VAC/12VDC, CALRAD	I&E
40	A/R	WIREDUCT, 2" X 2", TYPE E, PANDUIT E2X2LG6	I&E
41	A/R	COVER, 2", TYPE C, PANDUIT C2LG6	I&E
42	3	OUTLET STRIP, RT ANGLE, 15A, 120VAC, WABER UL24RA-6	I&E
43	1	FITTING, 1" GROUND HUB, MYERS #STG3	I&E
44	3	GROUND CONNECTOR, BURNDY #K2C15	I&E
45	7	FITTING, 3/4" GROUND HUB, #STG2	I&E
46	3	TERMINAL MARK SYST, WEIDMLR. 2924.6, 2937.9, 2940.0	I&E
47	8	TERM END BRACKT, WEIDMULLER 2061.6	I&E
48	A/R	TERM ASSY RAIL, WEIDMULLER TS32, 1228	I&E
49	4	TERM, DEKAFIX TAG, VERT 1-50, WEIDMULLER 4687.6	I&E
50	44	TERMINAL BLOCK, WEIDMULLER SAK 1100.2	I&E
51	4	TERMINAL END SECTION, WEIDMULLER AP/SAK10 1179.6	I&E
52	8	TERM., GROUNDING FOR SAK10, WEID. EK10 3546.6	I&E
53	A/R	WIREDUCT, 1-1/2" X 1-1/2", TYPE E, PAND. E1.5X1.5LG6	I&E
54	A/R	COVER, 1-1/2" TYPE C, PANDUIT C1.5LG6	I&E
55	A/R	DIN RAIL, RELAY MOUNT, P&B 24A110	I&E
56	8	SOCKET, RELAY, P&B 27E893	I&E
57	8	RELAY, DPDT, 24VAC COIL, P&B KUP11A15 24VAC	I&E
58	2	DRIVER/RECEIVER UNIT, WIRELESS RL-450-DX	PO 01670
59	2	BACK PANEL, HOFFMAN A24P20	R 347045
60	A/R	WIRE, 10AWG, STRANDED COPPER, GREEN, THWN	I&E
61	4	FITTING, 1/2" GROUND HUB, MYERS STG3	I&E
62	4	FITTING, 1/2" CGB	I&E
63	1	CUSTOM HONEYWELL BEZEL FOR VIDEO MONITOR	RA34681401
64	3	NAMEPLATES, PER SK-11-14-93	I&E
65	2	FITTING, 1" TEE, C-H TB37	I&E
66	1	FITTING, 1" SEAL, C-H EYS31	I&E

50-1301-T

TEXACO  
 PUGET SOUND PLANT  
 BILL OF MATERIAL

B/M# 5129A

W.O.# 9314308

SHT. 1 OF 5

TITLE: WHARF - INSTALL VIDEO CAMERAS AND RADIOS AT BOOST PUMP AND "A"  
 ANCHOR AND RECEIVERS AND CONTROLS AT RP&S CONTROL ROOM. (ELECTRICAL)

CHARGE: PSP-305 MODIFICATION REVIEW CONDUCTED

APPROVAL: *W Tezak* P&ID'S REVISED N/A REV 0

MASTER DIST.	PM	AMM	AMO	AMT	OPR	PWR	PRO	ER	AWC	LAB	ENG	CA	GMF
		X	X	X	X	X					X	X	X

	REVISIONS	0	6	7	7	0	10	1	4	1	0	0	2	1	0	0	1	0	0
B M C O P I E S	D R A W I N G S	SK 10 - 14 - 93	30 - AP - 1	22 - BP - 19	22 - AP - 30	29 - EP - 1	40 - AS - 1	SK 08 - 11	40 AA - 3	41 BP - 1	41 BP - 1	22 - BP - 25	22 DP - 44	22 03 - 25	50 EP - 26	50 EP - 38	22 BP - 46	30 C - C	41 C - C
13	TOTALS	9	8	8	8	8	8	8	8	8	8	8	8	8	8	8	8	8	8
1	M&C	1																	
1	STOREHOUSE																		
	PF/I&T																		
4	PF/I&E	4	4	4	4	4	4	4	4	4	4	4	4	4	4	4	4	4	4
1	I&E (WEO)	1	1	1	1	1	1	1	1	1	1	1	1	1	1	1	1	1	1
	AF/NS																		
	AF/SS																		
	AF/OFF PLT																		
	AF/SHOPS																		
	F/MACH SHP																		
	F/MT-BT																		
	F/FCU-BoHo																		
	F/POLY-ALK																		
	F/CRU-HTU																		
	F/CPD																		
2	F/RP&S	2	2	2	2	2	2	2	2	2	2	2	2	2	2	2	2	2	2
	INSP DEPT																		
1	ENG'R DEPT																		
	EQUIP FILE																		
	"R" STAMP																		
1	JMB	1	1	1	1	1	1	1	1	1	1	1	1	1	1	1	1	1	1
1	RAP/I&E																		
1	RAM																		

*Jeffrey A. Curtis*  
 7/21/94

10/31/95



TEXACO  
PUGET SOUND PLANT  
BILL OF MATERIAL

B/M# 5129A

W.O.# 9314308

SHT. 2 OF 5

TITLE: INSTALL VIDEO CAMERAS AND RADIOS AT THE BOOSTER PUMPS AND AT "A"  
ANCHOR AND RECEIVERS AND CONTROLS AT RP&S (ELECTRICAL)

CHARGE PSP-305 MADE BY JMB CHECKED BY WY ISSUE DATE 11 -10 -93

**PURPOSE:** TO PROVIDE 120VAC POWER TO NEW CAMERAS AND RADIOS LOCATED AT CRUDE BOOSTER PUMPS AND AT "A" ANCHOR. THE OVERVIEW OF THE ELECTRICAL INSTALLATION IS AS SHOWN ON SCOPE SKETCH #SK10-14-93 AND ON DRAWING #40-AA-3.

**ESTIMATED COMPLETION DATE:** BEFORE DECEMBER 31, 1993.

**SCOPE:** CONTRACTOR AND/OR PLANT FORCES SHALL PERFORM THE FOLLOWING WORK AS LABOR/MATERIALS BECOMES AVAILABLE. THE CONSTRUCTION CREW SHALL NOTIFY MATT BROWN, AT EXT. #534 WHEN WORK IS TO BEGIN. SHOULD QUESTIONS ARISE DURING INSTALLATION, CONTACT POWER DEPARTMENT: MATT BROWN AT EXT. #534, OR BILL TEZAK AT EXT. #537.

**CAUTION:** TAKE ALL NECESSARY SAFETY PRECAUTIONS WHEN PERFORMING WORK IN VICINITY OF ENERGIZED LINES, AND/OR EQUIPMENT. THIS WORK WILL REQUIRE APPROACHING ENERGIZED LINES, EQUIPMENT & DEVICES WITH VOLTAGES OF UP TO 240V LINE-TO-LINE AND UP TO 120V LINE-TO-GROUND.

**NOTE TO PLANNER:**  
COORDINATE THIS BM WITH BM'S #4980 AND 5129.

**POWER SUPPLY TO CAMERA TOWER AT CRUDE BOOSTER PUMPS**

1. LOCATE EXISTING SWITCH RACK #SWRK. 22B AT THE EAST SIDE OF POLE #20, SEE DRAWING 30-AP-1. ROUTE (1) 1" RGS CONDUIT #30-SP-369 WITH CONDUITS 30-P-366 & 30-P-367 (TO BE INSTALLED PER B.M. #4980) BELOW GRADE FROM SOUTH SIDE OF SWRK. 22B PAD TO EAST SIDE OF CRUDE BOOSTER PUMP AREA. CONTINUE CONDUIT #30-P-366 UNDERGROUND TO THE CAMERA TOWER FOUNDATION, AS SHOWN ON DRAWINGS 22-DP-44, 22-AP-30, 22-BP-25, 30-AP-1 & 50-EP-26.
2. POUR RED CONCRETE AND BACKFILL DUCT BANK EXCAVATION PER TEXACO GEMS #A-1P9. AT THE BACK SIDE OF SWRK. 22B, BACK-FILL WITH CRUSH ROCK TO BE LEVEL WITH SWRK 22B FOUNDATION.
3. MOUNT 120/240V, 15AT, 70AF, NEMA 3R ENCLOSURE, ENCLOSED CIRCUIT BREAKER ON THE SOUTH SIDE OF SWRK. 22B (FIELD SHALL SUPPORT ENCLOSURE AS REQUIRED), SEE DRAWING 22-DP-44.
4. INSTALL 3/4" CONDUIT HUB ON EXISTING 240V, 50A, 2-POLE, SAFETY SWITCH FOR PANEL #LP-22J AND ROUTE 3/4" CONDUIT TO THE NEW ENCLOSED CIRCUIT BREAKER MOUNTED ON THE SOUTH SIDE OF SWRK. 22B, SEE DRAWING 22-DP-44.
5. INSTALL 1" CONDUIT HUB ON NEW ENCLOSED CIRCUIT BREAKER MOUNTED ON THE SOUTH SIDE OF SWRK. 22B AND ROUTE 1" RGS CONDUIT TO 1" SEALING FITTING ON CONDUIT #30-P-366, SEE DRAWING 22-DP-44.

TEXACO  
PUGET SOUND PLANT  
BILL OF MATERIAL

B/M# 5129A

W.O.# 9314308

SHT. 3 OF 5

TITLE: INSTALL VIDEO CAMERAS AND RADIOS AT THE BOOSTER PUMPS AND AT "A"  
ANCHOR AND RECEIVERS AND CONTROLS AT RP&S (ELECTRICAL)

6. BOND EXISTING #4 STRANDED BARE GROUNDING CONDUCTOR AT SWRK 22B TO CONDUIT #30-P-366 WITH GROUNDING CONNECTOR.
7. AT CAMERA TOWER FOUNDATION INSTALL WEATHERPROOF OUTLET BOX WITH 15A TWIST-LOCK RECEPTACLE AND COVER NEXT TO VIDEO CAMERA JUNCTION BOX INSTALLED BY B.M. #5129, COMPLETE INSTALLATION OF CONDUIT #30-P-366 WITH 1" SEALING FITTING TO THIS BOX, AS SHOWN ON DRAWING #22-BP-25.
8. INSTALL A 1" COUPLING AND PLUG ON CONDUIT #30-P-369 WHERE IT TRANSITIONS ABOVE GRADE AT EACH END.
9. PULL IN AND TERMINATE CONDUCTORS PER DRAWING 22-BP-19, 22-DP-47 AND PLANT 30 CONDUIT AND CONDUCTOR SCHEDULE. COMPLETE TESTING AS PER ITEM #18.
10. INSTALL NAMEPLATE ON THE CIRCUIT BREAKER ENCLOSURE PER DRAWING #22-BP-46.

POWER SUPPLY TO CAMERA TOWER AT "A" ANCHOR

11. LOCATE EXISTING PANEL #41PP-CJ AT THE NORTH SIDE OF TERA AREA SEE DRAWING 40-AA-3. ROUTE (1) 1" RGS CONDUIT #41-P-29 ABOVE GROUND FROM PANEL #41PP-CJ TO FENCE POST EAST SIDE OF CAMERA TOWER FOUNDATION, USING THE FENCE TO SUPPORT THE 1" CONDUIT #41-P-29. INSTALL A PULLING FITTING AND MAKE A TRANSITION TO UNDERGROUND FROM THE FENCE TO CAMERA TOWER FOUNDATION. INSTALL WEATHERPROOF OUTLET BOX WITH 15A TWIST-LOCK RECEPTACLE AND COVER NEXT TO VIDEO CAMERA JUNCTION BOX INSTALLED BY B.M. #5129 AND COMPLETE CONDUIT #41-P-29 INSTALLATION TO RECEPTACLE JUNCTION BOX. SEE STUB-UP DETAIL ON DRAWING #22-BP-25.
12. POUR RED CONCRETE AND BACKFILL DUCT BANK EXCAVATION PER TEXACO GEMS #A-1P9.
13. INSTALL 15AT, 70AF, 1-POLE, CIRCUIT BREAKER IN PANEL #41PP-CJ. SEE PANEL SCHEDULE ON DRAWING #41-BP-109.
14. BOND EXISTING #4 STRANDED BARE GROUNDING CONDUCTOR AT PANEL #41PP-CJ AREA TO CONDUIT #41-P-29 WITH GROUNDING CONNECTOR.
15. PULL IN AND TERMINATE CONDUCTORS PER DRAWING 40-AA-3, AND PLANT 41 CONDUIT AND CONDUCTOR SCHEDULE. COMPLETE TESTING AS PER ITEM 18.
16. INSTALL NAMEPLATES ON THE PANEL #41PP-CH & J ENCLOSURES PER DRAWING #41-BP-120.
17. CORRECT POOR EXISTING SUPPORT STRUCTURE AT PANEL #41PP-CJ BY MODIFYING SUPPORTS ON THE LEVEL INDICATING LIGHTS, AS SHOWN ON SKETCH #SK03-25-93.



TEXACO  
PUGET SOUND PLANT  
BILL OF MATERIAL

B/M# 5129A

W.O.# 9314308

SHT. 4 OF 5

TITLE: INSTALL VIDEO CAMERAS AND RADIOS AT THE BOOSTER PUMPS AND AT "A"  
ANCHOR AND RECEIVERS AND CONTROLS AT RP&S (ELECTRICAL)

GENERAL

18. PRIOR TO TERMINATION, ALL 600V INSULATED CONDUCTORS, SHALL BE MEGGER TESTED PER TEXACO GEMS #L-1P9, PARAGRAPH #14.3. ALSO AS PER ELECTRICAL ACTIVITY GUIDE #EAG-004 AND RECORDED ON TEST REPORT FORM #ETR-011.

19. UPON COMPLETION OF ALL REQUIRED WORK ON THIS PROJECT, ALL WORK WILL BE INSPECTED AND TESTED WITH FIELD AS-BUILT DRAWINGS TO BE RETURNED TO THE POWER DEPARTMENT - ELECTRICAL GROUP.

50-1304-T

TEXACO  
 PUGET SOUND PLANT  
 BILL OF MATERIAL


B/M# 5129A

W.O.# 9314308

SHT. 5 OF 5


ITEM	QUANTITY	DESCRIPTION	FURNISHED BY
	1650LF	WIRE, #12AWG, TYPE THWN, 600V, COLOR BLACK	I & E
	400LF	WIRE, #12AWG, TYPE THWN, 600V, COLOR GREEN	I & E
	340LF	CONDUIT, 1", RGS	I & E
	10 LF	CONDUIT, 3/4", RGS	I & E
	2 EA	CIRCUIT BREAKER, 15AT, 70AF, 1-POLE, 120V, PLUG-ON, SQUARE D #QO115	I & E
	1 EA	PANELBOARD, 40A LUGS, 2 CKT., 120/240V, 2-POLE, NEMA 3R ENCLOSURE, SQUARE D #QO2L40RB AND #PK3GTA-1 EQUIPMENT GROUND BAR KIT	RA34647701B
	2 EA	GROUND CONNECTOR, 1", UL LISTED FOR GROUNDING, BURNDY #GAR154C	I & E
	2 EA	SEALING FITTING, 1", W/DRAIN, C-H #EYD3	I & E
	2 EA	HUB, 3/4", MYERS #ST-2	I & E
	4 EA	HUB, 1", MYERS #ST-3	I & E
	2 EA	BOX, WEATHERPROOF BELL BOX, ONE GANG, MOUNTING TABS, 1" CONDUIT OPENING IN BOTTOM, BELL #891-L	I & E
	2 EA	RECEPTACLE, 3-WIRE, GOUNDING, 15A, NEMA L5-15R HUBBLE #4700	I & E
	2 EA	COVER, WEATHERPROOF, DEEP COVER, ONE GANG, LOCKING VERTICAL MOUNT, TAYMAC #10550	I & E



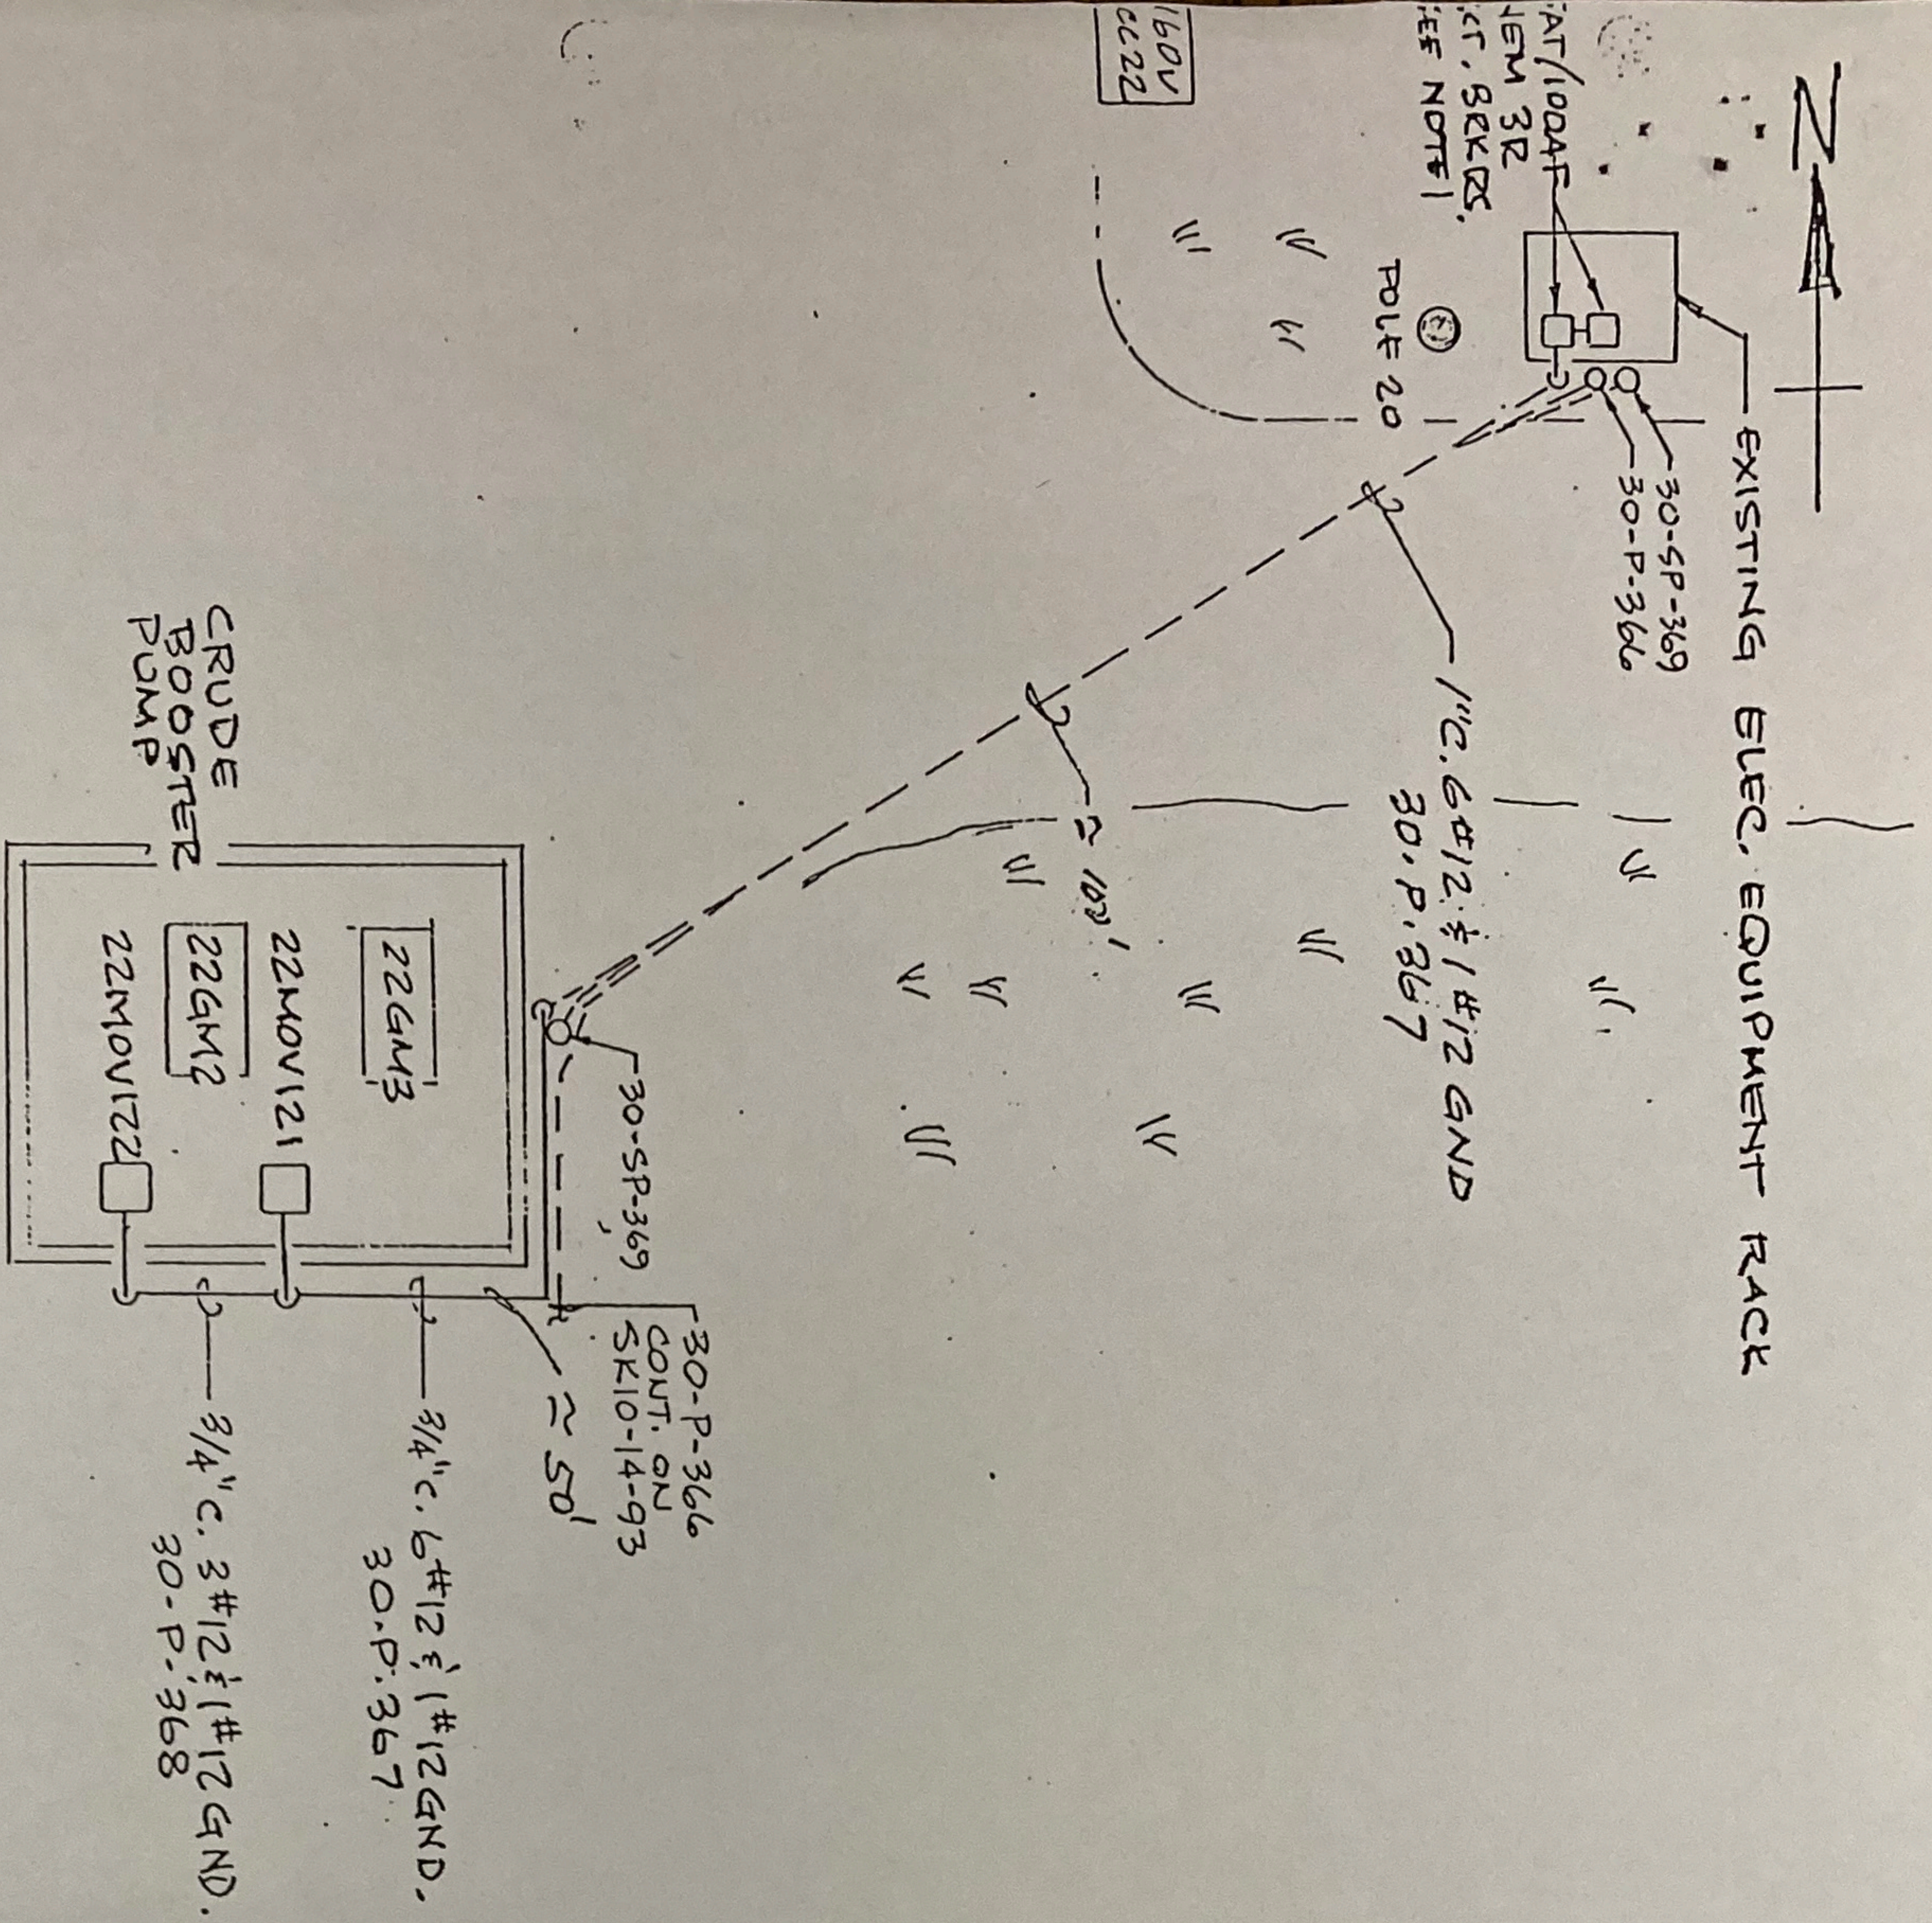

160V  
CC22

EXPIRES 10/31/95

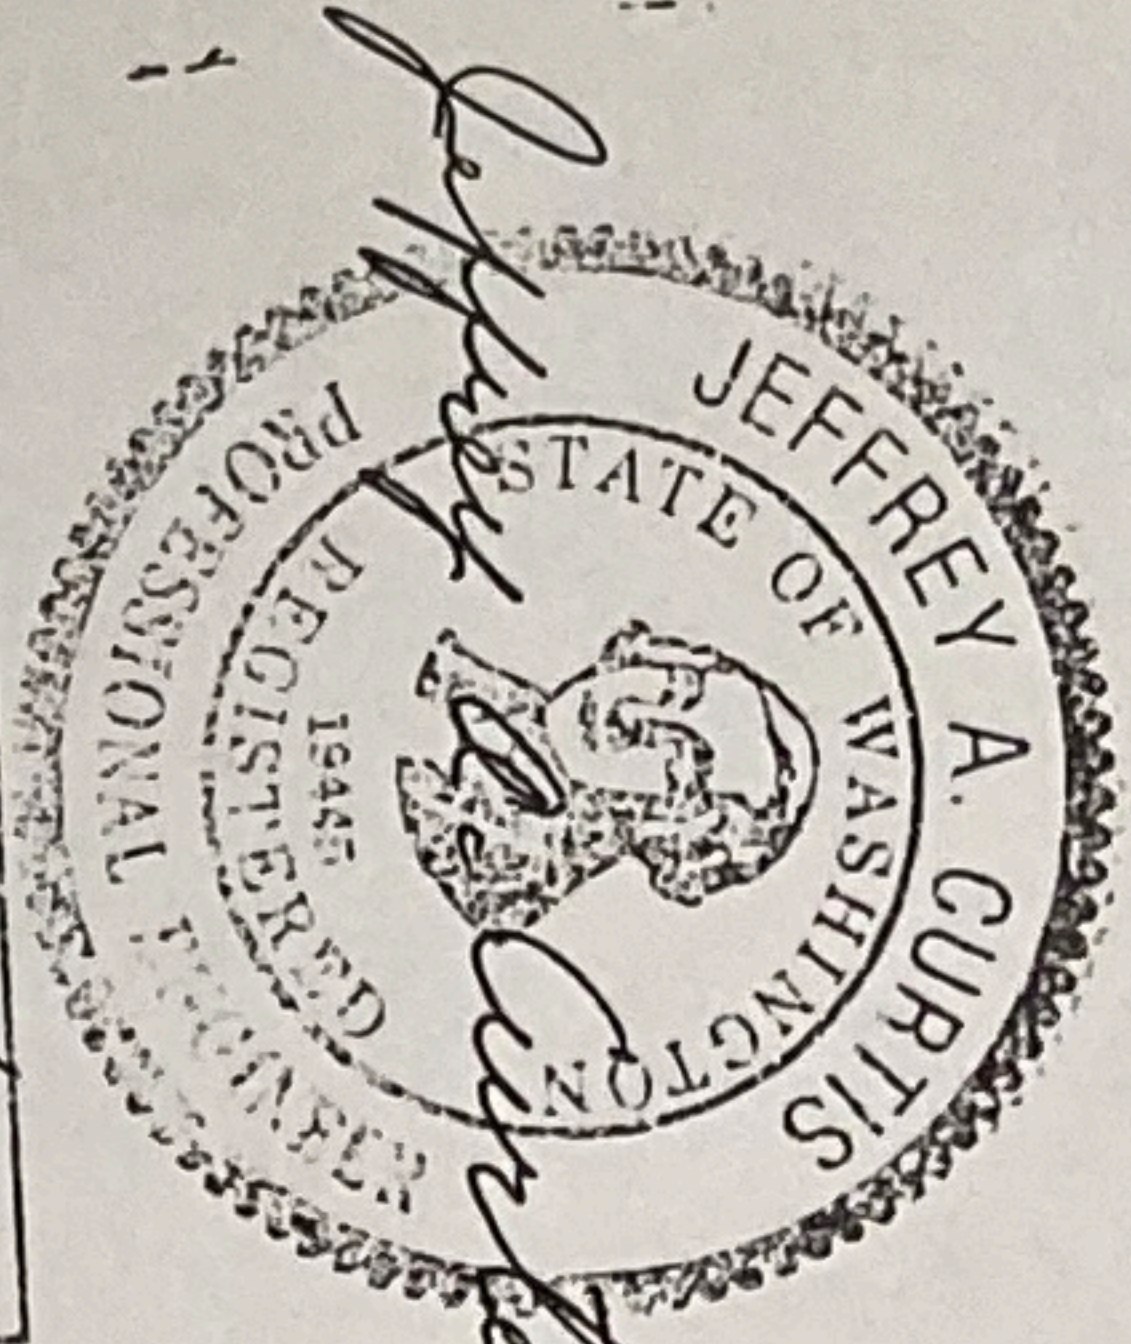

*Jeffrey A. Curtis*  
7/27/94


NOTES:

1. FEEDERS FOR MOV'S SHALL BE TAPPED IN EXISTING 480V 3Ø, 3 WIRE BUS BOX.


ELECTRICAL INSTALLATION  
RPP'S INSTALL MOV'S  
@ CRUDE BOOSTER PUMP  
W.D. 9312387 R.M. 4980  
SCOPE SKETCH

M.G. CHRISTY  
SK081193 Rev. 1



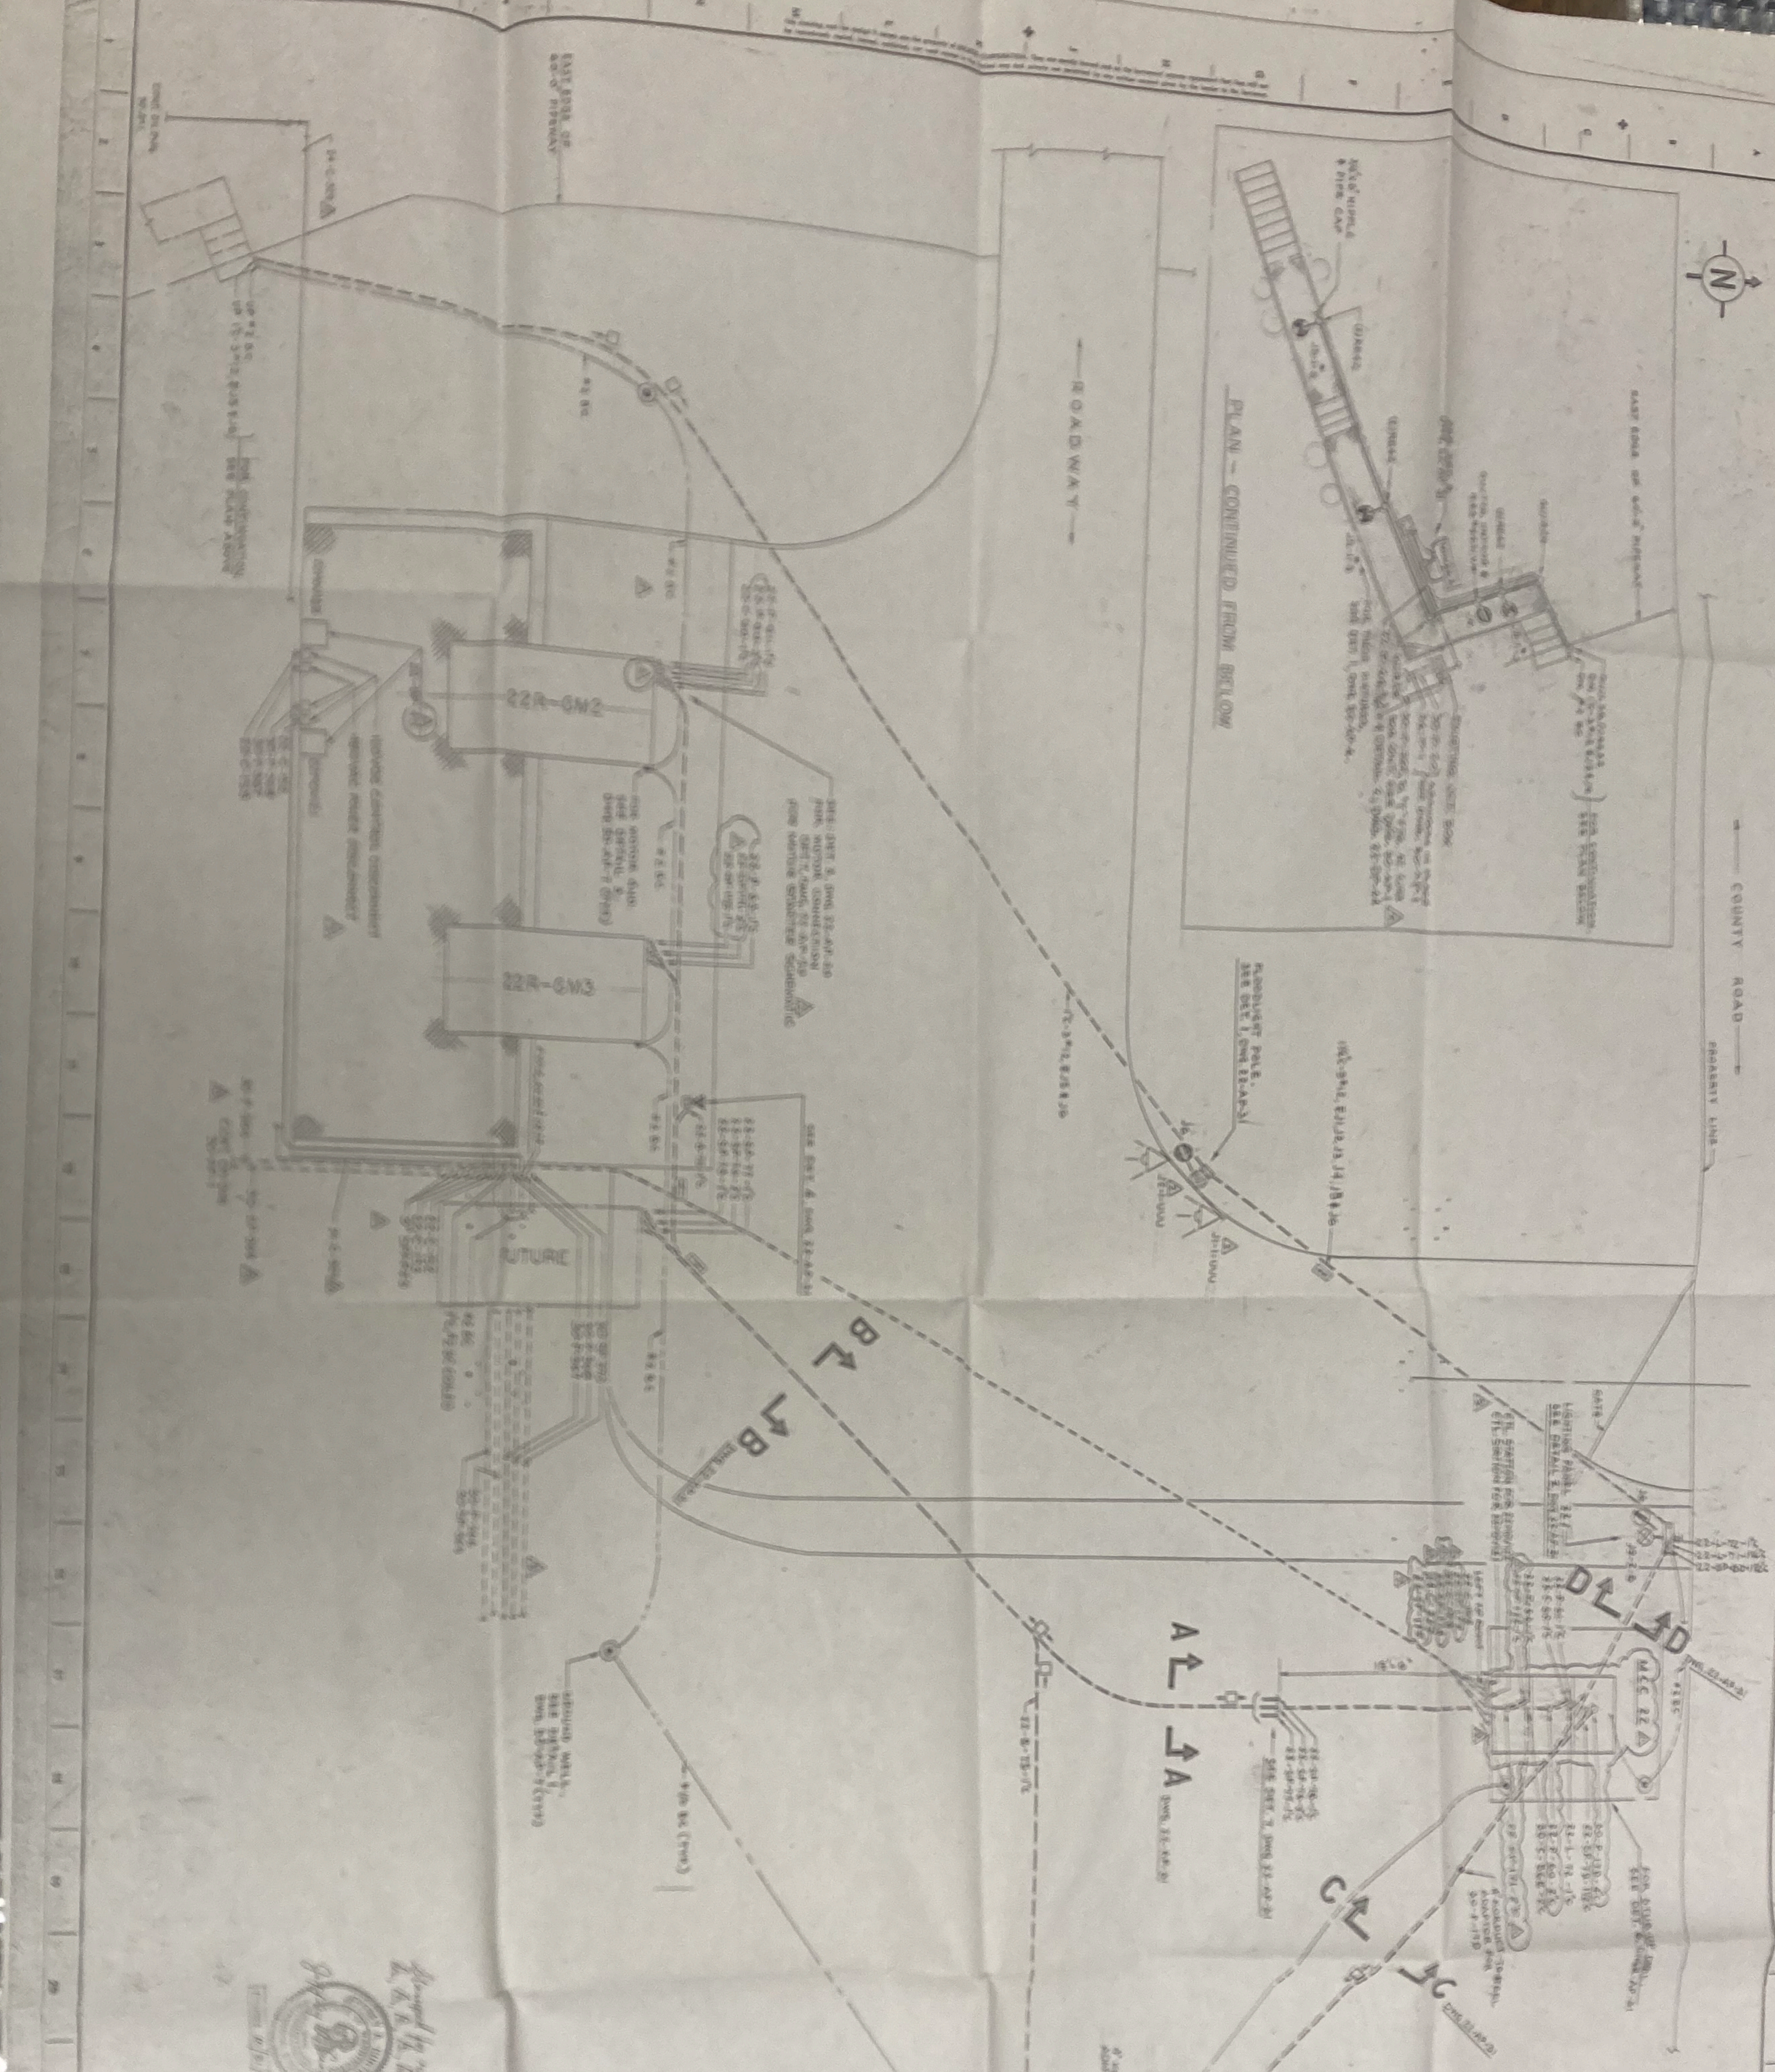


- NOTES**
- FOR ELECT. SYMBOLS & GENERAL NOTES, SEE TMS 20-AP-2.
  - FOR MISC. 2X WIRING DIAGRAM, SEE TMS 22-AP-21.
  - LIGHTING FIXTURES: VAPORPROOF NOT INDICATED.
  - FIRE-RATE TYPE: SEE TMS 20-AP-9.
  - WIRING AND DETAIL: SEE TMS 20-AP-21.
  - FRANKLIN & CURRY'S INSTALLATION.
  - FOR LIGHTING PANEL, CIRCUIT SCHEDULE, SEE DET. 2.
  - SEE TMS 22-AP-31.

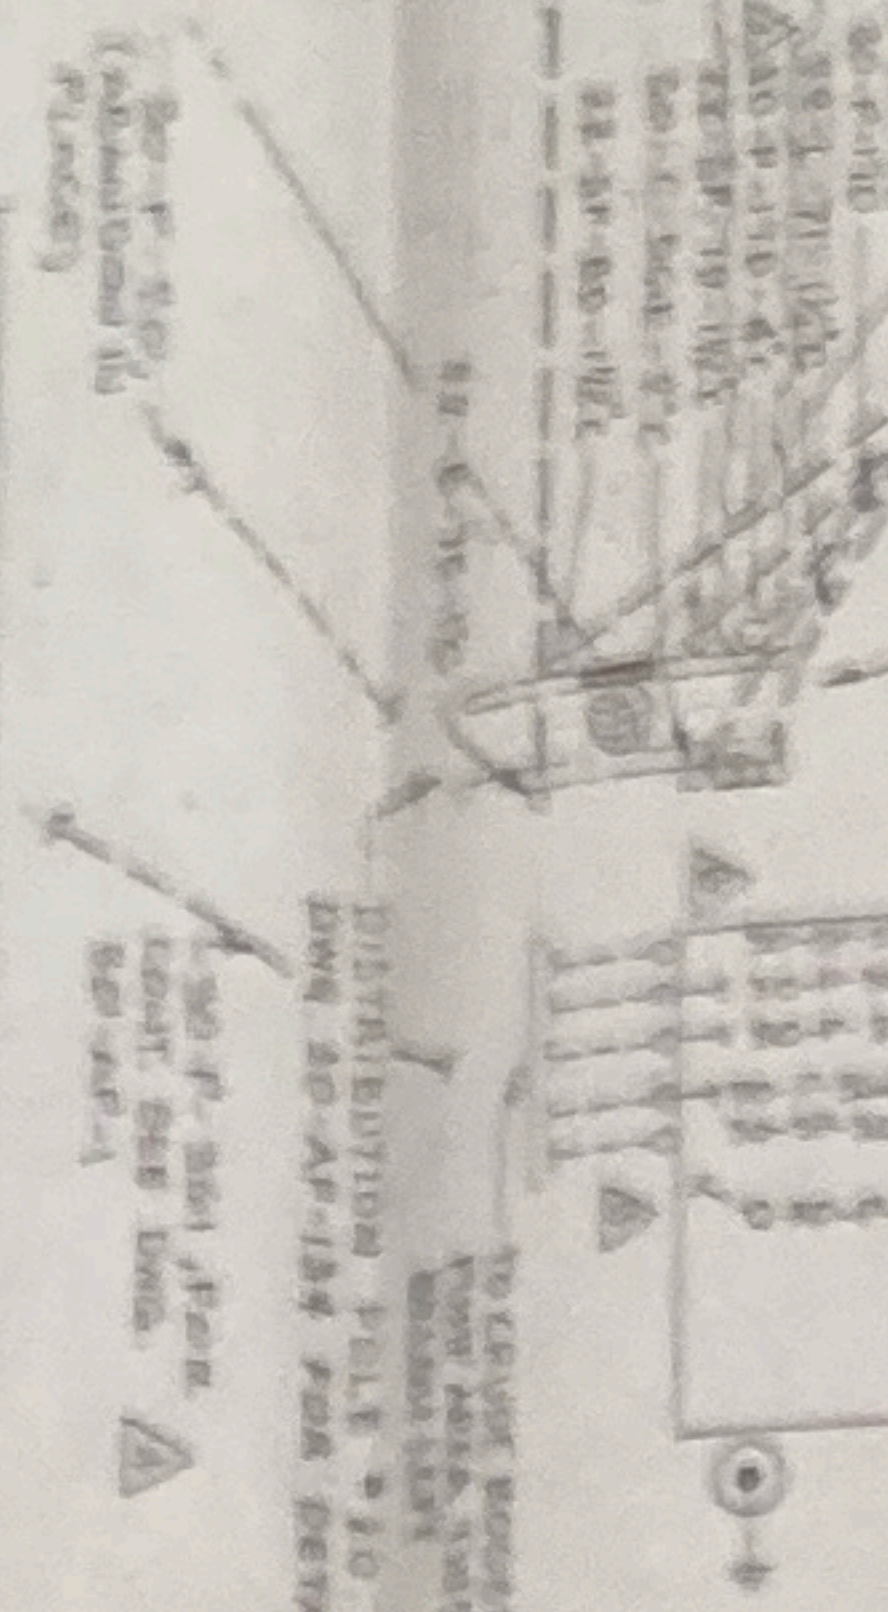




**REFERENCE DRAWINGS**

NO.	DESCRIPTION	DATE
 

**THE TEXAS COMPANY**  
 PROJECT ENGINEER  
**BRICHTL CORPORATION**  
 PROJECT ENGINEER  
**25225 22-AP-30**  
 ELEC. LAYOUT & GROUNDING PLAN  
 CRUDE BOOSTER PUMP STATION



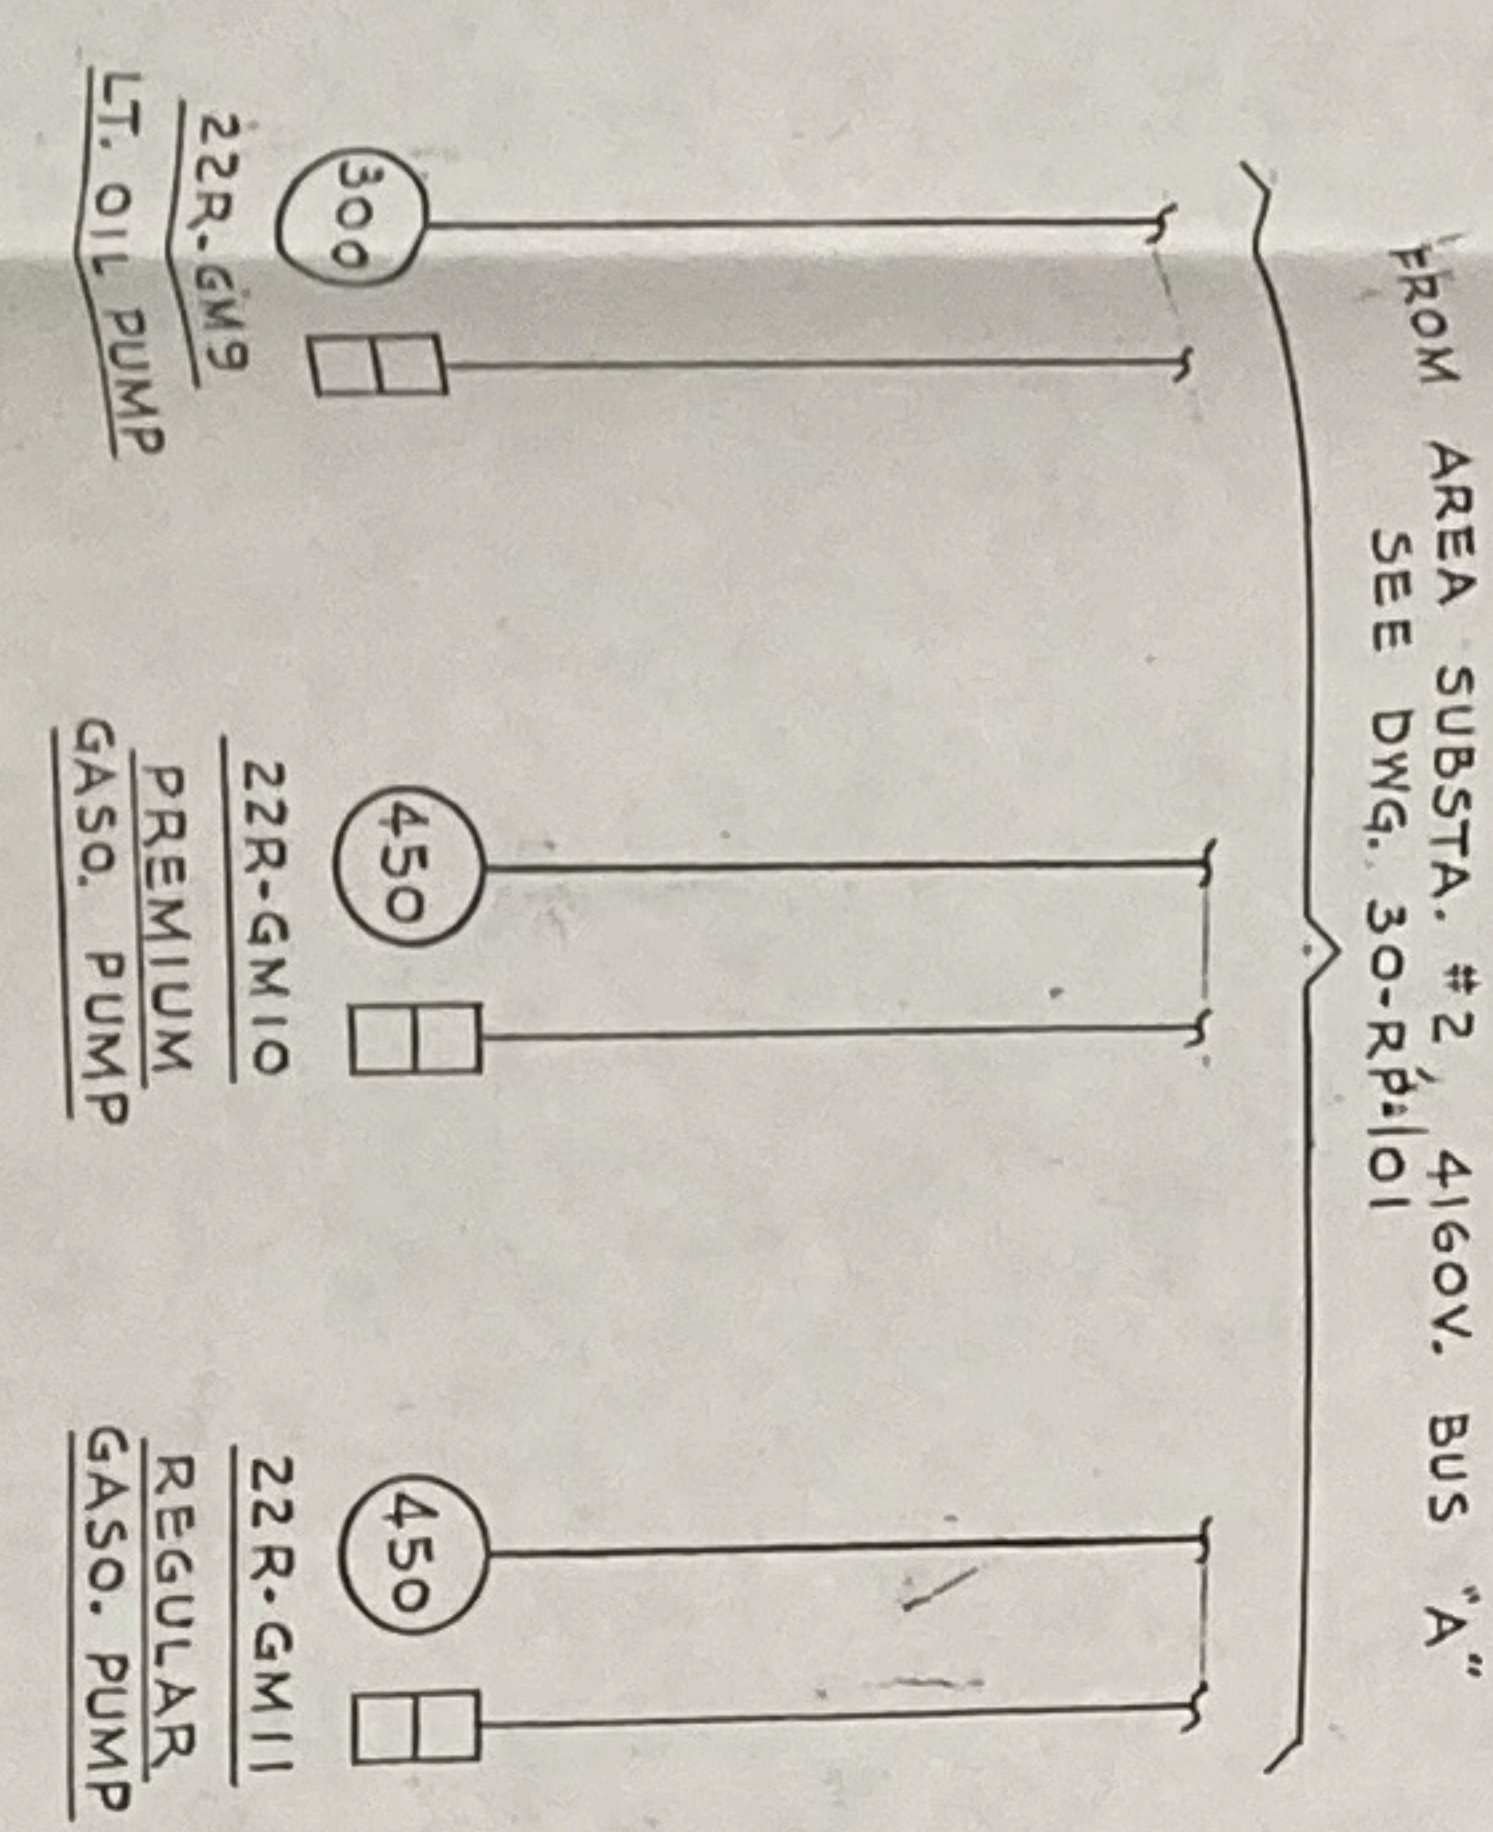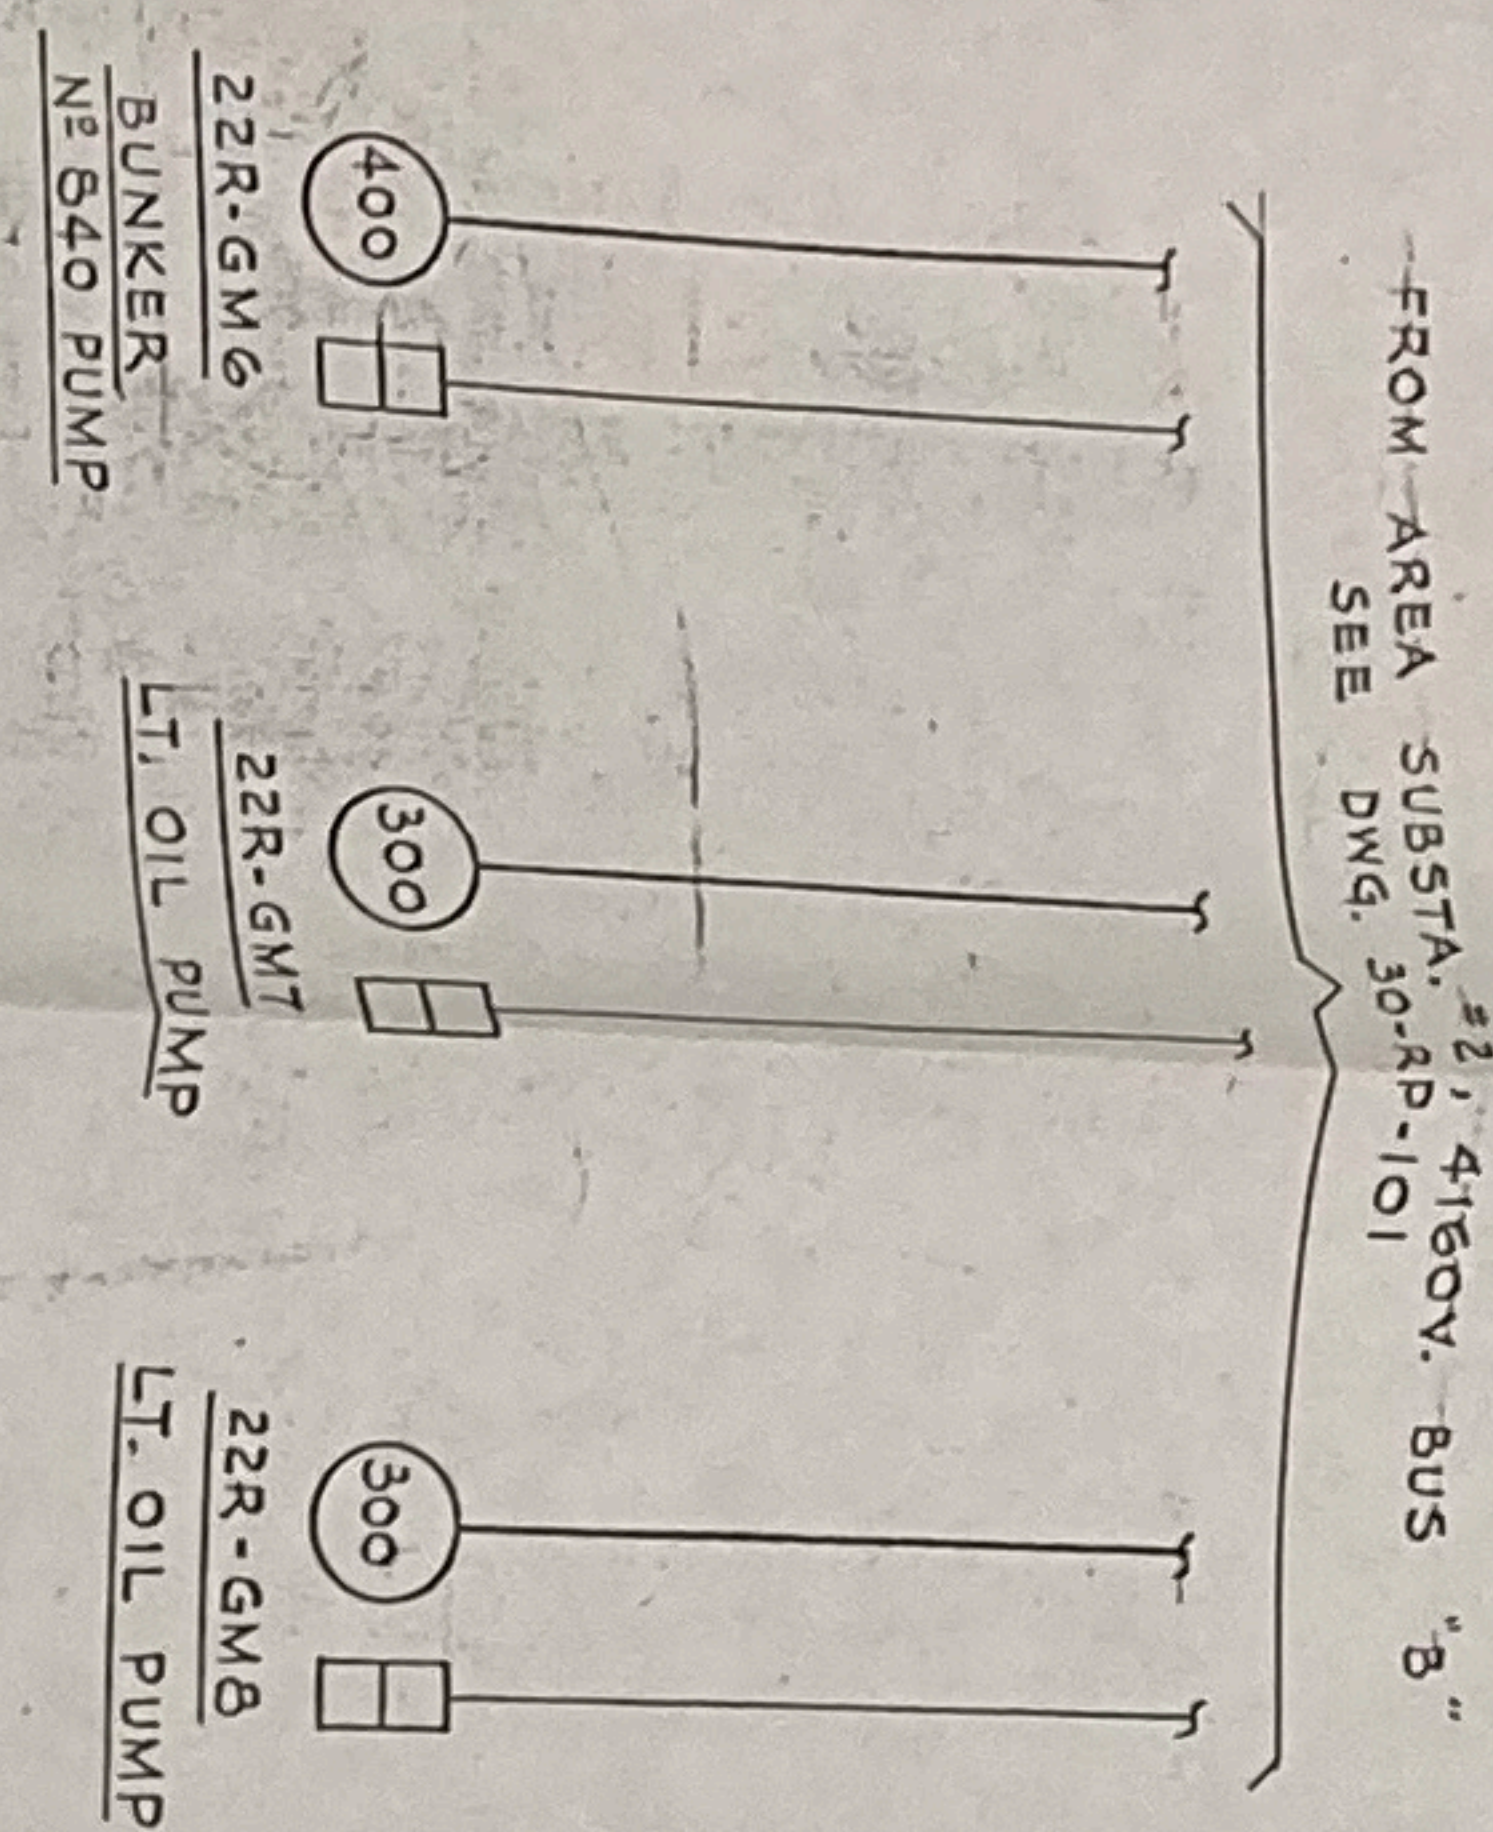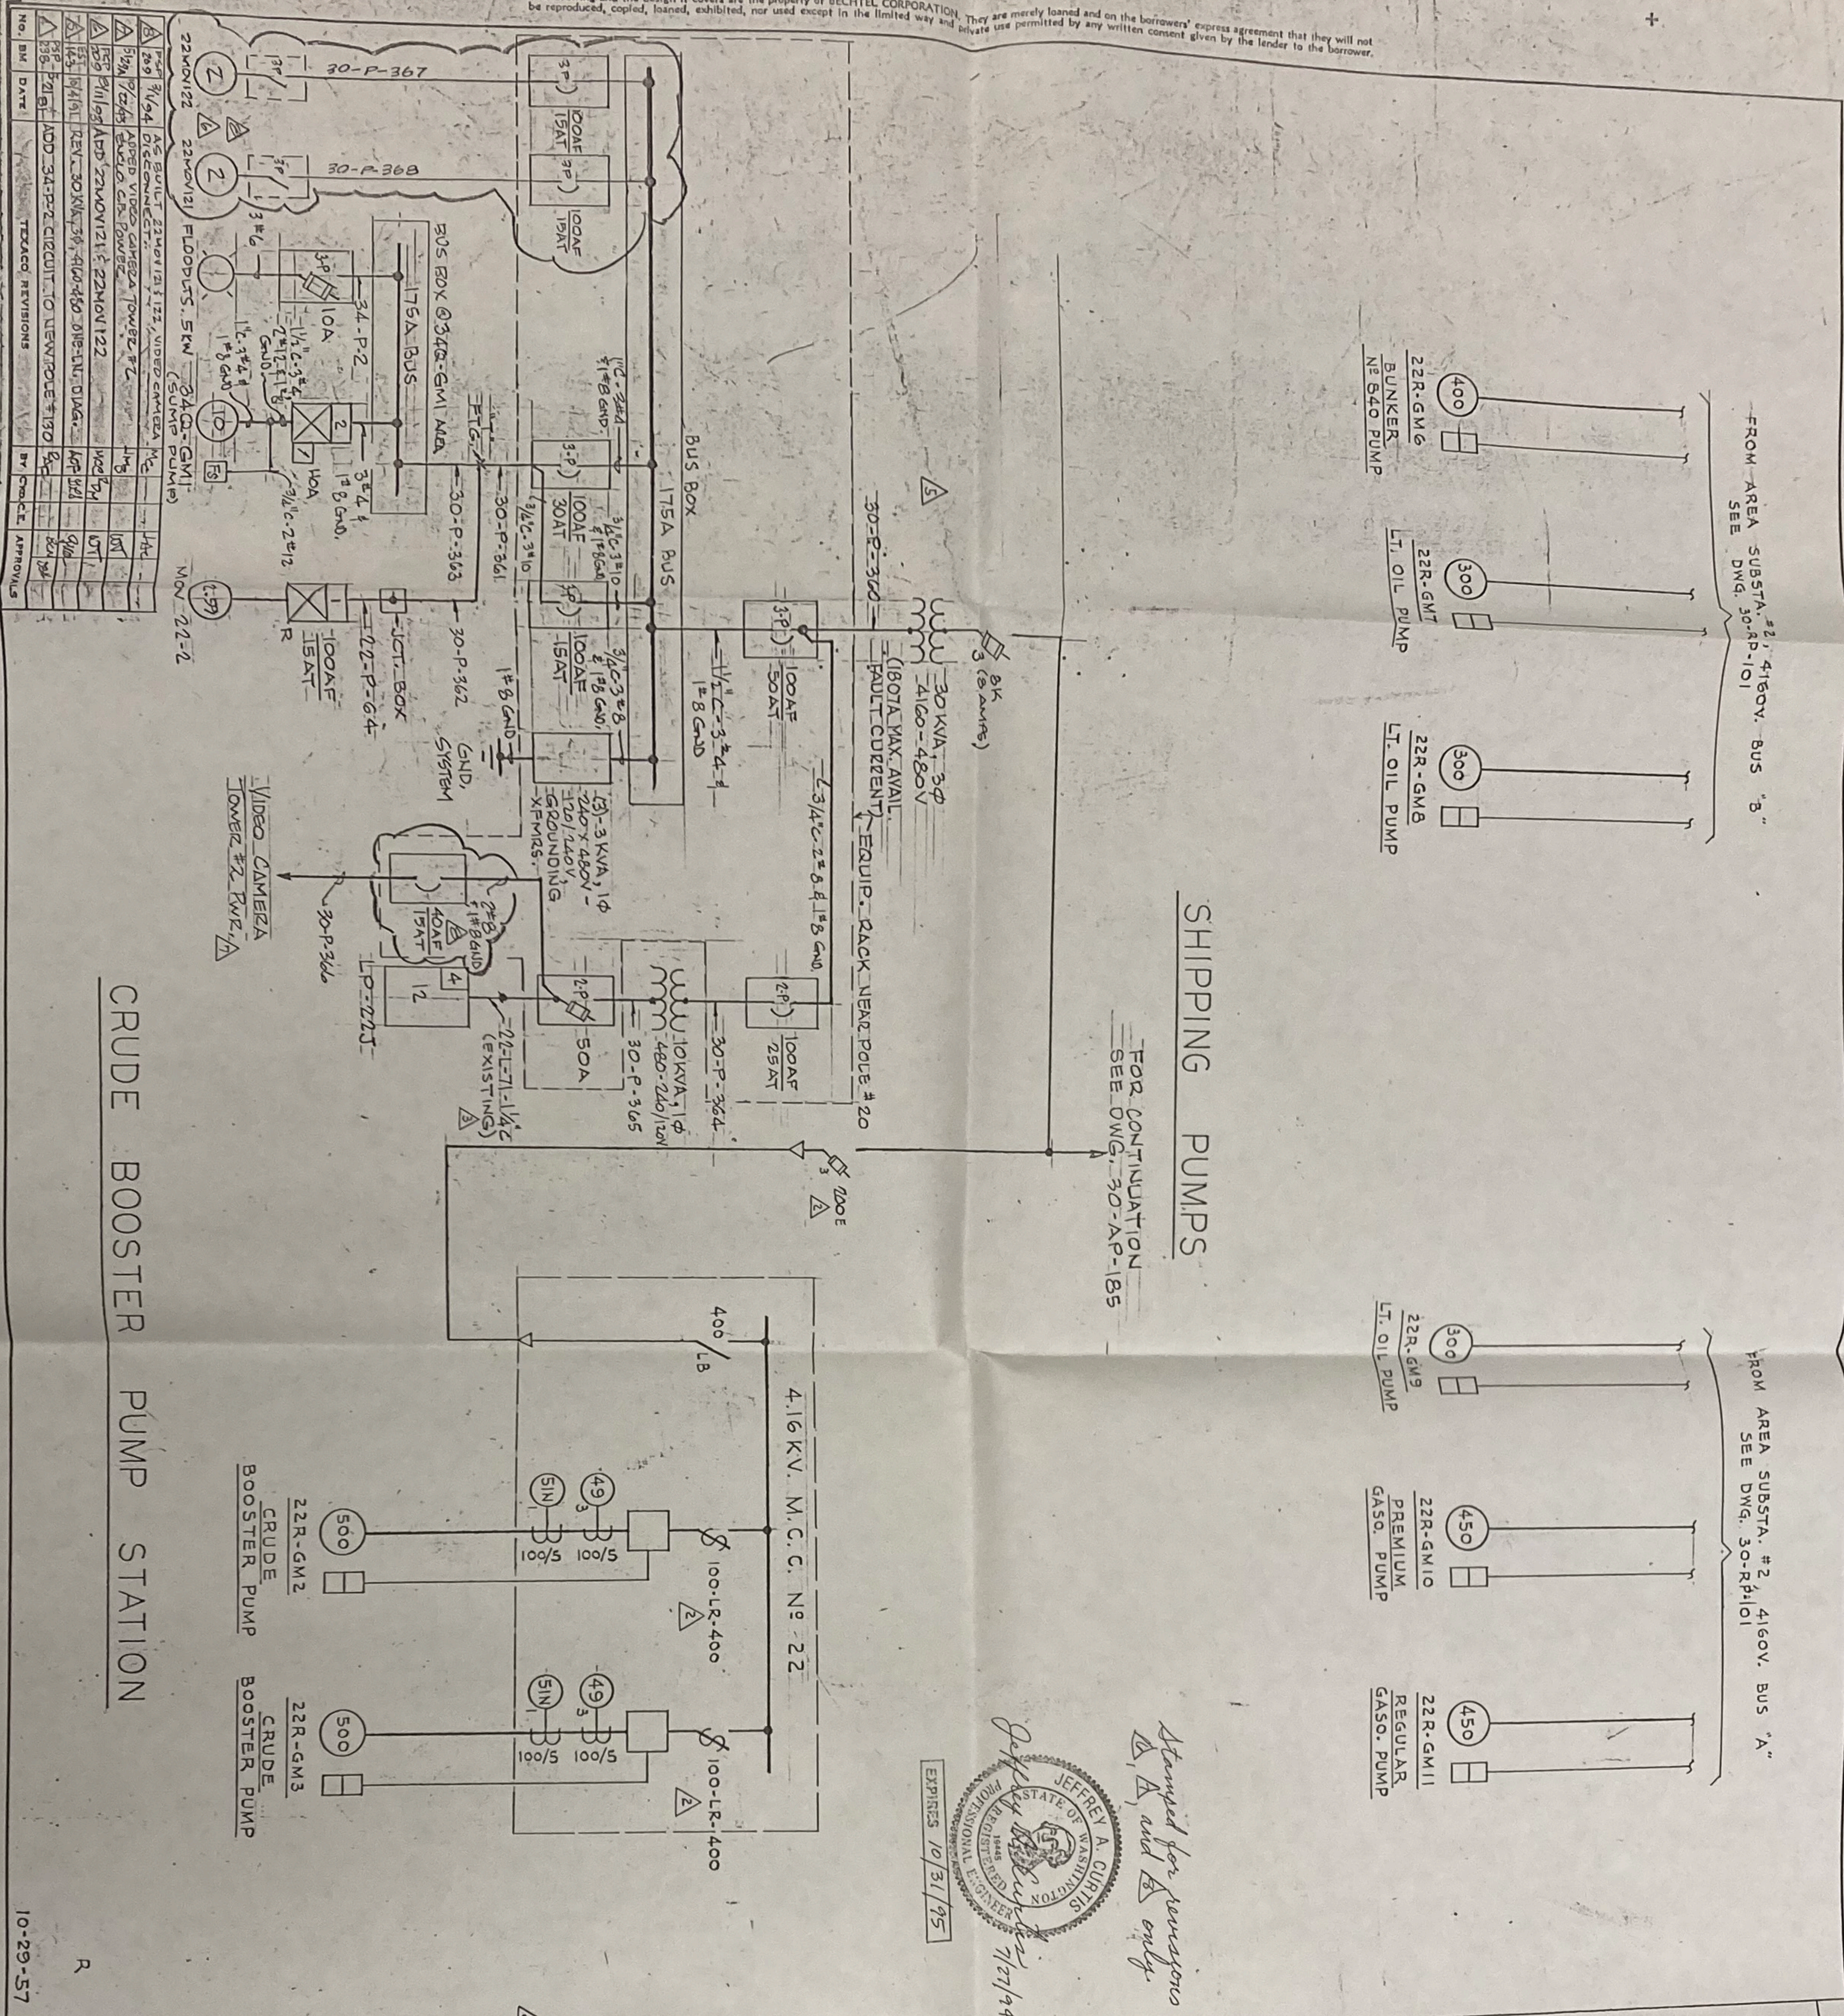

SHIPPING PUMPS

FOR CONTINUATION SEE DWG. 30-AP-185

*Approved for reviewers  
and only*

JEFFREY A. CURTIS  
REGISTERED PROFESSIONAL ENGINEER  
EXPIRES 10/31/95  
7/27/94

SIZE B  
SYMBOLS

- 3 FUSED CUTOFF POLE MOUNTING. 3-1 POLES INDICATED.
- 400 LOADBREAK DISCONNECT SWITCH. 400 INDICATES CURRENT RATING.
- MOTOR STARTER WITH CURRENT-LIMITING FUSES. 3-POLE, 416 KV.
- 100 COMBINATION MOTOR STARTER. 100 INDICATES BREAKER FRAME SIZE, NEMA SIZE REVERSING.
- TRANSFORMER. RATING AS NOTED.
- CURRENT TRANSF. QUANTITY & RATING AS NOTED.
- 12 LIGHTING PANEL. 240/120V. 3W. 1Ø. 4 INDICATES NEMA ENCLOSURE TYPE. 12 INDICATES NUMBER OF CIRCUITS.
- 49 RELAY: NE OUTSIDE CIRCLE INDICATES QUANT. 49: THERMAL OVERLOAD-THERMAL. SIN: GROUND OVERCURRENT-TIME.
- 500 SQUIRREL CAGE INDUCTION MOTOR. NE INDICATES H.P. RATING.

REFERENCE DRAWINGS

ONE LINE DIAGRAM - ELECT. DISTRIBUTION	30-RP-101
ELECT. LAYOUT - CRUDE BOOSTER PUMP STA.	22-AP-30
ELECT. U.G. PLAN BLENDING AREA	24-AP-3
ELEC. MISC., SECTS. & DETS., CRUDE BOOSTER	22-OP-44
DESIGNED FOR MISC. CONDUIT WAS 24-AP-30	24-AP-3
ISSUED FOR APPROVAL	22-OP-44

BECHTEL CORPORATION  
SAN FRANCISCO

THE TEXAS COMPANY  
PUGET SOUND WORKS

ELECTRICAL ONE LINE DIAGRAM  
CRUDE AND SHIPPING PUMPS

DESIGNED BY: *WNS* DATE: *2/2/94* CHECKED BY: *WNS* DATE: *2/2/94*

SCALE: AS SHOWN

2525 22-BP-198


10-29-57







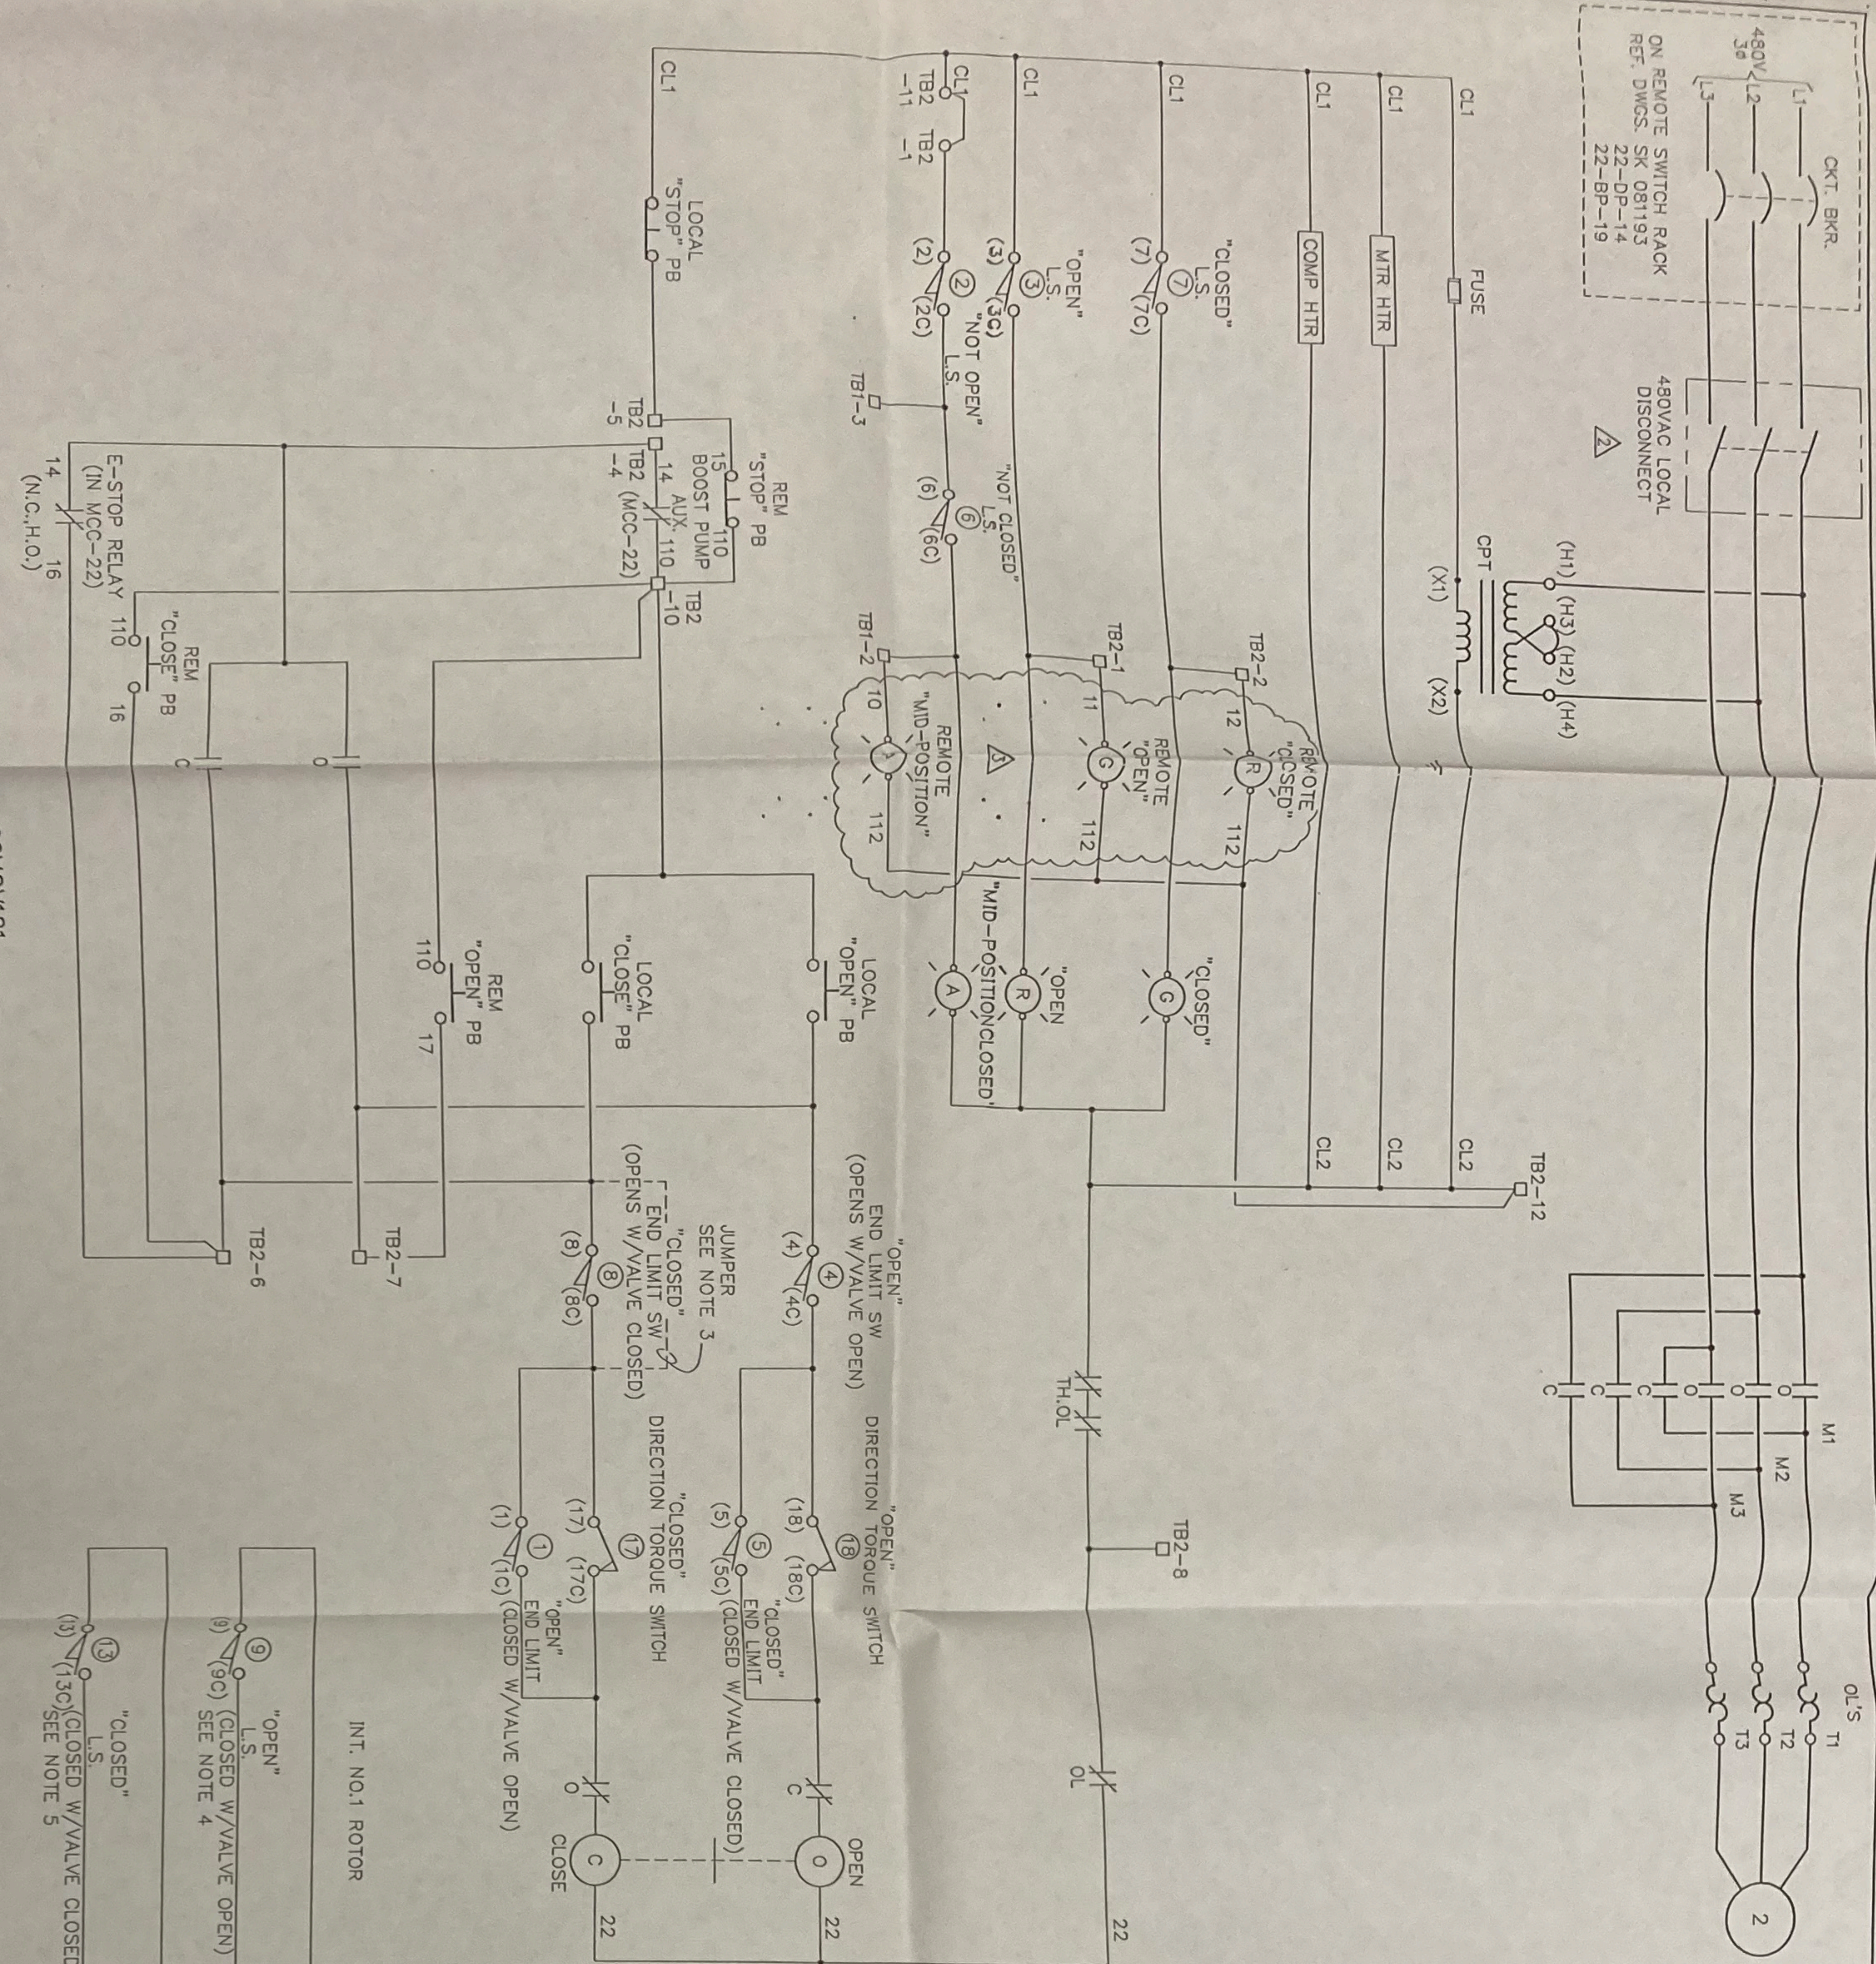

22MOV121  
AT CRUDE BOOSTER PUMP 22R-G2 (INLET)

DATE	BY	ESTIMATE	APPROVED
4/18/94	JAC	4980	JOB
8/13/93	WJT	4980	


DATE	DESCRIPTION
12/22/93	AS-BUILT
11/93	ADDED DISCONNECTS
09/16/93	ADDED PUSHBUTTONS, LIGHT
8/13/93	ISSUED FOR CONSTRUCTION

**TEXACO REFINING & MARKETING**  
 INC.  
 PUGET SOUND PLANT  
 ANACORTES, WASHINGTON

**PLANT 22 - WHARF & LOADING**  
**480V MOTOR OPERATED VALVE INLET**  
**MOTOR CNTRL SCHEMATIC-22MOV121**

INITIALS- DATE SCALE NONE  
 DWN. BY D.S 9/16/93 CAD FILE NO. 22DP0007  
 APP'D BY DRAWING NUMBER  
 CHF. ENGR. 22-DP-47 REV NO. 3

- NOTES**
1. ROTORS INT.1 & INT.2 CAN BE SET AT VALVE POSITION FULL OPEN, FULL CLOSED OR ANY POSITION IN BETWEEN AS INDICATED BY POINT A AND B.
  2. TRANSFORMER CONNECTION FOR HIGH VOLTAGE CONNECT H3 TO H2, H1 TO L1 & H4 TO L2. FOR LOW VOLTAGE CONNECT H1 & H3 TO L1.
  3. JUMPER OUT LOCAL SWITCH 8 FOR CLOSING VALVE AGAINST TORQUE SWITCH 17.
  4. SET LIMIT SWITCH TO CLOSE WHEN (4) OPENS.
  5. SET LIMIT SWITCH TO CLOSE BEFORE (8) OR (17) OPENS.

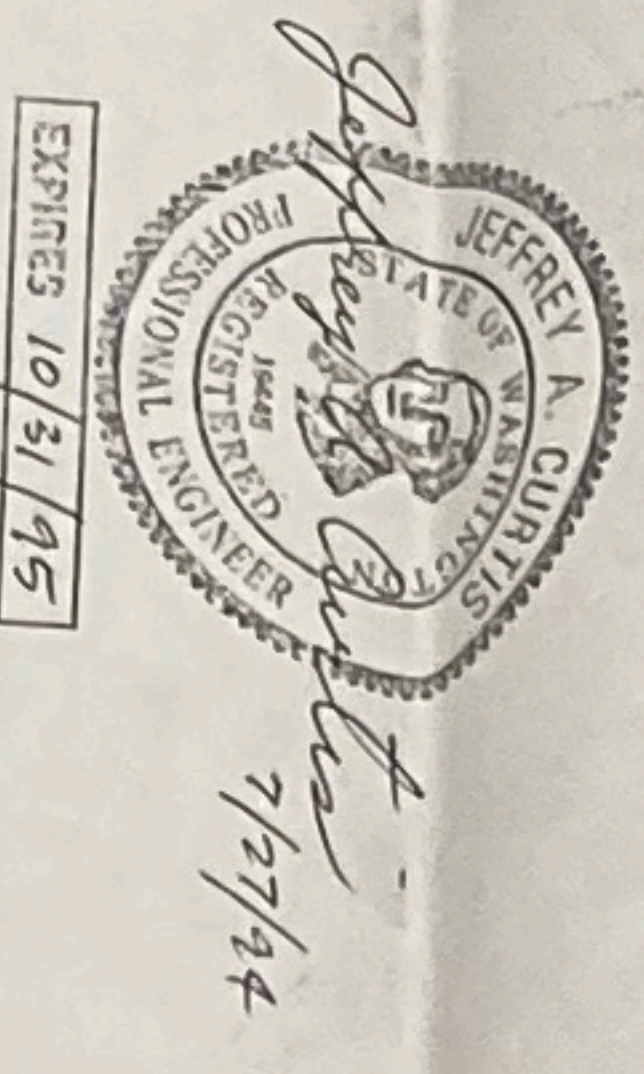

TO MCC2  
(SEE DIS 22-BU-12 & FP-22016-4)





**GENERAL NOTES**

- ALL ROAD POLES, CROSSARMS, & LOG ANCHORS TO BE FULL PENTACHLOROPHENOL TREATED.
- TRUNK LINES TO BE "PENTA" TREATED WOOD TO BE FULL TREATED.
- ALL OVERHEAD 1500 VOLT LINES TO BE #4/0 PVC.
- MEDIUM HAD DRAIN, STRANDED COPPER WIRE.
- ALL OVERHEAD 1500 VOLT LINES TO BE MADE WITH PRESURE CONNECTORS. ALL SHALL BE TAPPED WITH SCOTCH TAPE.
- ALL OVERHEAD STREET LIGHTING LINES TO BE #6 PVC.
- UNDERGROUND STREET LIGHTING LINES TO BE #6 BUTYL RUBBER INSULATED, NEOPRENE JACKETED, DIRECT BURIAL.
- UNDERGROUND DIRECT BURIAL CABLE FOR 480VOLT CIRCUITS TO BE #2 DUTY KUBSEK INSULATED, NEOPRENE JACKETED CABLES ON POLES TO BE MINIMUM OF #2 PVC.
- PHASE DESIGNATION FOR 480VOLT CIRCUITS SHALL BE AS FOLLOWS:
  - 1. PHASE A - RED
  - 2. PHASE B - YELLOW
  - 3. PHASE C - BLUE
- ENCASE UNDERGROUND CONDUITS IN RED CONCRETE.

**SYMBOLS**

WOOD POLE { TOP NUMERAL (60) INDICATES POLE NO. }  
 LOWER (66) POLE HEIGHT.

GUY STUD POLE { TOP NUMERAL (145) INDICATES POLE NO. }  
 LOWER (40) POLE HEIGHT.

DOWN GUY WITH EXPANDING ANCHOR.

DOWN GUY WITH LOG ANCHOR.

OVERHEAD LINE

UNDERGROUND CONDUIT OR DUCT

DIRECT BURIAL CABLE

DEADEND OF OVERHEAD LINE

TRANSFORMER, 34, FWR - DENOTES POWER SERVICE  
 4100 - 480 VOLTS 30 - INDICATES KVA RATING

TRANSFORMER, 34, (15) - INDICATES LIGHTING SERVICE  
 4100 - 120/208 VOLTS

TRANSFORMER, 34, (15) - INDICATES KVA RATING  
 480 - 120/240 VOLTS

STREET LIGHTING (ST - DENOTES STREET LIGHTING  
 TRANSFORMER, 20 KW) (2 - INDICATES CIRCUIT NO.)

INCANDESCENT STREET LIGHTING (I - INDICATES LIGHTING NO.,  
 ON WOOD POLE) (II - INDICATES REFRACTOR TYPE

US MERCURY VAPOR STREET LIGHTING (M - INDICATES LIGHT NO.,  
 ON WOOD POLE) (II - INDICATES REFRACTOR TYPE

2'S MERCURY VAPOR STREET LIGHTING (2 - INDICATES LIGHT NO.,  
 ON ALUMINUM STD.) (II - INDICATES REFRACTOR TYPE

MERCURY VAPOR STREET LIGHTING (M - INDICATES LIGHT NO.,  
 ON GRAY STEEL STD.) (II - INDICATES REFRACTOR TYPE

I - AREA INDICATES POSITION OF CONDUCTORS  
 ON POLES LOOKING IN THE DIRECTION  
 OF THE ARROW.

AERIAL CABLE

CABLE MARKER - SEE DETAIL T, DWG. 50-AP-9

**REFERENCE DRAWINGS**

ELECTRICAL DISTRIBUTION - KEY INDEX PLAN  
 - 15.8 KW/4.16 KW PFR. DWG.

STREET LITG. PLAN  
 - ONE LINE DIAGRAM  
 - SECTION & DETAILS

CRUDE BOOSTER PUMPS - STATION LAYOUT

NO.	DESCRIPTION	DATE	BY	CHECKED	SCALE
1	ISSUED FOR CONSTRUCTION	12/15/10	J. J. [Signature]	[Signature]	1" = 30'
2	REVISIONS				
3	REVISIONS				
**BECHTEL CORPORATION**  
 SAN FRANCISCO

**THE TEXAS COMPANY**  
 PUGET SOUND WORKS

**ELECTRICAL DISTRIBUTION PLAN**

**BLOCK 1**

**2525 30-AP-1**

6400 - I - APPROVED BY THE TEXAS CO.

SCANNED 30EP0050





LIST OF MATERIALS

ITEM #	ITEM DESCRIPTION
1	LIQUIDTIGHT FLEXIBLE METAL CONDUIT, 3/4", TYPE "UA"
2	CONNECTOR, LIQUIDTIGHT, 3/4", STRAIGHT, O-Z/GEDNEY #40-75
3	CONDUIT SEAL, 3/4", C-H #EYS3
4	UNION, 3/4", C-H #JUNY205
5	REDUCER, 1 1/2"-3/4", C-H #RES2
6	CONDUIT OUTLET BODY, 3/4", C-H #T37
7	CONDUIT OUTLET BODY COVER, C-H #270
8	CONDUIT OUTLET BODY GASKET, C-H #GASK572
9	NAMEPLATE
10	DISCONNECT, 3P, 600V, NEMA 7, HP RATED, WITH LOCKABLE OPERATOR. SQUARE D #KR2

NOTES:

1. REFERENCE NAMEPLATE SCHEDULE 22-BP-46.

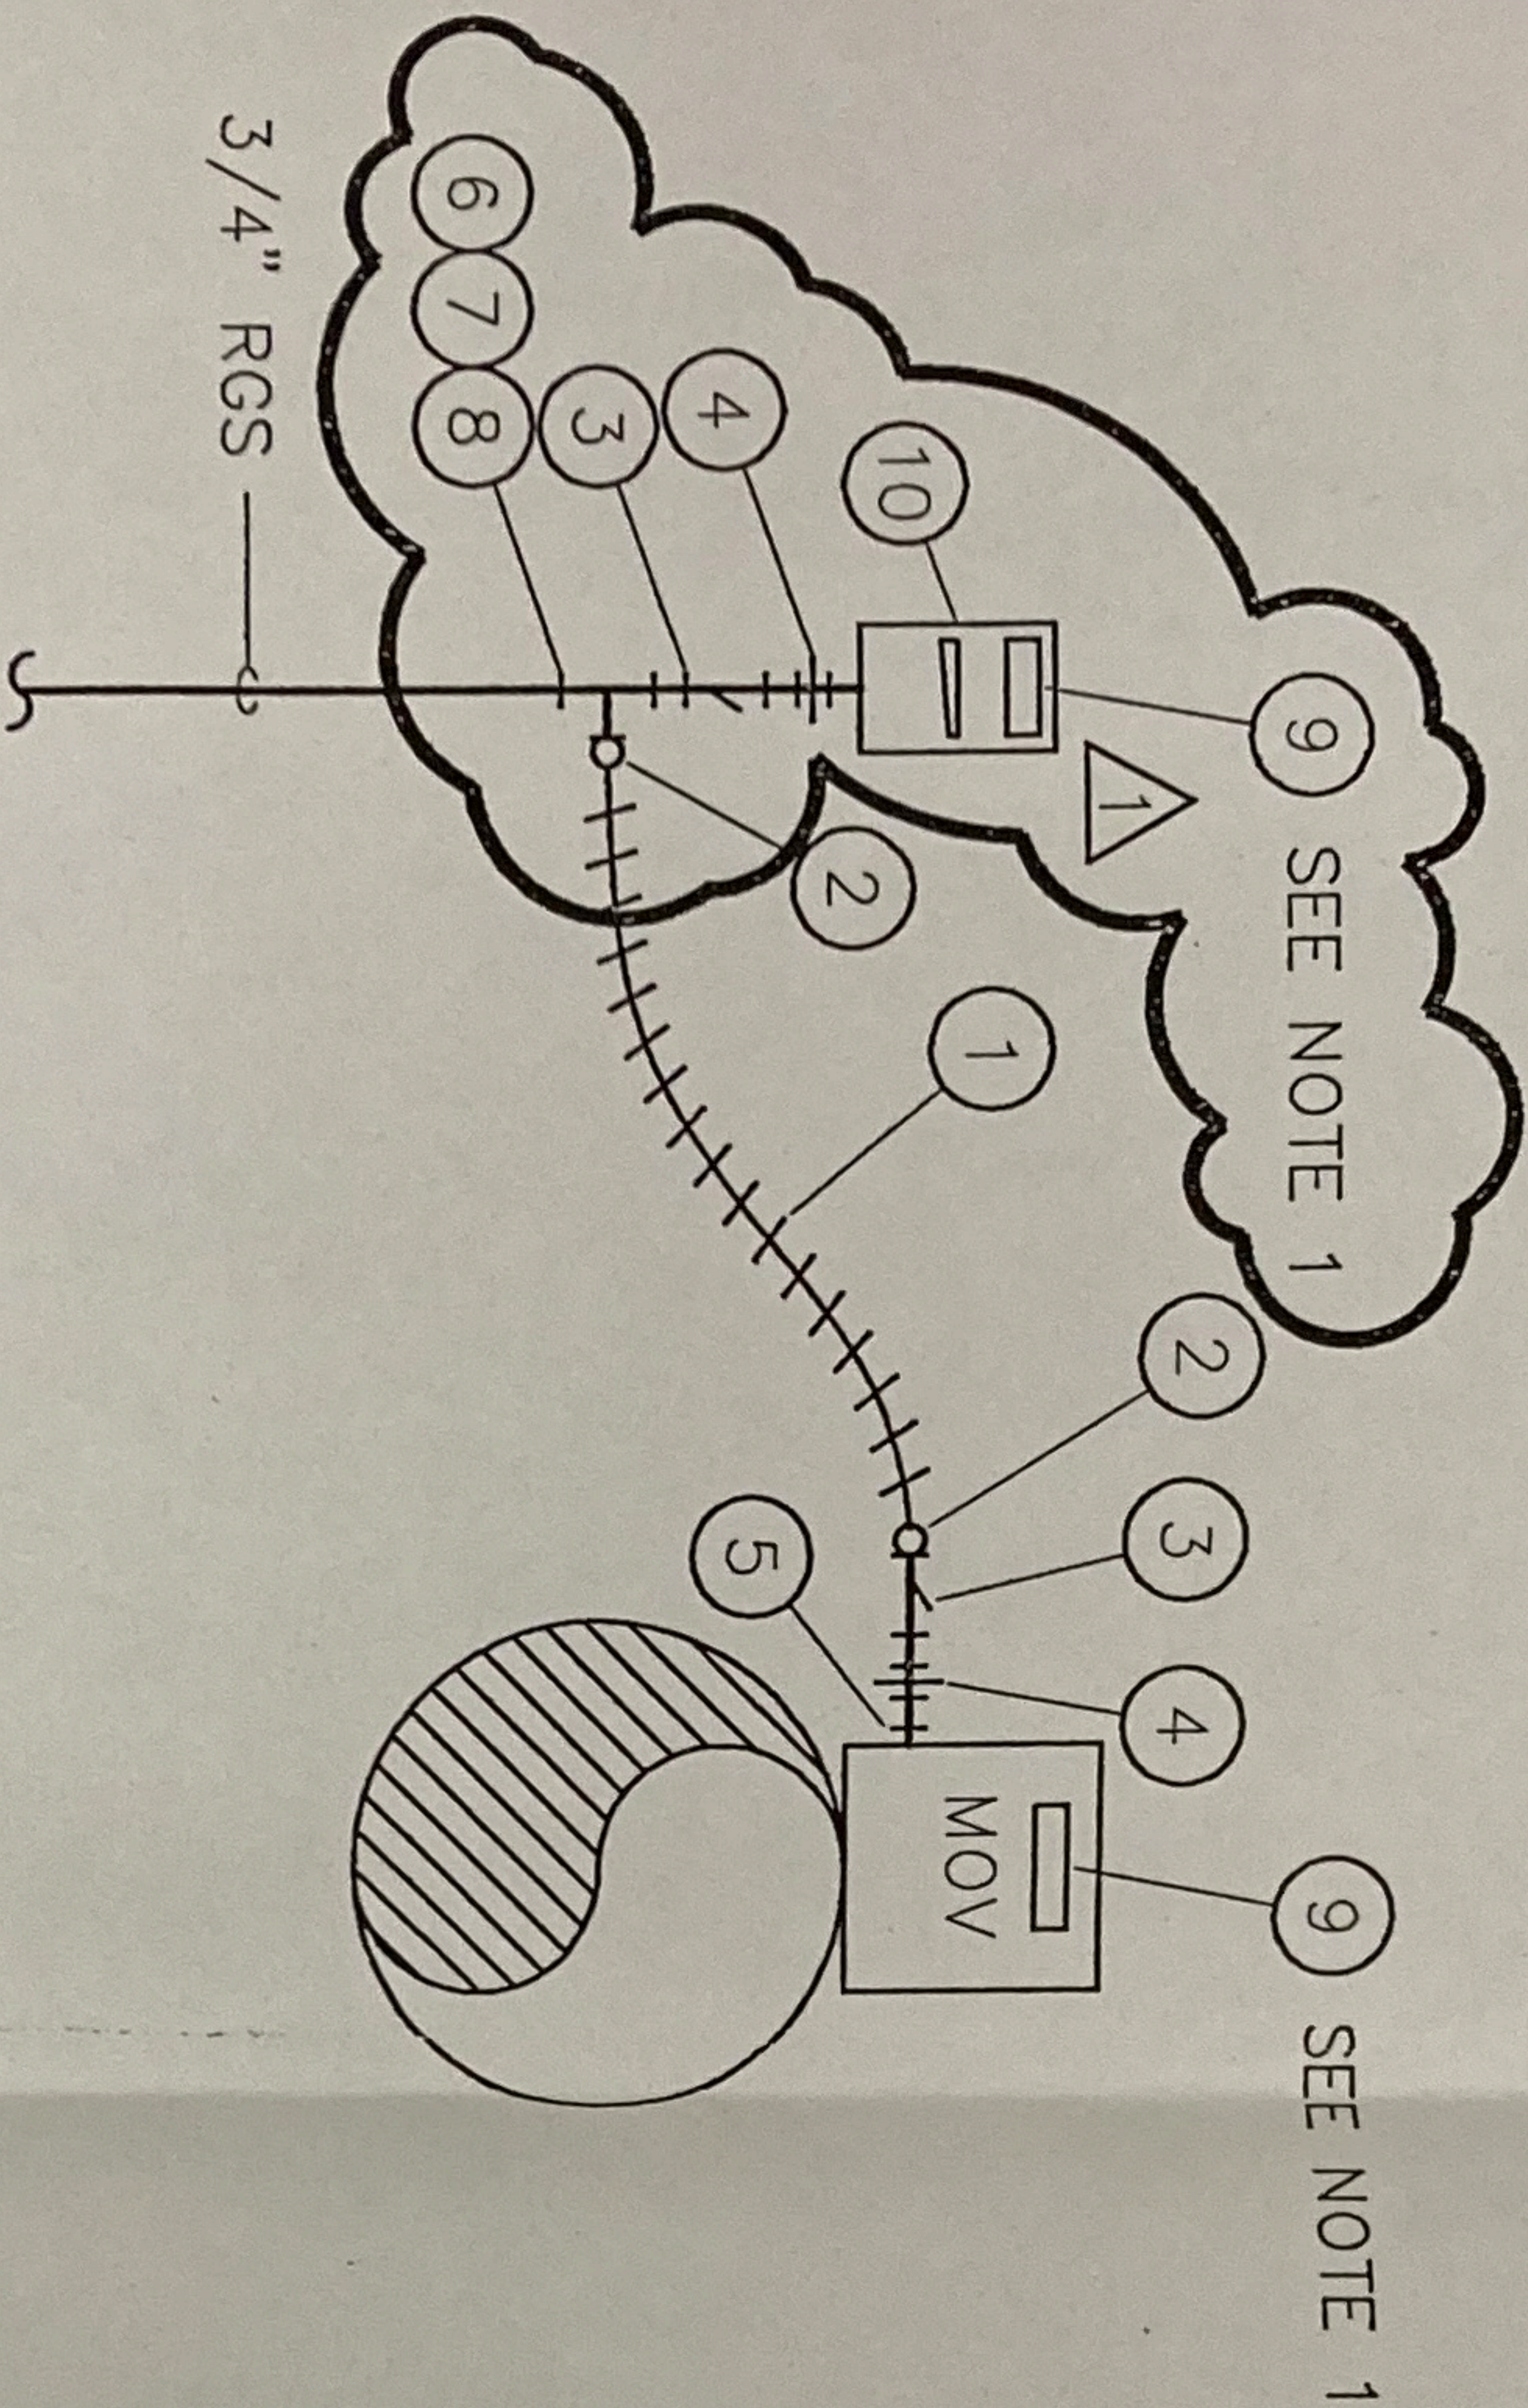


DETAIL A

TYPICAL FOR 22MOV121 & 22MOV122  
 REFERENCE DRAWING 22-AP-30

THIS DRAWING HAS NOT BEEN PUBLISHED. IT IS THE SOLE PROPERTY OF TEXACO REFINING AND MARKETING, INC. IT IS LENT TO THE RECIPIENT FOR HIS CONFIDENTIAL USE ONLY, AND UPON THE CONDITION AND AGREEMENTS FOLLOWING. IN CONSIDERATION OF THE LOAN OF THIS DRAWING THE RECIPIENT PROMISES AND AGREES TO RETURN IT UPON REQUEST, AND THAT IT SHALL NOT BE REPRODUCED, COPIED, LENT OR OTHERWISE DISPOSED OF DIRECTLY OR INDIRECTLY WITH-

DATE	BY	DESCRIPTION	REVISIONS
12/1/93	WJT	PSP 290	4980
8/13/93	WJT	PSP 290	4980
11/29/93	MCC	ADD DISCONNECT	
8/11/93	MCC	ISSUED FOR CONSTRUCTION	

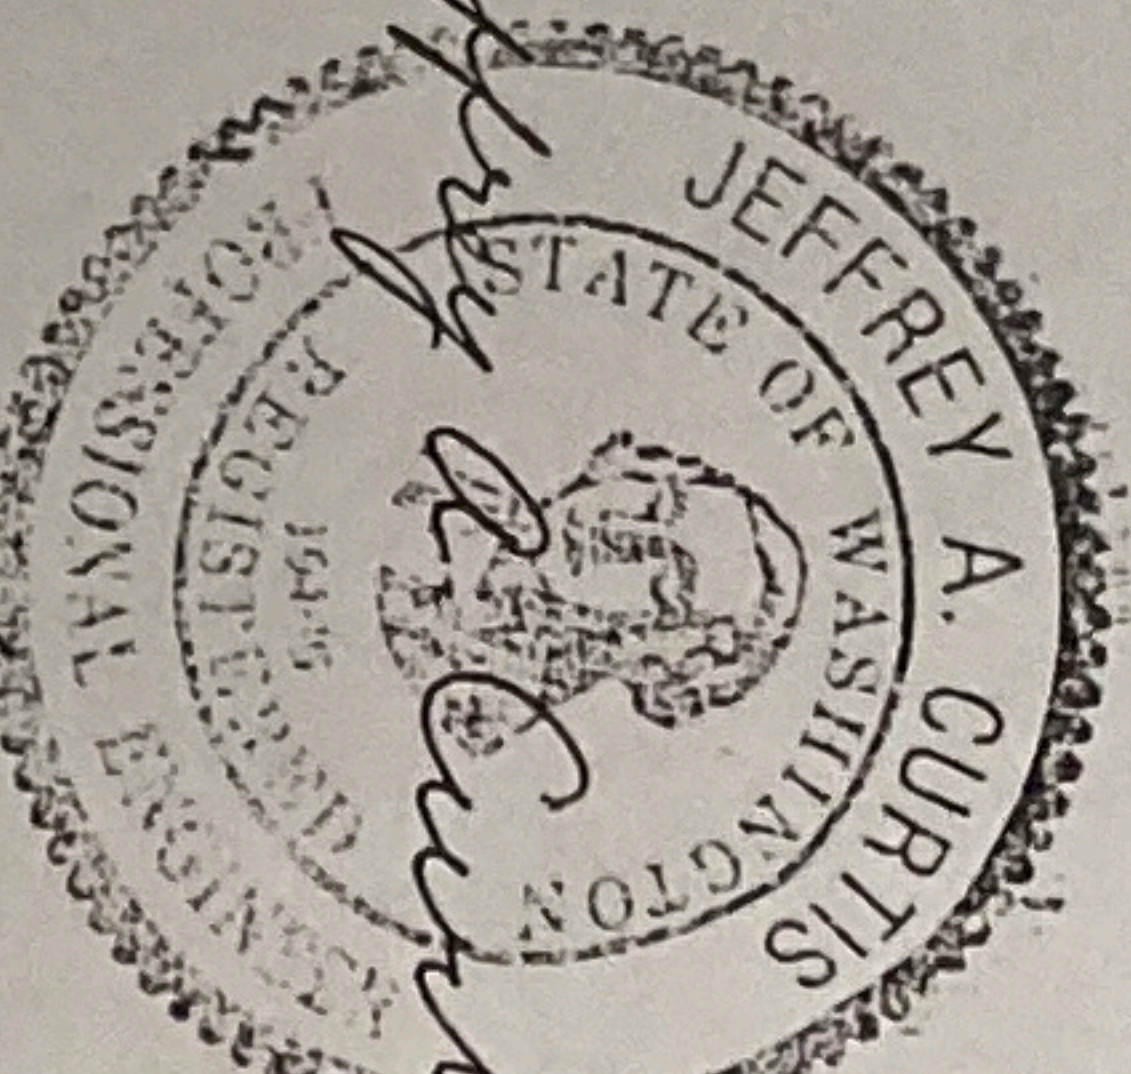

EXPIRES 10/31/95

7/27/94

TEXACO REFINING & MARKETING INC.  
 PUGET SOUND PLANT ANACORTES, WASHINGTON

PLANT 22 - WHARF & LOADING ELECTRICAL INSTALLATION DETAIL  
 480V MOV FEEDER CONNECTION

INITIALS-	DATE	SCALE: NONE	REV NO
DWN BY	MCC 8/11/93	CAD FILE NO. 22BP0005	
CKD BY	RDM 8/13/93	DRAWING NO.	
APP'D BY	WJT 8/13/93	22-BP-45	1
CHK. ENGR.	-		



## **Appendix B**

### **3.6.0**

#### **Bill of Materials 4980 / 5059**

#### **Installation of MOV's (Motor Operated Valves) Crude Booster Pump and Installation of MOV Controls**



50-1301-T

TEXACO  
BILL OF MATERIAL  
PUGET SOUND PLANT

B.M. 4980

W.O. 9312387

SHEET 1 of 4

Master  
File Copy

TITLE: RP&S, DOCKLINE CRUDE BOOSTER PUMP, INSTALL MOV'S

CHARGE: PSP 290

MODIFICATION REVIEW CONDUCTED


APPROVAL: *WT JAK*

P&ID'S REVISED N/A

REV 0

MASTER DIST.	PM	AMM	AMO	AMT	OPR	PWR	PRO	ER	AWC	LAB	ENG	CA	GMF
		X	X	X	X	X					X	X	X

B M C O P I E S	D R A W I N G S	REVISIONS														P L A N T C & C
		0	6	6	0	0	1	0	0	5	0	0	0	0	0	
		SK	22	22	22	22	22	22	29	30	50	50	E	E	P	
		08	-	-	-	-	-	-	-	-	-	-	A	T	L	
		11	AP	BP	BP	BP	DP	DP	EP	AP	EP	EP	G	R	A	
		93	-	-	-	-	-	-	-	-	-	-	-	-	N	
			30	19	45	46	44	47	1	1	26	38	0	0	T	
													0	1		
													4	1	C	
													1	30	C	
14	TOTALS	11	10	8	8	8	8	8	8	8	8	8	8	8	8	
1	M&C	1	1													
1	STOREHOUSE															
	PF/I&T															
4	PF/I&E	4	4	4	4	4	4	4	4	4	4	4	4	4	4	
1	I&E (WEO)	1	1	1	1	1	1	1	1	1	1	1	1	1	1	
	AF/NS															
	AF/SS															
	AF/OFF PLT															
	AF/SHOPS															
	F/MACH SHP															
	F/MT-BT															
	F/FCU-BoHo															
	F/POLY-ALK															
	F/CRU-HTU															
	F/CPD															
2	F/RP&S	2	2	2	2	2	2	2	2	2	2	2	2	2	2	
	INSP DEPT															
1	ENG'R DEPT															
	EQUIP FILE															
	"R" STAMP															
1	RAM	1	1													
1	RAP/I&E															
1	MCC/PWR	1	1	1	1	1	1	1	1	1	1	1	1	1	1	
1	WJT/PWR	1														

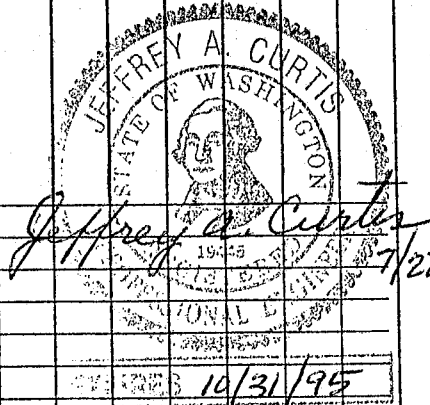

Master  
File Copy



TEXACO  
PUGET SOUND PLANT  
BILL OF MATERIAL

BM 4980

WO 9312387

SHEET 2 OF 4

TITLE: RP&S, DOCKLINE CRUDE BOOSTER PUMP, INSTALL MOV,S

CHARGE PSP 290      MADE BY MCC      CHECKED BY RDM      ISSUE DATE 8 -20 - 93

**PURPOSE:** TO PROVIDE 480VAC POWER TO NEW MOTOR OPERATED VALVES 22MOV121 & 22MOV122 LOCATED AT SOUTH SIDE OF CRUDE BOOSTER PUMP 22R-G2. OVERVIEW OF ELECTRICAL INSTALLATION IS AS SHOWN ON SCOPE SKETCH SK081193.

**SCOPE:** CONTRACTOR AND/OR PLANT FORCES SHALL PERFORM THE FOLLOWING WORK AS MANPOWER AND MATERIALS BECOME AVAILABLE. THE CONSTRUCTION CREW SHALL NOTIFY MIKE CHRISTY, EXT 717 WHEN WORK IS TO BEGIN. SHOULD QUESTIONS ARISE DURING INSTALLATION, CONTACT POWER DEPARTMENT: MIKE CHRISTY EXT 717, OR BILL TEZAK EXT 537.

**CAUTION:** TAKE ALL NECESSARY SAFETY PRECAUTIONS WHEN PERFORMING WORK IN VICINITY OF ENERGIZED LINES, AND/OR EQUIPMENT. THIS WORK WILL REQUIRE APPROACHING ENERGIZED LINES, EQUIPMENT & DEVICES WITH VOLTAGES OF UP TO 480V LINE-TO-LINE AND UP TO 480V LINE-TO-GROUND.

1. LOCATE EXISTING ELECTRICAL EQUIPMENT RACK AT EAST SIDE OF POLE 20 (REFERENCE DRAWING 30-AP-1). ROUTE (2) 1" RGS CONDUITS (30-SP-366 & 30-P-367) BELOW GRADE FROM SOUTH SIDE OF EQUIPMENT RACK PAD TO EAST SIDE OF CRUDE BOOSTER PUMP AREA AS SHOWN ON DRAWINGS 22-DP-44, 22-AP-30, 30-AP-1 & 50-EP-26.
2. POUR RED CONCRETE AND BACKFILL DUCT BANK EXCAVATION PER TEXACO GEMS A-1P9.
3. INSTALLATION OF ITEMS AT EQUIPMENT RACK SHALL BE AS FOLLOWS (REFERENCE DRAWING 22-DP-44):
  - A. MOUNT (2) 480V, 15AT, 100AF, NEMA 3R CIRCUIT BREAKERS AND ENCLOSURES ON ELECTRICAL EQUIPMENT RACK (FIELD SHALL SUPPORT EQUIPMENT AS REQUIRED).
  - B. INSTALL 3/4" CONDUIT HUB ON EXISTING 480V BUS BOX AND ROUTE 3/4" CONDUIT AND/OR NIPPLES BETWEEN BUS BOX AND MOV CIRCUIT BREAKER ENCLOSURES.
  - C. INSTALL 3/4" CONDUIT HUB ON 22MOV121 CIRCUIT BREAKER ENCLOSURE AND ROUTE 3/4" RGS CONDUIT TO A 1"-3/4" CONDUIT REDUCER, 1" COUPLING AND 1" SEALING FITTING ON 30-P-367.
  - D. 30-SP-366 SHALL BE FITTED WITH A 1" COUPLING AND PLUG WHERE IT TRANSITIONS ABOVE GRADE.
  - E. EXISTING #4 STRANDED BARE COPPER GROUNDING CONDUCTOR SHALL BE BONDED TO 30-P-367 WITH GROUNDING CONNECTOR (UL LISTED FOR GROUNDING).



TEXACO  
PUGET SOUND PLANT  
BILL OF MATERIAL

BM 4980

WO 9312387

SHEET 3 OF 4

4. INSTALLATION OF ITEMS AT CRUDE BOOSTER PUMP AREA SHALL BE AS FOLLOWS (REFERENCE DRAWINGS 22-AP-30 AND 22-BP-45, 30-AP-1):

A. INSTALL 1" SEALING FITTING WITH DRAIN ON 30-P-367 WHERE IT TRANSITIONS ABOVE GRADE. INSTALL 1"-3/4" CONDUIT REDUCER AND ROUTE 3/4" CONDUIT TO 22MOV121 AS SHOWN ON DRAWING 22-AP-30, FROM A "TEE" FITTING NEAR 22MOV121 ROUTE 30-P-368 TO 22MOV122 (FIELD SHALL SUPPORT CONDUIT AND ROUTE AS REQUIRED). INSTALLATION DETAIL SHOWING LIQUIDTIGHT FLEXIBLE METAL CONDUIT AND SEALING FITTINGS FOR 480V FEEDER CONNECTION TO MOV'S IS SHOWN ON DRAWING 22-BP-45.

B. 30-SP-366 SHALL BE FITTED WITH A 1" COUPLING AND PLUG WHERE IT TRANSITIONS ABOVE GRADE.

5. PULL IN AND TERMINATE CONDUCTORS PER DRAWINGS 22-BP-19, 22-DP-47 AND PLANT 30 CONDUIT AND CONDUCTOR SCHEDULE.

6. INSTALL NAMEPLATES ON 22MOV121, 22MOV122 AND ASSOCIATED CIRCUIT BREAKER ENCLOSURES PER DRAWINGS 22-BP-45, 22-BP-46, 22-BP-44 AND 50-EP-38.

7. ALL WIRE AND CABLE SHALL BE MEGGER TESTED PER TEXACO GEMS #L-1P9 ITEM #14.3 WIRING, AND ELECTRICAL ACTIVITY GUIDE EAG-004. RECORD RESULTS ON ELECTRICAL TEST REPORT FORM ETR-011.

8. UPON COMPLETION OF PROJECT, ALL WORK WILL BE INSPECTED AND TESTED BY A TEXACO PSP REPRESENTATIVE AND AS-BUILT DRAWINGS SHALL BE RETURNED TO TEXACO PSP POWER DEPARTMENT.



50-1304-T

TEXACO  
 PUGET SOUND PLANT  
 BILL of MATERIALS

B of M 4980  
 SHEET 4 OF 4


ITEM	QUAN	DESCRIPTION	FURNISHED BY
1	1	CIRCUIT BREAKER, 480V, 15AT, 100AF, 3 POLE, NEMA TYPE 12/3R ENCLOSURE, SQUARE "D" #FAL34015 AND #FA100AWK ENCLOSURE WITH EQUIPMENT GROUND BAR	RA34411301B
2	2	SEALING FITTING, 1", W/DRAIN, C-H #EYD3	I & E
3	2	SEALING FITTING, 3/4", C-H #EYS2	I & E
4	6FT	LIQUIDTIGHT FLEXIBLE METAL CONDUIT, 3/4", TYPE "UA"	I & E
5	4	CONNECTOR, LIQUIDTIGHT, 3/4", STRAIGHT, O-Z/GEDNEY #4Q-75	I & E
6	1	GROUND CONNECTOR, 3/4", UL LISTED FOR GROUNDING, BURNDY #GAR144C	I & E
7	5	HUB, 3/4", MYERS #ST-2	I & E
8	2	CONDUIT PLUG, 1", SQUARE HEAD, C-H #PLG35	I & E
9	1	CONDUIT BODY, 3/4", FORM 7, C-H #T27	I & E
10	2	CONDUIT BODY, 3/4", FORM 7, C-H #LB27	I & E
11	3	CONDUIT BODY COVER, 3/4", FORM 7, C-H #270	I & E
12	3	CONDUIT BODY GASKET, 3/4", FORM 7, C-H #GASK572	I & E
13	2	REDUCER, 1 1/2"-3/4", C-H #RE52	I & E
14	2	REDUCER, 1"-3/4", C-H #RE32	I & E
15	200FT	CONDUIT, 1", TYPE RGS	I & E
16	60FT	CONDUIT, 3/4", TYPE RGS	I & E
17	150FT	WIRE, #12 AWG COPPER, GREEN, 600V TYPE THWN	I & E
18	1000FT	WIRE, #12 AWG COPPER, BLACK, 600V TYPE THWN	I & E



# EQUIPMENT LIST

EQUIPMENT NO.	DESCRIPTION	SECTION
22R-02	CRUDE BOOSTER PUMP	14
22R-03	CRUDE BOOSTER PUMP	13
22R-04	CRUDE BOOSTER PUMP	11
22R-05	CRUDE BOOSTER PUMP	9
22R-06	CRUDE BOOSTER PUMP	9
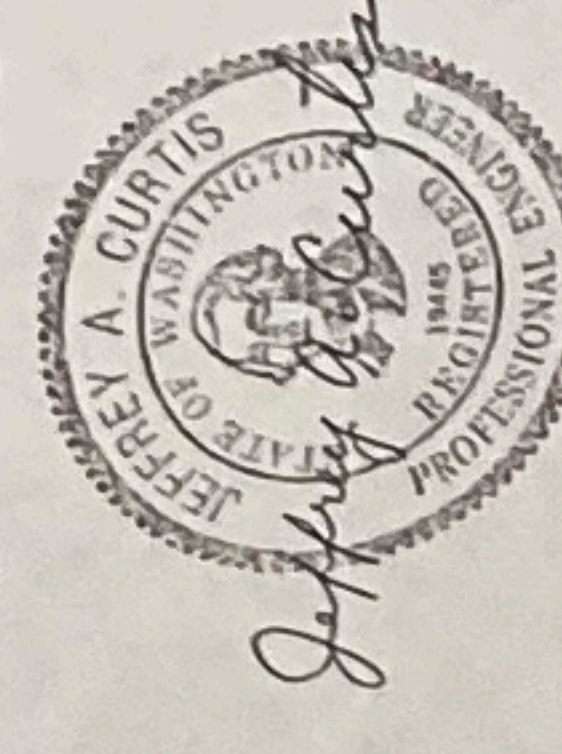

EXPIRES 10/31/92

## NOTES

- UTILITIES ARE CONTINUED TO THE FOLLOWING DRAWINGS:
  - ON SHORE UTILITIES..... 22-01-0056
  - OFF SHORE UTILITIES..... 22-01-0056
- INSTRUMENT TAG NUMBERS ARE PRECEDED BY THE PLANT NUMBER UNLESS OTHERWISE INDICATED.
- DESIGN DATA INDICATES EQUIPMENT MAINT UNLESS NOTED WITH A LEADING \*.
- HIGH / LOW POINT DRAIN VALVES, DRAIN VALVES AT CONTROL STATIONS AND INSTRUMENT ROOT VALVES REQUIRED BY GEMS ARE NOT SHOWN.
- SHIPPING PUMP EMERGENCY STOPS LOCATED AT BERTHS 1, 2 & 3 INTERCONNECT VIA TELEPHONE CABLE.
- SEE DRAWING 22-AP-21 FOR WIRING DIAGRAM DETAIL OF TORQUE SWITCH CONTROL CIRCUIT INTERRUPTS.

## REFERENCE DRAWINGS


DWG NO.	TITLE
22-AL-8	PIPING PLAN AT SHIPPING PUMPS
22-RA-2	WHARF LOADING FACILITIES

REV	DATE	BY	CHK'D	REVISIONS
1	8/10/93	5059		ADDED MOV121 AND MOV122 - W09313410
2	8/7/93			SOF PROJECT EST 9169 ISSUED AS BUILT
3	8/7/93			UPDATE CONTINUATION BOXES
4	10/8/92			ISSUED APPROVED

**TEXACO REFINING & MARKETING INC.**  
 PUGET SOUND PLANT  
 ANACORTES, WASHINGTON



**WHARF AND LOADING FACILITIES**  
**PIPING AND INSTRUMENT DIAGRAM**  
**PRODUCT SHIPPING PUMPS**

INITIALS: \_\_\_\_\_ DATE: 4/15/92 SCALE: NONE  
 DWN. BY: JST JOB FILE NO.: 22DA0021  
 CDD. BY: RPK DRAWING NUMBER: 22-DA-0020  
 APP. BY: \_\_\_\_\_ REV. NO.: 3  
 CHK. ENGR.: \_\_\_\_\_

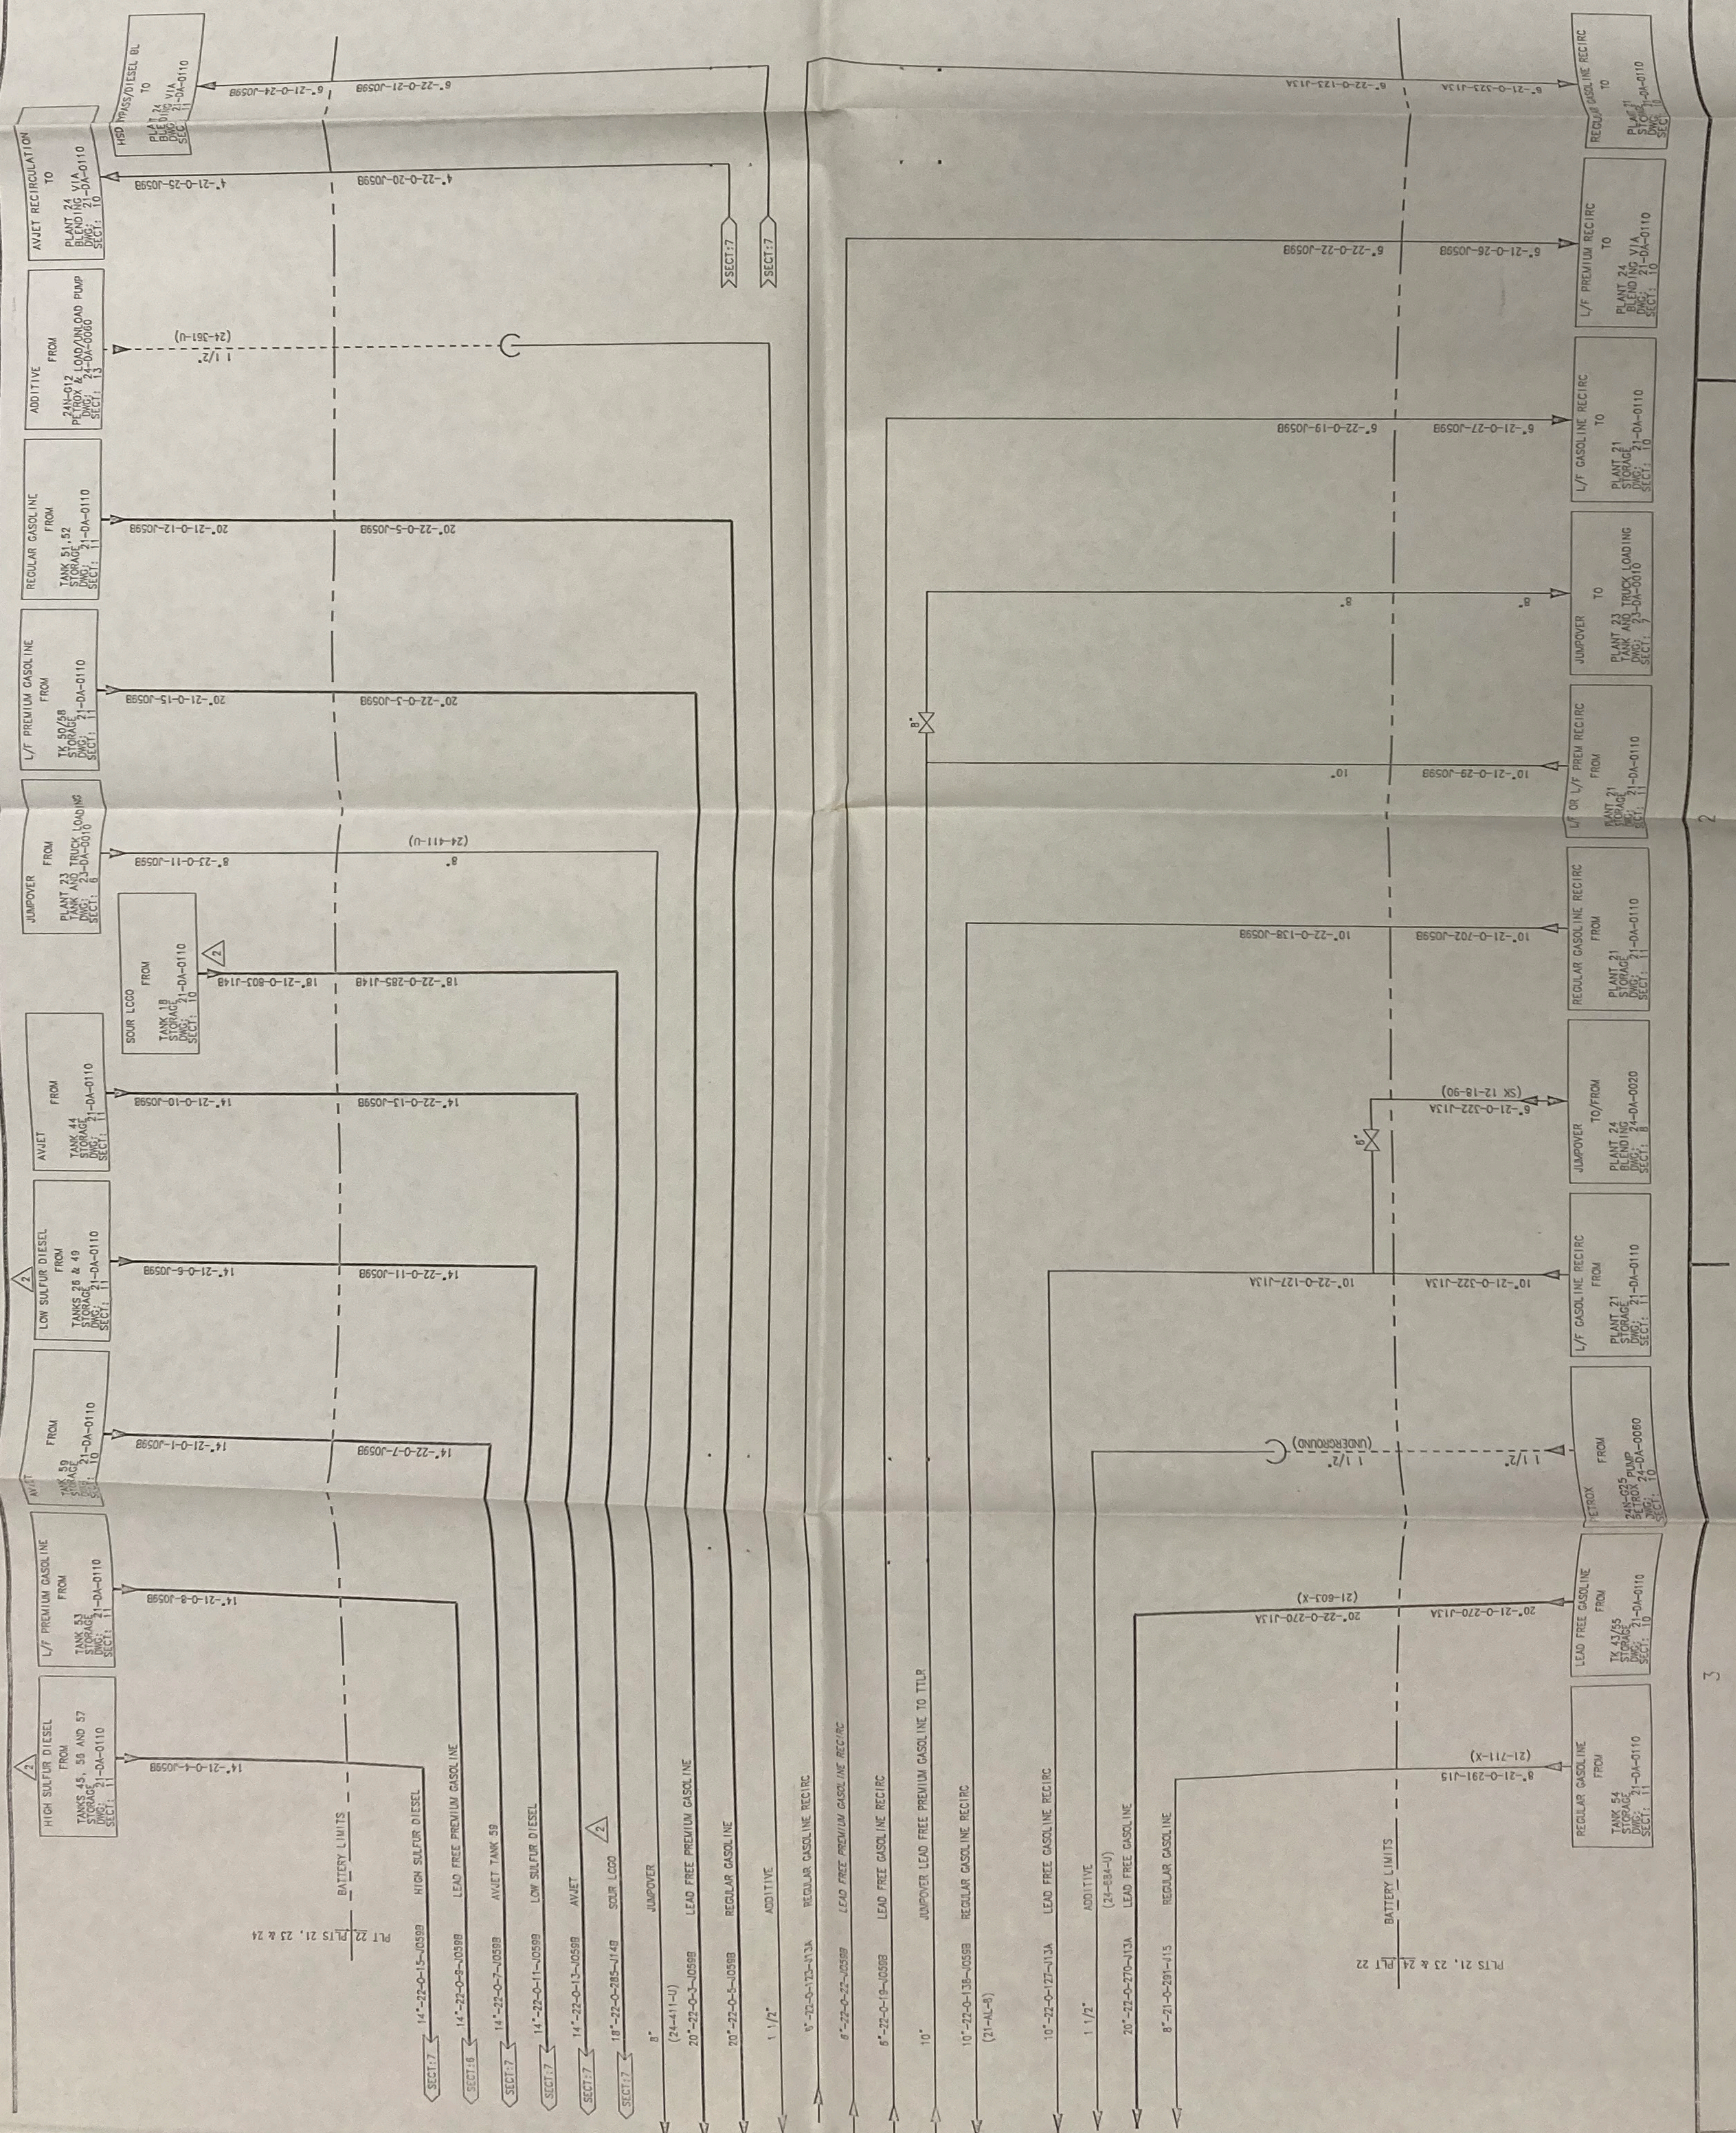



"A" ANCHOR

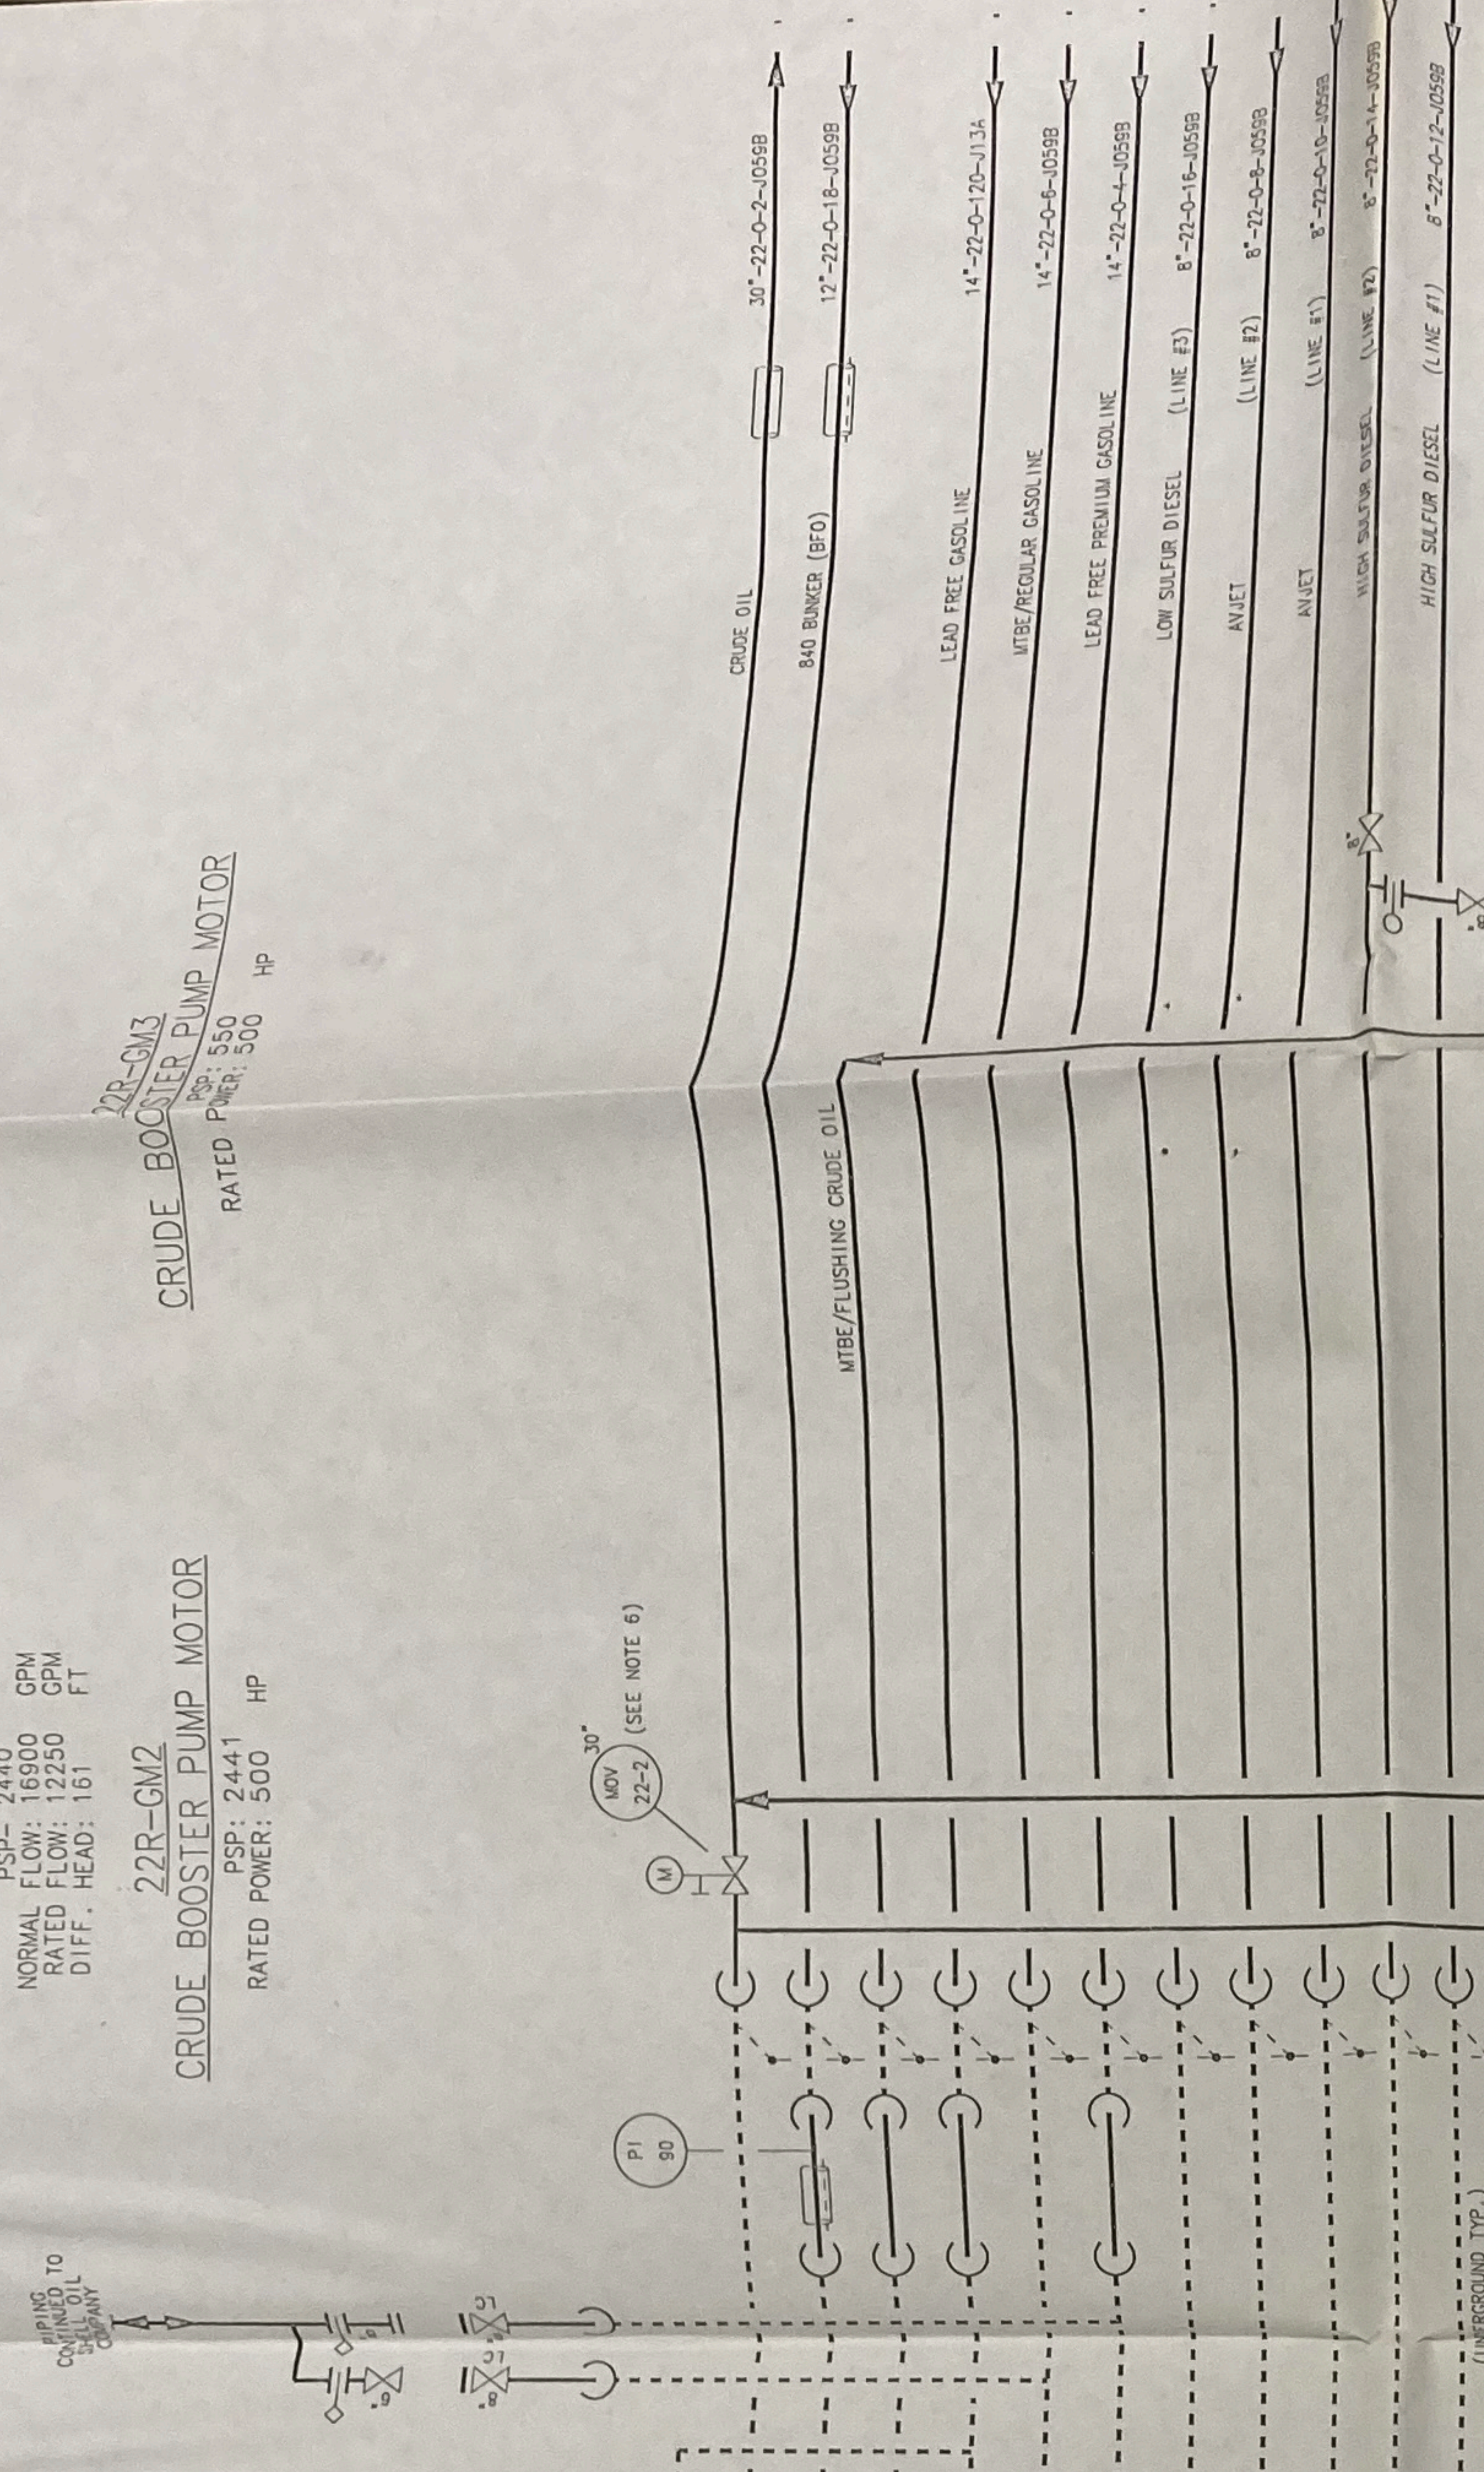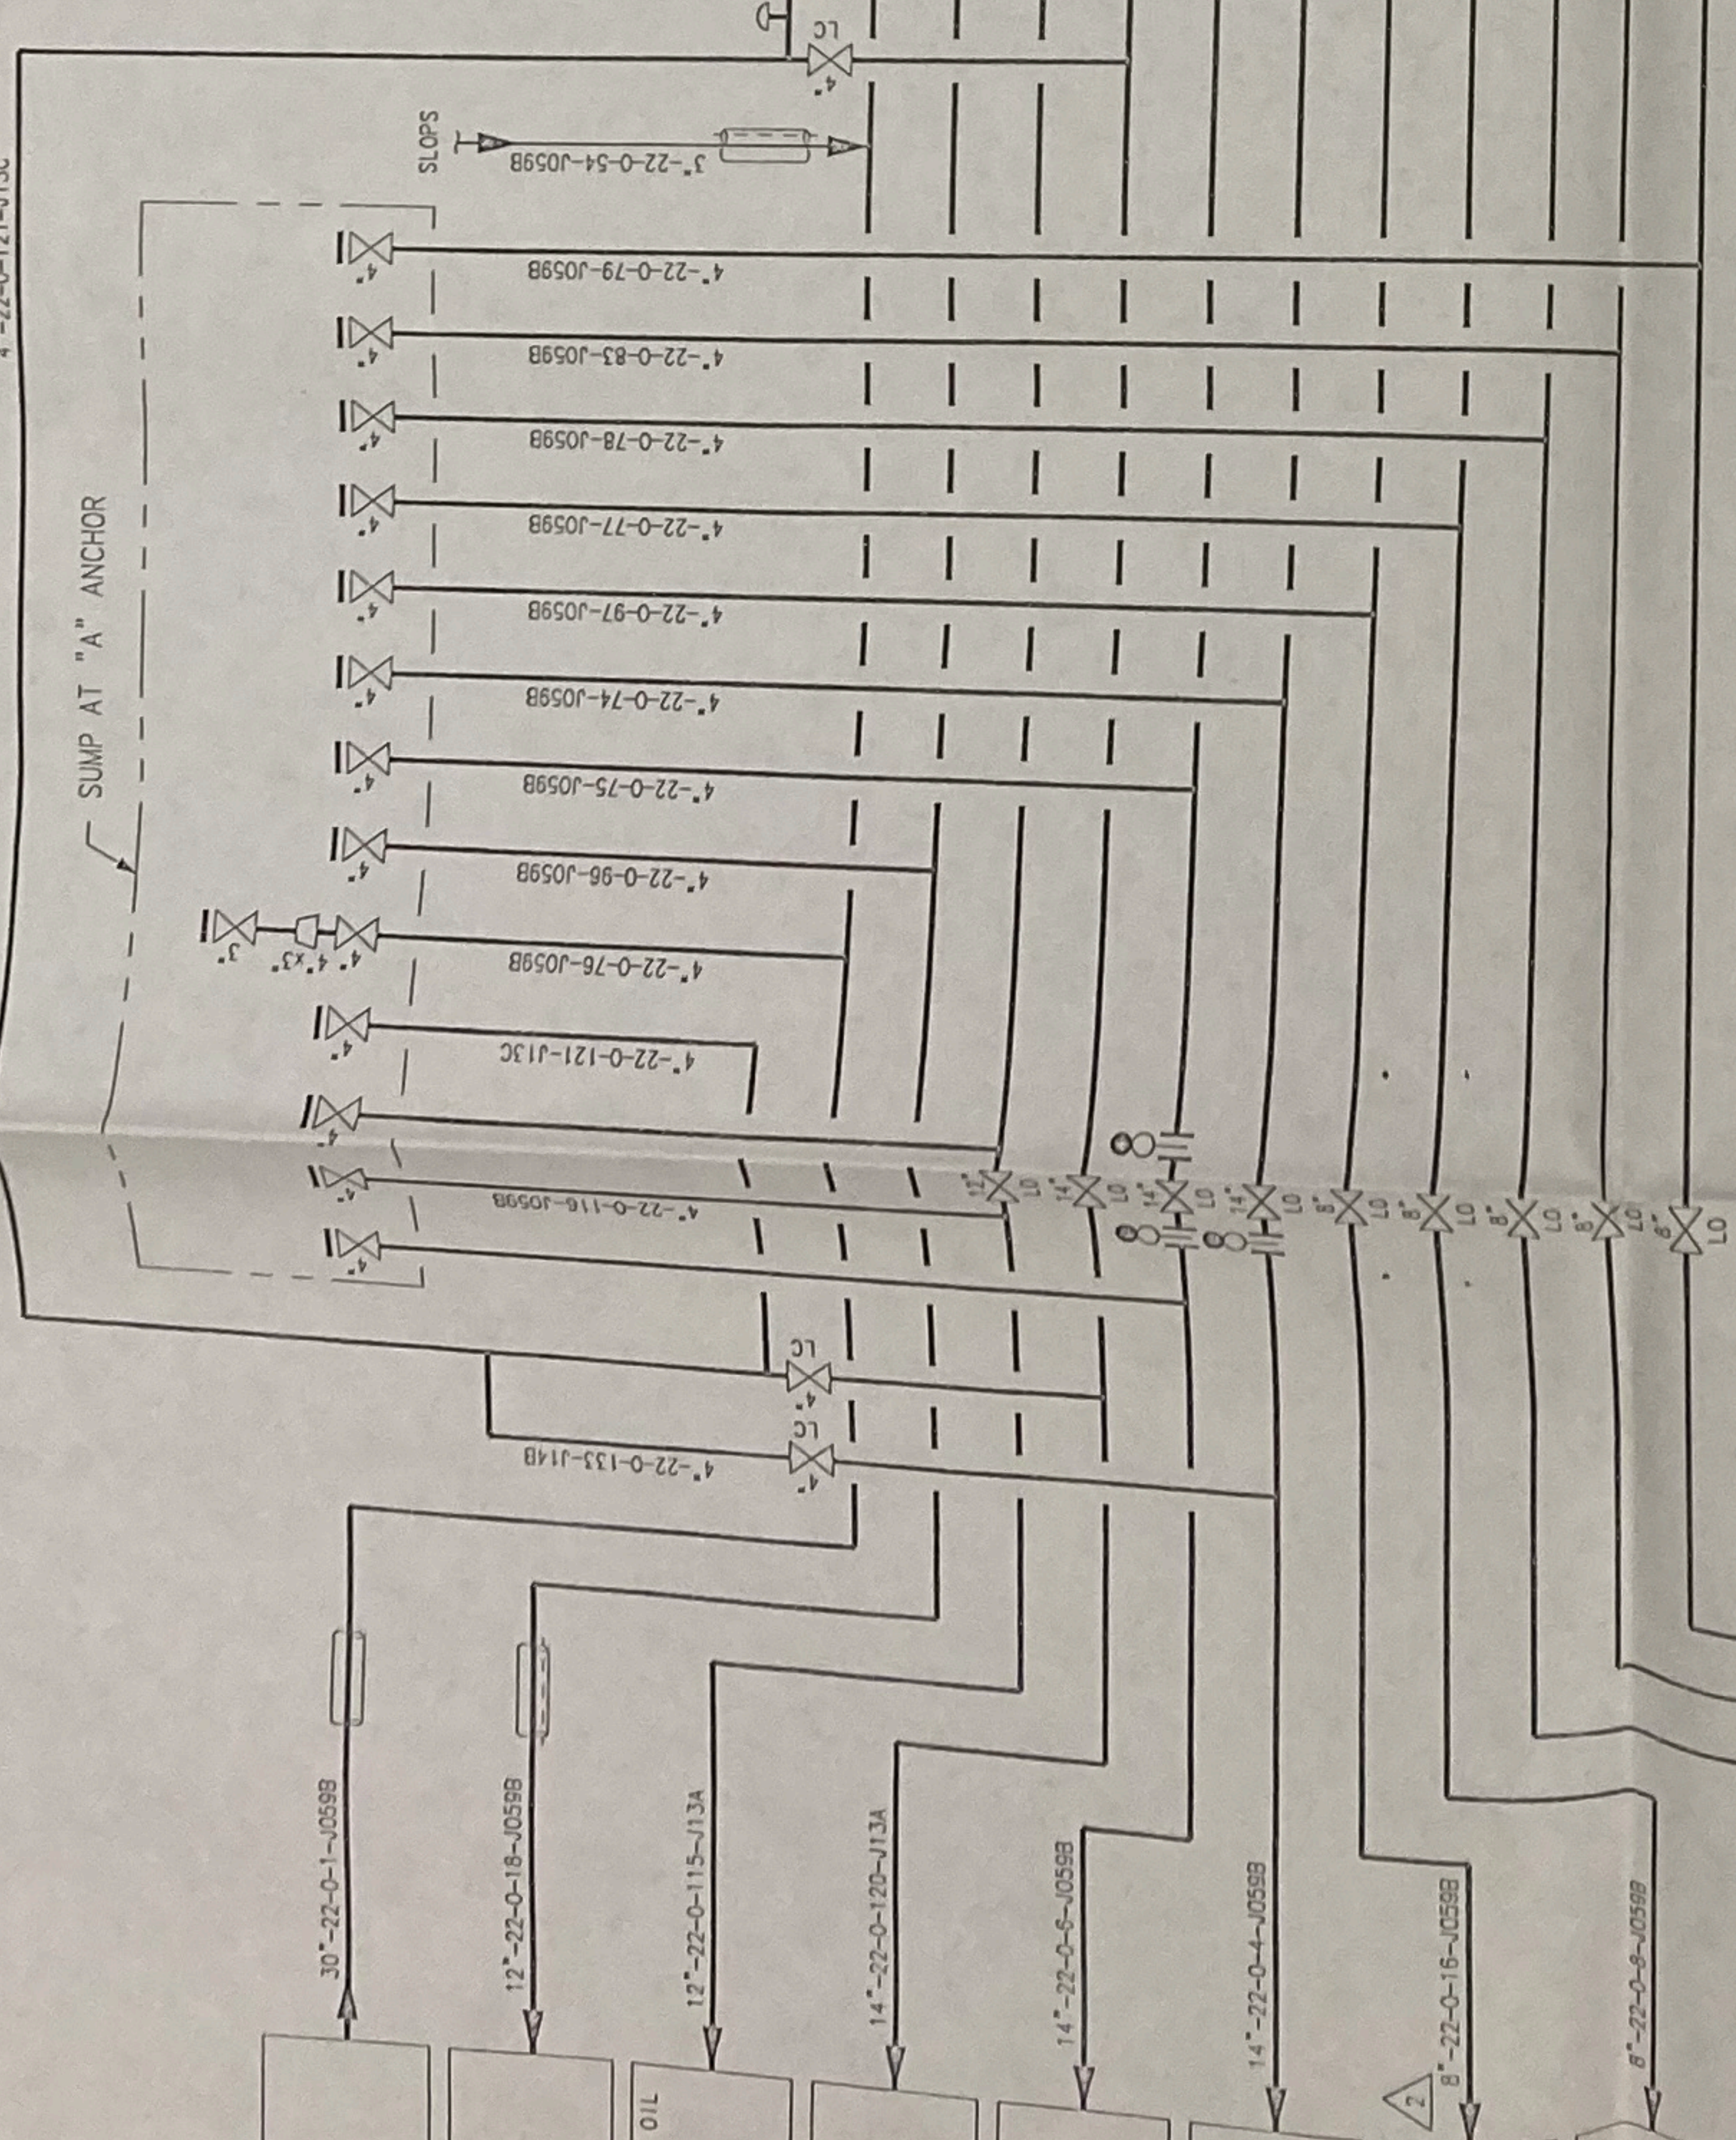

22R-G2  
CRUDE BOOSTER PUMP

PSP- 2440  
NORMAL FLOW: 16900 GPM  
RATED FLOW: 12250 GPM  
DIFF. HEAD: 161 FT

22R-GM2  
CRUDE BOOSTER PUMP MOTOR

PSP: 2441  
RATED POWER: 500 HP

22R-GM3  
CRUDE BOOSTER PUMP MOTOR

PSP: 550  
RATED POWER: 500 HP

CONNECTED TO  
COMPANY

3" x 1/2" SET @ 52 PSIG  
FLUSH

1/2" x 1/2" SET @ 35 PSIG

MOV 121  
AT MOV

MOV 122  
AT MOV

MOV 22-2  
(SEE NOTE 6)

MOV 90

MOV 120

MOV 122

MOV 121



































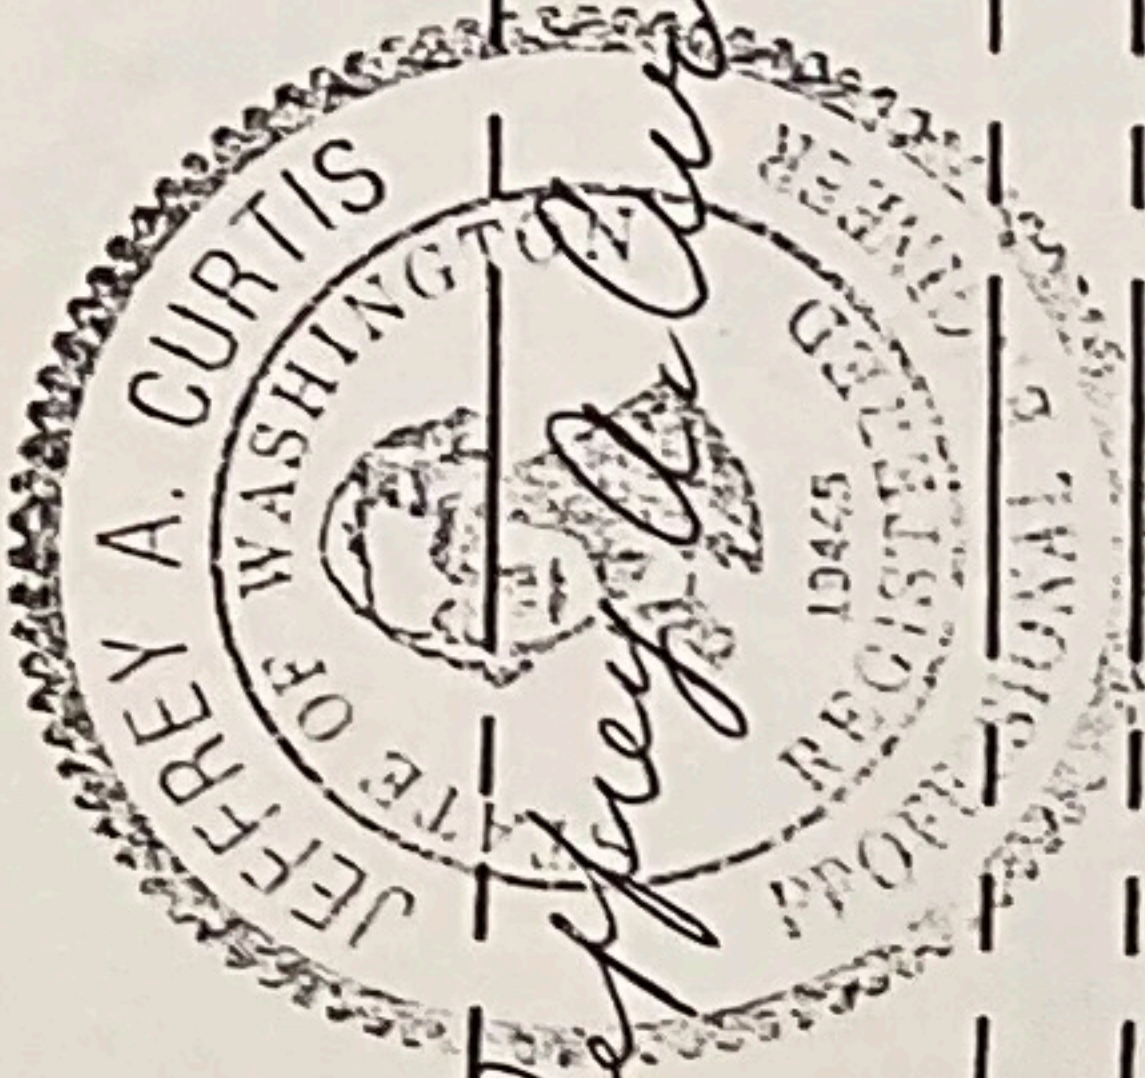


*Jeffrey A. Curtis 7/27/94*

JB21D2

JB21D1

EXPIRES 10/31/95

 

**TEXACO REFINING & MARKETING INC.**  
**PUGET SOUND PLANT ANACORTES, WASHINGTON**

**PLANT 22 - WHARF & LOADING INTERCONNECTION DIAGRAM**  
**MOV121 & MOV122 PB STATIONS**

INITIALS-	DATE	SCALE:	NONE
DWN BY EW	9/15/93	CAD FILE NO.	22BJ0004
CHK BY		DRAWING NO.	
APP'D BY		REV NO	
CHf. ENGR.			

22-BJ-12 3

THIS DRAWING HAS NOT BEEN PUBLISHED. IT IS THE SOLE PROPERTY OF TEXACO REFINING AND MARKETING INC. IT IS LENT TO THE RECIPIENT FOR HIS CONFIDENTIAL USE ONLY, AND UPON THE CONDITION AND AGREEMENTS FOLLOWING, IN CONSIDERATION OF THE LOAN OF THIS DRAWING THE RECIPIENT PROMISES AND AGREES TO RETURN IT UPON REQUEST, AND THAT IT SHALL NOT BE REPRODUCED, COPIED, LENT OR OTHERWISE DISPOSED OF DIRECTLY OR INDIRECTLY WITHOUT WRITTEN CONSENT:

NO.	DATE	DESCRIPTION	REVISIONS
1	4/15/93	AS BUILT	3
2	12/2/93	CHANGED LIGHT COLORS	2
3	11/93	ADDED DISCONNECTS	1
4	9/15/93	ISSUED FOR CONSTRUCTION	0

- NOTES:**
- PERMANENTLY LABEL WIRES USING RAYCHEM TMS SLEEVE SYSTEM (TYPEWRITTEN) OR TEXACO APPROVED EQUAL.
  - PANDUIT #PV18-6F (OR TEXACO APPROVED EQUAL) CRIMP CONNECTORS REQUIRED WHEN TERMINATING WIRES TO FIELD TERMINAL BLOCKS (EXCLUDING J-BOX) WIRE MUST EXTEND 4"-6" FROM THE TERMINAL BLOCK BEFORE LANDING TO INSURE ADEQUATE WORKING ROOM.
  - SEE DWGS. #22-DP-47, #22-DP-48 & #22-DA-0020.

