


## MEMORANDUM

Project No.: 110125

November 24, 2015

**To:** Jessi Massingale, Floyd|Snider Inc  
Megan McCullough, Floyd|Snider Inc

**From:**

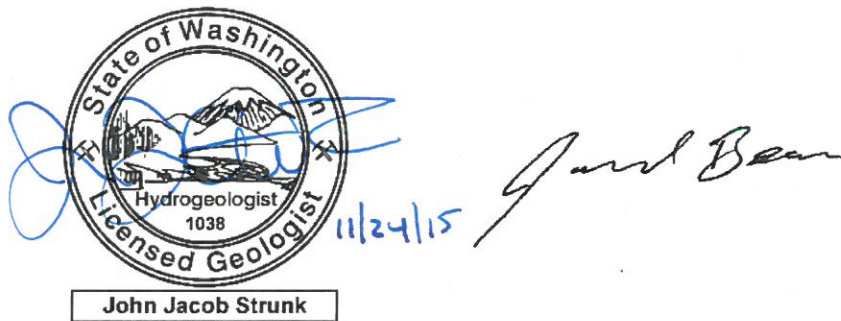

**John Strunk, LHG**  
Senior Associate Geologist  
jstrunk@aspectconsulting.com

**Jared Bean**  
Staff Hydrogeologist  
jbean@aspectconsulting.com

**Re: Updated Lora Lake 2013-2014 Surface Water – Groundwater Baseline Monitoring, Data Summary Memorandum**

This updated memorandum summarizes surface water and groundwater baseline monitoring activities conducted during 2013 and 2014 related to the Port of Seattle's (Port) Lora Lake Parcel (Figure 1). The purpose of the monitoring activities was to obtain data to:

- 1) Advance understanding of the hydraulic functions of Lora Lake and Miller Creek;
- 2) Establish a baseline hydroperiod that the post-remedial action condition can be compared against; and
- 3) Provide the Washington State Department of Ecology (Ecology) with supporting information and a better understanding of water storage, hydraulic function, and flood desynchronization to inform remedial design of the Lora Lake Parcel.

Aspect Consulting LLC (Aspect) provided hydrologic monitoring services as part of a team managed by Floyd|Snider Inc., under contract to the Port. Other team members include Environmental Science Associates and SvR Design Company.

November 24, 2015

Hydrologic monitoring began in June 2013 and ended in November 2014. The attached Tables, Figures, and Appendices (listed at the end of the Memorandum) summarize the data collected.

## **Monitoring Network**

The hydrologic monitoring system stations consisted of a network of wells, mini-piezometers, staff gages, and flow gaging stations. Station locations and monitoring frequency are described below and summarized in Table 2 and Figure 1.

Installation of new monitoring stations was conducted by or coordinated by Aspect. Locations of new monitoring stations were surveyed by Port staff and transmitted to Aspect on July 19, 2013. Pre-existing monitoring stations (e.g., monitoring wells MW-1 through MW-17 upgradient of the Lora Lake Parcel) were previously surveyed and used for groundwater level monitoring and groundwater contour mapping (Figure 2). Invert elevation of the Lora Lake outlet culvert was surveyed by the Port (Port of Seattle, 2009). Locations of existing monitoring stations were previously surveyed. All elevation data reported in this memorandum use the North American Vertical Datum of 1988 (NAVD 88).

Surface water and groundwater monitoring stations within the Lora Lake Parcel were outfitted with dataloggers to record water levels and water temperatures (Figure 5) at 15-minute intervals. Port staff conducted approximately monthly site visits that consisted of manual water level measurements, datalogger downloads, and stream gaging, when appropriate. Groundwater elevations in monitoring wells upgradient of the Lora Lake Parcel were measured quarterly by Aspect.

### ***New Monitoring Stations***

Station purposes are described below.

- **Monitoring well MW-LL-1** was installed on May 25, 2013 by Cascade Drilling. Aspect logged the lithology and developed the well. MW-LL-1 was intended to be completed in wetland soils near the bottom elevation of the lake to evaluate hydraulic conductivity of the wetland soils and therefore enable estimation of groundwater discharge into and out of the lake. However, the boring encountered wetland soils to a depth of only 1 foot below ground surface (bgs) and glacial outwash from 1 foot to 20.5 feet bgs (total depth). MW-LL-1 is screened in glacial outwash sediments from 8 feet to 18 feet bgs; the boring log is provided in Appendix A.
- **Miller Creek staff gages SG-MC-2 and SG-MC-3** were installed in Miller Creek. Port staff conducted stream discharge measurements at the gages, and Aspect developed stage-discharge rating relationships (Tables 6 and 7, Figure 7, Appendix C).
- **Mini-piezometers DP-MC-1A through DP-MC-3B** were driven into the Miller Creek streambed and the adjacent creek bank (see Table 1 below for station locations and total depths). These mini-piezometers, in conjunction with adjacent staff gages (SG-MC-2 and SG-MC-3), were used to evaluate stream flow gaining/losing conditions and surface water-groundwater interactions. The mini-piezometers are 5.75 feet in length and have a drive point tip. The upper 3.8 feet are 2-inch-diameter steel pipes; the lower 1.95 feet are 2-inch-diameter wire-wrap screen. DP-MC-1A and DP-MC-3A experienced repeated siltation and

November 24, 2015

clogging of the screen. Both stations were bailed repeatedly but continued to accumulate silt throughout the baseline monitoring period. Evaluation and use of the DP-MC-1A and DP-MC-3A data should consider the repeated siltation and clogging, as well as the resultant likely erroneously high water elevation data.

**Table 1: Mini-piezometer Locations and Total Depths**

<b>Station ID</b>	<b>Location</b>	<b>Total Depth (feet below ground or streambed surface)</b>
DP-MC-1A	Streambed	3.6
DP-MC-1B	Bank	5.3
DP-MC-2A	Streambed	3.3
DP-MC-2B	Bank	5.0
DP-MC-3A	Streambed	3.4
DP-MC-3B	Bank	4.4

- **Lora Lake staff gage SG-LL-1 and wetland staff gage SG-LL-2** were installed to document seasonal water level variability as well as lake and wetland response to precipitation events (e.g., detention/retention capacity of lake).

***Pre-Existing Monitoring Stations***

Station purposes are described below. Well logs for the monitoring wells listed below are compiled in Appendix B (except for the MW-LL-P1 well log, which the Port staff have been unable to locate).

- **Stream gage SG-MC-1**, operated by King County, is a Miller Creek flow monitoring station upstream of SG-MC-2. Stream stage and discharge data were obtained online from the King County Hydrologic Information Center.
- **Monitoring wells MW-1 through MW-17** are located upgradient of Lora Lake along Des Moines Memorial Drive and within the Lora Lake Apartments Parcel. Water levels in all wells (except MW-13 which was not located in the field) were monitored quarterly. Quarterly water level measurements from MW-1 through MW-14 (excluding MW-13) were used for groundwater contour mapping. The following well pairs allow for calculation of vertical hydraulic gradient: MW-1 and MW-16; MW-5 and MW-15; and MW-4 and MW-17.
- **Mini-piezometers HPA1-1, HPA1-3, and HPA1-4** are completed in shallow soils (maximum total depth of approximately 2 feet bgs) surrounding Lora Lake. These stations were installed by the Port for wetland hydrology and vegetation monitoring. Quarterly water level data from HPA1-3 and HPA1-4 were used for groundwater contour mapping.

November 24, 2015

- **Monitoring wells HC99-B31 and MW-LL-P1** are located in the wetland on the south side of Lora Lake. HC99-B31 is completed below the wetland soils in outwash to a total depth of approximately 25 feet below the bottom of the wetland. As mentioned previously, Port staff have been unable to locate a well log for MW-LL-P1; but it is our understanding that the well is completed in shallow wetland soils to a total depth of approximately 10 feet below the wetland's surface water – soil interface. Continuous water level data were monitored to evaluate surface water – groundwater interactions and Lake – wetland hydraulic functions. Pending confirmation of the MW-LL-P1 completion zone, HC99-B31 and MW-LL-P1 could be used to calculate vertical hydraulic gradient in the vicinity of the wetland.
- **Monitoring wells HC00-B310, HC00-B311, and HC00-B312** are located northeast of Lora Lake. Boring logs suggest that the wells are completed in outwash and/or alluvium. Quarterly water level data were used for groundwater contour mapping.
- **Precipitation as well as storm drain outfall** discharge at the northwest corner of Lora Lake were monitored by CARDNO TEC. These data were compiled to evaluate water balance parameters and understand hydraulic functioning of the lake in response to precipitation events.

### **Lora Lake Outlet Culvert Discharge Estimates**

The Lora Lake outlet culvert connects Lora Lake and Miller Creek. SG-LL-1 monitors Lake stage, and SG-MC-2 monitors Creek stage immediately downstream of the culvert. The culvert is a 1-foot-diameter corrugated plastic pipe. Partial sediment and debris blockage of the Lora Lake outlet culvert was cleared on September 30, 2013.

A standard stage-discharge rating curve is not applicable to Lora Lake outlet culvert because discharge is influenced by both headwater (Lora Lake) and tailwater (Miller Creek) hydraulic conditions. The culvert inlet and outlet invert elevation is 266.80 feet NAVD 88 (Port of Seattle, 2009).

Culvert discharge from Lora Lake to Miller Creek was roughly estimated as the difference in Miller Creek discharge between SG-MC-2 and SG-MC-1. Using this method, estimated culvert discharge during the dry season (low or no precipitation) ranges from approximately 0.1 to 0.5 cubic feet per second (cfs). This range is consistent with area-velocity measurements of culvert discharge (Table 4). For the area-velocity discharge measurements, velocity was measured at the culvert inlet with a SonTek Flowtracker. Flow area at the culvert inlet was estimated as the area of the culvert inlet multiplied by the fraction of the culvert inlet filled with water.

In wetter conditions (during and after precipitation events), use of the aforementioned culvert discharge estimation method is problematic for multiple reasons. For example, complicating factors include:

- At high flows, Miller Creek overtops a low spot in the berm separating Miller Creek and the northeast corner of Lora Lake. Port staff have observed Miller Creek high flows overtopping the berm and flowing into Lora Lake while Lora Lake's outlet culvert discharges back to Miller Creek.

November 24, 2015

- The degree of recording interval synchronization between King County’s SG-MC-1 datalogger and the Port’s SG-MC-2 datalogger has not been evaluated.
- Culvert discharge is dependent on headwater and tailwater conditions, and Lora Lake and Miller Creek exhibit flashy stage changes associated with precipitation events.
- SG-MC-1 and SG-MC-2 are subject to changes in hydraulic controls, especially at high flows; and there are few field flow measurement data points on which to calibrate the upper end of the rating curves.

### Hydraulic Conductivity Analyses

Rising and falling head slug tests were conducted in six wells (MW-LL-1, MW-10, HC99-B31, HC00-B311, HPA1-1, and HPA1-3) to characterize hydraulic conductivity of subsurface materials (Table 3). As mentioned above, MW-LL-1 was intended to be completed and tested in wetland soils (e.g., peat), but the wetland soils extended to only 1 foot bgs. Slug tests of HPA1-1 and HPA1-3 were conducted to better evaluate hydraulic conductivity of the wetland soils.

The Bouwer and Rice method (Bouwer and Rice, 1976; Bouwer, 1989) was used to analyze the slug test data and estimate hydraulic conductivity. Data analysis guidelines from Butler (1998) were also followed. Hydraulic conductivity of MW-LL-1, MW-10, and HC99-B31, completed in slightly silty to trace silt, sand and gravel outwash, ranged from 96 to 263 feet/day. Hydraulic conductivity of HC00-B311, completed in silty sand and sandy silt outwash or alluvium, ranged from 22 to 25 feet/day. Hydraulic conductivity of the HPA1-1 and HPA1-3, presumably completed in shallow wetland soils, ranged from 5 to 12 feet/day.

### Groundwater Contour Mapping

Four rounds of quarterly manual water level measurements were conducted for the entire monitoring network to create groundwater contour maps and evaluate groundwater flow direction and gradient (Figures 2a through 2d). Groundwater flow direction within the monitored area is generally southward toward Lora Lake and Miller Creek. Average groundwater gradients in the shallow aquifer shown on the October 24, 2013 groundwater contour map are:

*Des Moines Memorial Drive to Lora Lake*

$$\frac{275 \text{ feet NAVD 88} - 267 \text{ feet NAVD 88}}{210 \text{ feet}} = 0.04$$

*Des Moines Memorial Drive to Miller Creek*

$$\frac{275 \text{ feet NAVD 88} - 266 \text{ feet NAVD 88}}{590 \text{ feet}} = 0.02$$

Flow direction and gradient showed little seasonal variability.

November 24, 2015

**References**

Bouwer, H., and R. C. Rice, 1976, A slug test for determining hydraulic conductivity of unconfined aquifers with completely or partially penetrating wells. *Water Resources Research* Vol. 12, No. 3, pp. 423-428, 1976.

Bouwer, H., 1989, The Bouwer and Rice slug test--an update, *Ground Water*, Vol. 27, No. 3, pp. 304-309, 1989.

Butler, J. J. Jr., 1998, The design, performance, and analysis of slug tests. Boca Raton, FL: Lewis Publishers, 1998.

Port of Seattle, 2009, Lora Lake Wetland Topo CAD drawing – saved 3/25/2009. Department of Engineers, Survey-Mapping Services, 2009.

**Limitations**

Work for this project was performed for Floyd|Snider Inc. (Client), and this memorandum was prepared in accordance with generally accepted professional practices for the nature and conditions of work completed in the same or similar localities, at the time the work was performed. This memorandum does not represent a legal opinion. No other warranty, expressed or implied, is made.

All reports prepared by Aspect Consulting for the Client apply only to the services described in the Agreement(s) with the Client. Any use or reuse by any party other than the Client is at the sole risk of that party, and without liability to Aspect Consulting. Aspect Consulting’s original files/reports shall govern in the event of any dispute regarding the content of electronic documents furnished to others.

**Attachments**

**List of Tables**

---

Table 1 – Mini-piezometer Locations and Total Depths (in text)

Table 2 – Hydrologic Monitoring Point Inventory

Table 3 – Aquifer Hydraulic Conductivity Estimates from Slug Tests

Table 4 – Lora Lake Outlet Culvert Discharge Measurements

Table 5 (with Figure 4) – Precipitation

Table 6 – SG-MC-2 Stage-Discharge Rating Table

Table 7 – SG-MC-3 Stage-Discharge Rating Table

November 24, 2015

## MEMORANDUM

Project No.: 110125

### List of Figures

---

Figure 1 – Site Map

Figure 2a – Groundwater Elevation Contour Map – October 24, 2013

Figure 2b – Groundwater Elevation Contour Map – January 23, 2014

Figure 2c – Groundwater Elevation Contour Map – May 1, 2014

Figure 2d – Groundwater Elevation Contour Map – July 29, 2014

Figure 3 – Water Temperature

Figure 4 – Precipitation

Figure 5 – Groundwater Interactions with Lora Lake

Figure 6 – Overall Surface Water and Groundwater Interactions

Figure 7 – Stage-Discharge Rating Curves (SG-MC-2 and SG-MC-3)

Figure 8 – Miller Creek Flows

Figure 9 – Surface Water and Groundwater Interactions with Miller Creek

### List of Appendices

---

Appendix A – MW-LL-1 Well Log

Appendix B – Well Logs of Pre-Existing Monitoring Stations

Appendix C – Lora Lake 15-min and daily data \_with graphs.xlsx (Microsoft Excel File)

W:\110125 Lora Lake RI-FS Support\Deliverables\Data Summary Memo\UPDATED Lora Lake Data Summary Memo\_final.docm

# **TABLES**



## Table 2 - Hydrologic Monitoring Point Inventory

Project No. 110125, Lora Lake RI/FS  
Burien, WA

Surface Water Monitoring Points					
Station Name	Location	Installed prior to June 2013	Installed in June 2013 by Aspect	Monitoring frequency	
				15-Minute <sup>1</sup>	Quarterly <sup>2</sup>
SG-MC-1	Miller Creek	X		X	
SG-MC-2	Miller Creek		X	X	
SG-MC-3	Miller Creek		X	X	
SG-LL-1	Lora Lake		X	X	
SG-LL-2	Wetland		X	X	

Groundwater Monitoring Points					
Station Name	Location	Installed prior to June 2013	Installed in June 2013 by Aspect	Monitoring frequency	
				15-Minute <sup>1</sup>	Quarterly <sup>2</sup>
MW-1	Lora Lake Apartments	X			X
MW-2	Lora Lake Apartments	X			X
MW-3	Lora Lake Apartments	X			X
MW-4	Lora Lake Apartments	X			X
MW-5	Lora Lake Apartments	X			X
MW-6	Lora Lake Apartments	X			X
MW-7	Des Moines Memorial Drive	X			X
MW-8	Des Moines Memorial Drive	X			X
MW-9	Des Moines Memorial Drive	X			X
MW-10	Des Moines Memorial Drive	X			X
MW-11	Des Moines Memorial Drive	X			X
MW-12	Lora Lake Apartments	X			X
MW-13	Lora Lake Apartments	X			X
MW-14	Lora Lake Apartments	X			X
MW-15	Lora Lake Apartments	X			X
MW-16	Lora Lake Apartments	X			X
MW-17	Lora Lake Apartments	X			X
HPA1-1 <sup>3</sup>	Bank of Lora Lake	X		X	
HPA1-3	Bank of Lora Lake	X		X	
HPA1-4	Bank of Lora Lake	X		X	
HC99-B31	Wetland	X		X	
HC00-B310	East of Lora Lake	X			X
HC00-B311	East of Lora Lake	X			X
HC00-B312	North of Lora Lake	X			X
MW-LL-P1	Wetland	X		X	
MW-LL-1	North of Lora Lake		X	X	
DP-MC-1A	Miller Creek		X	X	
DP-MC-1B	Bank of Miller Creek		X	X	
DP-MC-2A	Miller Creek		X	X	
DP-MC-2B	Bank of Miller Creek		X	X	
DP-MC-3A	Miller Creek		X	X	
DP-MC-3B	Bank of Miller Creek		X	X	

<sup>1</sup> 15-minute pressure transducer datalogger measurements; approximately monthly downloads and manual measurements.

<sup>2</sup> Quarterly manual measurements.

<sup>3</sup> 15-minute data not compiled by Aspect; quarterly data compiled.

**Table 3 - Aquifer Hydraulic Conductivity Estimates from Slug Tests**

Project No. 110125, Lora Lake RI/FS  
Burien, WA

Monitoring Well	MW-LL-1		MW-10		HC99-B31		HC00-B311		HPA1-1		HPA1-3	
Well Depth in Feet	16		20		24		17		2		2	
Screen Length in Feet	10		10		10		10		1.5		1.5	
Depth to Screen in Feet	6		10		15		7		0.5		0.5	
Depth to Aquitard in Feet	25		25		25		25		25		25	
Depth to Water in Feet	2.7		13.5		-1.5		10.0		-0.5		0.5	
Depth to Sandpack in Feet	4		8		14		6		0.5		0.5	
Slug Displacement (H <sub>0</sub> ) in Feet	0.50	0.76	0.87	0.44	0.29	0.46	0.45	0.44	0.50	0.50	0.14	0.14
Porosity (n)	0.20		0.20		0.20		0.20		0.20		0.20	
Radius of Casing (r <sub>c</sub> ) in Feet	0.08		0.08		0.08		0.08		0.08		0.08	
Radius of Borehole (r <sub>w</sub> ) in Feet	0.18		0.18		0.18		0.18		0.09		0.09	
Saturated Aquifer Thickness (H) in Feet	22		12		27		15		26		25	
Saturated Well Thickness (L <sub>w</sub> ) in Feet	13		7		27		7		3		2	
Effective Radius (r <sub>eff</sub> ) in Feet	0.18		0.18		0.18		0.18		0.09		0.09	
Effective Screen Length (L <sub>s</sub> ) in Feet	10.0		6.5		10.0		7.0		1.5		1.5	
Rising/Falling Head Test	Falling	Rising	Rising	Rising	Falling	Rising	Falling	Rising	Falling	Falling	Falling	Falling
Fully Submerged Sandpack	Yes	Yes	No	No	Yes	Yes	No	No	Yes	Yes	No	No
Transiently Exposed Sandpack	No	No	Yes	Yes	No	No	Yes	No	No	No	No	No
Transiently Exposed Screen	No	No	Yes	Yes	No	No	Yes	No	No	No	No	No
Partially Submerged Screen	No	No	Yes	Yes	No	No	Yes	No	No	No	No	No
<b>Bouwer and Rice Parameters</b>												
Normalized Head at t <sub>1</sub> (y <sub>1</sub> ) in Feet	0.70	0.69	0.68	0.69	0.66	0.69	0.70	0.70	0.79	0.70	0.70	0.65
Time - t <sub>1</sub> in Seconds	2	1.60	1.00	0.88	1.50	1.13	5.25	7.88	8.62	11.87	20.60	19.50
Normalized Head at t <sub>2</sub> (y <sub>2</sub> ) in Feet	0.40	0.40	0.39	0.41	0.40	0.40	0.40	0.41	0.49	0.40	0.40	0.40
Time - t <sub>2</sub> in Seconds	4	3.70	2.37	1.87	3.50	3.00	16.38	19.63	25.75	32.25	60.40	53.10
L <sub>s</sub> /r <sub>w</sub>	55.6		36.1		55.6		38.9		16.7		16.7	
Coefficient A <sup>a</sup>	3.2		2.6		3.2		2.7		2.0		2.0	
Coefficient B <sup>a</sup>	0.5		0.4		0.5		0.4		0.3		0.3	
Coefficient C <sup>a</sup>	2.8		2.2		2.8		2.3		1.4		1.4	
ln(R <sub>s</sub> /r <sub>w</sub> ) <sup>b</sup>	2.9		2.4		3.4		2.4		1.8		1.6	
<b>Calculated K in cm/sec</b>	0.03	0.04	0.07	0.1	0.04	0.05	0.01	0.01	0.004	0.004	0.002	0.002
<b>Calculated K in ft/day</b>	96	103	206	263	119	139	25	22	12	11	5	5
<b>Screened Interval Soil Type</b>	<b>GP-GM, SP</b>		<b>SW, SP</b>		<b>SP-SM</b>		<b>SM, ML</b>		<b>(not logged)</b>		<b>(not logged)</b>	

Notes:

Hydraulic conductivity estimates from the Bouwer and Rice method (Bouwer and Rice, 1976; Bouwer, 1989).

Data analysis guidelines from Butler (1998).

Bold values are entered from field data and other values are calculated.

All depths are below ground surface.

<sup>a</sup> A, B, and C coefficients are calculated using regression equations of Van Rooy (1988).

<sup>b</sup> R<sub>s</sub>/r<sub>w</sub> is the effective radial distance over which y is dissipated, divided by the radial distance of well development.

cm/sec = centimeters per second

ft/day = feet per day

# Table 4 - Lora Lake Outlet Culvert Discharge Measurements

Project No.110125, Lora Lake RI/FS  
Burien, WA

Date <sup>1</sup>	Stage (ft)	Elevation (ft)	Approximate fraction culvert full	Flowtracker inlet velocity (ft/s)	Discharge estimate <sup>2</sup> (cfs)
10/1/2013	2.10	267.55	0.75	0.95	0.6
11/19/2013	2.26	267.71	0.91	1.44	1.0
2/20/2014	2.22	267.67	0.87	0.63	0.4
3/6/2014	3.00	268.45	1.00	1.58	1.2
5/1/2014	1.74	267.19	0.39	0.52	0.2
5/15/2014	1.62	267.07	0.27	0.37	0.1
7/29/2014	1.66	267.11	0.31	0.75	0.2
SG-LL-1 top elevation (NAVD 88 feet) <sup>3</sup>		268.78		Min	0.1
Culvert bottom elevation (NAVD 88 feet) <sup>4</sup>		266.80		Max	1.2

Notes:

<sup>1</sup> Lora Lake outlet culvert cleared of debris on 9/30/2013.

<sup>2</sup> Discharge estimate = (Flowtrack velocity)\*πr<sup>2</sup>\*(fraction culvert full).

<sup>3</sup> Survey data from Port of Seattle; data received by email on 7/19/2013.

<sup>4</sup> Survey data from Port of Seattle survey document created 3/25/2009.

cfs = cubic feet per second

ft = feet

ft/s = feet per second

## Table 6 - SG-MC-2 Stage-Discharge Rating Table

Project No. 110125, Lora Lake RI/FS  
Burien, WA

Stage (ft)	Discharge (cfs)		Stage (ft)	Discharge (cfs)		Stage (ft)	Discharge (cfs)		Stage (ft)	Discharge (cfs)
3.41	0.31	B	3.74	0.81		4.07	2.15		4.40	9.60
3.42	0.32	B	3.75	0.83		4.08	2.21		4.41	9.83
3.43	0.34	B	3.76	0.85		4.09	2.28		4.46	11.00
3.44	0.35	B	3.77	0.86		4.10	2.35		4.51	12.19
3.45	0.36	B	3.78	0.88		4.11	2.47		4.56	13.16
3.46	0.37	B	3.79	0.90		4.12	2.59		4.61	14.17
3.47	0.38	B	3.80	0.92		4.13	2.71		4.66	15.19
3.48	0.39	B	3.81	0.95		4.14	2.84		4.71	16.14
3.49	0.40	B	3.82	0.99		4.15	2.97		4.76	17.11
3.50	0.41	B	3.83	1.03		4.16	3.11		4.81	18.10
3.51	0.43	B	3.84	1.06		4.17	3.25		4.86	19.12
3.52	0.44	B	3.85	1.10		4.18	3.39		4.91	20.15
3.53	0.46	B	3.86	1.14		4.19	3.54			
3.54	0.47	B	3.87	1.17		4.20	3.70			
3.55	0.49	B	3.88	1.21		4.21	3.97			
3.56	0.50	B	3.89	1.25		4.22	4.26			
3.57	0.51	B	3.90	1.29		4.23	4.56			
3.58	0.53	B	3.91	1.33		4.24	4.88			
3.59	0.54	B	3.92	1.37		4.25	5.60			
3.60	0.55	B	3.93	1.41		4.26	5.90			
3.61	0.57	B	3.94	1.45		4.27	6.20			
3.62	0.58		3.95	1.49		4.28	6.52			
3.63	0.60		3.96	1.54		4.29	6.85			
3.64	0.62		3.97	1.58		4.30	7.20			
3.65	0.64		3.98	1.62		4.31	7.42			
3.66	0.66		3.99	1.67		4.32	7.64			
3.67	0.68		4.00	1.71		4.33	7.87			
3.68	0.69		4.01	1.77		4.34	8.11			
3.69	0.71		4.02	1.83		4.35	8.34			
3.70	0.73		4.03	1.89		4.36	8.59			
3.71	0.75		4.04	1.95		4.37	8.83			
3.72	0.77		4.05	2.02		4.38	9.08			
3.73	0.79		4.06	2.08		4.39	9.34			

Notes:

ft = feet

cfs = cubic feet per second

A = above rating, reliable estimate (within one-half of the lowest measured flow)

B = below rating, reliable estimate (within two times the highest measured flow)

J = unreliable estimate (less than one-half the lowest or greater than two times the highest measured flow)

# Table 7 - SG-MC-3 Stage-Discharge Rating Table

Project No. 110125, Lora Lake RI/FS  
 Burien, WA

Stage (ft)	Discharge (cfs)	Stage (ft)	Discharge (cfs)	Stage (ft)	Discharge (cfs)	Stage (ft)	Discharge (cfs)
3.94	0.40 B	4.27	0.86	4.60	1.84	4.93	3.54
3.95	0.41 B	4.28	0.88	4.61	1.87	4.94	3.62
3.96	0.42 B	4.29	0.91	4.62	1.90	4.99	4.04
3.97	0.43 B	4.30	0.93	4.63	1.94	5.04	4.50
3.98	0.44 B	4.31	0.95	4.64	1.97	5.09	5.07
3.99	0.45 B	4.32	0.97	4.65	2.00	5.14	5.70
4.00	0.46 B	4.33	1.00	4.66	2.04	5.19	6.39
4.01	0.47 B	4.34	1.02	4.67	2.09	5.24	7.14
4.02	0.49 B	4.35	1.04	4.68	2.13	5.29	7.96
4.03	0.50 B	4.36	1.07	4.69	2.17	5.34	8.84
4.04	0.51 B	4.37	1.09	4.70	2.22	5.39	9.80
4.05	0.52 B	4.38	1.12	4.71	2.26	5.44	10.70
4.06	0.53 B	4.39	1.14	4.72	2.31	5.49	11.63
4.07	0.54 B	4.40	1.17	4.73	2.36	5.54	12.62
4.08	0.55 B	4.41	1.19	4.74	2.40	5.59	13.67
4.09	0.57	4.42	1.22	4.75	2.45	5.64	14.77
4.10	0.58	4.43	1.25	4.76	2.50	5.69	15.67
4.11	0.59	4.44	1.27	4.77	2.55	5.74	16.54
4.12	0.60	4.45	1.30	4.78	2.61	5.79	17.43
4.13	0.62	4.46	1.33	4.79	2.66	5.84	18.35
4.14	0.63	4.47	1.37	4.80	2.71	5.89	19.30
4.15	0.65	4.48	1.40	4.81	2.77	5.94	20.28
4.16	0.66	4.49	1.43	4.82	2.83	5.99	21.29
4.17	0.68	4.50	1.47	4.83	2.88	6.04	22.49
4.18	0.70	4.51	1.51	4.84	2.94	6.09	23.78
4.19	0.71	4.52	1.54	4.85	3.00	6.14	25.11
4.20	0.73	4.53	1.58	4.86	3.06	6.19	26.49
4.21	0.75	4.54	1.62	4.87	3.12	6.24	27.92
4.22	0.77	4.55	1.65	4.88	3.18		
4.23	0.78	4.56	1.69	4.89	3.24		
4.24	0.80	4.57	1.73	4.90	3.30		
4.25	0.82	4.58	1.77	4.91	3.38		
4.26	0.84	4.59	1.81	4.92	3.46		

Notes:

ft = feet


cfs = cubic feet per second

A = above rating, reliable estimate (within one-half of the lowest measured flow)

B = below rating, reliable estimate (within two times the highest measured flow)

J = unreliable estimate (less than one-half the lowest or greater than two times the highest measured flow)

# FIGURES

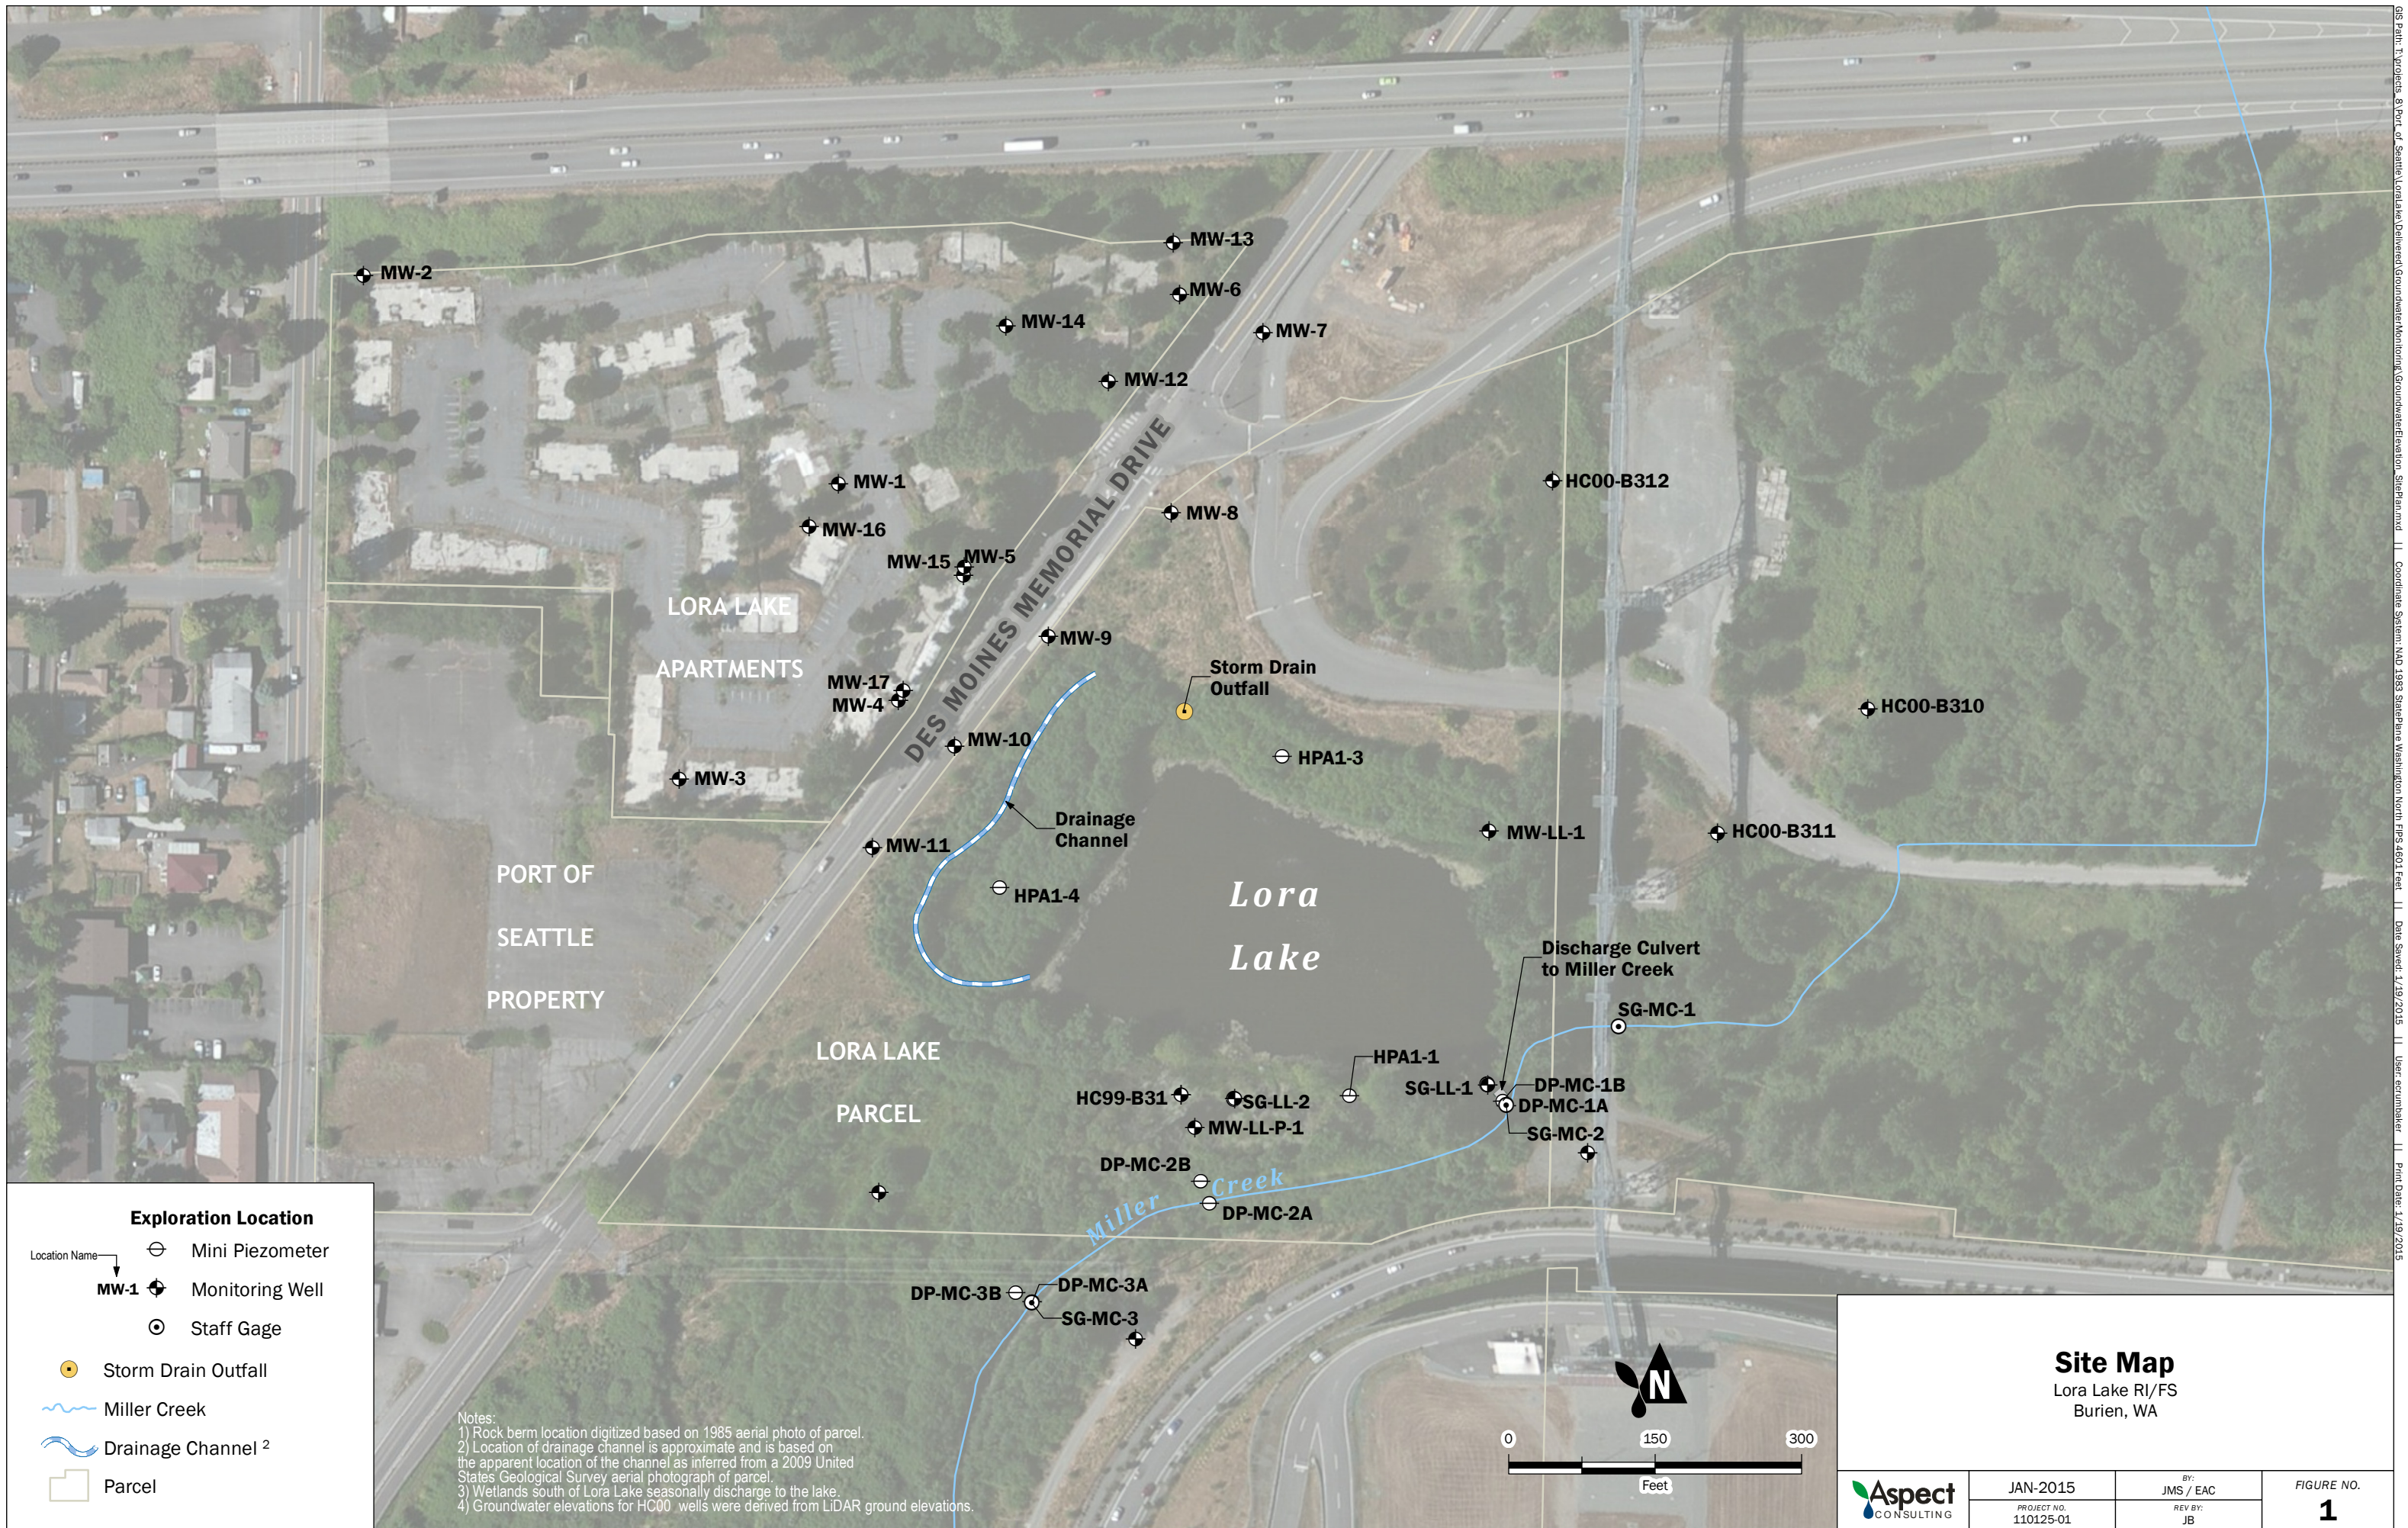

**Exploration Location**

Location Name


- ⊖ Mini Piezometer
- MW-1 ⊕ Monitoring Well
- ⊙ Staff Gage
- Storm Drain Outfall
- ~ Miller Creek
- ~ Drainage Channel <sup>2</sup>
- ▭ Parcel

Notes:

- 1) Rock berm location digitized based on 1985 aerial photo of parcel.
- 2) Location of drainage channel is approximate and is based on the apparent location of the channel as inferred from a 2009 United States Geological Survey aerial photograph of parcel.
- 3) Wetlands south of Lora Lake seasonally discharge to the lake.
- 4) Groundwater elevations for HC00 wells were derived from LIDAR ground elevations.

**Site Map**  
Lora Lake RI/FS  
Burien, WA

	JAN-2015	BY: JMS / EAC	<b>FIGURE NO.</b> <b>1</b>
	PROJECT NO. 110125-01	REV BY: JB	

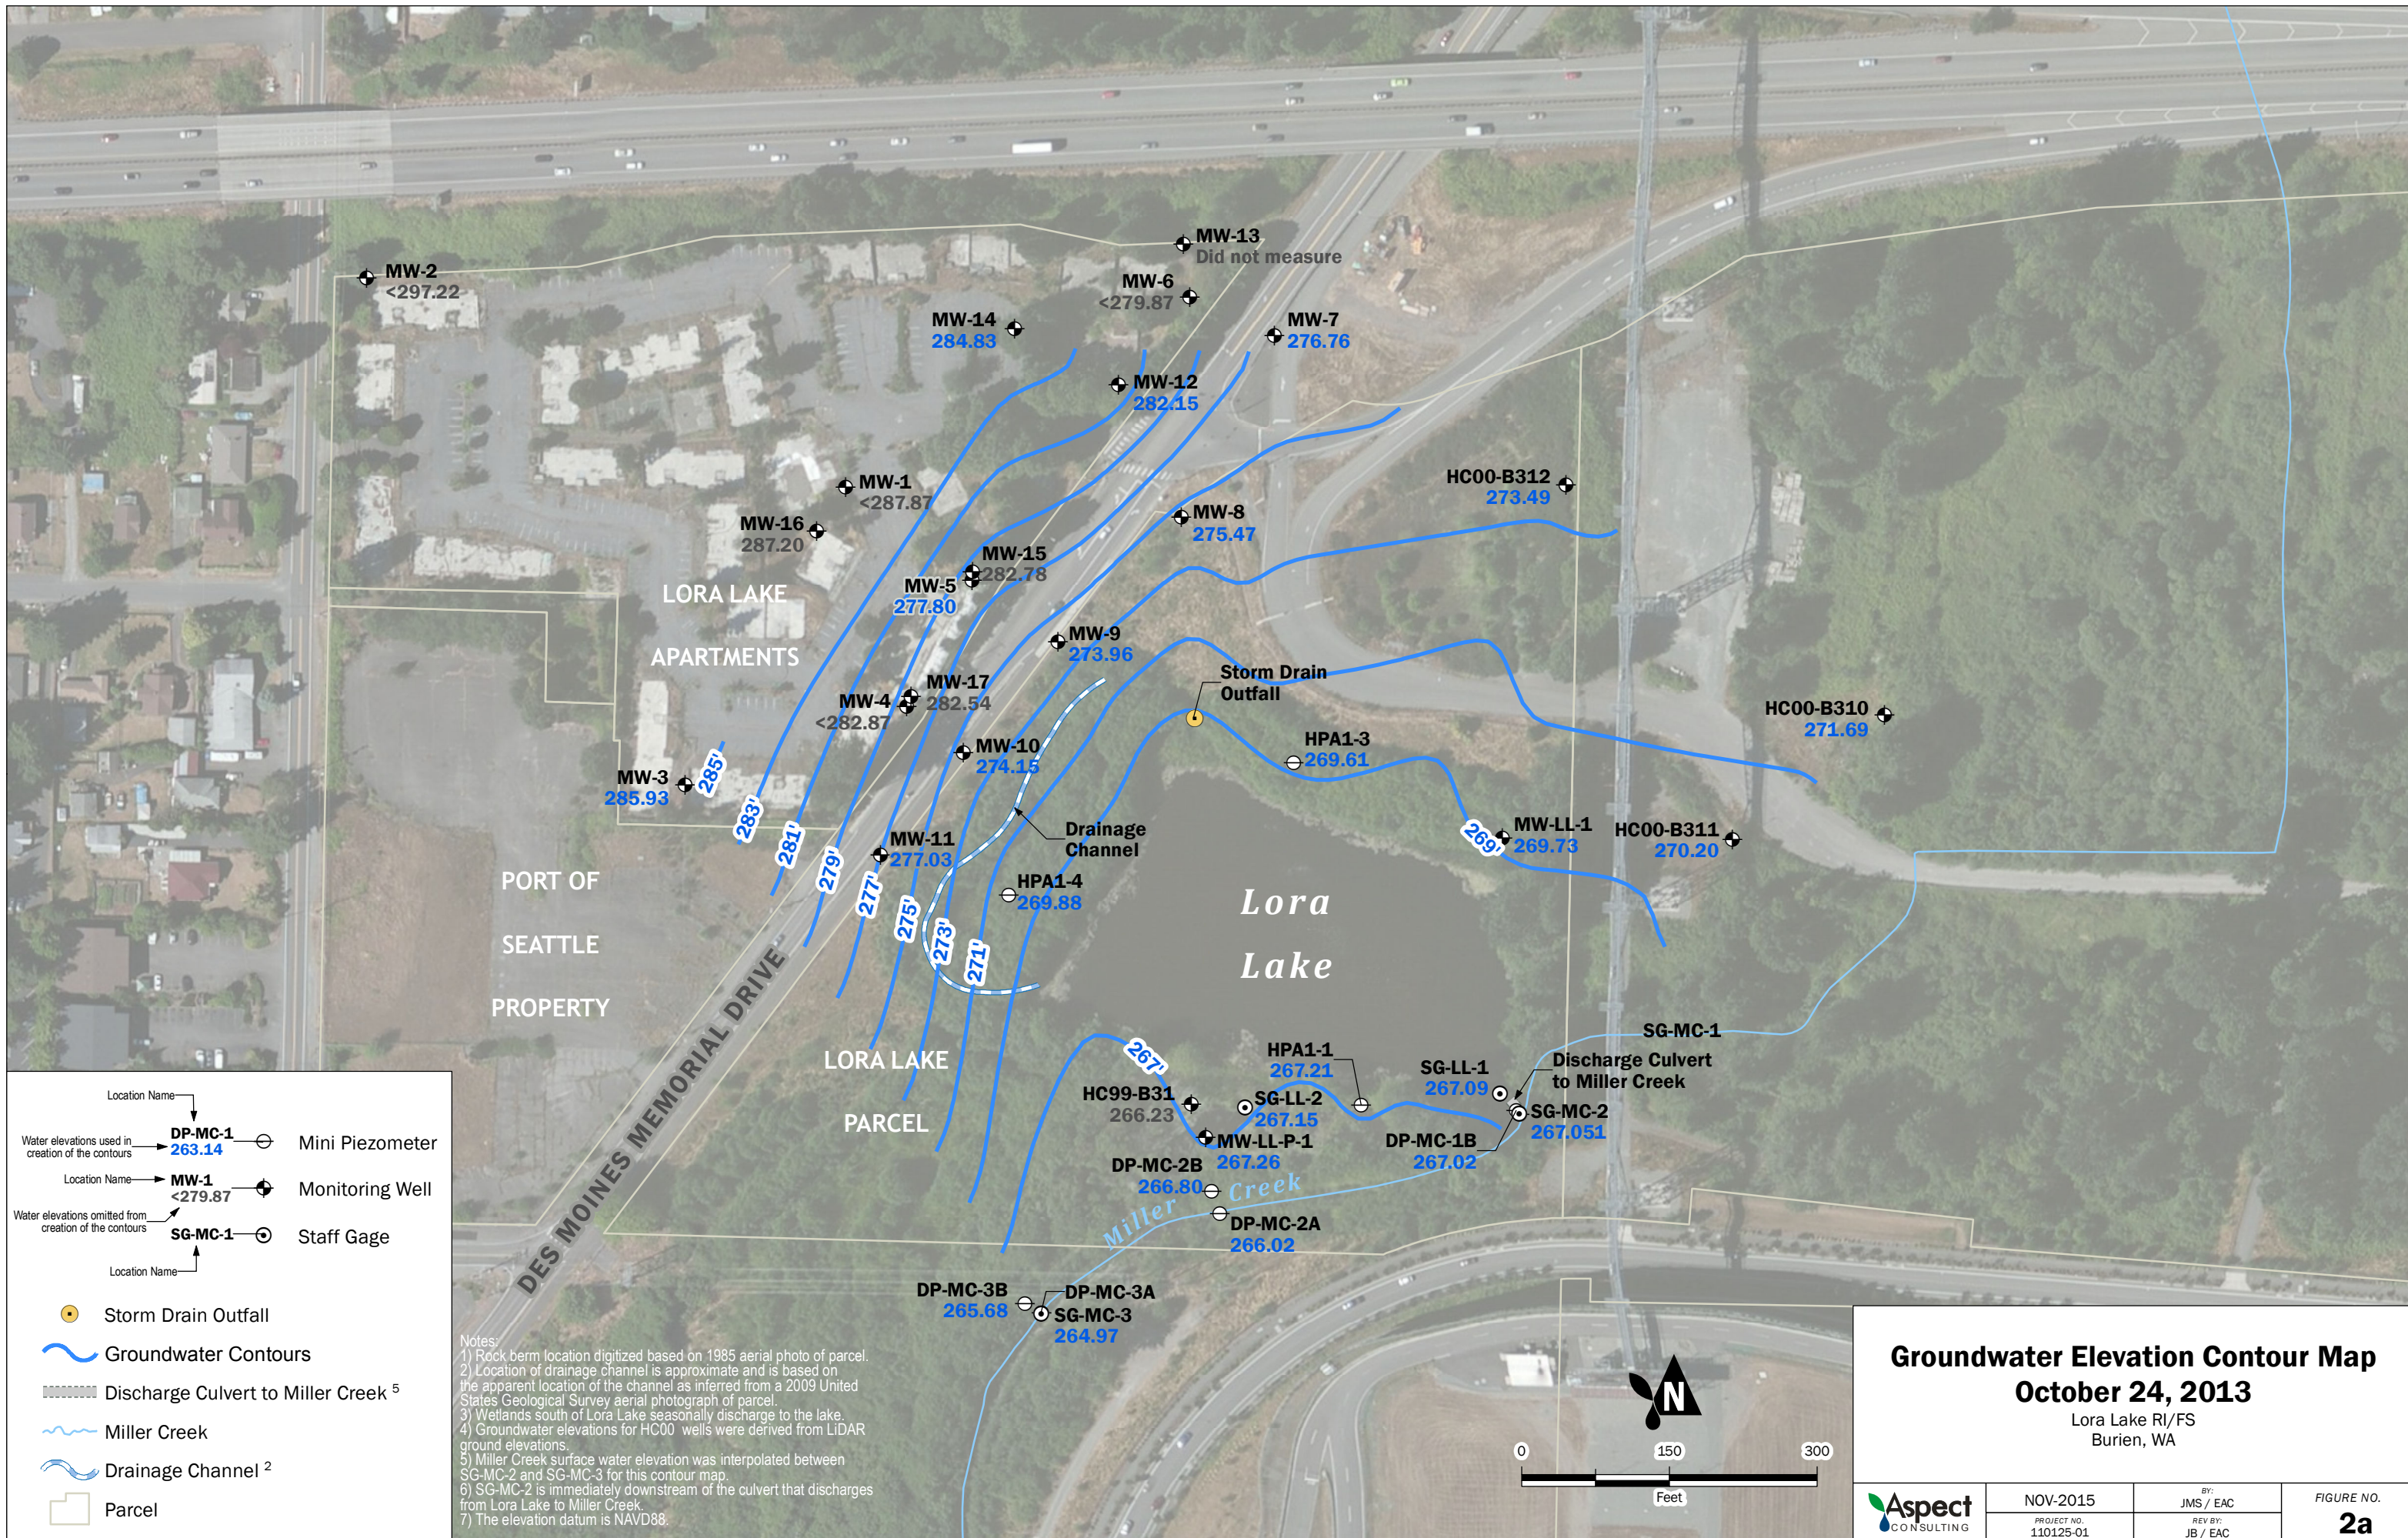

Location Name → **DP-MC-1** 263.14 ⊕ Mini Piezometer

Location Name → **MW-1** <279.87 ⊕ Monitoring Well

Water elevations omitted from creation of the contours → **SG-MC-1** ⊕ Staff Gage

Location Name → ⊙ Storm Drain Outfall

Groundwater Contours

Discharge Culvert to Miller Creek <sup>5</sup>

Miller Creek

Drainage Channel <sup>2</sup>

Parcel

Notes:

- 1) Rock berm location digitized based on 1985 aerial photo of parcel.
- 2) Location of drainage channel is approximate and is based on the apparent location of the channel as inferred from a 2009 United States Geological Survey aerial photograph of parcel.
- 3) Wetlands south of Lora Lake seasonally discharge to the lake.
- 4) Groundwater elevations for HC00 wells were derived from LIDAR ground elevations.
- 5) Miller Creek surface water elevation was interpolated between SG-MC-2 and SG-MC-3 for this contour map.
- 6) SG-MC-2 is immediately downstream of the culvert that discharges from Lora Lake to Miller Creek.
- 7) The elevation datum is NAVD88.

### Groundwater Elevation Contour Map


October 24, 2013

Lora Lake RI/FS  
Burien, WA


	NOV-2015	BY: JMS / EAC	FIGURE NO. <b>2a</b>
	PROJECT NO. 110125-01	REV BY: JB / EAC	


GIS Path: \\projects.gis\Port of Seattle\LoraLake\Deliverables\GroundwaterMonitoring\November2013\Figures\GroundwaterElevation\_Oct2013.mxd || Coordinate System: NAD 1983 StatePlane Washington North FIPS 4601 Feet || Date Saved: 11/19/2015 || User: ecumshaker || Print Date: 11/19/2015



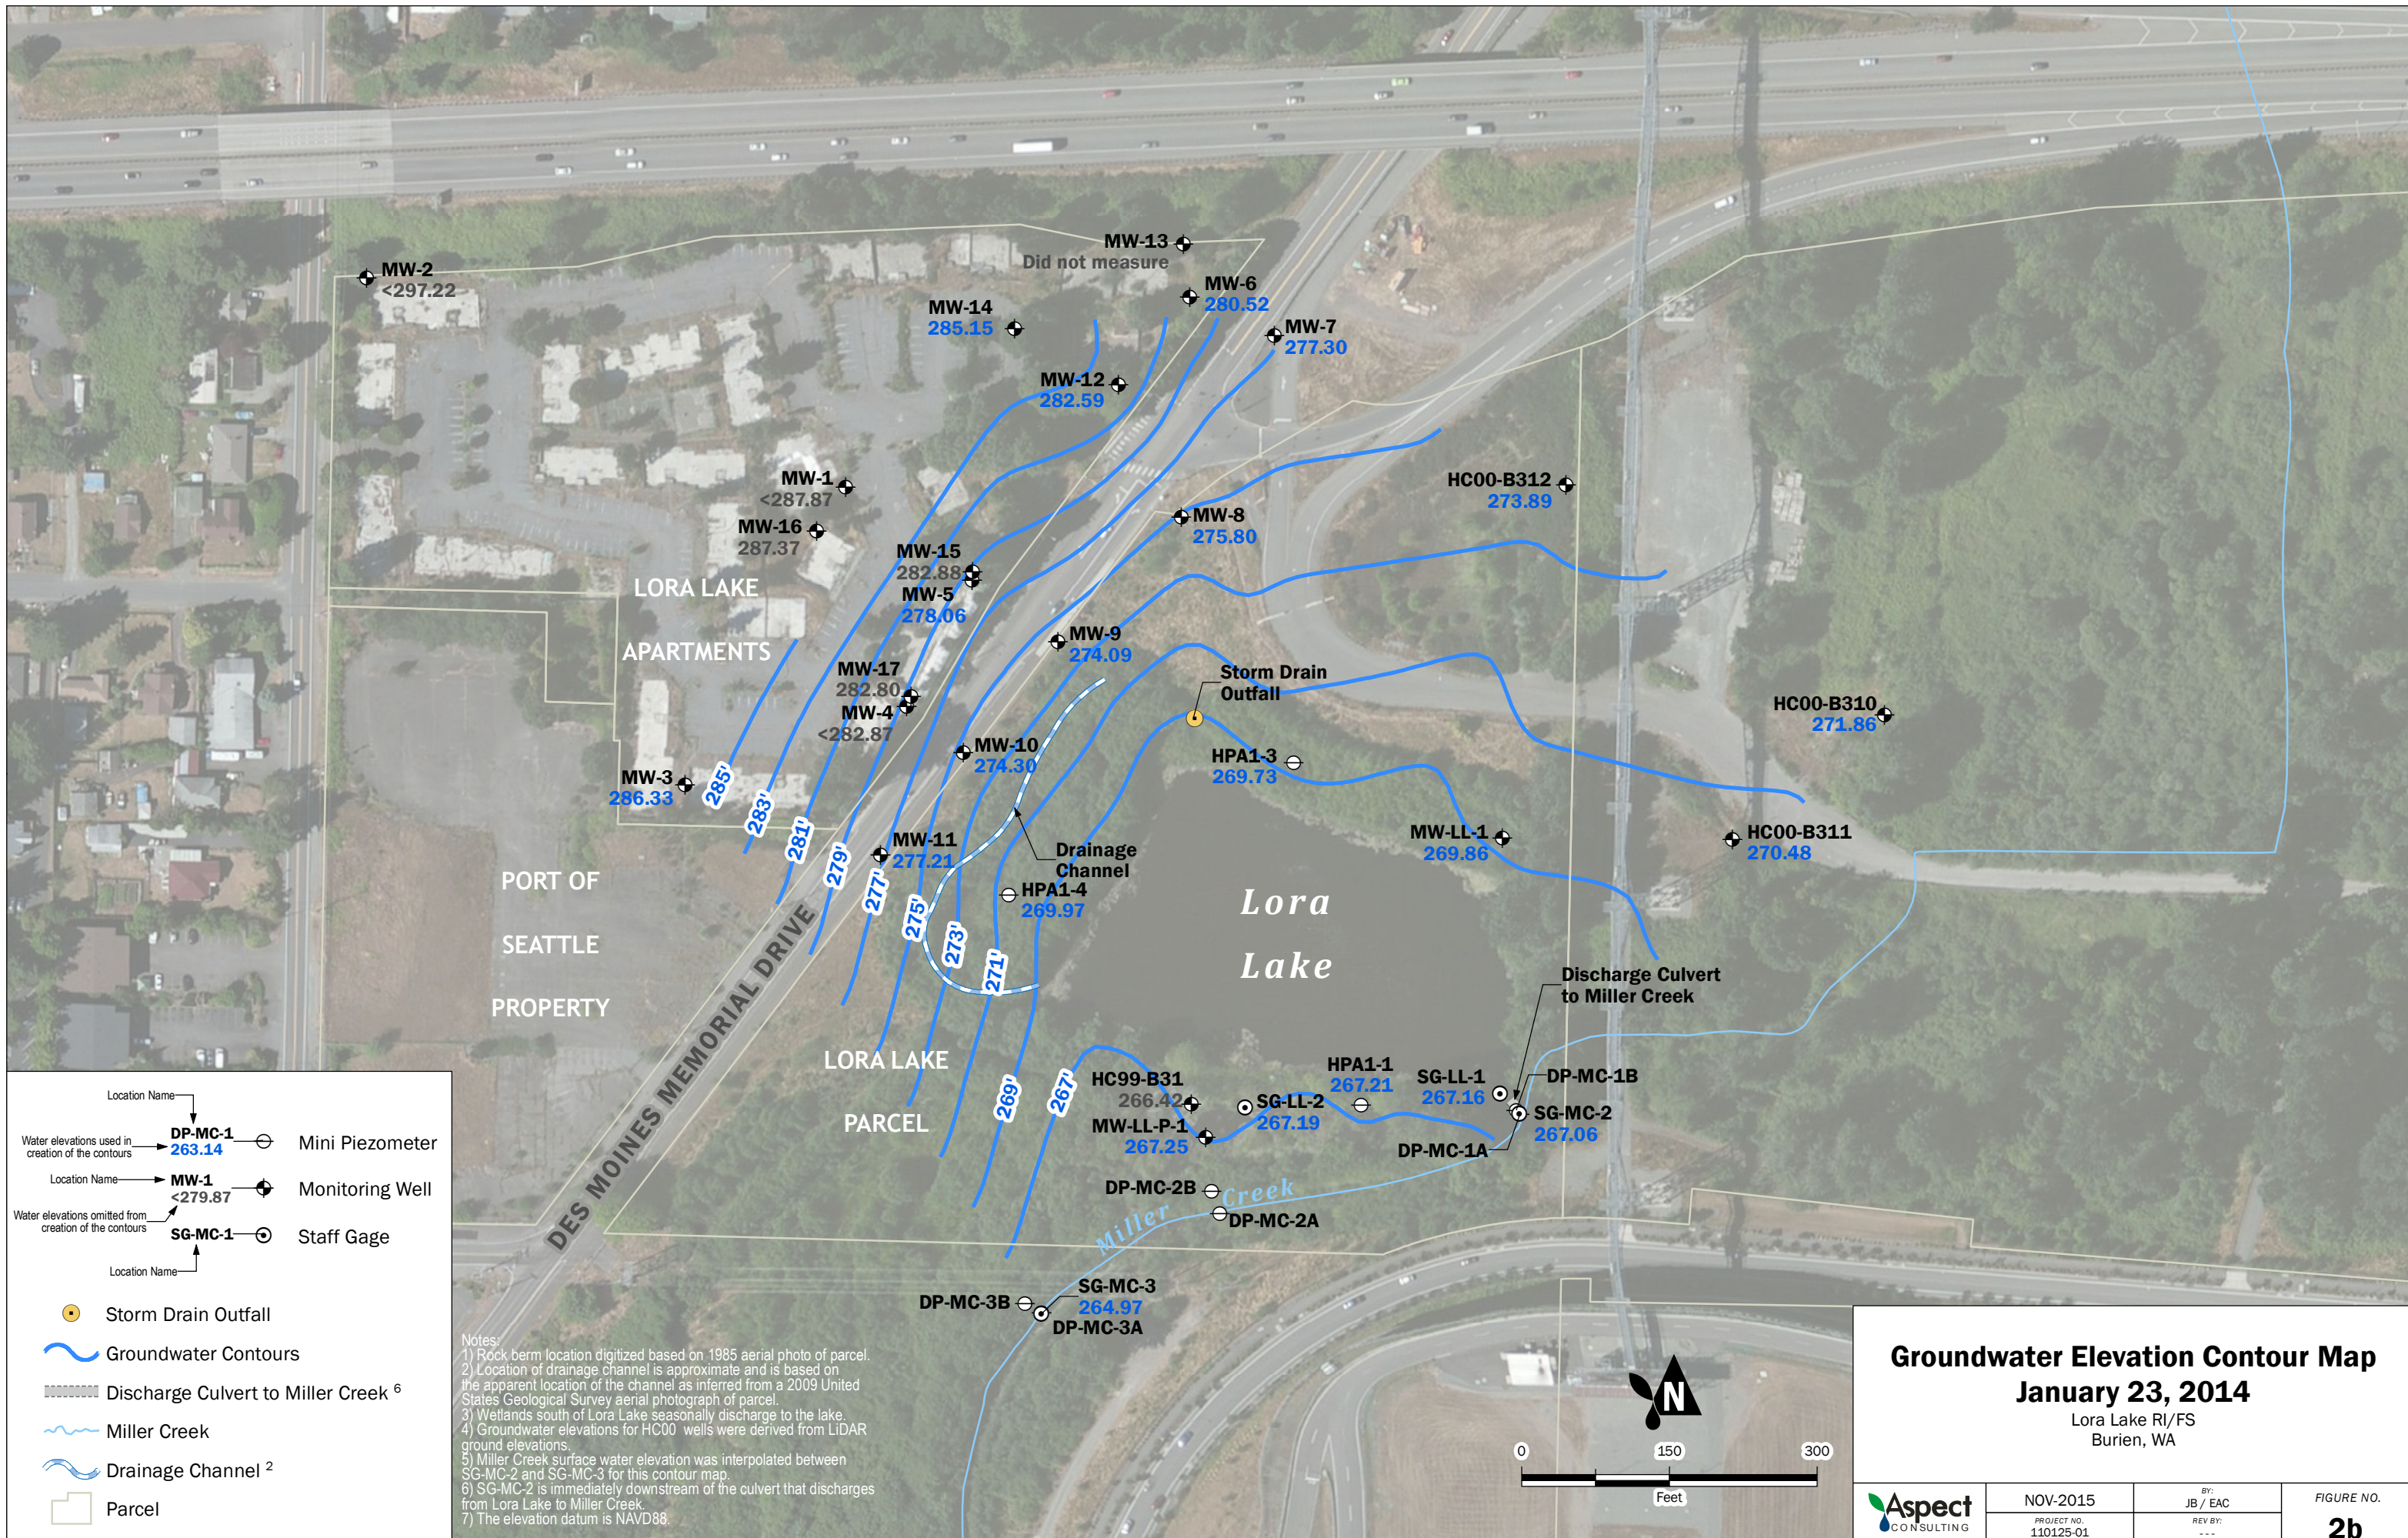

Notes:  
 1) Rock berm location digitized based on 1985 aerial photo of parcel.  
 2) Location of drainage channel is approximate and is based on the apparent location of the channel as inferred from a 2009 United States Geological Survey aerial photograph of parcel.  
 3) Wetlands south of Lora Lake seasonally discharge to the lake.  
 4) Groundwater elevations for HC00 wells were derived from LiDAR ground elevations.  
 5) Miller Creek surface water elevation was interpolated between SG-MC-2 and SG-MC-3 for this contour map.  
 6) SG-MC-2 is immediately downstream of the culvert that discharges from Lora Lake to Miller Creek.  
 7) The elevation datum is NAVD88.

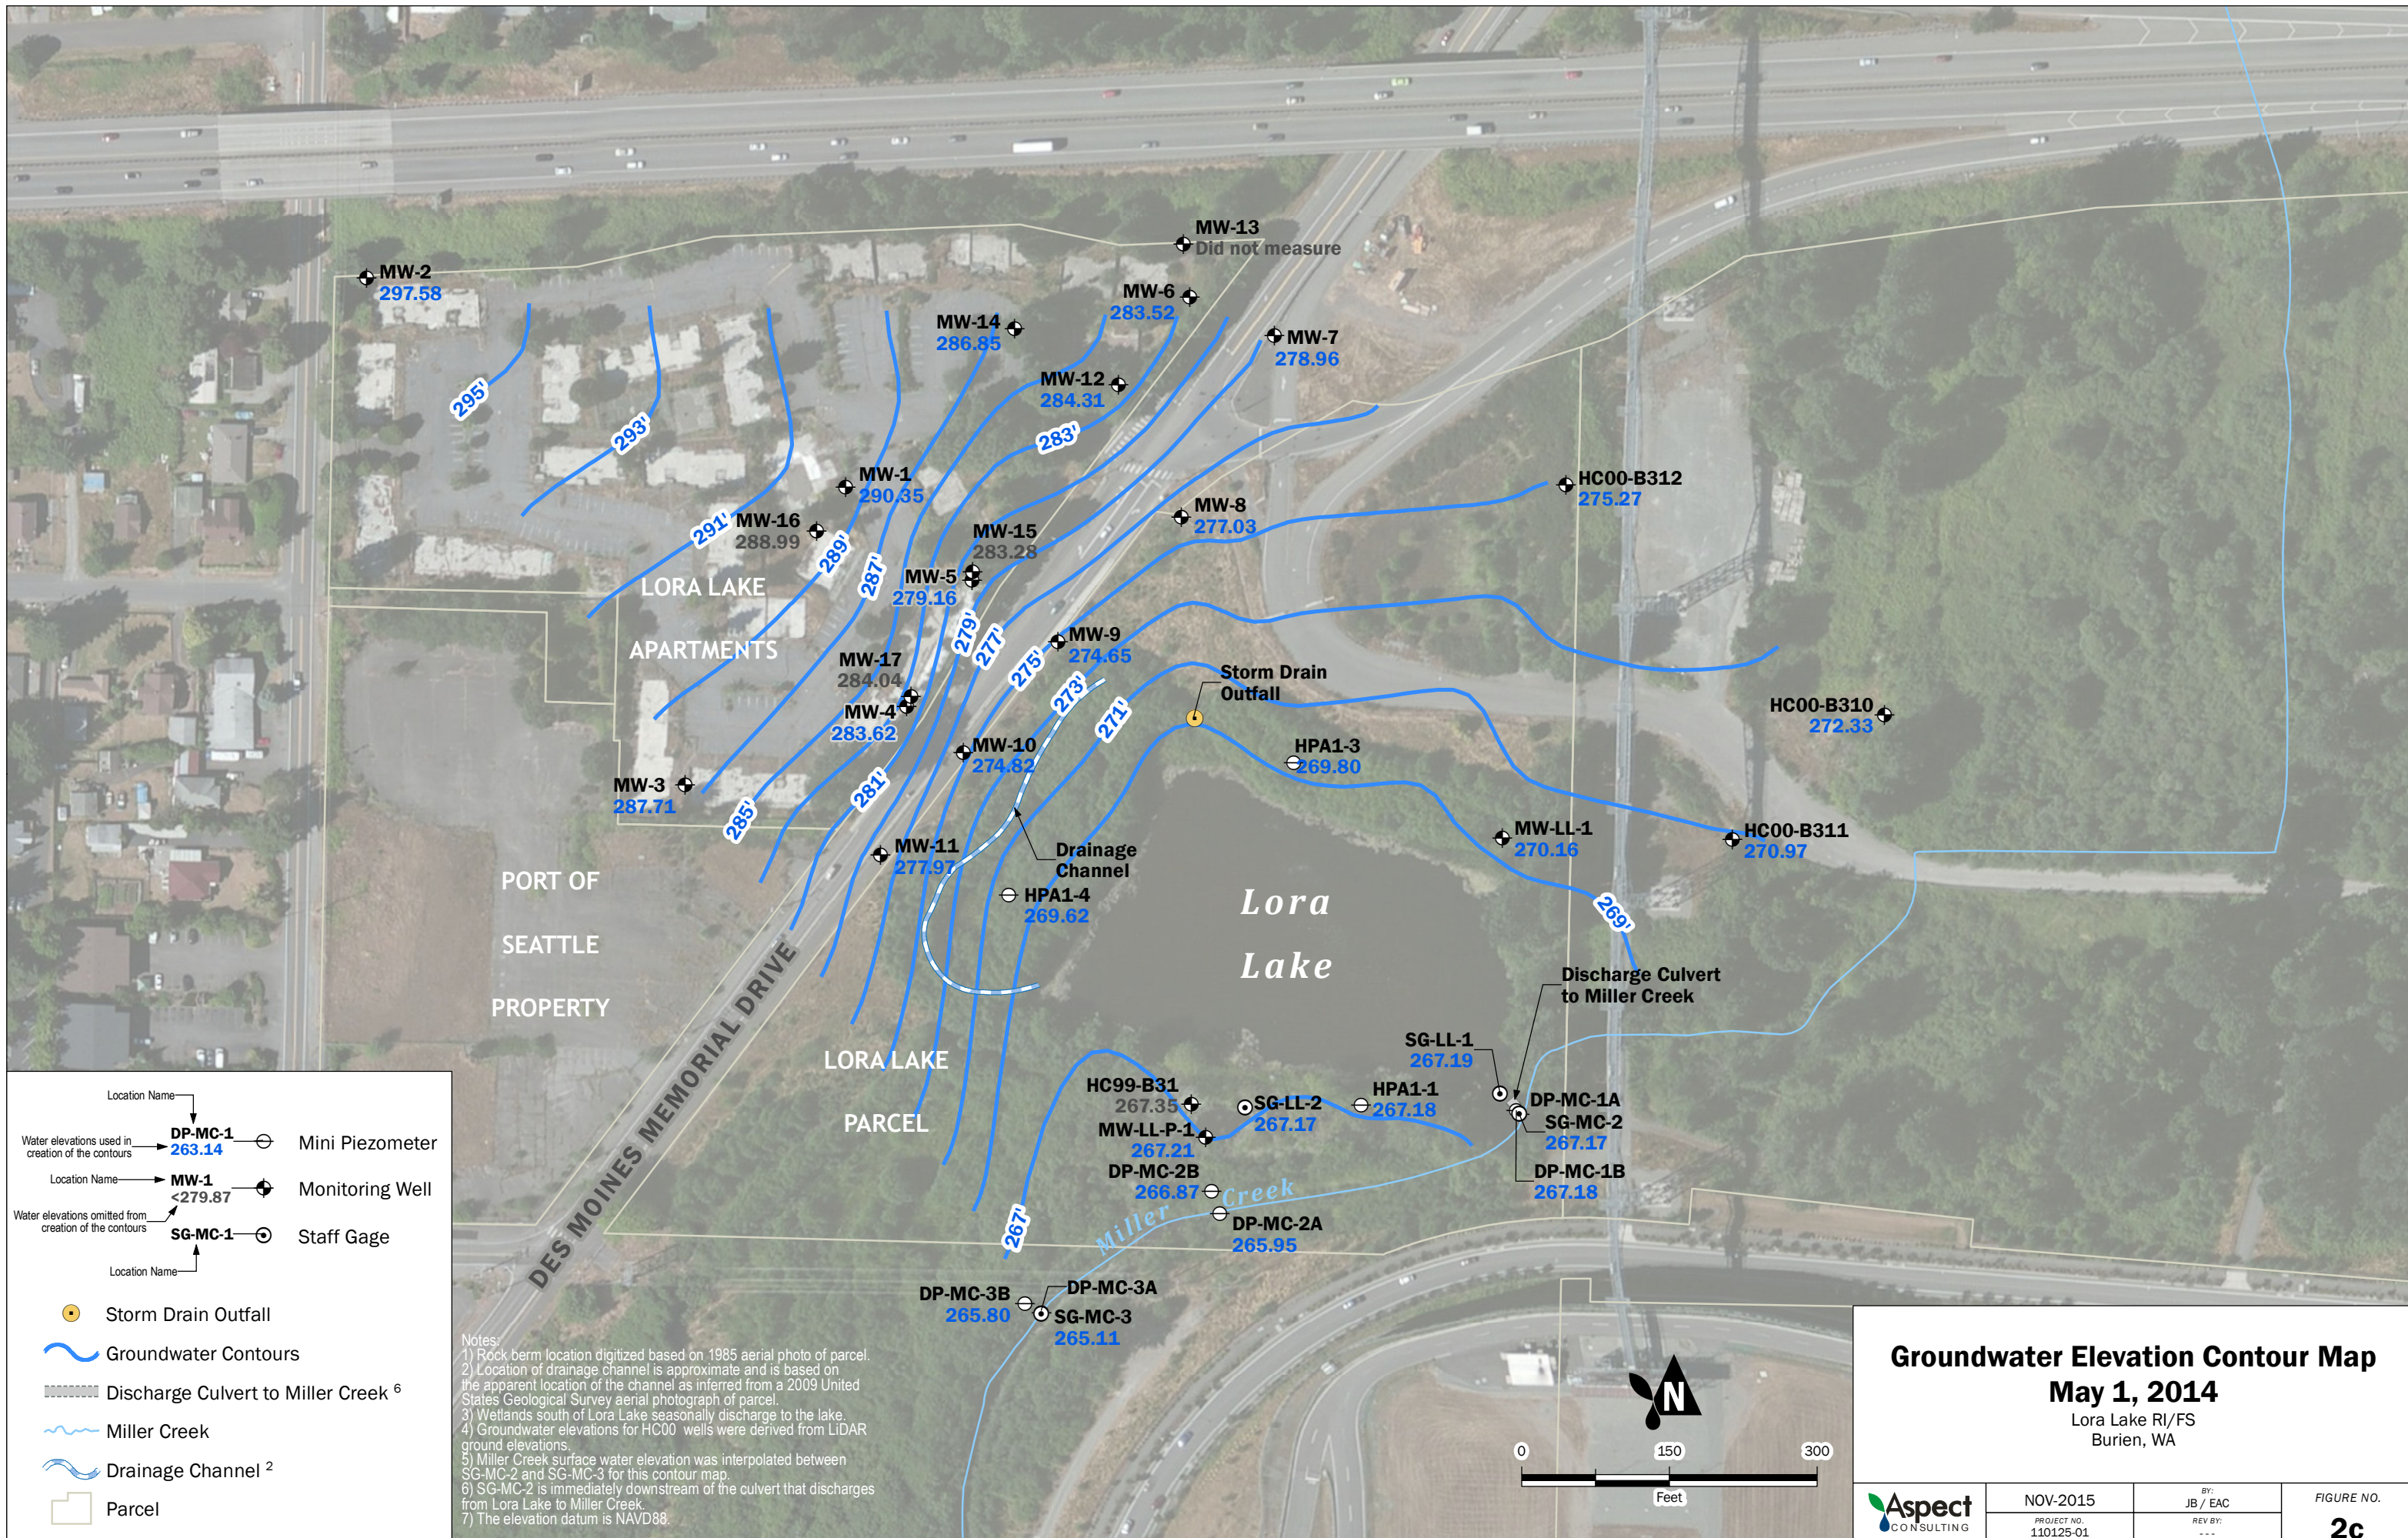

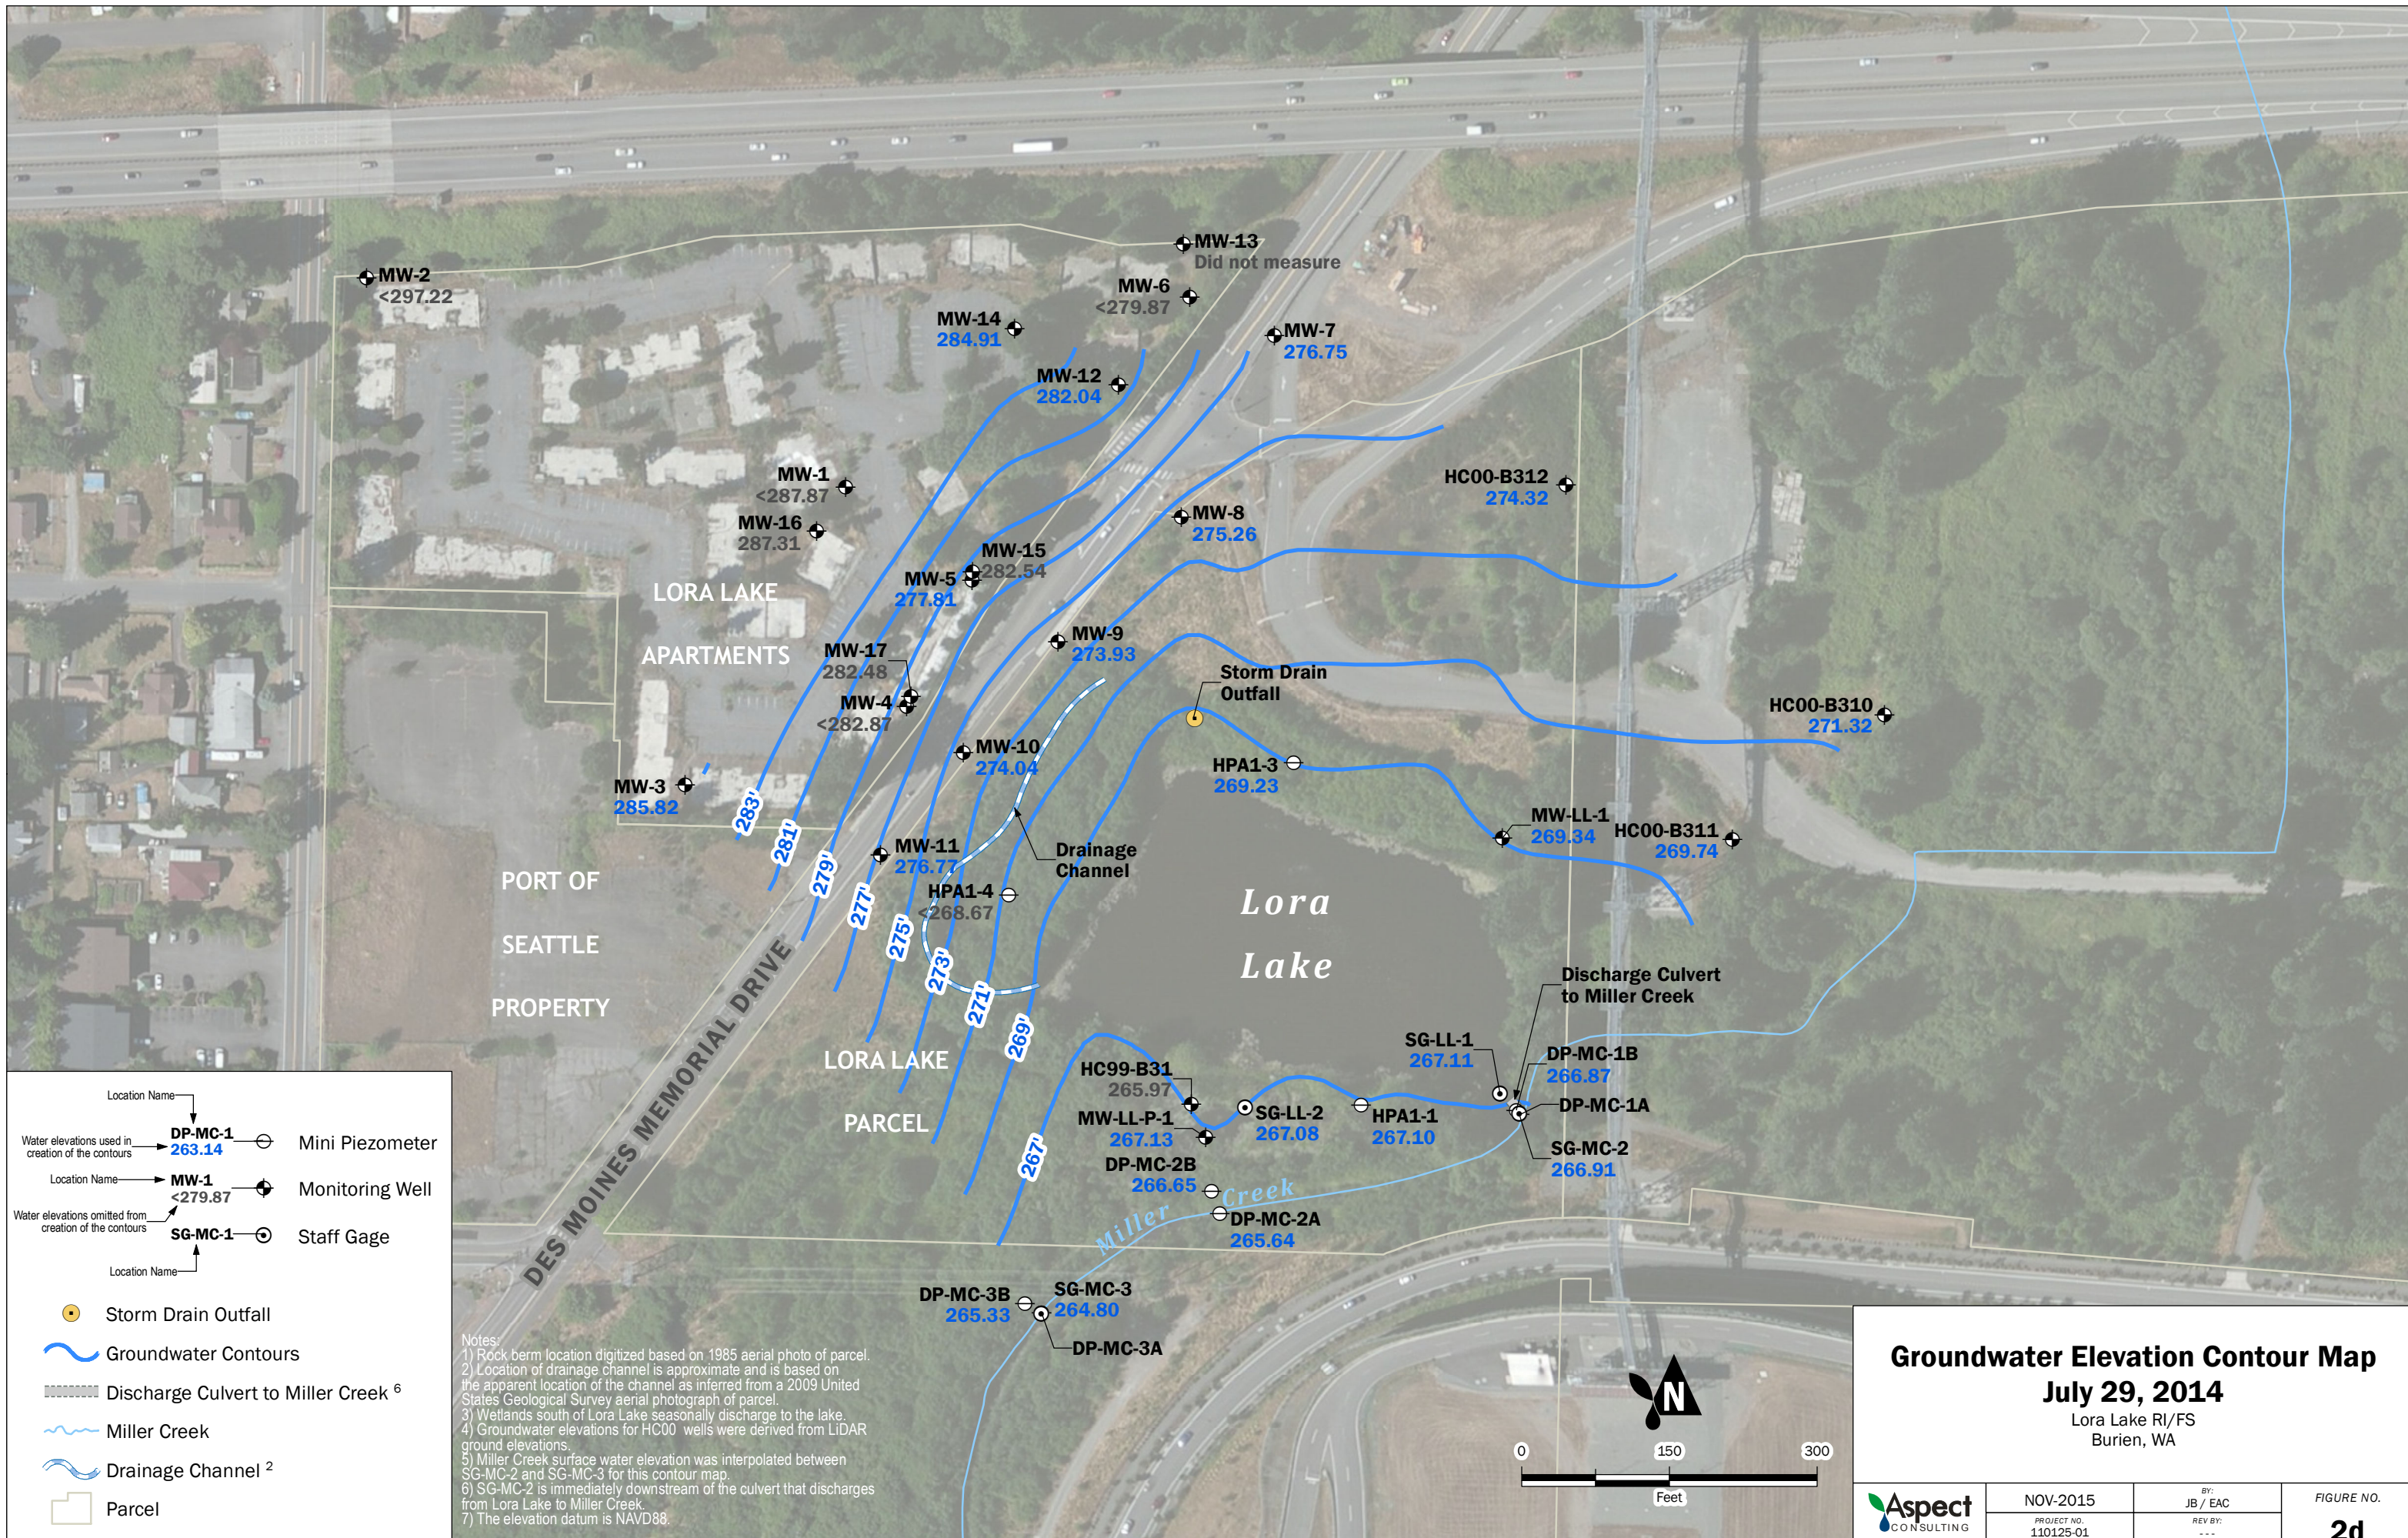

Location Name → **DP-MC-1** ⊕ Mini Piezometer  
 Water elevations used in creation of the contours → **263.14**

Location Name → **MW-1** ⊕ Monitoring Well  
 Water elevations omitted from creation of the contours → **<279.87**

Location Name → **SG-MC-1** ⊕ Staff Gage

Location Name → **Storm Drain Outfall** ●

Groundwater Contours

Discharge Culvert to Miller Creek <sup>6</sup>

Miller Creek

Drainage Channel <sup>2</sup>

Parcel


Notes:  
 1) Rock berm location digitized based on 1985 aerial photo of parcel.  
 2) Location of drainage channel is approximate and is based on the apparent location of the channel as inferred from a 2009 United States Geological Survey aerial photograph of parcel.  
 3) Wetlands south of Lora Lake seasonally discharge to the lake.  
 4) Groundwater elevations for HC00 wells were derived from LiDAR ground elevations.  
 5) Miller Creek surface water elevation was interpolated between SG-MC-2 and SG-MC-3 for this contour map.  
 6) SG-MC-2 is immediately downstream of the culvert that discharges from Lora Lake to Miller Creek.  
 7) The elevation datum is NAVD88.

### Groundwater Elevation Contour Map

**July 29, 2014**  
 Lora Lake RI/FS  
 Burien, WA

	NOV-2015	BY: JB / EAC	FIGURE NO. <b>2d</b>
	PROJECT NO. 110125-01	REV BY: ---	

GIS Path: T:\projects\_8\Port of Seattle\LoraLake\Deliverables\GroundwaterMonitoring\November2015\Report\GroundwaterElevation\_July2014.mxd | Coordinate System: NAD 83 StatePlane Washington North FIPS 4601 Feet | Date Saved: 11/19/2015 | User: scumshaker | Print Date: 11/19/2015

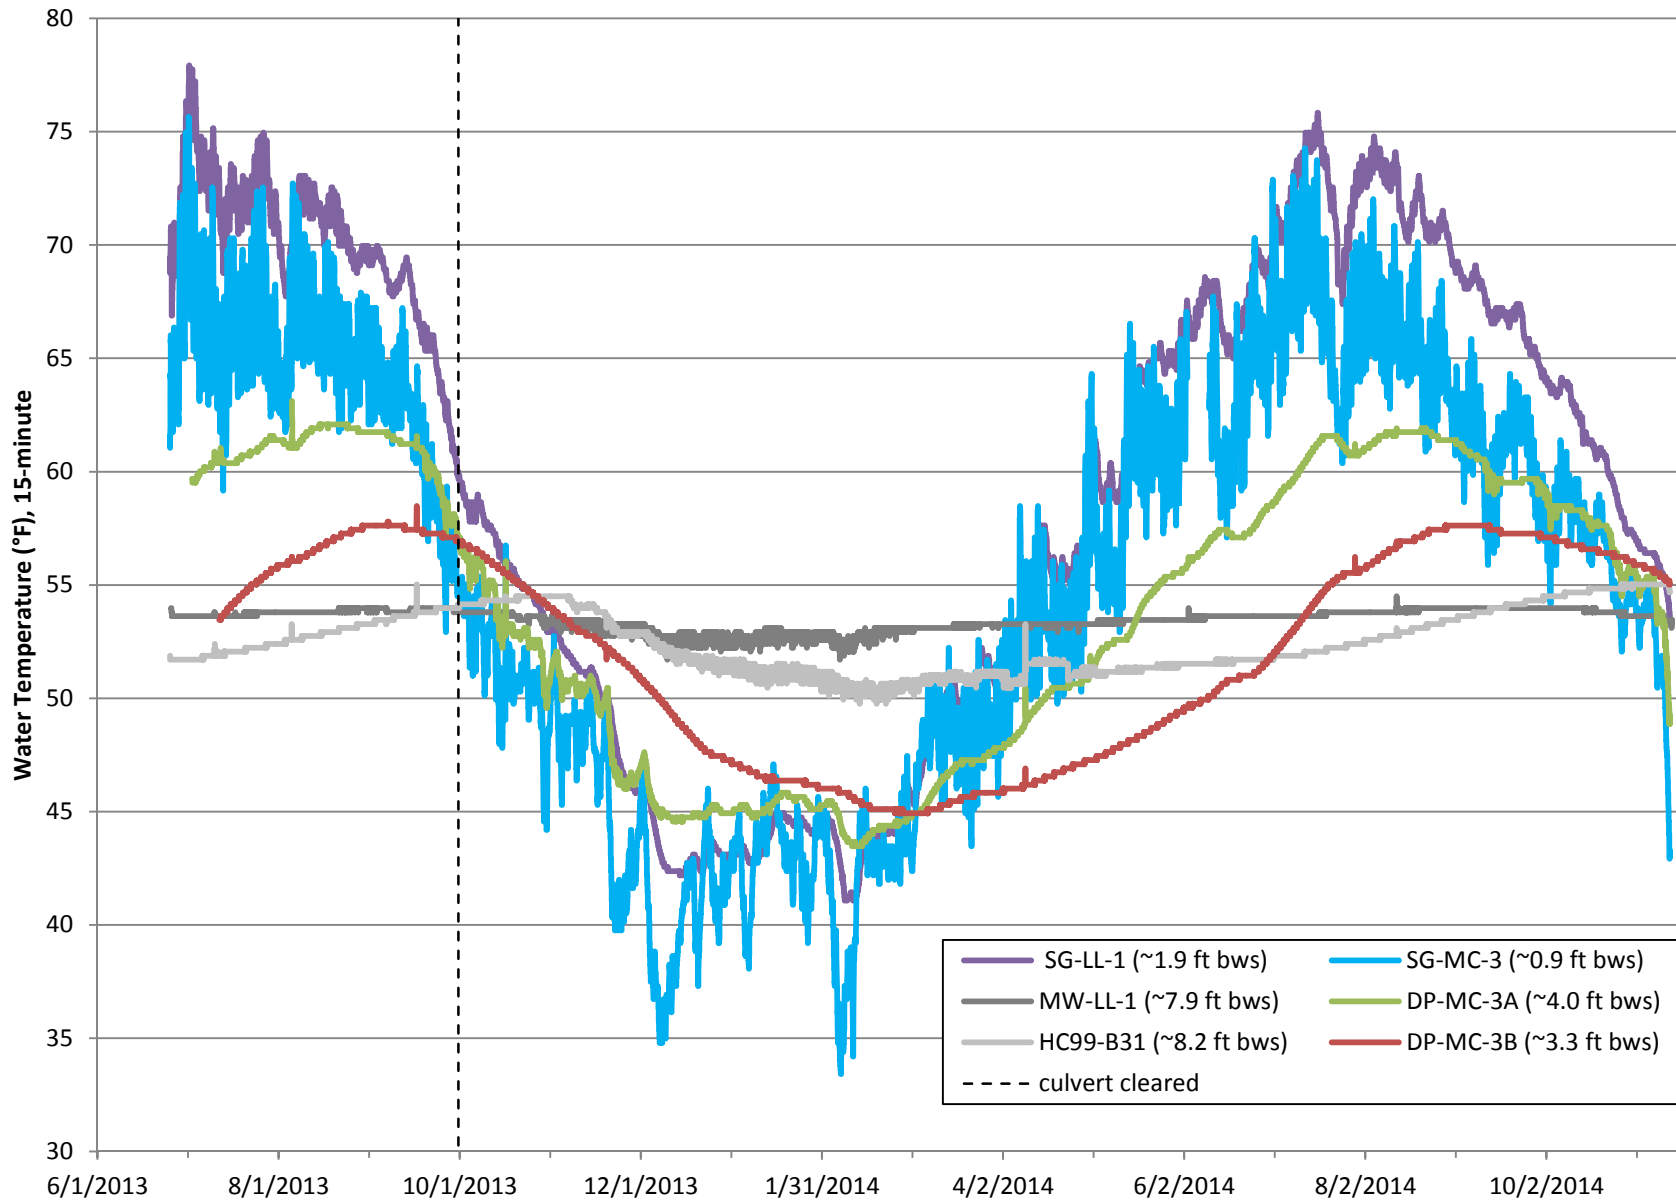

(bws = below water surface)


Aspect Consulting

1/16/2015

P:\Port of Seattle\Lora Lake\Lake Fill Baseline Data\Field data\superceded\Combined Monitoring Data & Graphs.xlsx

**Figure 3**  
**Water Temperature**

Data Summary Memo  
Lora Lake RI/FS, Burien, WA

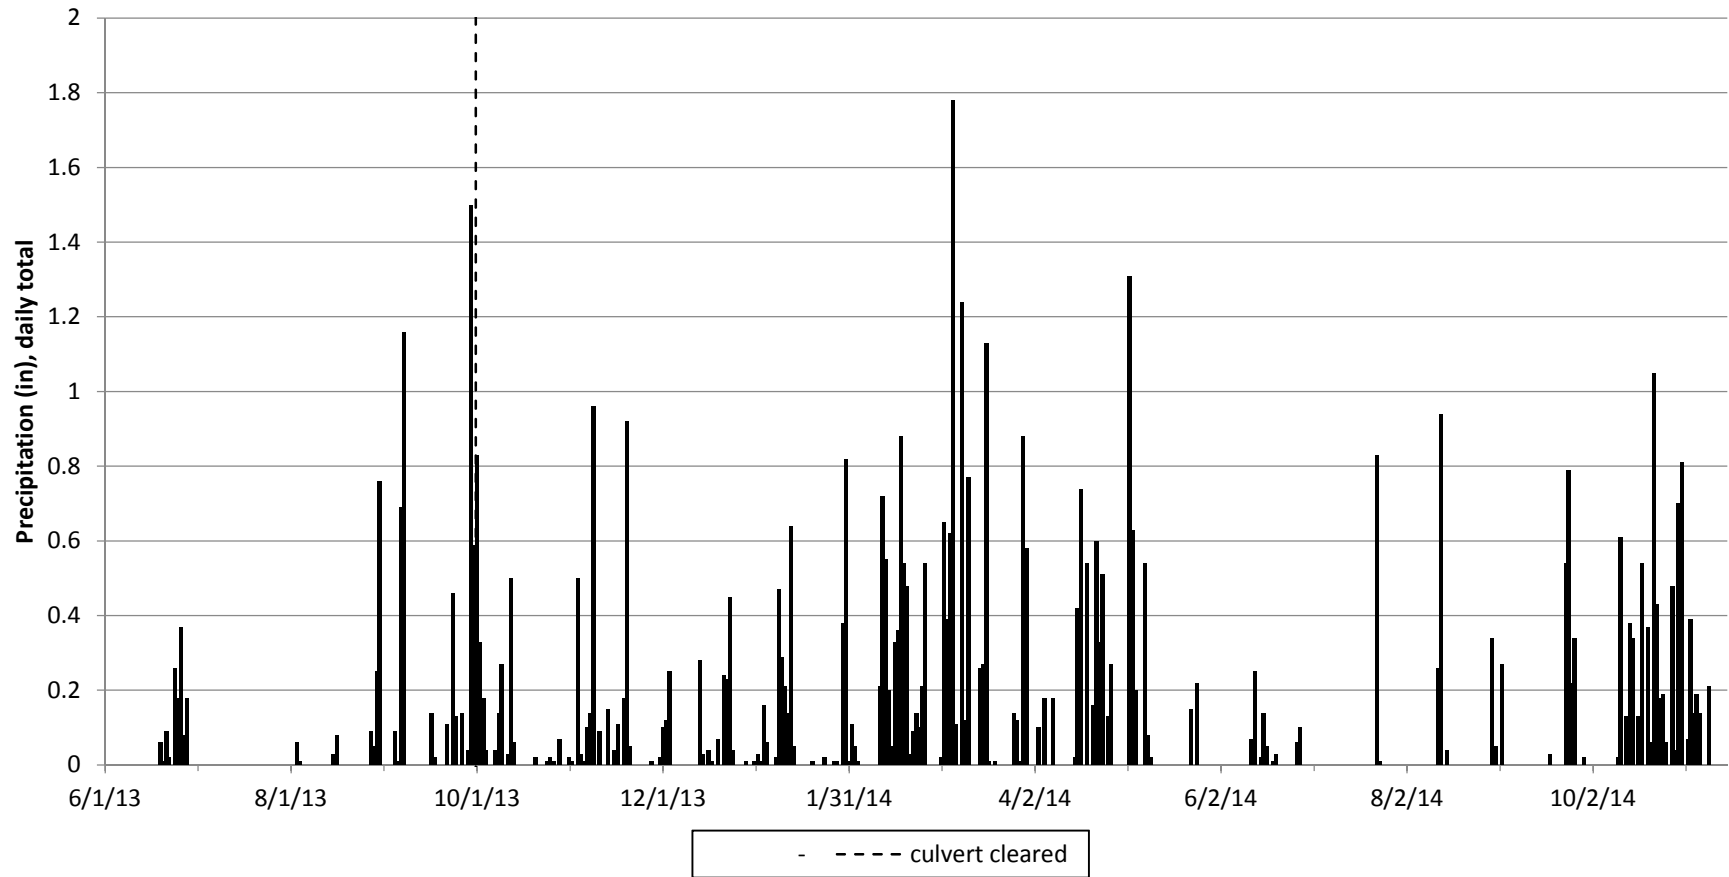


	Monthly Precipitation Totals (in)												Avg.		Total	
	Jan	Feb	Mar	Apr	May	June	July	Aug	Sept	Oct	Nov	Dec				
<b>2013</b>	-	-	-	-	2.4	1.3	0.0	1.3	5.1	2.6	3.3	1.9	3.3 <sup>1</sup>	3.6 <sup>2</sup>	40.1 <sup>1</sup>	43.4 <sup>2</sup>
<b>2014</b>	3.3	5.6	9.1	4.2	3.2	0.7	0.8	1.6	2.2	6.5	4.7	4.7				
<b>1945-2003 Avg.</b>	5.6	4.2	3.8	2.6	1.7	1.5	0.8	1.0	1.8	3.6	5.9	5.8	3.2		38.2	
<b>Difference 2013 from Avg.</b>	-	-	-	-	0.7	<b>-0.2</b>	<b>-0.8</b>	0.3	3.3	<b>-1.0</b>	<b>-2.6</b>	<b>-3.9</b>				
<b>Difference 2014 from Avg.</b>	<b>-2.3</b>	1.4	5.3	1.6	1.5	<b>-0.8</b>	0.1	0.6	0.5	3.0	<b>-1.2</b>	<b>-1.1</b>				

<sup>1</sup> May 2013 through April 2014.

<sup>2</sup> Using average of 2013 and 2014 monthly precipitation for the duplicate months (May - December).

**Figure 4 and Table 5  
Precipitation**

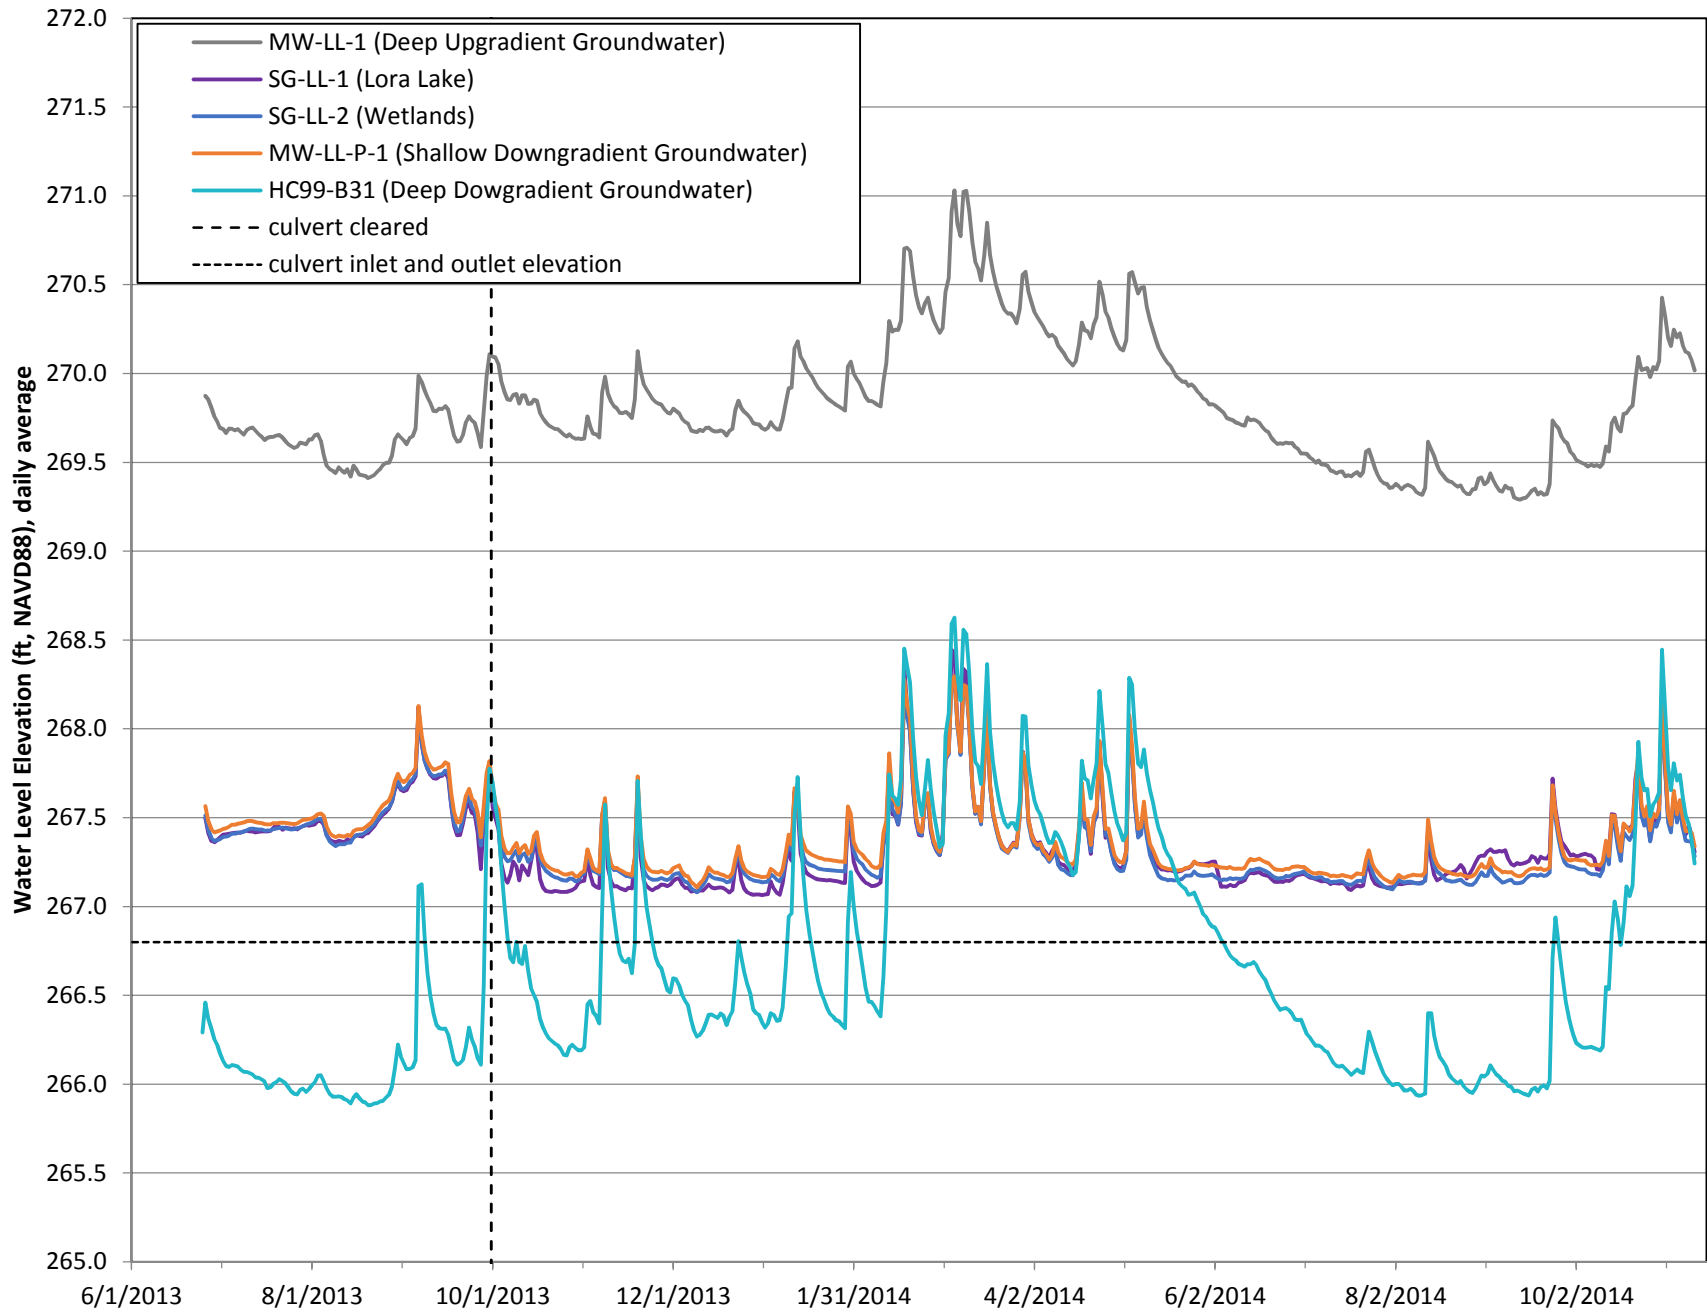


**Figure 5 - Groundwater Interactions with Lora Lake**

Aspect Consulting

10/19/2015

W:\110125 Lora Lake RI-FS Support\Deliverables\Data Summary Memo\UPDATED Tables\Tables and Figures

Data Summary Memo  
Lora Lake RI/FS, Buriem, WA

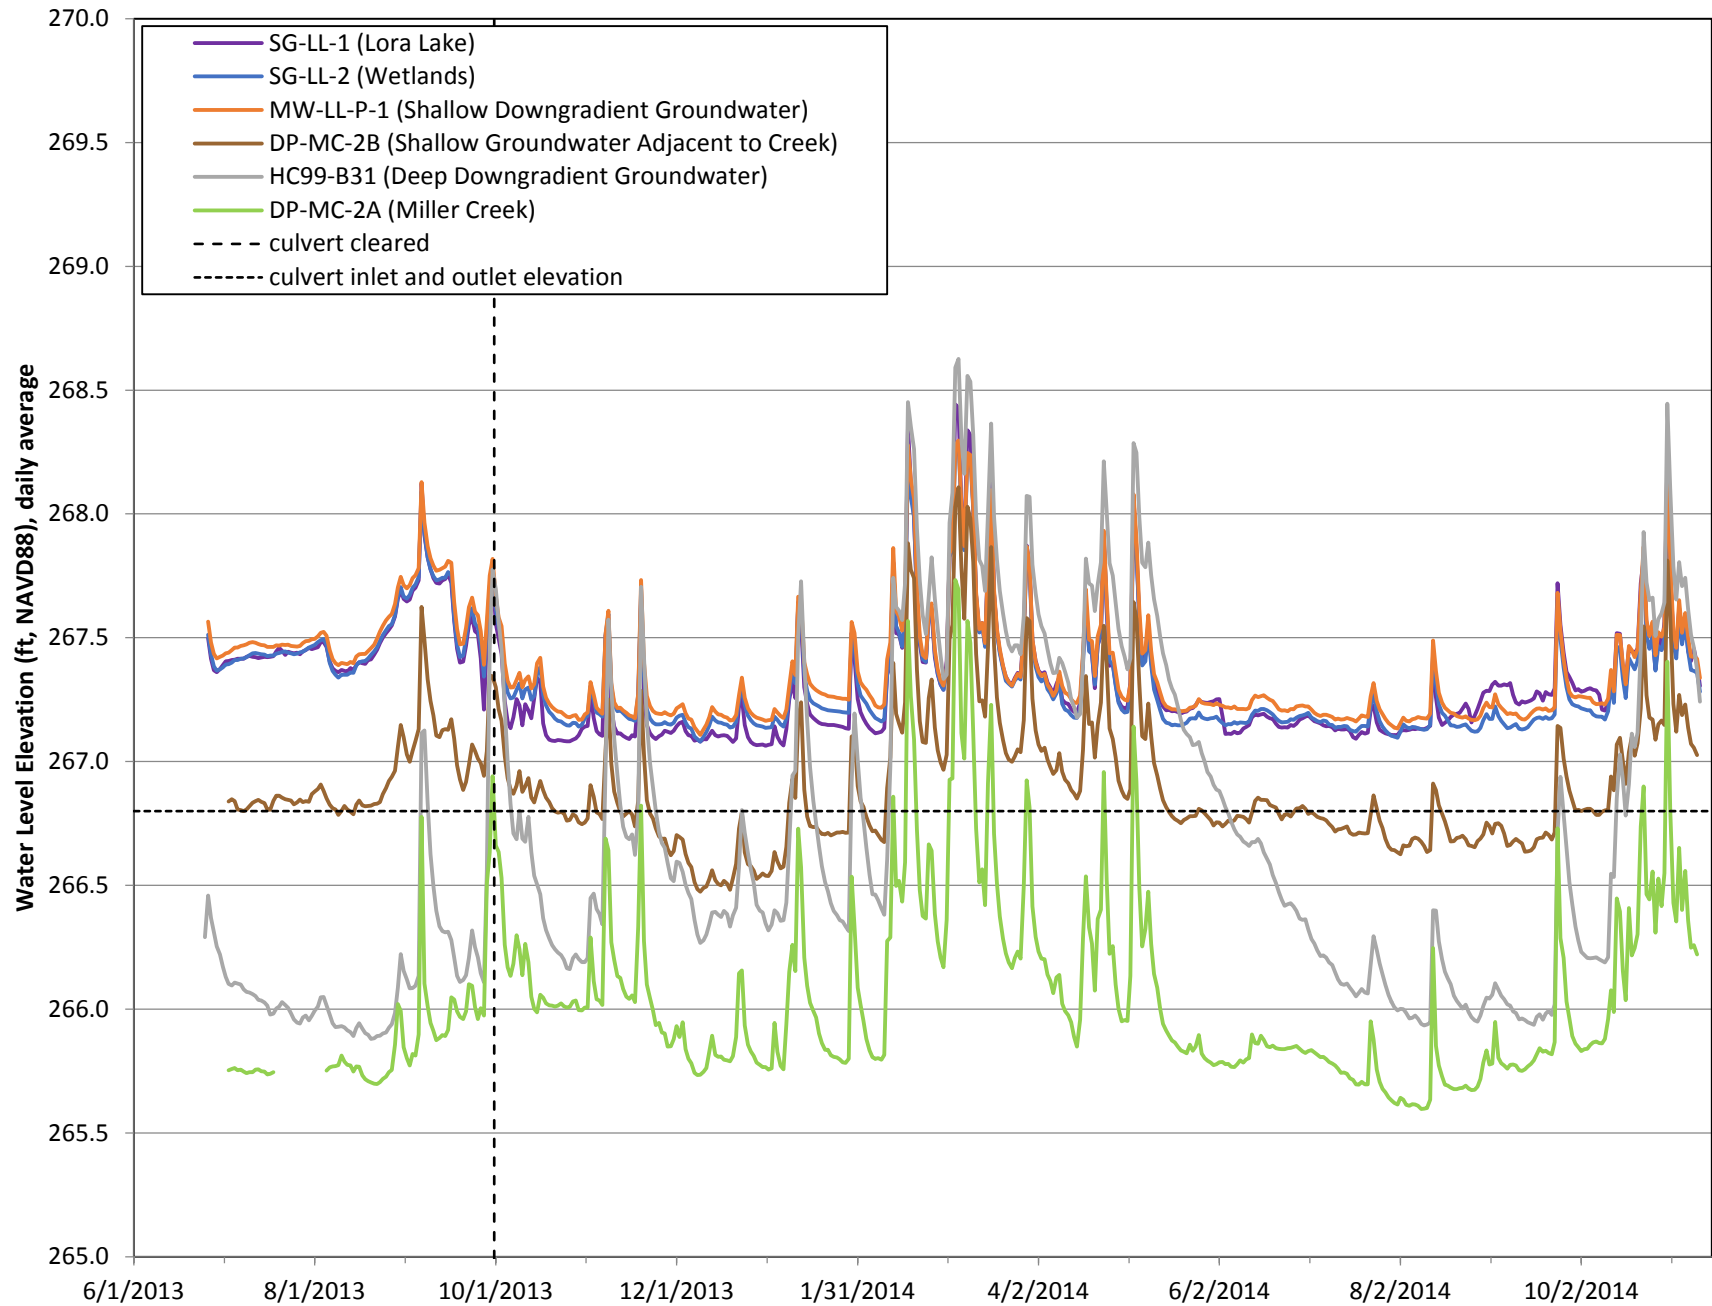



**Figure 6 - Overall Surface Water and Groundwater Interactions**

Aspect Consulting

10/19/2015


W:\110125 Lora Lake RI-FS Support\Deliverables\Data Summary Memo\UPDATED Tables\Tables and Figures

Data Summary Memo  
Lora Lake RI/FS, Burien, WA

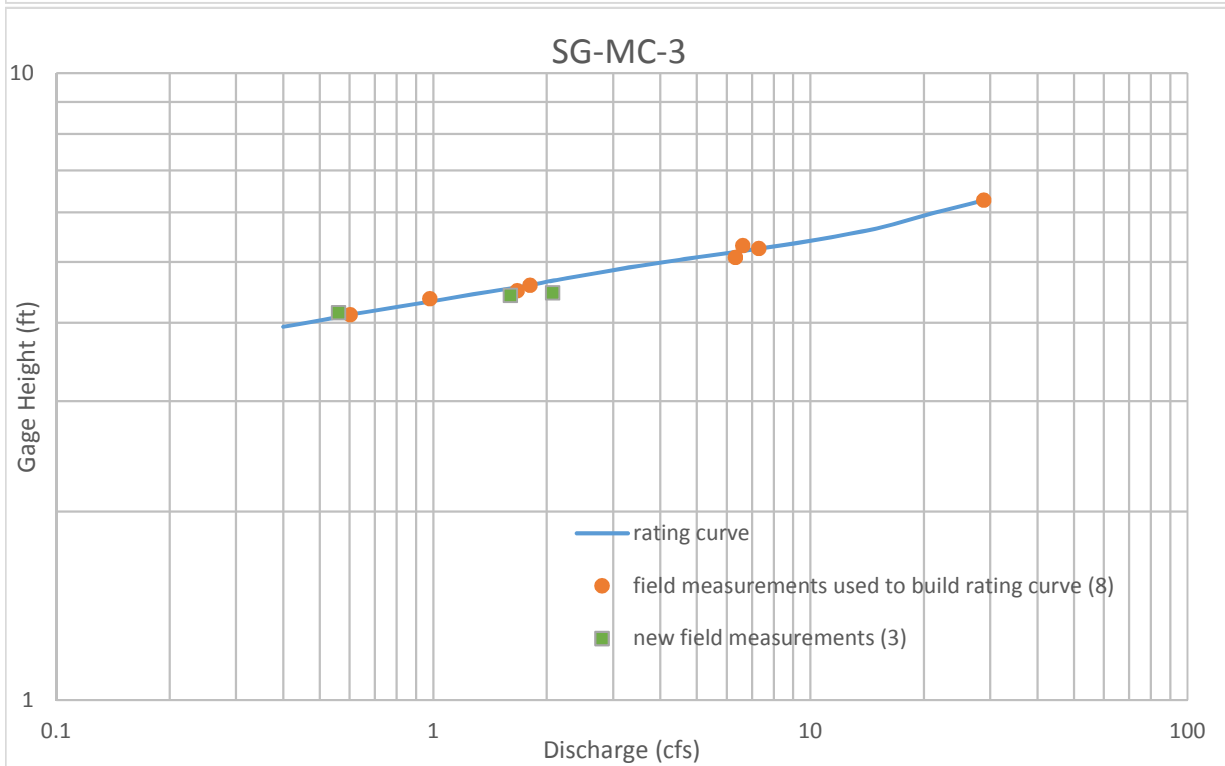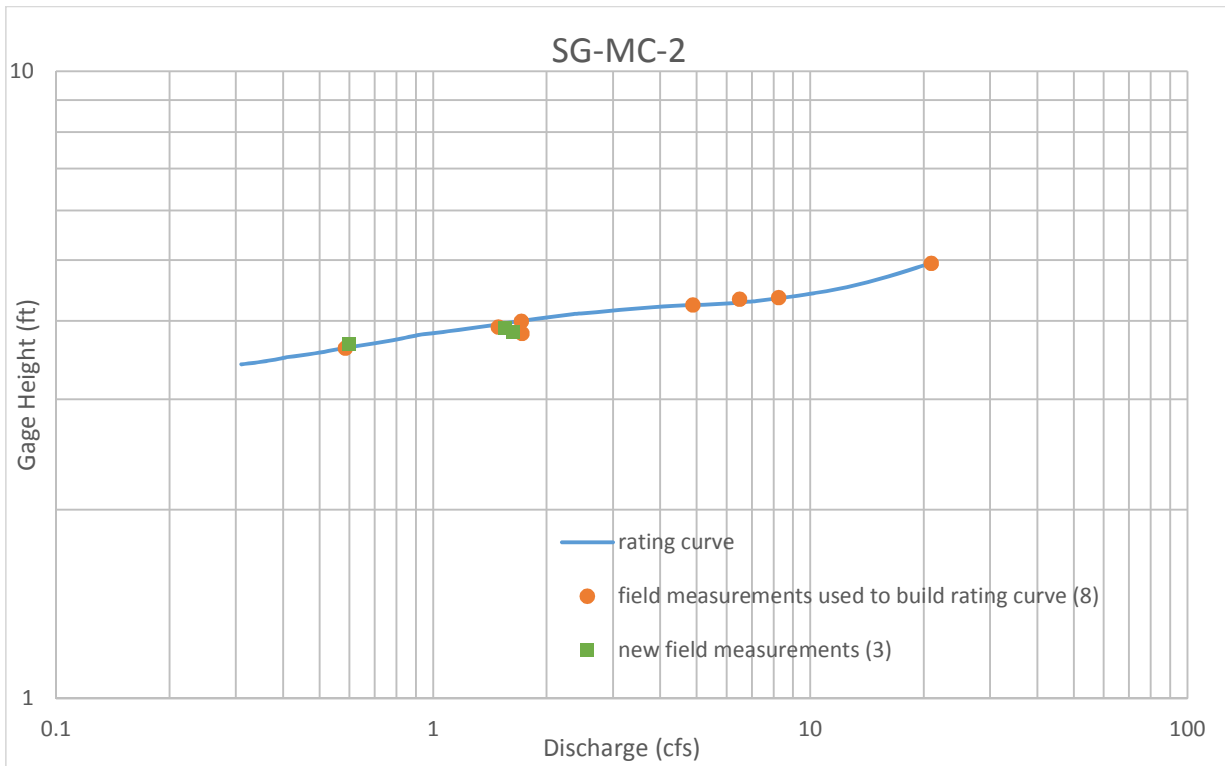





### Overview of Flows in Miller Creek

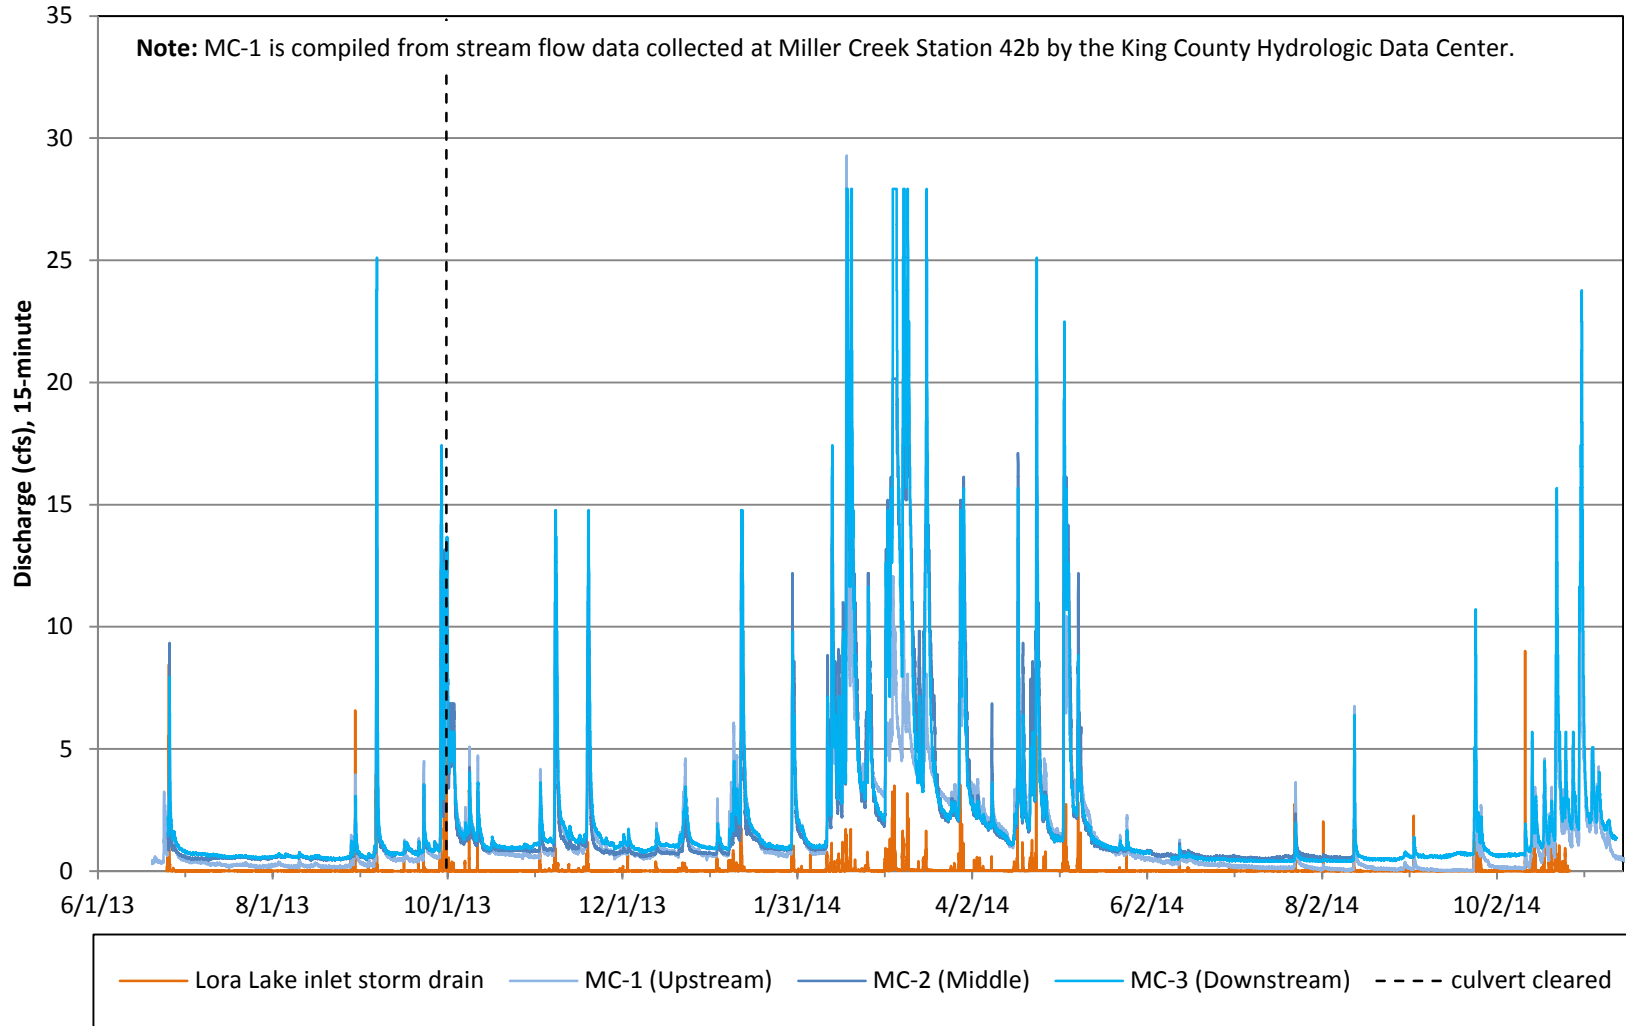

### Detailed Low Flows in Miller Creek

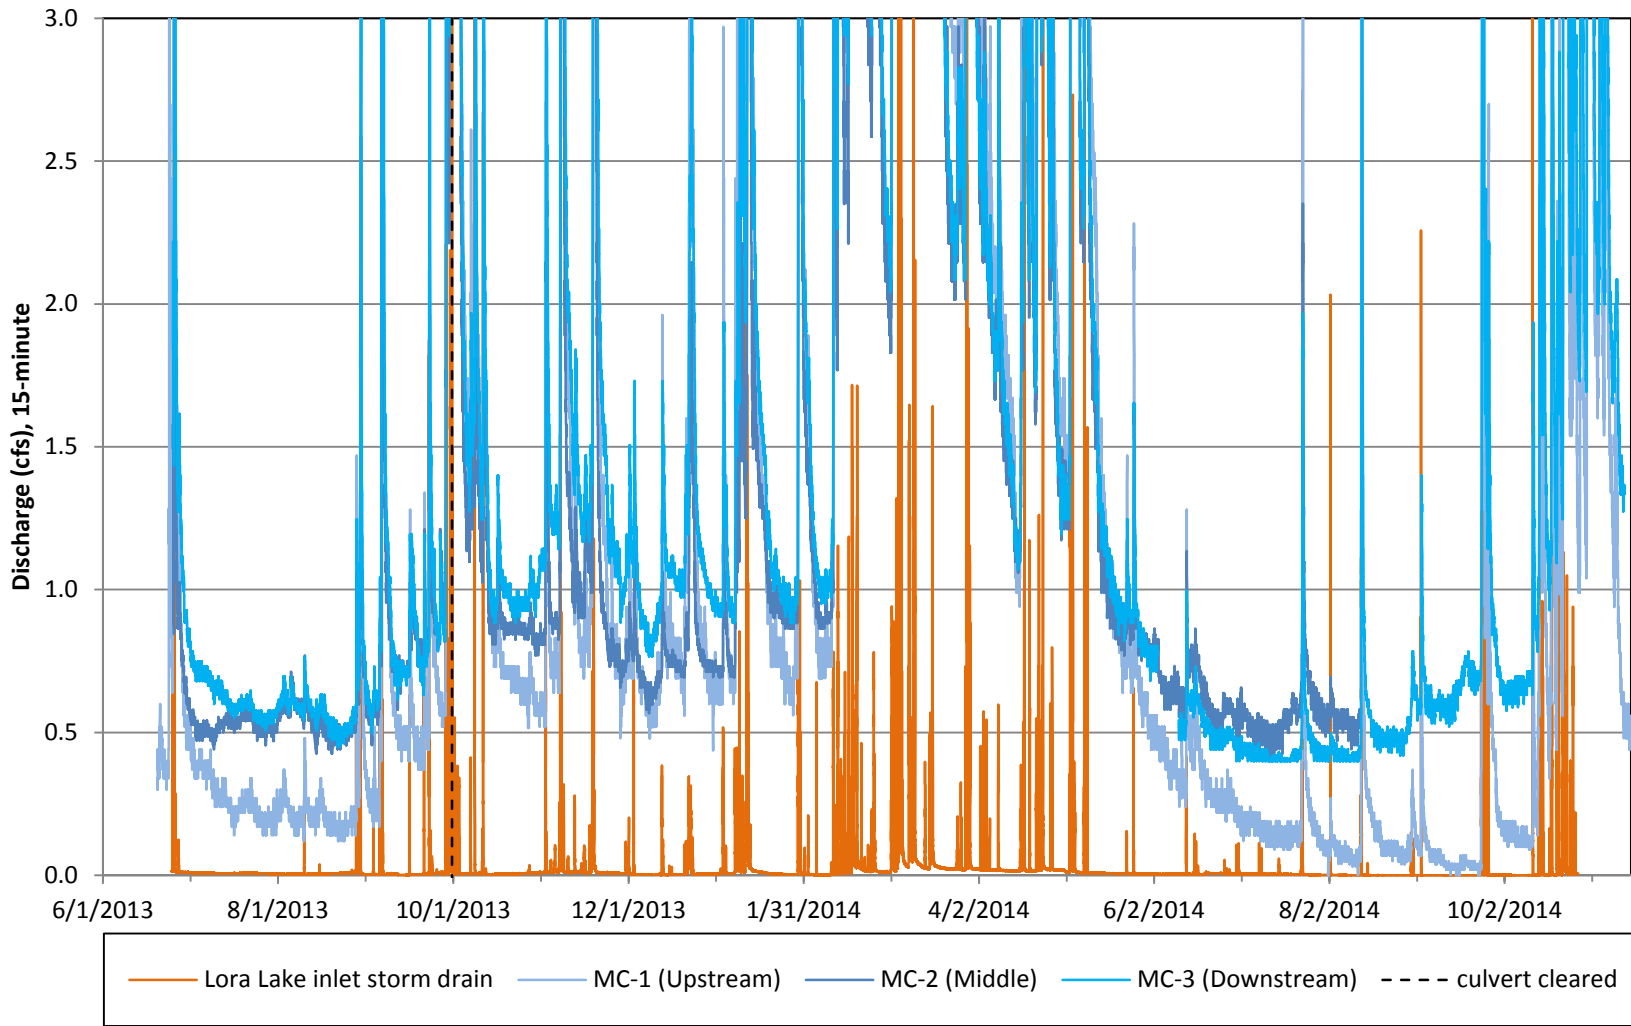


### Precipitation

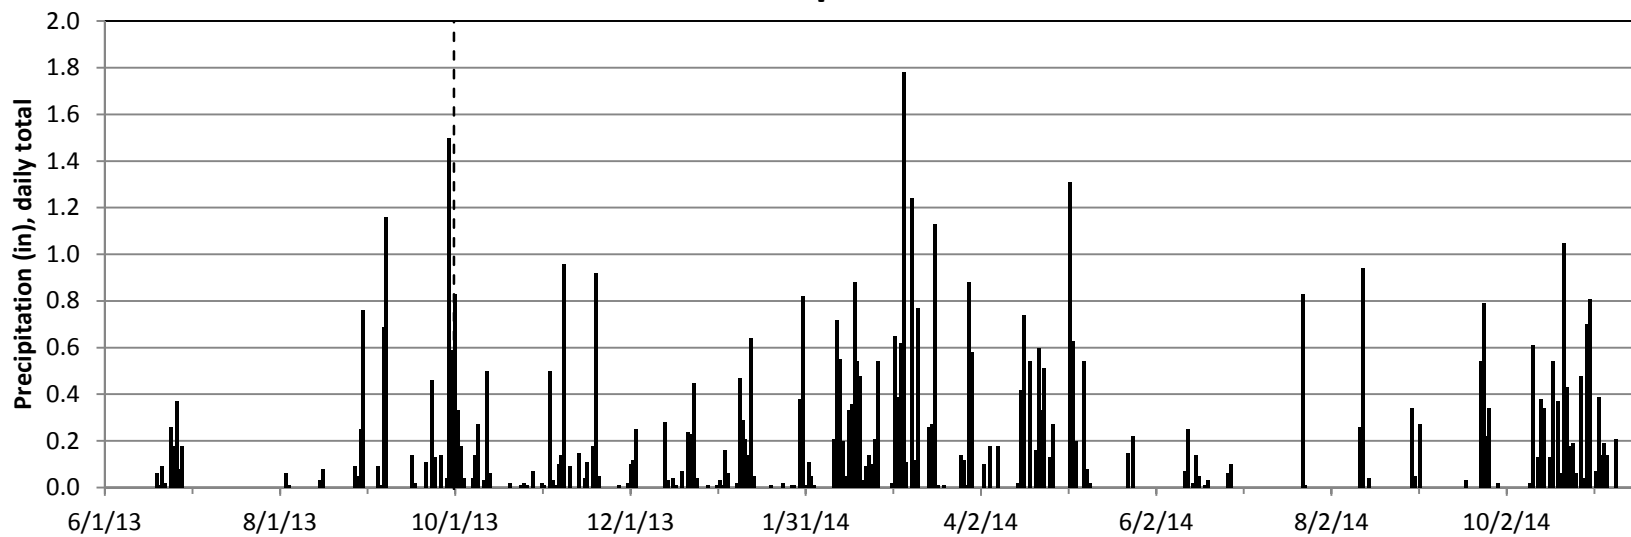


**Figure 8**  
**Miller Creek Flows**  
 Data Summary Memo  
 Lora Lake RI/FS, Burien, WA


### Miller Creek near Lora Lake Outflow

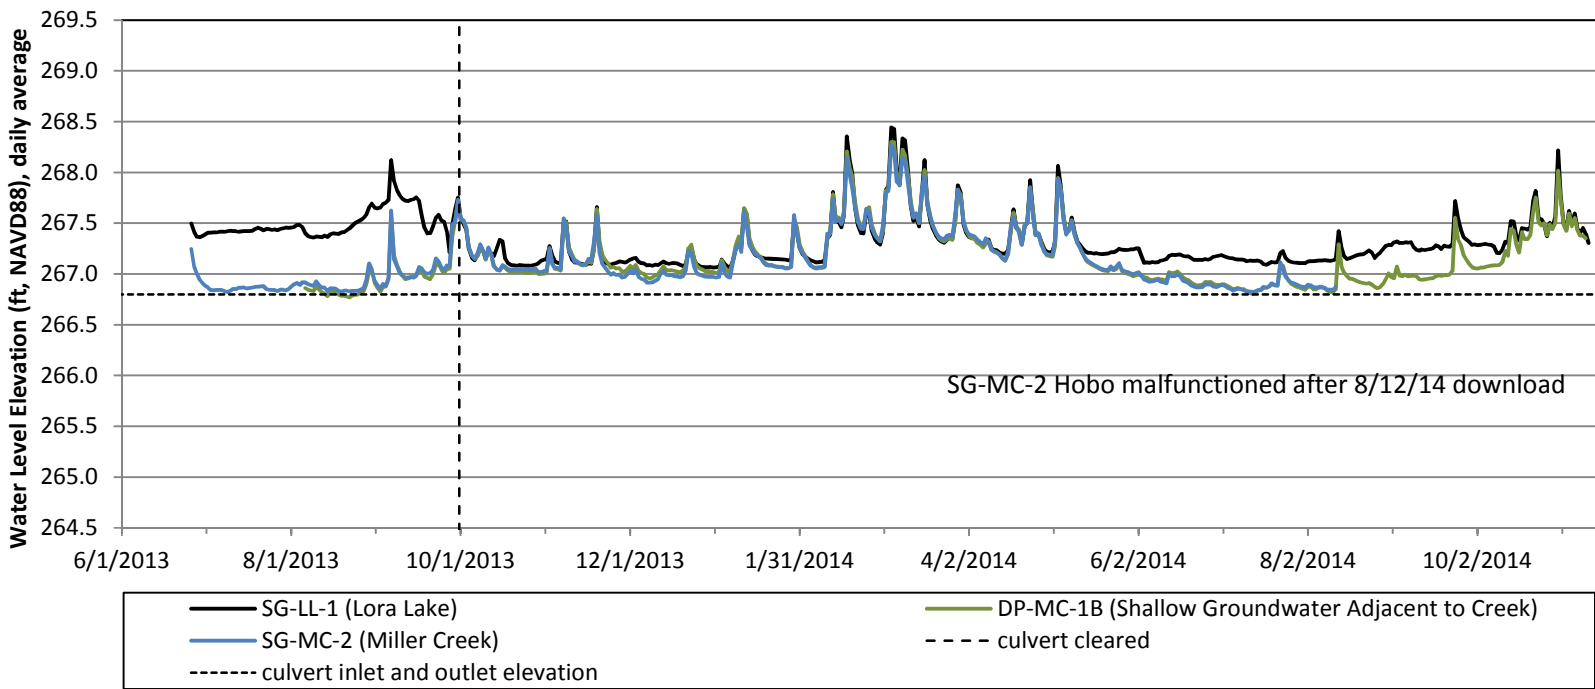


### Miller Creek near Wetlands

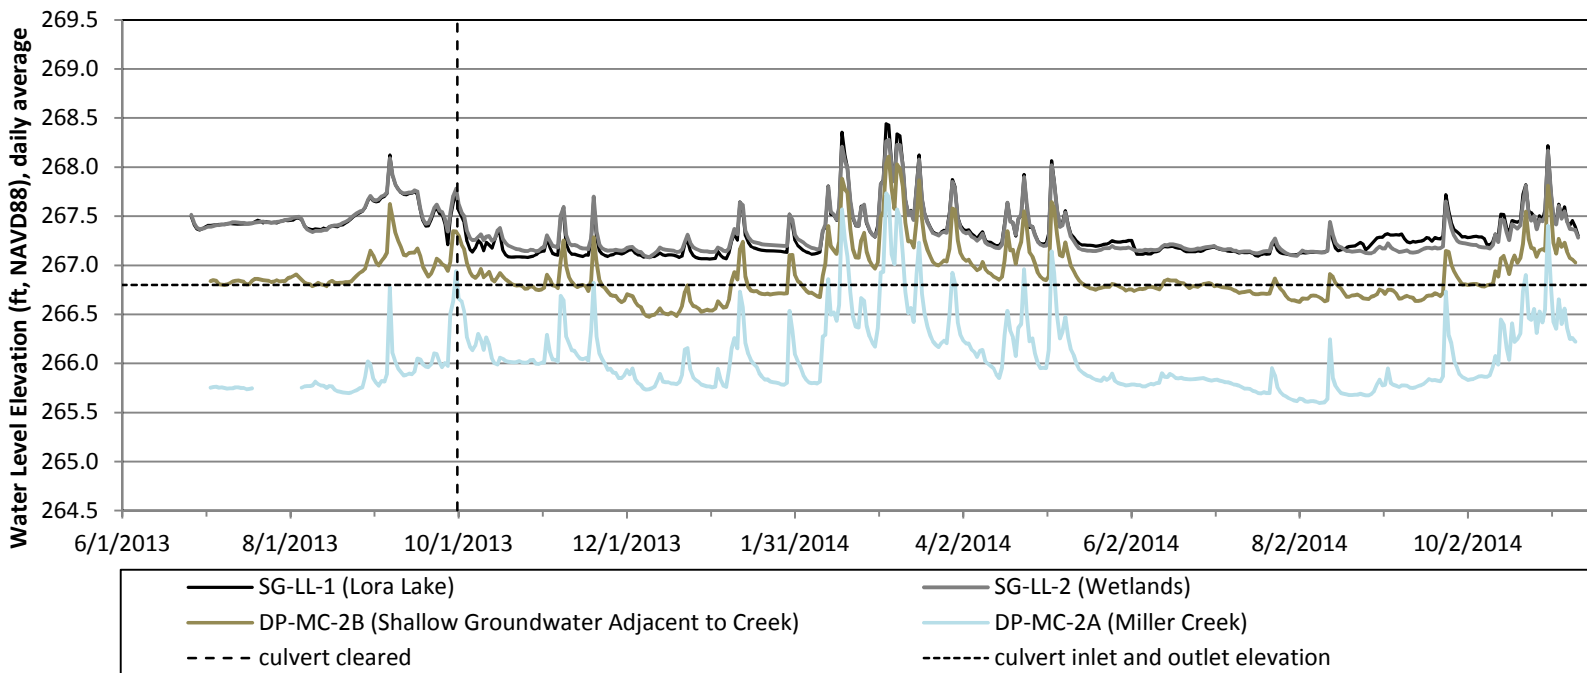

### Miller Creek downstream of Wetlands

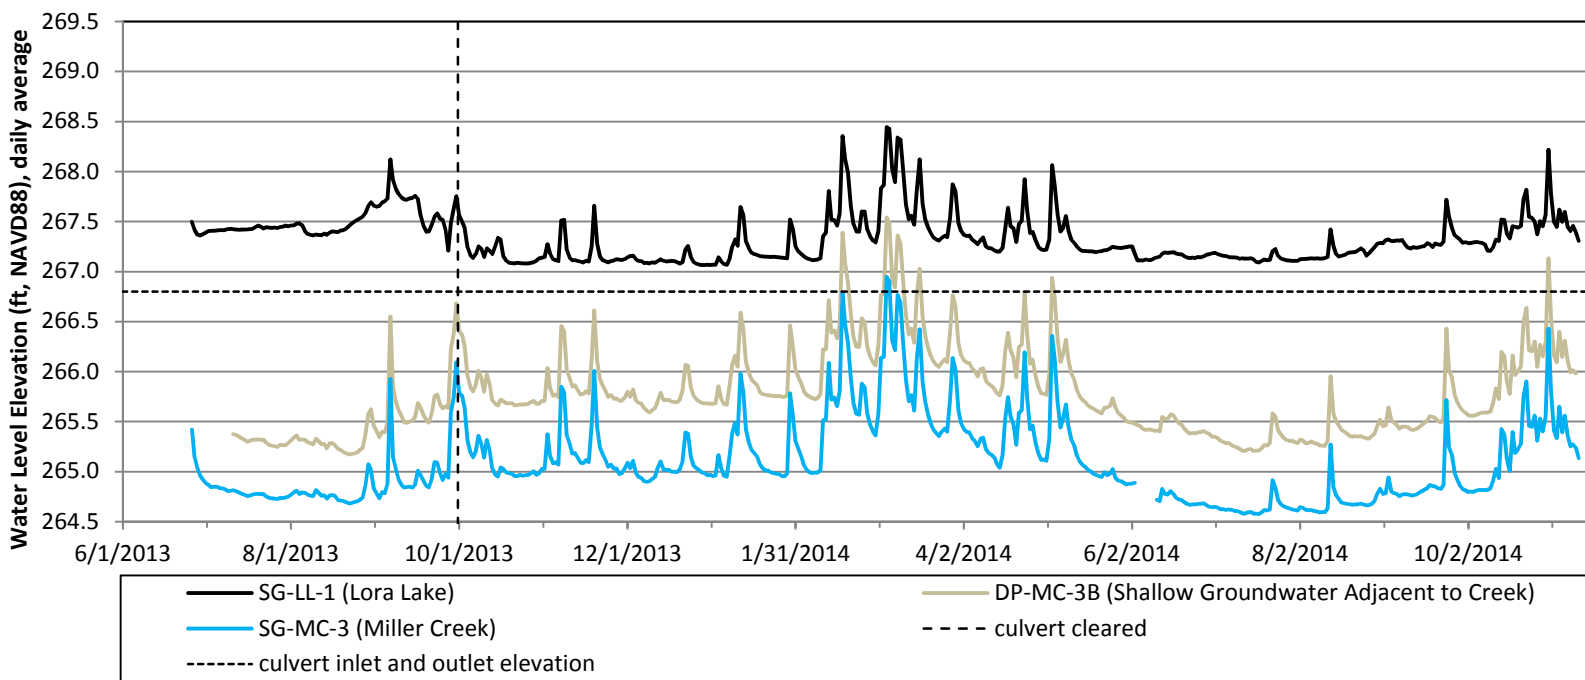

### Precipitation

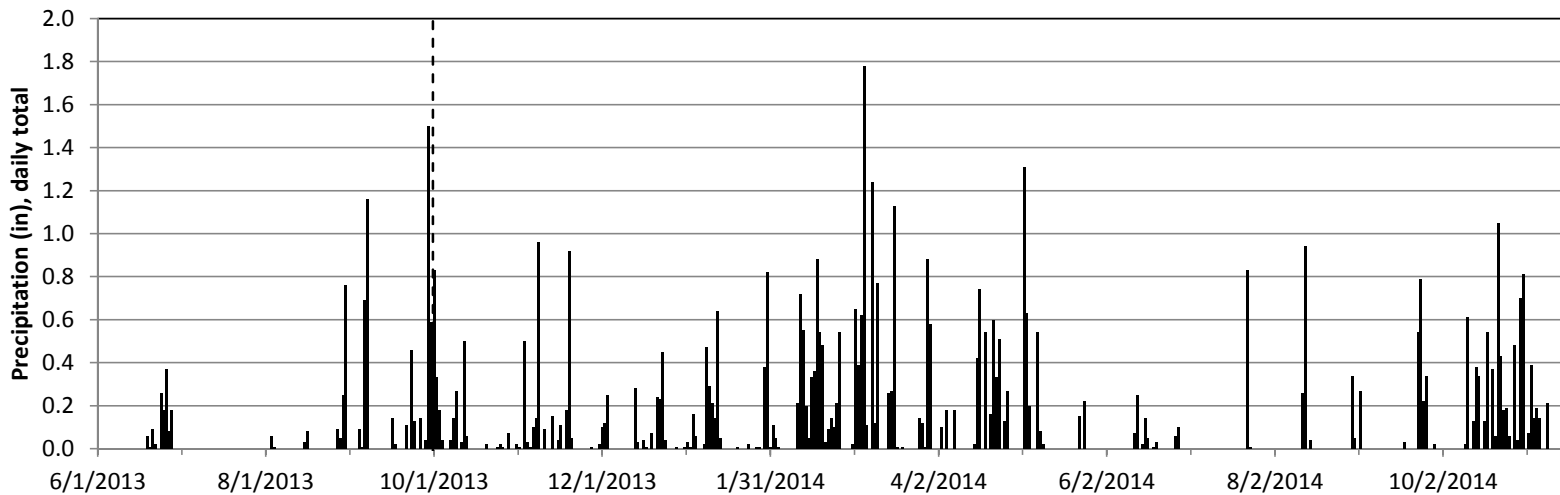

**Figure 9**  
**Surface Water and Groundwater**  
**Interactions with Miller Creek**

## **APPENDIX A**

### **MW-LL-1 Well Log**

Soil Classification		Terms Describing Relative Density and Consistency	
		Density	SPT <sup>(2)</sup> blows/foot
Coarse-Grained Soils - More than 50% (1) Retained on No. 200 Sieve	Gravels - More than 50% (1) of Coarse Fraction Retained on No. 4 Sieve	Well-graded gravel and gravel with sand, little to no fines	Very Loose 0 to 4
	GP	Poorly-graded gravel and gravel with sand, little to no fines	Loose 4 to 10
	GM	Silty gravel and silty gravel with sand	Medium Dense 10 to 30
	GC	Clayey gravel and clayey gravel with sand	Dense 30 to 50
	SW	Well-graded sand and sand with gravel, little to no fines	Very Dense >50
	SP	Poorly-graded sand and sand with gravel, little to no fines	
Fine-Grained Soils - 50% (1) or More Passes No. 200 Sieve	Sands - 50% (1) or More of Coarse Fraction Passes No. 4 Sieve	Silty sand and silty sand with gravel	
	SM	Clayey sand and clayey sand with gravel	
	ML	Silt, sandy silt, gravelly silt, silt with sand or gravel	
	CL	Clay of low to medium plasticity; silty, sandy, or gravelly clay, lean clay	
	CH	Clay of high plasticity, sandy or gravelly clay, fat clay with sand or gravel	
	OH	Organic clay or silt of medium to high plasticity	
Highly Organic Soils	PT	Peat, muck and other highly organic soils	

Component Definitions	
Descriptive Term	Size Range and Sieve Number
Boulders	Larger than 12"
Cobbles	3" to 12"
Gravel	3" to No. 4 (4.75 mm)
Coarse Gravel	3" to 3/4"
Fine Gravel	3/4" to No. 4 (4.75 mm)
Sand	No. 4 (4.75 mm) to No. 200 (0.075 mm)
Coarse Sand	No. 4 (4.75 mm) to No. 10 (2.00 mm)
Medium Sand	No. 10 (2.00 mm) to No. 40 (0.425 mm)
Fine Sand	No. 40 (0.425 mm) to No. 200 (0.075 mm)
Silt and Clay	Smaller than No. 200 (0.075 mm)

(3) Estimated Percentage		Moisture Content
Percentage by Weight	Modifier	
<5	Trace	Dry - Absence of moisture, dusty, dry to the touch
5 to 15	Slightly (sandy, silty, clayey, gravelly)	Slightly Moist - Perceptible moisture
15 to 30	Sandy, silty, clayey, gravelly	Moist - Damp but no visible water
30 to 49	Very (sandy, silty, clayey, gravelly)	Very Moist - Water visible but not free draining
		Wet - Visible free water, usually from below water table

Symbols	
Sampler Type	Description
2.0" OD Split-Spoon Sampler (SPT)	Continuous Push
Bulk sample	Non-Standard Sampler
Grab Sample	3.0" OD Thin-Wall Tube Sampler (including Shelby tube)
	Portion not recovered

(1) Percentage by dry weight	(5) Combined USCS symbols used for fines between 5% and 15% as estimated in General Accordance with Standard Practice for Description and Identification of Soils (ASTM D-2488)
(2) (SPT) Standard Penetration Test (ASTM D-1586)	
(3) In General Accordance with Standard Practice for Description and Identification of Soils (ASTM D-2488)	
(4) Depth of groundwater	ATD = At time of drilling BGS = below ground surface

Classifications of soils in this report are based on visual field and/or laboratory observations, which include density/consistency, moisture condition, grain size, and plasticity estimates and should not be construed to imply field or laboratory testing unless presented herein. Visual-manual and/or laboratory classification methods of ASTM D-2487 and D-2488 were used as an identification guide for the Unified Soil Classification System.



## Exploration Log Key

DATE:	PROJECT NO.
DESIGNED BY:	
DRAWN BY:	FIGURE NO.
REVISED BY:	A-1



# Boring Log

Project Number  
110125

Boring Number  
MW-LL-1

Sheet  
1 of 1

Project Name: Lora Lake RI/FS

Ground Surface Elev \_\_\_\_\_

Location: Burien, WA

Driller/Equipment: Cascade Drilling / HSA Limited Access

Depth to Water (ft BGS) 0

Drilling Method/Hammer: D&M, 140 lb down-hole hammer, <30 inch drop

Start/Finish Date 6/25/2013

Depth / Elevation (feet)	Borehole Completion	Sample Type/ID	Tests	Blows/ 6"	N-value					Material Type	Description	Depth (ft)
					0	10	20	30	40			
0	Stick-up monument set in concrete											
5	Hydrated medium bentonite chips			16								5
5	2 inch diameter PVC casing			50/6"								
5	2/12 sand filter pack											
10	2 inch diameter 20-slot PVC screen			50/6"								10
15	PVC end cap			50/6"								15
20				50/6"								20
20.5												20.5

Grass, woody debris, and wetland soils

**WEATHERED VASHON RECESSIONAL GLACIAL OUTWASH**  
(Dense), wet, brown SAND (SP); fine to medium sand, trace organics - grass and thin roots

(Dense), wet, brown slightly silty, sandy GRAVEL (GP-GM); fine to coarse sand, predominantly fine round gravel, trace organics - grass and thin roots

(Dense), wet, gray brown SAND (SP); fine to medium sand, trace coarse sand and fine gravel, trace organics, trace silt

Becomes gray, no organics

Bottom of boring at 20.5 ft bgs

Sampler Type:

Drilling Method:

Logged by: **JB**

- No Recovery
- 3.25" OD D&M Split-Spoon
- Ring Sampler

HSA: Hollow Stem Auger

Approved by:

MR: Mud Rotary

Figure No.

GEOTECH BORING LOG LORA LAKE 110125.GPJ June 26, 2013

## **APPENDIX B**

### **Well Logs of Pre-Existing Monitoring Stations**

# BORING & WELL CONSTRUCTION LOG


# WELL MW-1 (BORING LLP-4 LOCATION)



**GEOSCIENCE MANAGEMENT, INC.**  
 ENVIRONMENTAL CONSULTING SERVICES  
 809 156TH STREET NE  
 ARLINGTON, WA 98223

**PROJECT**  
Lora Lake Apartments  
**CLIENT**  
Port of Seattle  
**DRILLING COMPANY**  
Hollow-stem Auger  
**GEOLOGIST**  
H. W. Small, L.H.G.  
**START DATE** 10/25/2007 **END DATE** 10/25/2007

**DRILLING METHOD**  
Hollow-stem Auger (4.25 ID x 9 OD)  
**SAMPLING METHOD**  
3-in. O.D. Split-Spoon Sampler  
**SURFACE COMPLETION**  
Flush-mount steel monument  
**Elevation Ground:** Not Measured  
**Elevation TOC:** Not Measured  
**Total Boring Depth:** 20 Feet  
**Depth to Water ATD:** 14 Feet

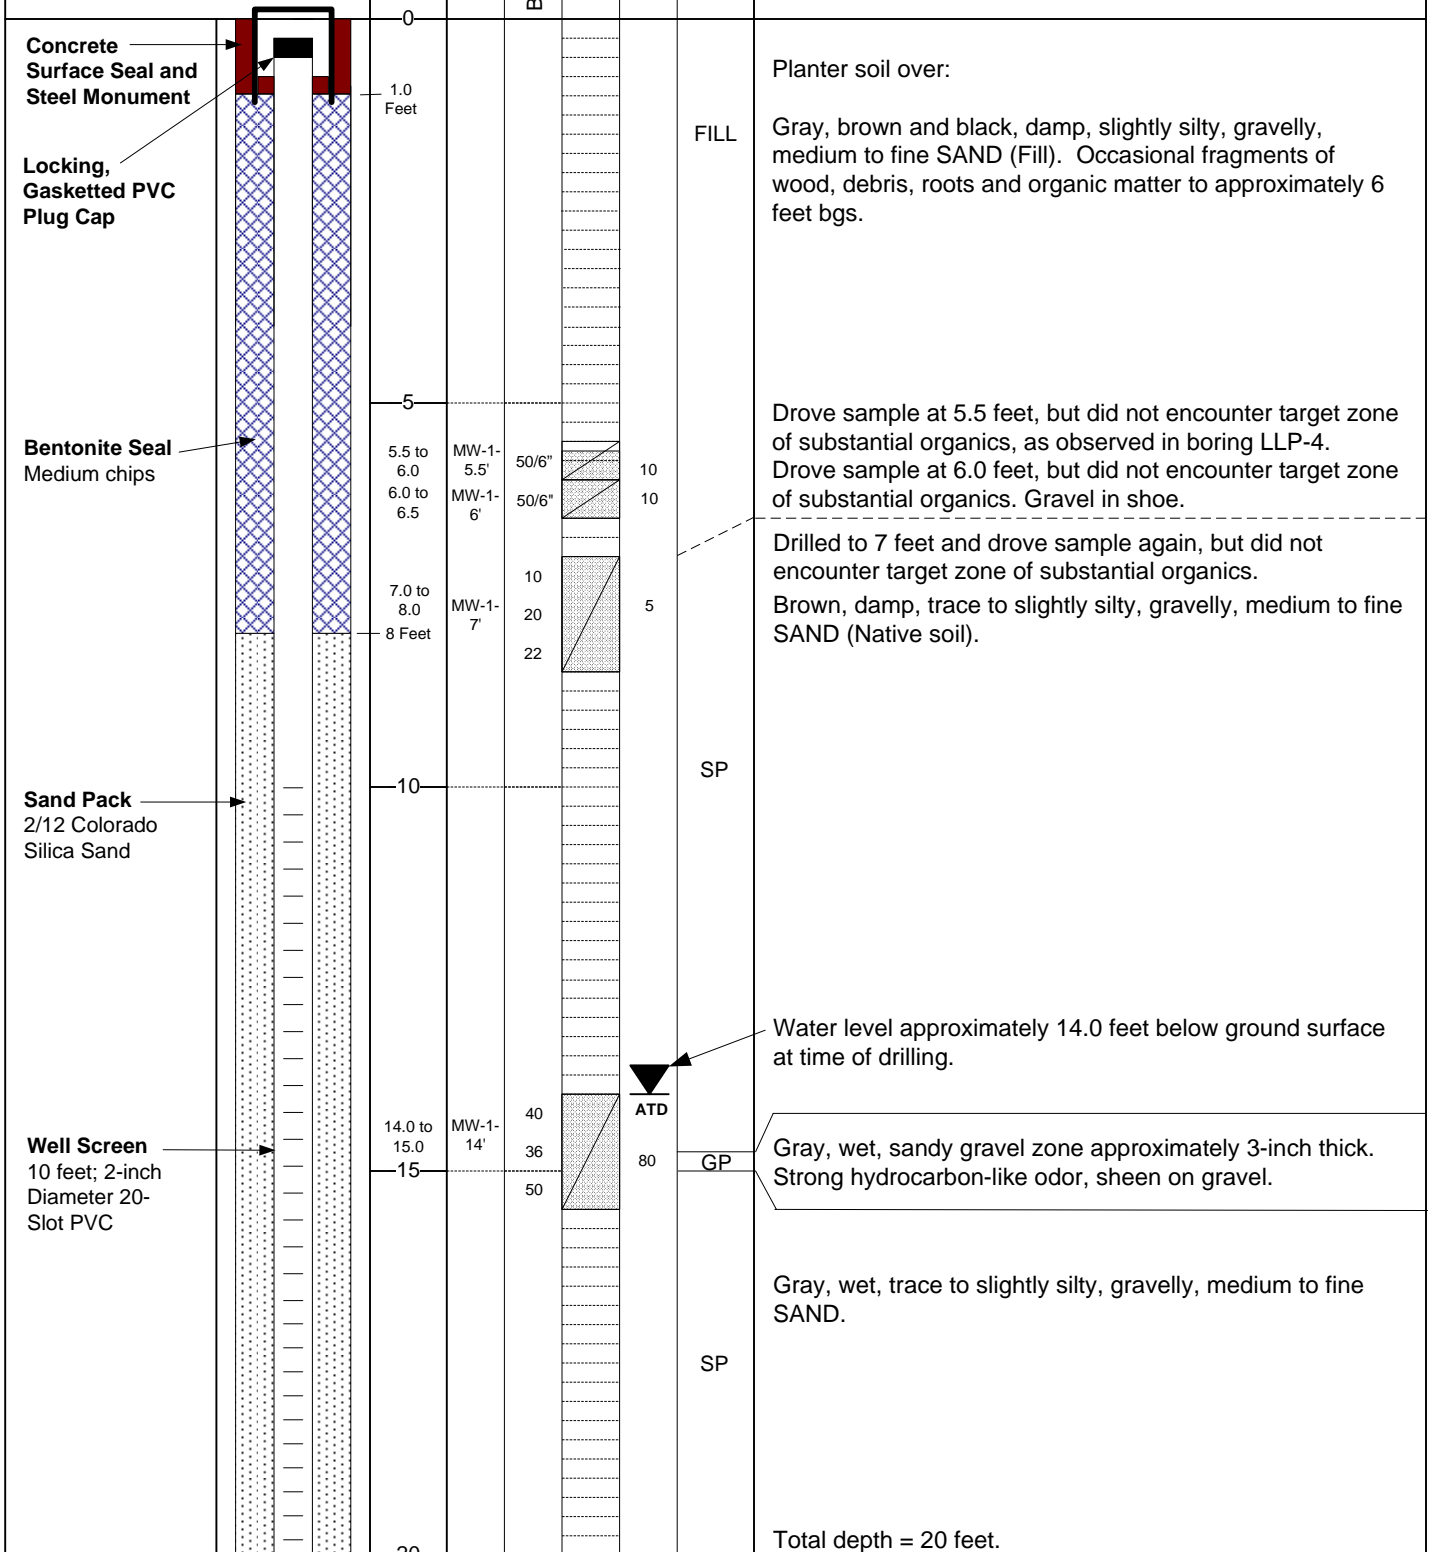

**Construction Notes:** Installed 2-inch diameter PVC well screen from 20 to 10 feet (see as-built diagram this page). Completed at the ground surface in concrete pad with steel, traffic-rated well monument. No water added during drilling except to hydrate bentonite seal.

# Boring/Well Log

Well #: MW-2

Sheet 1 of 2

Project: <b>Lora Lake Apartments</b>	Monument: <b>Flush Mount</b>	Stick Up: -
Project #: <b>05482-025-210</b>	Northing: <b>174871.1516</b> Easting: <b>1271948.3761</b>	Ground Elevation: <b>299.891 ft.</b>
Location: <b>Burien, WA</b>	Drill Rig Type: <b>HSA Limited Access</b>	MP Elevation: -
Client: <b>Port of Seattle</b>	Method: <b>HSA</b>	Total Depth: <b>15.5'</b>
Start Date & Time: <b>3/18/08 0800</b>	Casing ID: <b>2"</b>	Filter Pack: <b>10/20 Silica Sand</b>
Finish Date & Time: <b>3/18/08 0850</b>	Boring ID: <b>8.25"</b>	Seal: <b>Bentonite chips</b>
Contractor: <b>Cascade Drilling Inc.</b>	Bit Type: <b>4.25" HSA</b>	Grout: -
Operator: <b>Curtis Askew</b>	Logged By: <b>R. Knecht/ C. Smith</b>	Screen: <b>0.010" slot Sch. 40 PVC 5-15 ft-bgs</b>

Sample			Well Completion Log	Graphic	Depth (ft.)	Soil and Rock Description Classification Scheme: <b>USCS/ASTM</b>	Elevation(ft.)	Comments & Samples
Type & Number	Depth Range	% Rec						
SS-1	0.0-1.5	66			0	(0.0-0.3) MULCH	295	Flush Mount Monument 2-inch Sch. 40 PVC riser from 0-5 ft-bgs
SS-2	1.5-3.0	72			(0.3-1.5) SP: POORLY GRADED SAND, dark yellowish brown, fine, medium dense, moist. Trace rootlets, and fine, rounded, gravel. No odor or visible contamination.	0.0-0.5' Sampled for analytical		
					(1.5-3.0) SP: POORLY GRADED SAND, light yellowish gray, fine, medium dense, moist. One large, long root, 1/8" in diameter. Trace coarse sand, and rounded, fine gravel, up to 0.5" in diameter. No odor or visible contamination.	1.5-2.0' Sampled for analytical		
					(3.0-4.0) Not Sampled.	Bentonite seal from 2 to 4 ft-bgs		
SS-3	4.0-5.5	66		5	(4.0-5.5) SW: WELL GRADED SAND, yellowish gray grading to dark yellowish gray, fine to medium, dense, moist to wet. Trace fine gravel, up to 3/4" in diameter. No odor or visible contamination.			
					(5.5-6.5) Not Sampled.			
SS-4	6.5-8.0	75			(6.5-8.0) SW: WELL GRADED SAND, yellowish brown, fine to coarse, very dense, wet. Trace rounded, fine gravel, up to 3/4" in diameter. No odor or visible contamination.		6.5-8.0' Sampled for analytical	

<b>Remarks and Datum Used:</b>  AECOM - Environment 710 2nd Ave. Suite 1000 Seattle, WA 98104 Phone: (206) 624-9349 Fax: (206) 623-3793	HSA - Hollow Stem Auger	<b>Sample Type</b> N = SPT DP = Direct Push SS = Split Spoon C = Core	<b>Groundwater</b>		
	Sch. - Schedule		Date	Time	Depth (ft.)
	Amb. - ambient air		03/18/08	0944	6.46'



# Boring/Well Log

Well #: MW-2

Sheet 2 of 2

Project: <b>Lora Lake Apartments</b>	Monument: <b>Flush Mount</b>	Stick Up: -
Project #: <b>05482-025-210</b>	Northing: <b>174871.1516</b> Easting: <b>1271948.3761</b>	Ground Elevation: <b>299.891 ft.</b>
Location: <b>Burien, WA</b>	Drill Rig Type: <b>HSA Limited Access</b>	MP Elevation: -
Client: <b>Port of Seattle</b>	Method: <b>HSA</b>	Total Depth: <b>15.5'</b>
Start Date & Time: <b>3/18/08 0800</b>	Casing ID: <b>2"</b>	Filter Pack: <b>10/20 Silica Sand</b>
Finish Date & Time: <b>3/18/08 0850</b>	Boring ID: <b>8.25"</b>	Seal: <b>Bentonite chips</b>
Contractor: <b>Cascade Drilling Inc.</b>	Bit Type: <b>4.25" HSA</b>	Grout: -
Operator: <b>Curtis Askew</b>	Logged By: <b>R. Knecht/ C. Smith</b>	Screen: <b>0.010" slot Sch. 40 PVC 5-15 ft-bgs</b>

Sample			Well Completion Log	Graphic	Depth (ft.)	Soil and Rock Description Classification Scheme: <b>USCS/ASTM</b>	Elevation(ft.)	Comments & Samples
Type & Number	Depth Range	% Rec						
SS-5	9.0-10.5	66			10	(8.0-9.0) Not Sampled.	290	2-inch diameter 0.010 inch slot, Sch. 40 PVC screen from 5 to 15 ft-bgs
						(9.0-10.5) SW: WELL GRADED SAND, grayish brown, fine to medium, very dense, wet. 10% coarse sand to fine gravel, up to 3/4" in diameter. 10% silt. No odor or visible contamination.		
SS-6	11.5-13.0	83			10	(10.5-11.5) Not Sampled.		10/20 silica sand pack from 4 to 15.5 ft-bgs
						(11.5-13.0) SP: POORLY GRADED SAND, brown to grayish brown, very fine, dense, wet. At 11.5-11.7', sub angular, fine to coarse sand, and coarse gravel, up to 2" long. At 12.25', 4" thick lense of fine sand. No odor or visible contamination.		
SS-7	14.0-15.5	-			15	(13.0-14.0) Not Sampled.	285	14-15.5' Sampled for analytical  Slight heaving sand
						(14.0-15.5) SW: WELL GRADED SAND, brownish gray, fine to medium, very dense, wet.. Sharp contact at 15.3' with sub angular to sub rounded, medium sand. No odor or visible contamination.		

<b>Remarks and Datum Used:</b>  AECOM - Environment 710 2nd Ave. Suite 1000 Seattle, WA 98104 Phone: (206) 624-9349 Fax: (206) 623-3793	<b>HSA - Hollow Stem Auger</b>	<b>Sample Type</b> N = SPT DP = Direct Push SS = Split Spoon C = Core	<b>Groundwater</b>		
	<b>Sch. - Schedule</b>		Date	Time	Depth (ft.)
	<b>Amb. - ambient air</b>		<b>03/18/08</b>	<b>0944</b>	<b>6.46'</b>

# Boring/Well Log

**Well #: MW-3**

**Sheet 1 of 3**

Project: <b>Lora Lake Apartments</b>	Monument: <b>Flush Mount</b>	Stick Up: -
Project #: <b>05482-025-210</b>	Northing: <b>174355.3983</b> Easting: <b>1272271.6255</b>	Ground Elevation: <b>300.36 ft.</b>
Location: <b>Burien, WA</b>	Drill Rig Type: <b>HSA Limited Access</b>	MP Elevation: -
Client: <b>Port of Seattle</b>	Method: <b>HSA</b>	Total Depth: <b>25.5'</b>
Start Date & Time: <b>3/18/08 1015</b>	Casing ID: <b>2"</b>	Filter Pack: <b>10/20 Silica Sand</b>
Finish Date & Time: <b>3/18/08 1115</b>	Boring ID: <b>8.25"</b>	Seal: <b>Bentonite chips</b>
Contractor: <b>Cascade Drilling Inc.</b>	Bit Type: <b>4.25" HSA</b>	Grout: -
Operator: <b>Curtis Askew</b>	Logged By: <b>R. Knecht/ C. Smith</b>	Screen: <b>0.010" slot Sch. 40 PVC 13-23 ft-bgs</b>

Type & Number	Sample		Well Completion Log	Graphic	Depth (ft.)	Soil and Rock Description Classification Scheme: <b>USCS/ASTM</b>	Elevation(ft.)	Comments & Samples
	Depth Range	% Rec						

SS-1	0.0-1.5	66			0	(0.0-0.3) MULCH	300	Flush Mount Monument 2-inch diameter, Sch. 40 PVC riser from 0-13 ft-bgs  0.0-0.5' Sampled for analytical; mulch not included in sample 1.5-2.0' Sampled for analytical  Bentonite seal from 2 to 11 ft-bgs
SS-2	1.5-3.0	72				(0.3-1.5) SP: POORLY GRADED SAND, dark yellowish brown to yellowish brown, fine, dense, moist. 10% medium to coarse sand and rounded, fine to coarse gravel, up to 1.5" long. Trace rootlets. No odor or visible contamination.		
						(1.5-3.0) SP: POORLY GRADED SAND, brown to slightly dark brown, fine, dense, moist. 10% medium to coarse sand. Trace, elongated, fine to coarse gravel, up to 1.5" long. No odor or visible contamination.		
SS-3	4.0-5.5	66				(3.0-4.0) Not Sampled.		
					5	(4.0-4.6) SP: POORLY GRADED SAND, brown to dark brown, fine, dense, moist. 10% rounded to sub rounded, elongate, coarse sand and fine gravel, up to 0.5" long. No odor or visible contamination.	295	
SS-4	6.5-8.0	75				(4.6-5.5) SW: WELL GRADED SAND, yellowish brown, fine to medium, dense, moist. Trace rounded, coarse sand and fine gravel, up to 0.5" in diameter. No odor or visible contamination.		6.5-8.0' Sampled for analytical
						(5.5-6.5) Not Sampled.		
						(6.5-7.5) SP: POORLY GRADED SAND, brown to dark brown, fine, very dense, moist. 20% medium to coarse sand. 10% rounded, fine gravel, up to 1/4" in diameter. No odor or visible contamination.		
SS-5	9.0-10.5	66				(7.5-8.0) SW: WELL GRADED SAND, yellowish brown, fine to medium. Trace rounded coarse sand and fine gravel, up to 1/2" long. No odor or visible contamination.		
					10	(8.0-9.0) Not Sampled.		

<b>Remarks and Datum Used:</b>  AECOM - Environment 710 2nd Ave. Suite 1000 Seattle, WA 98104 Phone: (206) 624-9349 Fax: (206) 623-3793	HSA - Hollow Stem Auger	<b>Sample Type</b> N = SPT DP = Direct Push SS = Split Spoon C = Core	<b>Groundwater</b>		
	Sch. - Schedule		Date	Time	Depth (ft.)
	Amb. - ambient air		03/18/08	1220	17.46'


# Boring/Well Log

Well #: MW-3

Sheet 2 of 3

Project: <b>Lora Lake Apartments</b>	Monument: <b>Flush Mount</b>	Stick Up: -
Project #: <b>05482-025-210</b>	Northing: <b>174355.3983</b> Easting: <b>1272271.6255</b>	Ground Elevation: <b>300.36 ft.</b>
Location: <b>Burien, WA</b>	Drill Rig Type: <b>HSA Limited Access</b>	MP Elevation: -
Client: <b>Port of Seattle</b>	Method: <b>HSA</b>	Total Depth: <b>25.5'</b>
Start Date & Time: <b>3/18/08 1015</b>	Casing ID: <b>2"</b>	Filter Pack: <b>10/20 Silica Sand</b>
Finish Date & Time: <b>3/18/08 1115</b>	Boring ID: <b>8.25"</b>	Seal: <b>Bentonite chips</b>
Contractor: <b>Cascade Drilling Inc.</b>	Bit Type: <b>4.25" HSA</b>	Grout: -
Operator: <b>Curtis Askw</b>	Logged By: <b>R. Knecht/ C. Smith</b>	Screen: <b>0.010" slot Sch. 40 PVC 13-23 ft-bgs</b>

Type & Number	Sample		Well Completion Log	Graphic	Depth (ft.)	Soil and Rock Description Classification Scheme: <b>USCS/ASTM</b>	Elevation(ft.)	Comments & Samples
	Depth Range	% Rec						

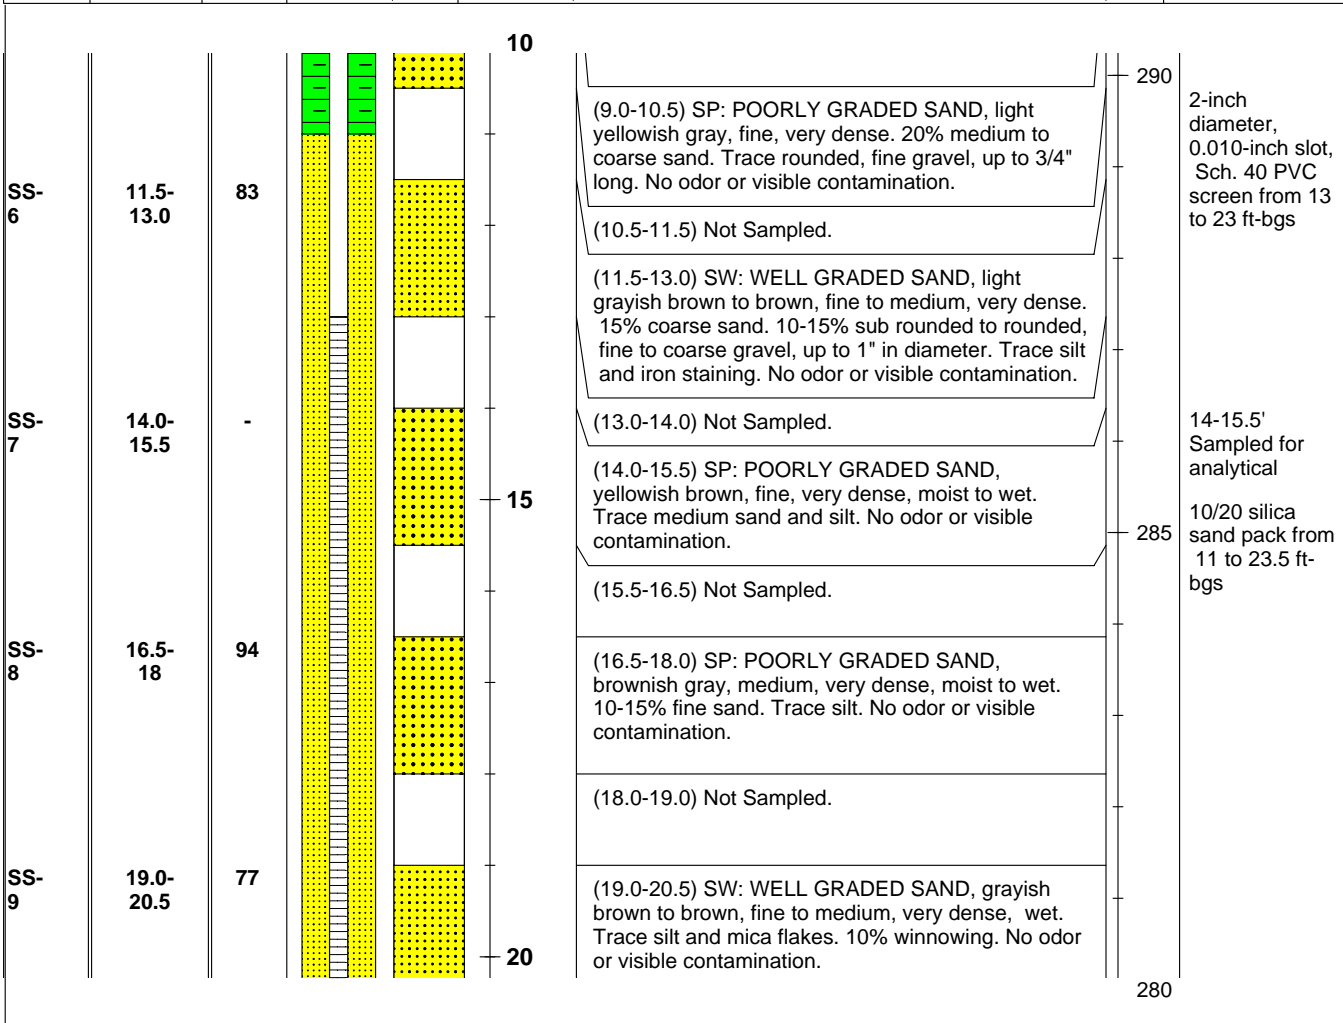

<b>Remarks and Datum Used:</b>  AECOM - Environment 710 2nd Ave. Suite 1000 Seattle, WA 98104 Phone: (206) 624-9349 Fax: (206) 623-3793	<b>HSA - Hollow Stem Auger</b>	<b>Sample Type</b> N = SPT DP = Direct Push SS = Split Spoon C = Core	<b>Groundwater</b>		
	<b>Sch. - Schedule</b>		Date	Time	Depth (ft.)
	<b>Amb. - ambient air</b>		<b>03/18/08</b>	<b>1220</b>	<b>17.46'</b>





# Boring/Well Log

Well #: MW-3

Sheet 3 of 3

Project: <b>Lora Lake Apartments</b>	Monument: <b>Flush Mount</b>	Stick Up: -
Project #: <b>05482-025-210</b>	Northing: <b>174355.3983</b> Easting: <b>1272271.6255</b>	Ground Elevation: <b>300.36 ft.</b>
Location: <b>Burien, WA</b>	Drill Rig Type: <b>HSA Limited Access</b>	MP Elevation: -
Client: <b>Port of Seattle</b>	Method: <b>HSA</b>	Total Depth: <b>25.5'</b>
Start Date & Time: <b>3/18/08 1015</b>	Casing ID: <b>2"</b>	Filter Pack: <b>10/20 Silica Sand</b>
Finish Date & Time: <b>3/18/08 1115</b>	Boring ID: <b>8.25"</b>	Seal: <b>Bentonite chips</b>
Contractor: <b>Cascade Drilling Inc.</b>	Bit Type: <b>4.25" HSA</b>	Grout: -
Operator: <b>Curtis Askew</b>	Logged By: <b>R. Knecht/ C. Smith</b>	Screen: <b>0.010" slot Sch. 40 PVC 13-23 ft-bgs</b>

Type & Number	Sample		Well Completion Log	Graphic	Depth (ft.)	Soil and Rock Description Classification Scheme: <b>USCS/ASTM</b>	Elevation(ft.)	Comments & Samples
	Depth Range	% Rec						

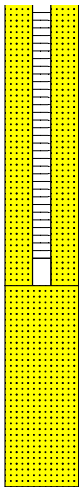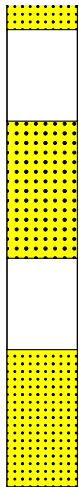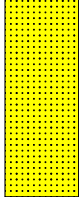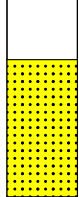SS-10	21.5-23.0	92			25	(20.5-21.5) Not Sampled.	280	
						(21.5-23.0) SP: POORLY GRADED SAND, gray to bluish gray, fine, very dense, wet. Abundant wood pieces. Trace large, mica flakes. 2mm thick lamination in soil layer. Very slight H2S-like odor. No visible contamination.		
						(23.0-24.0) Not Sampled.		
SS-11	24.0-25.5	100				(24.0-25.5) SW: WELL GRADED SAND, slightly yellowish brown to gray, medium to fine, very dense, wet. Iron stained beds, up to 1/4" thick at top of interval. No odor or visible contamination.	275	heaving sand, filled top foot of SS-11 with slough

<b>Remarks and Datum Used:</b>  AECOM - Environment 710 2nd Ave. Suite 1000 Seattle, WA 98104 Phone: (206) 624-9349 Fax: (206) 623-3793		<b>Sample Type</b> N = SPT DP = Direct Push SS = Split Spoon C = Core	<b>Groundwater</b>			
	HSA - Hollow Stem Auger  Sch. - Schedule  Amb. - ambient air		Date	Time	Depth (ft.)	
			03/18/08	1220	17.46'	

# Boring/Well Log

Well #: **MW-4**

Sheet 1 of 3

Project: <b>Lora Lake Apartments</b>	Monument: <b>Flush Mount</b>	Stick Up: -
Project #: <b>05482-025-210</b>	Northing: <b>174435.4039</b> Easting: <b>1272496.5424</b>	Ground Elevation: <b>294.562 ft.</b>
Location: <b>Burien, WA</b>	Drill Rig Type: <b>HSA Limited Access</b>	MP Elevation: -
Client: <b>Port of Seattle</b>	Method: <b>HSA</b>	Total Depth: <b>26'</b>
Start Date & Time: <b>3/17/08 1400</b>	Casing ID: <b>2"</b>	Filter Pack: <b>10/20 Silica Sand</b>
Finish Date & Time: <b>3/17/08 1515</b>	Boring ID: <b>8.25"</b>	Seal: <b>Bentonite chips</b>
Contractor: <b>Cascade Drilling Inc.</b>	Bit Type: <b>4.25" HSA</b>	Grout: -
Operator: <b>Curtis Askew</b>	Logged By: <b>R. Knecht/ C. Smith</b>	Screen: <b>0.010" slot Sch. 40 PVC 11-25.75 ft-bgs</b>

Sample Type & Number	Depth Range	% Rec	Well Completion Log	Graphic	Depth (ft.)	Soil and Rock Description Classification Scheme: <b>USCS/ASTM</b>	Elevation(ft.)	Comments & Samples
SS-1	0.0-1.5	66			0	(0.0-1.5) SW: SAND, brown, fine to medium, medium dense, moist. 20% rounded, coarse sand to fine gravel. Trace silt and rounded, coarse gravel, up to 1" long. Abundant grass and rootlets from 0.0-0.2'. Moderate organic-like odor, no visible contamination.	0	Flush Mount Monument 2-inch diameter, Sch. 40 PVC riser from 0 to 11 ft-bgs  0.0-0.5' Sampled for analytical  1.5-2.0' Sampled for analytical  Bentonite seal from 2 to 9 ft-bgs
SS-2	1.5-3.0	72				(1.5-2.0) SP: POORLY GRADED SAND, brown, fine, medium dense, moist. 15% silt. Trace rounded, fine, gravel. Organic-like odor, no visible contamination.  (2.0-3.0) SP: POORLY GRADED SAND, yellowish brown with pockets of gray from 2.5-3', fine, medium dense, moist. 20% medium sand from 2-2.5'. Trace rounded, fine gravel. No odor or visible contamination.		
SS-3	4.0-5.5	66			5	(3.0-4.0) Not Sampled.  (4.0-5.5) SP: POORLY GRADED SAND, yellowish brown grading to light yellowish brown at 5.0', fine, medium dense, moist. 20% medium sand from 4-5'. Trace rounded, fine gravel, content decreases downhole. Trace rootlets at 4.5'. No odor or visible contamination.	290	
SS-4	6.5-8.0	75				(5.5-6.5) Not Sampled.  (6.5-8.0) SP: POORLY GRADED SAND, yellowish brown, medium, very dense, moist. 20% rounded, fine to coarse gravel. Trace rootlets. No odor or visible contamination.		
						(8.0-9.0) Not Sampled.		

<b>Remarks and Datum Used:</b>  AECOM - Environment 710 2nd Ave. Suite 1000 Seattle, WA 98104 Phone: (206) 624-9349 Fax: (206) 623-3793	HSA - Hollow Stem Auger	<b>Sample Type</b> N = SPT DP = Direct Push SS = Split Spoon C = Core	<b>Groundwater</b>		
	Sch. - Schedule		Date	Time	Depth (ft.)
	-		03/17/08	1644	15.70'

# Boring/Well Log

Well #: **MW-4**

Sheet 2 of 3

Project: <b>Lora Lake Apartments</b>	Monument: <b>Flush Mount</b>	Stick Up: -
Project #: <b>05482-025-210</b>	Northing: <b>174435.4039</b> Easting: <b>1272496.5424</b>	Ground Elevation: <b>294.562 ft.</b>
Location: <b>Burien, WA</b>	Drill Rig Type: <b>HSA Limited Access</b>	MP Elevation: -
Client: <b>Port of Seattle</b>	Method: <b>HSA</b>	Total Depth: <b>26'</b>
Start Date & Time: <b>3/17/08 1400</b>	Casing ID: <b>2"</b>	Filter Pack: <b>10/20 Silica Sand</b>
Finish Date & Time: <b>3/17/08 1515</b>	Boring ID: <b>8.25"</b>	Seal: <b>Bentonite chips</b>
Contractor: <b>Cascade Drilling Inc.</b>	Bit Type: <b>4.25" HSA</b>	Grout: -
Operator: <b>Curtis Askew</b>	Logged By: <b>R. Knecht/ C. Smith</b>	Screen: <b>0.010" slot Sch. 40 PVC 11-25.75 ft-bgs</b>

Sample Type & Number	Sample		Well Completion Log	Graphic	Depth (ft.)	Soil and Rock Description Classification Scheme: <b>USCS/ASTM</b>	Elevation(ft.)	Comments & Samples
	Depth Range	% Rec						
SS-5	9.0-10.5	66			10	(9.0-10.5) SW: WELL GRADED SAND WITH GRAVEL, brown to yellowish brown, fine to coarse, very dense, moist. 30% rounded to sub rounded, flat, elongate, fine to coarse gravel, up to 1" long. Slight sweet odor, no visible contamination.	285	9.5-10.5' Sampled for analytical
						(10.5-11.5) Not Sampled.		
SS-6	11.5-13.0	83				(11.5-13.0) SP: POORLY GRADED SAND, slightly yellowish brown grading to yellowish gray, fine, dense, moist. Few 0.5" thick lenses of very fine sand. Trace coarse sand. No odor or visible contamination.		2-inch diameter, 0.010-inch slot, Sch. 40 PVC screen from 11 to 25.75 ft-bgs
						(13.0-14.0) Not Sampled.		
SS-7	14.0-15.5	-			15	(14.0-15.5) SP: POORLY GRADED SAND, brownish gray, fine, very dense, moist. 10-15% silt. Trace mica. No odor or visible contamination.	280	14-15.5' Sampled for analytical
						(15.5-16.5) Not Sampled.		
SS-8	16.5-18	94				(16.5-18.0) SP: POORLY GRADED SAND, gray to grayish brown, fine, very dense, moist. 20% medium sand at 16.75-17'. Little iron staining at 17.5-18'. At 17.9', 4mm thick black and iron stained bed. No odor or visible contamination.		10/20 silica sand pack from 9 to 26 ft-bgs

<b>Remarks and Datum Used:</b>  AECOM - Environment 710 2nd Ave. Suite 1000 Seattle, WA 98104 Phone: (206) 624-9349 Fax: (206) 623-3793	HSA - Hollow Stem Auger	<b>Sample Type</b> N = SPT DP = Direct Push SS = Split Spoon C = Core	<b>Groundwater</b>		
	Sch. - Schedule		Date	Time	Depth (ft.)
	-		03/17/08	1644	15.70'


# Boring/Well Log

Well #: MW-4

Sheet 3 of 3

Project: <b>Lora Lake Apartments</b>	Monument: <b>Flush Mount</b>	Stick Up: -
Project #: <b>05482-025-210</b>	Northing: <b>174435.4039</b> Easting: <b>1272496.5424</b>	Ground Elevation: <b>294.562 ft.</b>
Location: <b>Burien, WA</b>	Drill Rig Type: <b>HSA Limited Access</b>	MP Elevation: -
Client: <b>Port of Seattle</b>	Method: <b>HSA</b>	Total Depth: <b>26'</b>
Start Date & Time: <b>3/17/08 1400</b>	Casing ID: <b>2"</b>	Filter Pack: <b>10/20 Silica Sand</b>
Finish Date & Time: <b>3/17/08 1515</b>	Boring ID: <b>8.25"</b>	Seal: <b>Bentonite chips</b>
Contractor: <b>Cascade Drilling Inc.</b>	Bit Type: <b>4.25" HSA</b>	Grout: -
Operator: <b>Curtis Askew</b>	Logged By: <b>R. Knecht/ C. Smith</b>	Screen: <b>0.010" slot Sch. 40 PVC 11-25.75 ft-bgs</b>

Type & Number	Sample		Well Completion Log	Graphic	Depth (ft.)	Soil and Rock Description Classification Scheme: <b>USCS/ASTM</b>	Elevation(ft.)	Comments & Samples
	Depth Range	% Rec						

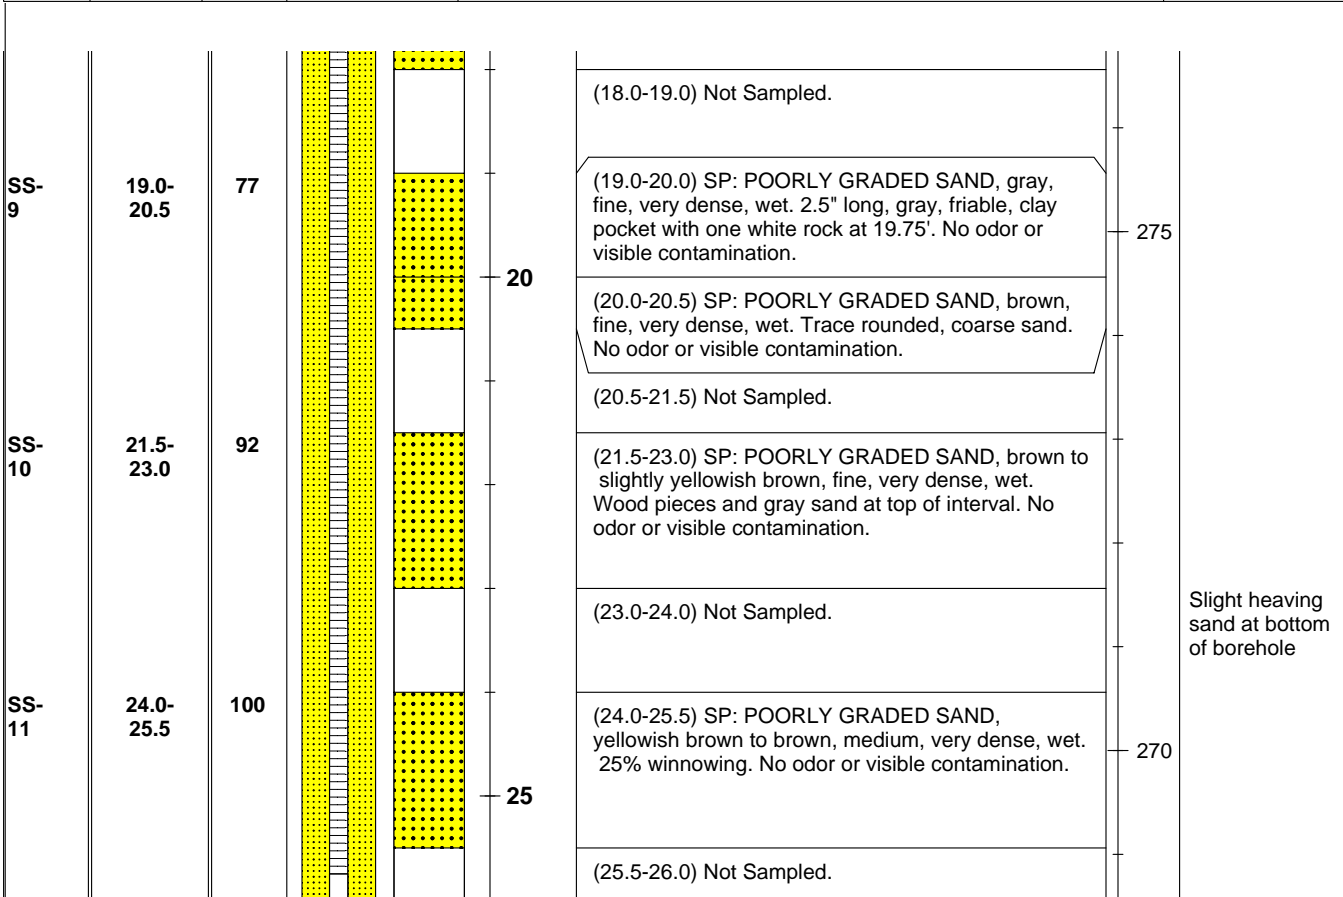

Remarks and Datum Used:		Sample Type	Groundwater		
AECOM - Environment 710 2nd Ave. Suite 1000 Seattle, WA 98104 Phone: (206) 624-9349 Fax: (206) 623-3793	HSA - Hollow Stem Auger	N = SPT	Date	Time	Depth (ft.)
	Sch. - Schedule	DP = Direct Push	03/17/08	1644	15.70'
	-	SS = Split Spoon			
		C = Core			

# Boring/Well Log

Well #: **MW-5**

Sheet 1 of 3

Project: <b>Lora Lake Apartments</b>	Monument: <b>Flush Mount</b>	Stick Up: -
Project #: <b>05482-025-210</b>	Northing: <b>174563.4071</b> Easting: <b>1272562.8511</b>	Ground Elevation: <b>295.151'</b>
Location: <b>Burien, WA</b>	Drill Rig Type: <b>HSA Limited Access</b>	MP Elevation: -
Client: <b>Port of Seattle</b>	Method: <b>HSA</b>	Total Depth: <b>28'</b>
Start Date & Time: <b>3/17/08 1025</b>	Casing ID: <b>2"</b>	Filter Pack: <b>10/20 Silica Sand</b>
Finish Date & Time: <b>3/17/08 1210</b>	Boring ID: <b>8.25"</b>	Seal: <b>Bentonite chips</b>
Contractor: <b>Cascade Drilling Inc.</b>	Bit Type: <b>4.25" HSA</b>	Grout: -
Operator: <b>Curtis Askew</b>	Logged By: <b>R. Knecht/ C. Smith</b>	Screen: <b>0.010" slot Sch. 40 PVC 13-28 ft-bgs</b>

Sample			Well Completion Log	Graphic	Depth (ft.)	Soil and Rock Description Classification Scheme: <b>USCS/ASTM</b>	Elevation(ft.)	Comments & Samples
Type & Number	Depth Range	% Rec						
SS-1	0.0-1.5	66			0	(0.0-1.5) SP: POORLY GRADED SAND, brown to dark brown, fine, loose, moist. 15% rounded, fine gravel, 0.25-0.5" long. One rounded gravel, 3" in diameter. Trace straw. No odor or visible contamination.	295	Flush Mount Monument 2-inch diameter Sch. 40 PVC riser from 0 to 13 ft-bgs
SS-2	1.5-3.0	100			(1.5-3.0) SP: POORLY GRADED SAND, yellowish brown, fine, dense, moist. Trace coarse sand to fine gravel, rounded, up to 0.5" long. No odor or visible contamination.		0.0-0.5' Sampled for analytical	
					(3.0-4.0) Not Sampled.		1.5-2.0' Sampled for analytical	
SS-3	4.0-5.5	91			(4.0-5.5) SW: WELL GRADED SAND, yellowish brown, fine to medium, very dense, moist. 20% sub rounded, gravel, up to 1/2" in diameter. Gravel content increases to 30% with depth. No odor or visible contamination.	5	290	Bentonite seal from 2 to 11 ft-bgs
					(5.5-6.5) Not Sampled.			
SS-4	6.5-8.0	100	(6.5-8.0) SM: SILTY SAND, gray to slightly brownish gray, fine, very dense, moist. 20% silt. 10% rounded, sand and fine gravel. One gravel up to 2" long. No odor or visible contamination.			6.5-8.0' Sampled for analytical		
			(8.0-9.0) Not Sampled.					
SS-5	9.0-10.5	75	(9.0-10.5) SW: WELL GRADED SAND, gray to brownish gray, fine to medium, very dense, moist to wet. Trace coarse sand, fine gravel, and 1" thick pockets of silt and very fine sand. Trace hydrocarbon-like odor in 0.5" thick silt lense at 10.5'. No visible contamination.	10	285			

<b>Remarks and Datum Used:</b>  AECOM - Environment 710 2nd Ave. Suite 1000 Seattle, WA 98104 Phone: (206) 624-9349 Fax: (206) 623-3793	HSA - Hollow Stem Auger	<b>Sample Type</b> N = SPT DP = Direct Push SS = Split Spoon C = Core	<b>Groundwater</b>		
	Sch. - Schedule		Date	Time	Depth (ft.)
	-		03/17/08	1332	20.27'




# Boring/Well Log

Well #: MW-5

Sheet 2 of 3

Project: <b>Lora Lake Apartments</b>	Monument: <b>Flush Mount</b>	Stick Up: -
Project #: <b>05482-025-210</b>	Northing: <b>174563.4071</b> Easting: <b>1272562.8511</b>	Ground Elevation: <b>295.151'</b>
Location: <b>Burien, WA</b>	Drill Rig Type: <b>HSA Limited Access</b>	MP Elevation: -
Client: <b>Port of Seattle</b>	Method: <b>HSA</b>	Total Depth: <b>28'</b>
Start Date & Time: <b>3/17/08 1025</b>	Casing ID: <b>2"</b>	Filter Pack: <b>10/20 Silica Sand</b>
Finish Date & Time: <b>3/17/08 1210</b>	Boring ID: <b>8.25"</b>	Seal: <b>Bentonite chips</b>
Contractor: <b>Cascade Drilling Inc.</b>	Bit Type: <b>4.25" HSA</b>	Grout: -
Operator: <b>Curtis Askew</b>	Logged By: <b>R. Knecht/ C. Smith</b>	Screen: <b>0.010" slot Sch. 40 PVC 13-28 ft-bgs</b>

Type & Number	Sample		Well Completion Log	Graphic	Depth (ft.)	Soil and Rock Description Classification Scheme: <b>USCS/ASTM</b>	Elevation(ft.)	Comments & Samples
	Depth Range	% Rec						

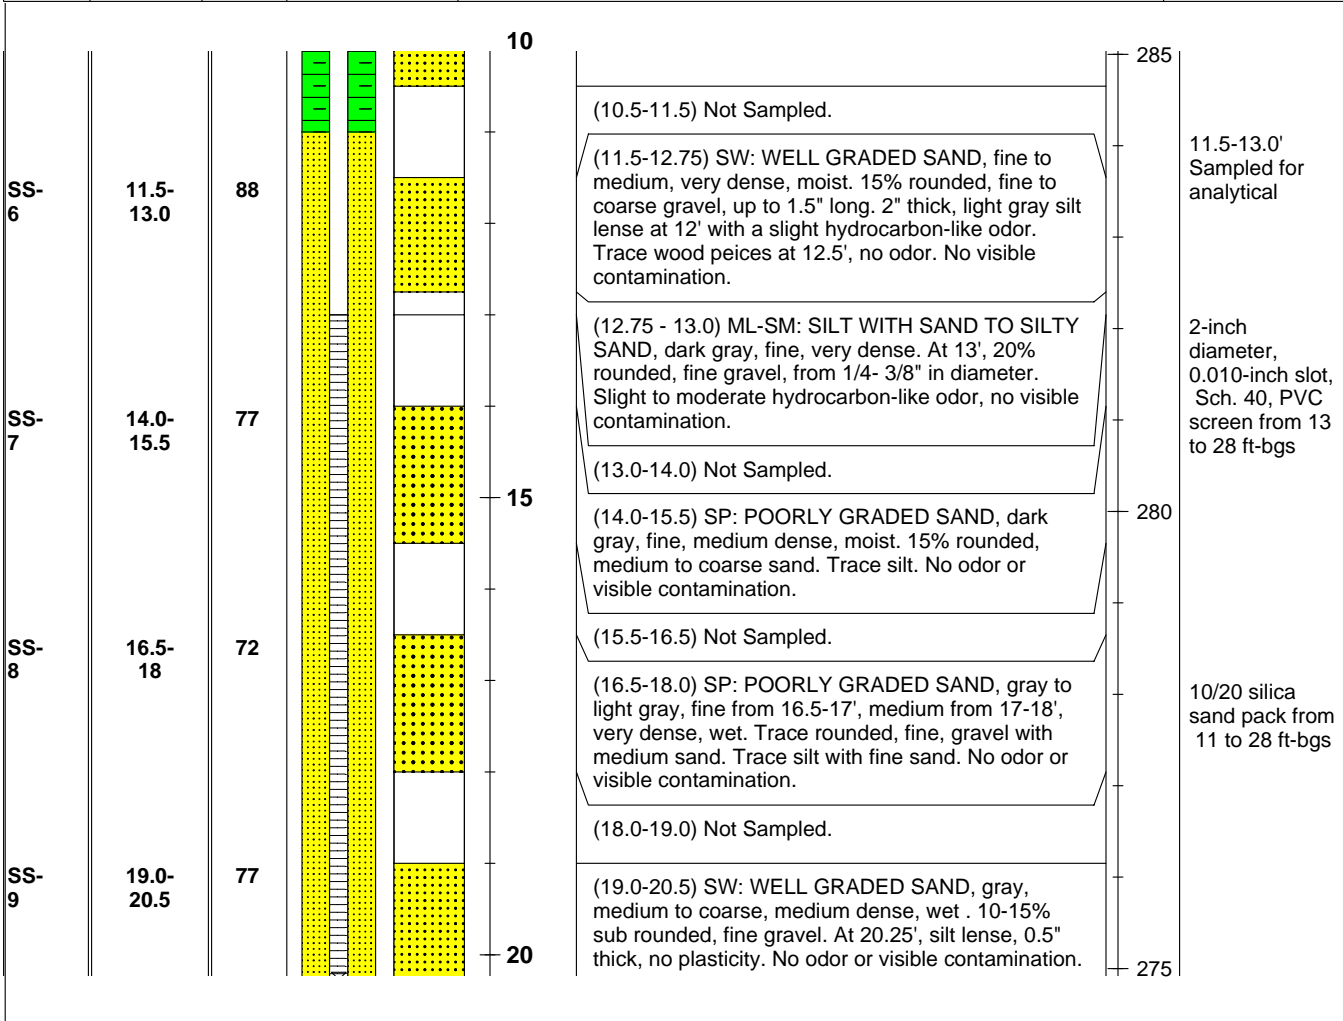

<b>Remarks and Datum Used:</b>  AECOM - Environment 710 2nd Ave. Suite 1000 Seattle, WA 98104 Phone: (206) 624-9349 Fax: (206) 623-3793	HSA - Hollow Stem Auger	<b>Sample Type</b> N = SPT DP = Direct Push SS = Split Spoon C = Core	<b>Groundwater</b>		
	Sch. - Schedule		Date	Time	Depth (ft.)
	-		03/17/08	1332	20.27'


# Boring/Well Log

Well #: MW-5

Sheet 3 of 3

Project: <b>Lora Lake Apartments</b>	Monument: <b>Flush Mount</b>	Stick Up: -
Project #: <b>05482-025-210</b>	Northing: <b>174563.4071</b> Easting: <b>1272562.8511</b>	Ground Elevation: <b>295.151'</b>
Location: <b>Burien, WA</b>	Drill Rig Type: <b>HSA Limited Access</b>	MP Elevation: -
Client: <b>Port of Seattle</b>	Method: <b>HSA</b>	Total Depth: <b>28'</b>
Start Date & Time: <b>3/17/08 1025</b>	Casing ID: <b>2"</b>	Filter Pack: <b>10/20 Silica Sand</b>
Finish Date & Time: <b>3/17/08 1210</b>	Boring ID: <b>8.25"</b>	Seal: <b>Bentonite chips</b>
Contractor: <b>Cascade Drilling Inc.</b>	Bit Type: <b>4.25" HSA</b>	Grout: -
Operator: <b>Curtis Askew</b>	Logged By: <b>R. Knecht/ C. Smith</b>	Screen: <b>0.010" slot Sch. 40 PVC 13-28 ft-bgs</b>

Type & Number	Sample		Well Completion Log	Graphic	Depth (ft.)	Soil and Rock Description Classification Scheme: <b>USCS/ASTM</b>	Elevation(ft.)	Comments & Samples
	Depth Range	% Rec						

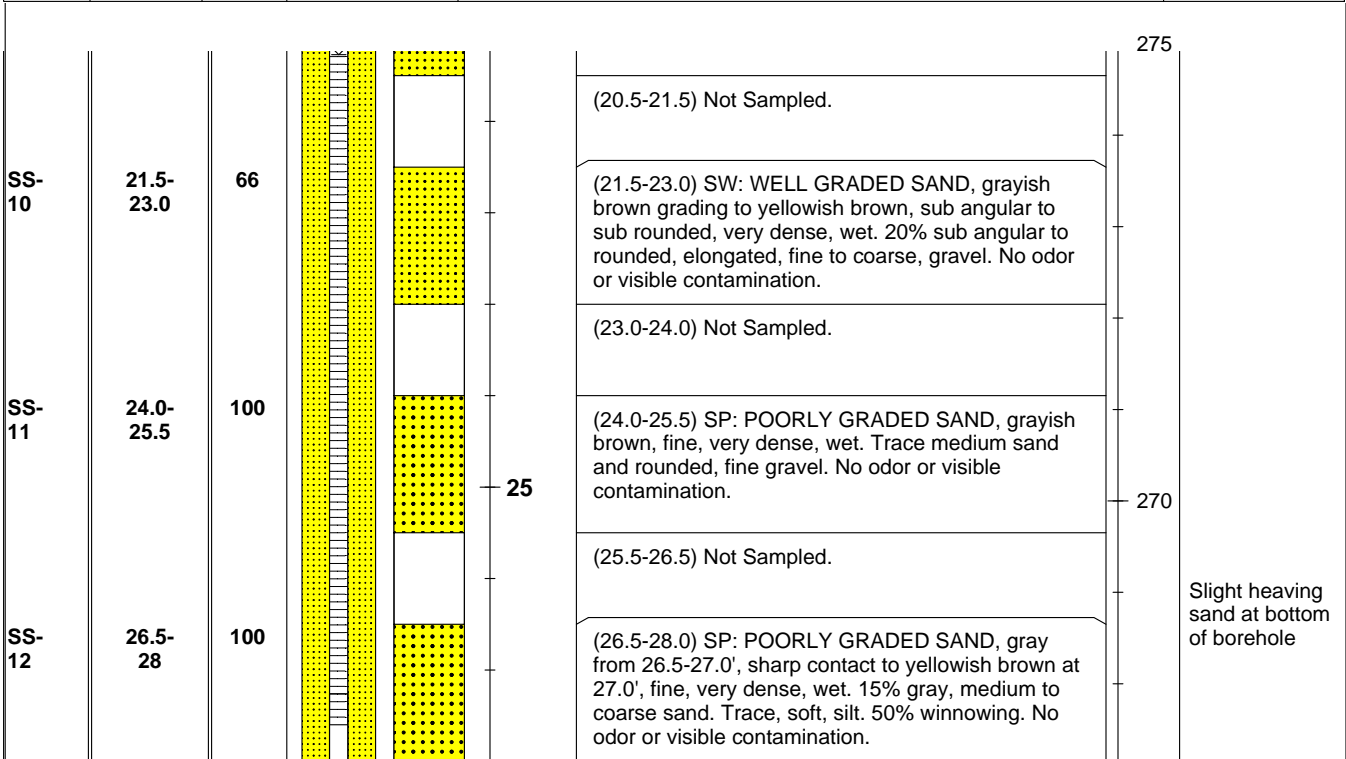

<b>Remarks and Datum Used:</b>  AECOM - Environment 710 2nd Ave. Suite 1000 Seattle, WA 98104 Phone: (206) 624-9349 Fax: (206) 623-3793	HSA - Hollow Stem Auger	<b>Sample Type</b> N = SPT DP = Direct Push SS = Split Spoon C = Core	<b>Groundwater</b>		
	Sch. - Schedule		Date	Time	Depth (ft.)
	-		03/17/08	1332	20.27'

# Boring/Well Log

Well #: MW-6

Sheet 1 of 3

Project: <b>Lora Lake Apartments</b>	Monument: <b>Flush Mount</b>	Stick Up: -
Project #: <b>05482-025-210</b>	Northing: <b>174850.9922</b> Easting: <b>1272784.1135</b>	Ground Elevation: <b>291.083'</b>
Location: <b>Burien, WA</b>	Drill Rig Type: <b>HSA Limited Access</b>	MP Elevation: -
Client: <b>Port of Seattle</b>	Method: <b>HSA</b>	Total Depth: <b>20.5'</b>
Start Date & Time: <b>3/18/08 1344</b>	Casing ID: <b>2"</b>	Filter Pack: <b>10/20 Silica Sand</b>
Finish Date & Time: <b>3/18/08 1445</b>	Boring ID: <b>8.25"</b>	Seal: <b>Bentonite chips</b>
Contractor: <b>Cascade Drilling Inc.</b>	Bit Type: <b>4.25" HSA</b>	Grout: -
Operator: <b>Curtis Askew</b>	Logged By: <b>R. Knecht/ C. Smith</b>	Screen: <b>0.010" slot Sch. 40 PVC 5-15 ft-bgs</b>

Type & Number	Sample		Well Completion Log	Graphic	Depth (ft.)	Soil and Rock Description Classification Scheme: <b>USCS/ASTM</b>	Elevation(ft.)	Comments & Samples
	Depth Range	% Rec						

SS-1	0.0-1.5	83			0	(0.0-1.5) SP: POORLY GRADED SAND, brown, fine, medium dense, moist. 20-25% silt. 10% medium to coarse sand. Trace fine gravel, up to 1/4" in diameter. Abundant rootlets throughout, grass on top. Moderate organic odor, no visible contamination.	290	Flush Mount Monument 2-inch diameter Sch. 40 PVC riser from 0 to 5 ft-bgs
SS-2	1.5-3.0	66			(1.5-3.0) SP: POORLY GRADED SAND, brown to slightly dark brown, fine, very dense, moist. 20% silt. Trace rounded, coarse sand to fine gravel. Little rootlets. Friable. Moderate organic odor, no visible contamination.			
					(3.0-4.0) Not Sampled.			
SS-3	4.0-5.5	66			(4.0-5.5) SP: POORLY GRADED SAND, slightly reddish brown, fine, loose, moist. 10-15% medium to coarse sand. Trace rounded, fine gravel, up to 3/4" in diameter. Trace rootlets in catcher. No odor or visible contamination.			
					(5.5-6.5) Not Sampled.			
				5			285	0.0-0.5' Sampled for analytical
SS-4	6.5-8.0	72	(6.5-8.0) SP: POORLY GRADED SAND, reddish brown grading to light reddish brown, fine, medium dense, moist. Trace fine gravel, up to 1/2" in diameter. No odor or visible contamination.					
			(8.0-9.0) Not Sampled.					
SS-5	9.0-10.5	94			10	(9.0-10.5) SP: POORLY GRADED SAND, gray with iron staining, fine, dense, moist. Trace organic matter and silt. No odor or visible contamination.		6.5-8.0' Sampled for analytical
								Bentonite seal

<b>Remarks and Datum Used:</b>  AECOM - Environment 710 2nd Ave. Suite 1000 Seattle, WA 98104 Phone: (206) 624-9349 Fax: (206) 623-3793	HSA - Hollow Stem Auger	<b>Sample Type</b> N = SPT DP = Direct Push SS = Split Spoon C = Core	<b>Groundwater</b>		
	Sch. - Schedule		Date	Time	Depth (ft.)
	Amb. - ambient air		03/18/08	1553	12.51'


# Boring/Well Log

Well #: MW-6

Sheet 2 of 3

Project: <b>Lora Lake Apartments</b>	Monument: <b>Flush Mount</b>	Stick Up: -
Project #: <b>05482-025-210</b>	Northing: <b>174850.9922</b> Easting: <b>1272784.1135</b>	Ground Elevation: <b>291.083'</b>
Location: <b>Burien, WA</b>	Drill Rig Type: <b>HSA Limited Access</b>	MP Elevation: -
Client: <b>Port of Seattle</b>	Method: <b>HSA</b>	Total Depth: <b>20.5'</b>
Start Date & Time: <b>3/18/08 1344</b>	Casing ID: <b>2"</b>	Filter Pack: <b>10/20 Silica Sand</b>
Finish Date & Time: <b>3/18/08 1445</b>	Boring ID: <b>8.25"</b>	Seal: <b>Bentonite chips</b>
Contractor: <b>Cascade Drilling Inc.</b>	Bit Type: <b>4.25" HSA</b>	Grout: -
Operator: <b>Curtis Askew</b>	Logged By: <b>R. Knecht/ C. Smith</b>	Screen: <b>0.010" slot Sch. 40 PVC 5-15 ft-bgs</b>

Type & Number	Sample		Well Completion Log	Graphic	Depth (ft.)	Soil and Rock Description Classification Scheme: <b>USCS/ASTM</b>	Elevation(ft.)	Comments & Samples
	Depth Range	% Rec						

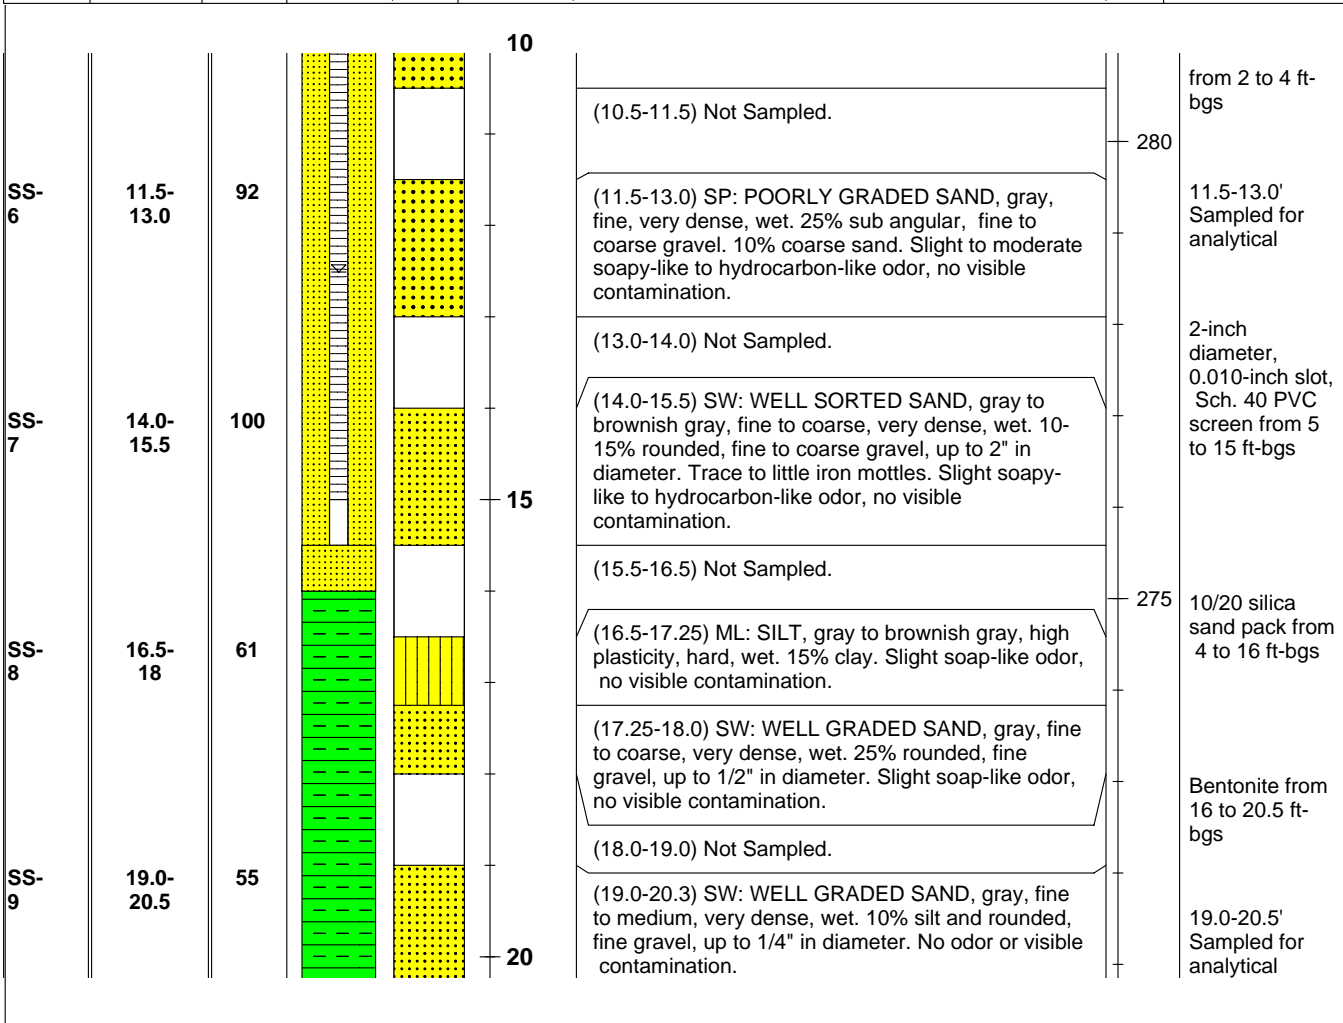

<b>Remarks and Datum Used:</b>  AECOM - Environment 710 2nd Ave. Suite 1000 Seattle, WA 98104 Phone: (206) 624-9349 Fax: (206) 623-3793	HSA - Hollow Stem Auger	<b>Sample Type</b> N = SPT DP = Direct Push SS = Split Spoon C = Core	<b>Groundwater</b>		
	Sch. - Schedule		Date	Time	Depth (ft.)
	Amb. - ambient air		<b>03/18/08</b>	<b>1553</b>	<b>12.51'</b>

# Boring/Well Log

Well #: MW-6

Sheet 3 of 3

Project: <b>Lora Lake Apartments</b>	Monument: <b>Flush Mount</b>	Stick Up: -
Project #: <b>05482-025-210</b>	Northing: <b>174850.9922</b> Easting: <b>1272784.1135</b>	Ground Elevation: <b>291.083'</b>
Location: <b>Burien, WA</b>	Drill Rig Type: <b>HSA Limited Access</b>	MP Elevation: -
Client: <b>Port of Seattle</b>	Method: <b>HSA</b>	Total Depth: <b>20.5'</b>
Start Date & Time: <b>3/18/08 1344</b>	Casing ID: <b>2"</b>	Filter Pack: <b>10/20 Silica Sand</b>
Finish Date & Time: <b>3/18/08 1445</b>	Boring ID: <b>8.25"</b>	Seal: <b>Bentonite chips</b>
Contractor: <b>Cascade Drilling Inc.</b>	Bit Type: <b>4.25" HSA</b>	Grout: -
Operator: <b>Curtis Askew</b>	Logged By: <b>R. Knecht/ C. Smith</b>	Screen: <b>0.010" slot Sch. 40 PVC 5-15 ft-bgs</b>

Sample			Well Completion Log	Graphic	Depth (ft.)	Soil and Rock Description Classification Scheme: <b>USCS/ASTM</b>	Elevation(ft.)	Comments & Samples
Type & Number	Depth Range	% Rec						



(20.3-20.5) SP: POORLY GRADED SAND, black, fine, wet. No odor or visible contamination.

<b>Remarks and Datum Used:</b>  AECOM - Environment 710 2nd Ave. Suite 1000 Seattle, WA 98104 Phone: (206) 624-9349 Fax: (206) 623-3793		<b>Sample Type</b> N = SPT DP = Direct Push SS = Split Spoon C = Core	<b>Groundwater</b>			
	HSA - Hollow Stem Auger  Sch. - Schedule  Amb. - ambient air		Date	Time	Depth (ft.)	
			03/18/08	1553	12.51'	


# Boring/Well Log

Well #: MW-7

Sheet 1 of 2

Project: <b>Lora Lake Apartments</b>	Monument: <b>Flush Mount</b>	Stick Up: -
Project #: <b>05482-025-3000</b>	Northing: <b>174801.0531</b> Easting: <b>1272865.8926'</b>	Ground Elevation: <b>288.525'</b>
Location: <b>NE of Des Moines Memorial Dr.</b>	Drill Rig Type: <b>HSA</b>	MP Elevation: <b>287.907'</b>
Client: <b>Port of Seattle</b>	Method: <b>Split Spoon</b>	Total Depth: <b>25.5'</b>
Start Date & Time: <b>10/22/08 1110</b>	Casing ID: <b>2"</b>	Filter Pack: <b>10/20 Silica Sand</b>
Finish Date & Time: <b>10/22/08 1210</b>	Boring ID: <b>8.25"</b>	Seal: <b>Bentonite Chips</b>
Contractor: <b>Cascade Drilling</b>	Bit Type: <b>HSA Coring Bit</b>	Grout: -
Operator: <b>Dave</b>	Logged By: <b>R. Knecht</b>	Screen: <b>Sch. 40 PVC from 15-24.6 ft-bgs</b>

Sample					Well Completion Log	Graphic	Depth (ft.)	Soil and Rock Description Classification Scheme: <b>USCS/ASTM</b>	Elevation (ft.)	Comments
Type & Depth Range	% Rec	Blows per 6"	PID (ppm)							

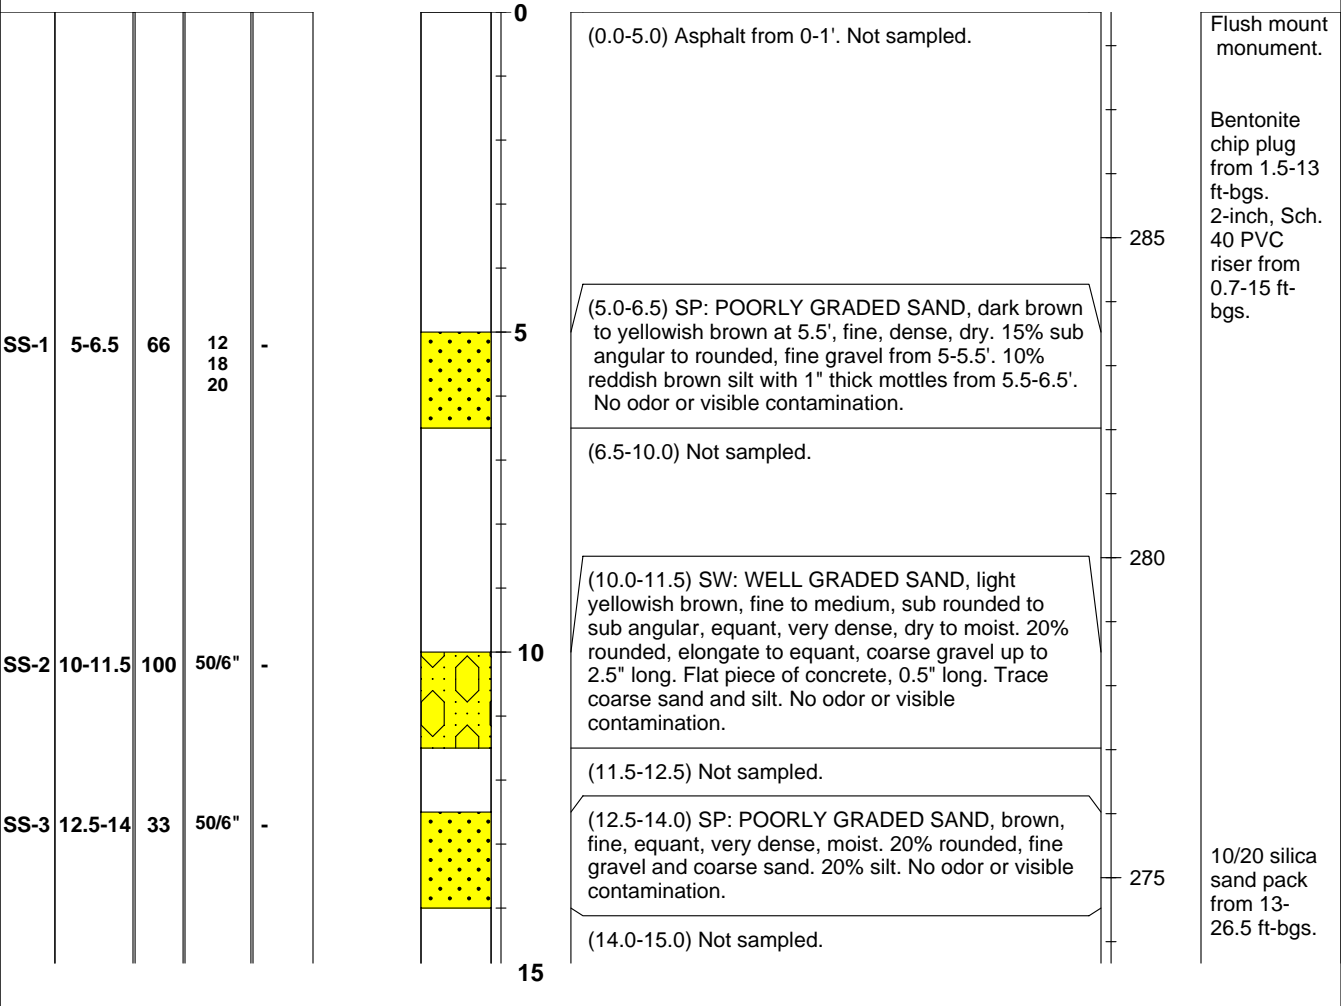

<b>Remarks and Datum Used:</b> The RETEC Group, Inc. 1011 SW Klickitat Way, Suite 207 Seattle, WA 98134-1162 Phone: (206) 624-9349 Fax: (206) 624-2839	<b>HSA = Hollow Stem Auger</b> <b>Sch. = Schedule</b> <b>ft-bgs = feel below ground surface</b>	<b>Sample Type</b> N = SPT DP = Direct Push SS = Split Spoon C = Core	<b>Groundwater</b>		
				Date	Time
			10/22/08	1300	16.65'
			10/22/08	1215	19'

# Boring/Well Log

Well #: MW-7

Sheet 2 of 2

Project: <b>Lora Lake Apartments</b>	Monument: <b>Flush Mount</b>	Stick Up: -
Project #: <b>05482-025-3000</b>	Northing: <b>174801.0531</b> Easting: <b>1272865.8926'</b>	Ground Elevation: <b>288.525'</b>
Location: <b>NE of Des Moines Memorial Dr.</b>	Drill Rig Type: <b>HSA</b>	MP Elevation: <b>287.907'</b>
Client: <b>Port of Seattle</b>	Method: <b>Split Spoon</b>	Total Depth: <b>25.5'</b>
Start Date & Time: <b>10/22/08 1110</b>	Casing ID: <b>2"</b>	Filter Pack: <b>10/20 Silica Sand</b>
Finish Date & Time: <b>10/22/08 1210</b>	Boring ID: <b>8.25"</b>	Seal: <b>Bentonite Chips</b>
Contractor: <b>Cascade Drilling</b>	Bit Type: <b>HSA Coring Bit</b>	Grout: -
Operator: <b>Dave</b>	Logged By: <b>R. Knecht</b>	Screen: <b>Sch. 40 PVC from 15-24.6 ft-bgs</b>

Type & Depth Range	Sample			Well Completion Log	Graphic	Depth (ft.)	Soil and Rock Description Classification Scheme: <b>USCS/ASTM</b>	Elevation (ft.)	Comments
	% Rec	Blows per 6"	PID (ppm)						

SS-4	15-16.5	100	50/6"	-		15	<p>(15.0-16.5) SW: WELL GRADED SAND, yellowish brown to dark brown, fine to medium, sub rounded to sub angular, equant, very dense, wet at 15.5'. 20-25% rounded to sub angular, fine gravel from 16.3-16.5'. Large, rounded, gravel up to 2" wide and long at 15.25'. No odor or visible contamination.</p> <p>(16.5-20.0) Not sampled.</p>	270	<p>2-inch, 0.010-slot, sch. 40 PVC screen from 15-24.6 ft-bgs.</p> <p>15-16.5', sample collected for analytical.</p>
SS-5	20-21.5	100	50/6"	-		20	<p>(20.0-21.5) SP: POORLY GRADED SAND, brown to yellowish brown, fine, rounded, equant, very dense, wet. 20% medium sand. 15-20% silt. 10% rounded, fine gravel up to 1" long from 21.2-21.5'. Silty sand lense at 20.3'. No odor or visible contamination.</p> <p>(21.5-25.0) Not Sampled.</p>	265	<p>2-inch PVC end cap from 24.6-25 ft-bgs.</p> <p>25-25.5', sample collected for analytical.</p>
SS-6	25-26.5	83	50/6"	-		25	<p>(25.0-26.5) SP: POORLY GRADED SAND, dark gray, fine, very dense, wet. Trace medium to coarse sand and silt. Slight rotten egg-like odor, no visible contamination.</p>		



<b>Remarks and Datum Used:</b> The RETEC Group, Inc. 1011 SW Klickitat Way, Suite 207 Seattle, WA 98134-1162 Phone: (206) 624-9349 Fax: (206) 624-2839	<b>HSA = Hollow Stem Auger</b> <b>Sch. = Schedule</b> <b>ft-bgs = feet below ground surface</b>	<b>Sample Type</b> N = SPT DP = Direct Push SS = Split Spoon C = Core	<b>Groundwater</b>		
				Date	Time
			10/22/08	1300	16.65'
			10/22/08	1215	19'

# Boring/Well Log

Well #: MW-8

Sheet 1 of 2

Project: <b>Lora Lake Apartments</b>	Monument: <b>Flush Mount</b>	Stick Up: -
Project #: <b>05482-025-3000</b>	Northing: <b>174627.274</b> Easting: <b>1272775.8574</b>	Ground Elevation: <b>282.534'</b>
Location: <b>Seattle, WA</b>	Drill Rig Type: <b>Limited Access Track Rig</b>	MP Elevation: <b>287.907'</b>
Client: <b>Port of Seattle</b>	Method: <b>HSA</b>	Total Depth: <b>20.5'</b>
Start Date & Time: <b>08/12/08 1357</b>	Casing ID: <b>2"</b>	Filter Pack: <b>10/20 Silica Sand</b>
Finish Date & Time: <b>08/12/08 1429</b>	Boring ID: <b>4.25"</b>	Seal: <b>Bentonite Chips</b>
Contractor: <b>Cascade Drilling Inc.</b>	Bit Type: <b>4.25" HSA</b>	Grout: -
Operator: <b>Curtis Askew</b>	Logged By: <b>C. Smith</b>	Screen: <b>0.010-inch slot, Sch. 40 PVC</b>

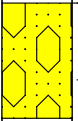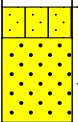Type & Depth Range	Sample			Well Completion Log	Graphic	Depth (ft.)	Soil and Rock Description Classification Scheme: <b>USCS/ASTM</b>	Elevation (ft.)	Comments
	% Rec	Blows per 6"	PID (ppm)						
SS -1 5-6.5	80	7 8 17	0.4 aa= 0.4			5	(5.0-6.5) SW: WELL GRADED SAND, brown, fine to coarse, sub angular to sub rounded, medium dense, dry. Trace rootlets. No odor or visible contamination.	280	2-inch schedule 40 riser pipe from 0-10 ft-bgs.
SS -2 10-11.5	46	50/6"	0.3 aa= 0.3			10	(10.4-11.5) SP: POORLY GRADED SAND, brown, fine, very dense, moist. Trace coarse sand. One rounded peice of large gravel. No odor or visible contamination.	270	0.010-inch slot, 2-inch schedule 40 PVC screen from 10-20 ft-bgs.
							(0.0-5.0) Not sampled.		Flush mount monument.
							(6.5-10.0) Not sampled.		Bentonite chip plug from 1.5-8 ft-bgs.
							(10.0-10.4) SM: SILTY SAND, gray and brown, fine to medium, very dense, moist. 40% silt. Trace, angular, coarse sand. Trace rootlets. No odor or visible contamination.		10/20 silica sand pack from 8-20.5 ft-bgs.
							(11.5-12.5) Not sampled.		

<b>Remarks and Datum Used:</b> The RETEC Group, Inc. 1011 SW Klickitat Way, Suite 207 Seattle, WA 98134-1162 Phone: (206) 624-9349 Fax: (206) 624-2839	aa = ambient air	<b>Sample Type</b> N = SPT DP = Direct Push SS = Split Spoon C = Core	<b>Groundwater</b>		
	ft-bgs = feet below ground surface		Date	Time	Depth (ft.)
	Sch. = schedule		8/12/08	1415	12'
	HSA = Hollow Stem Auger				





# Boring/Well Log

Well #: MW-8

Sheet 2 of 2

Project: <b>Lora Lake Apartments</b>	Monument: <b>Flush Mount</b>	Stick Up: -
Project #: <b>05482-025-3000</b>	Northing: <b>174627.274</b> Easting: <b>1272775.8574</b>	Ground Elevation: <b>282.534'</b>
Location: <b>Seattle, WA</b>	Drill Rig Type: <b>Limited Access Track Rig</b>	MP Elevation: <b>287.907'</b>
Client: <b>Port of Seattle</b>	Method: <b>HSA</b>	Total Depth: <b>20.5'</b>
Start Date & Time: <b>08/12/08 1357</b>	Casing ID: <b>2"</b>	Filter Pack: <b>10/20 Silica Sand</b>
Finish Date & Time: <b>08/12/08 1429</b>	Boring ID: <b>4.25"</b>	Seal: <b>Bentonite Chips</b>
Contractor: <b>Cascade Drilling Inc.</b>	Bit Type: <b>4.25" HSA</b>	Grout: -
Operator: <b>Curtis Askew</b>	Logged By: <b>C. Smith</b>	Screen: <b>0.010-inch slot, Sch. 40 PVC</b>

Sample					Well Completion Log	Graphic	Depth (ft.)	Soil and Rock Description Classification Scheme: <b>USCS/ASTM</b>	Elevation (ft.)	Comments
Type & Depth Range	% Rec	Blows per 6"	PID (ppm)							
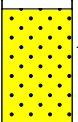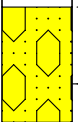
<b>SS-3</b>	12.5-14	80	50/6"	0.3 aa= 0.3			15	(12.5-14.0) SP: POORLY GRADED SAND, white, black, orange, and yellow grains, medium, sub rounded, very dense, wet. Trace coarse sand to large gravel. Trace, orange, iron oxide staining. One cobble, 3" in diameter. No odor or visible contamination.	270	12.5-14': Sampled for analytical.
								(14.0-19.0) Not sampled.	265	
<b>SS-4</b>	19-20.5	26	50/4"	0.3 aa= 0.3			20	(19.0-20.5) SW: WELL GRADED SAND, brown with white, black, and yellow grains, fine to medium, very dense, wet. Trace coarse sand. 10% winnowing. No odor or visible contamination.		Threaded end cap from 20-20.35 ft-bgs.



<b>Remarks and Datum Used:</b> The RETEC Group, Inc. 1011 SW Klickitat Way, Suite 207 Seattle, WA 98134-1162 Phone: (206) 624-9349 Fax: (206) 624-2839	aa = ambient air	<b>Sample Type</b> N = SPT DP = Direct Push SS = Split Spoon C = Core	<b>Groundwater</b>		
	ft-bgs = feet below ground surface			Date	Time
	Sch. = schedule		8/12/08	1415	12'
	HSA = Hollow Stem Auger				

# Boring/Well Log

Well #: MW-9

Sheet 1 of 2

Project: <b>Lora Lake Apartments</b>	Monument: <b>Flush Mount</b>	Stick Up: -
Project #: <b>05482-025-3000</b>	Northing: <b>174474.2134</b> Easting: <b>1272627.3356'</b>	Ground Elevation: <b>283.698'</b>
Location: <b>Seattle, WA</b>	Drill Rig Type: <b>Limited Access Track Rig</b>	MP Elevation: <b>283.335'</b>
Client: <b>Port of Seattle</b>	Method: <b>HSA</b>	Total Depth: <b>20.5'</b>
Start Date & Time: <b>08/12/08 1217</b>	Casing ID: <b>2"</b>	Filter Pack: <b>10/20 Silica Sand</b>
Finish Date & Time: <b>08/12/08 1240</b>	Boring ID: <b>4.25"</b>	Seal: <b>Bentonite Chips</b>
Contractor: <b>Cascade Drilling Inc.</b>	Bit Type: <b>4.25" HSA</b>	Grout: -
Operator: <b>Curtis Askew</b>	Logged By: <b>C. Smith</b>	Screen: <b>0.010-inch slot, Sch. 40 PVC</b>

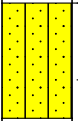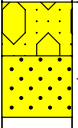Sample					Well Completion Log	Graphic	Depth (ft.)	Soil and Rock Description Classification Scheme: <b>USCS/ASTM</b>	Elevation (ft.)	Comments
Type & Depth Range	% Rec	Blows per 6"	PID (ppm)	Depth						
SS -1	5-6.5	53	24 50/6"	0.4 aa= 0.4			(0.0-5.0) Not sampled.  (5.0-6.5) SM: SILTY SAND, brown, fine to medium, very dense, moist. At 5-5.3', trace coarse sand and rootlets, large 3", rounded, cobble. At 5.3-5.6', color grades to gray. No odor or visible contamination.  (6.5-10.0) Not sampled.	280	Flush mount monument.  Bentonite chip plug from 1.5-8 ft-bgs.	
SS -2	10-11.5	-	21 25 30	0.3 aa= 0.3			(10.0-10.7) SW: WELL GRADED SAND, brown, fine to coarse, sub rounded, very dense, moist. Angular, crushed, dark gray boulder at 10.5'. No odor or visible contamination.  (10.7-11.5) SP: POORLY GRADED SAND, brown, fine, very dense, moist. Few 1/4" thick gray lenses at 11.1' and 11.3'. No odor or visible contamination.  (11.5-15.0) Not sampled.	275	2-inch schedule 40 riser pipe from 0-10 ft-bgs.  10/20 silica sand pack from 8-20.5 ft-bgs.  0.010-inch slot, 2-inch schedule 40 PVC screen from 10-20 ft-bgs.	

<b>Remarks and Datum Used:</b> The RETEC Group, Inc. 1011 SW Klickitat Way, Suite 207 Seattle, WA 98134-1162 Phone: (206) 624-9349 Fax: (206) 624-2839	aa = ambient air	<b>Sample Type</b> N = SPT DP = Direct Push SS = Split Spoon C = Core	<b>Groundwater</b>		
	ft-bgs = feet below ground surface		Date	Time	Depth (ft.)
	Sch. = schedule		8/12/08	1230	14'
	HSA = Hollow Stem Auger				



# Boring/Well Log

Well #: MW-9

Sheet 2 of 2

Project: <b>Lora Lake Apartments</b>	Monument: <b>Flush Mount</b>	Stick Up: -
Project #: <b>05482-025-3000</b>	Northing: <b>174474.2134</b> Easting: <b>1272627.3356'</b>	Ground Elevation: <b>283.698'</b>
Location: <b>Seattle, WA</b>	Drill Rig Type: <b>Limited Access Track Rig</b>	MP Elevation: <b>283.335'</b>
Client: <b>Port of Seattle</b>	Method: <b>HSA</b>	Total Depth: <b>20.5'</b>
Start Date & Time: <b>08/12/08 1217</b>	Casing ID: <b>2"</b>	Filter Pack: <b>10/20 Silica Sand</b>
Finish Date & Time: <b>08/12/08 1240</b>	Boring ID: <b>4.25"</b>	Seal: <b>Bentonite Chips</b>
Contractor: <b>Cascade Drilling Inc.</b>	Bit Type: <b>4.25" HSA</b>	Grout: -
Operator: <b>Curtis Askew</b>	Logged By: <b>C. Smith</b>	Screen: <b>0.010-inch slot, Sch. 40 PVC</b>

Sample					Well Completion Log	Graphic	Depth (ft.)	Soil and Rock Description Classification Scheme: <b>USCS/ASTM</b>	Elevation (ft.)	Comments
Type & Depth Range	% Rec	Blows per 6"	PID (ppm)							
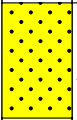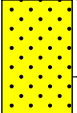
<b>SS-3</b>	15-16.5	66	50/6"	0.3 aa= 0.3			15	(15.0-16.5) SP: POORLY GRADED SAND, brown with white, black and yellow grains, fine, very dense, wet. Trace silt. 15% winnowing. No odor or visible contamination.	270	15-16.5 ft-bgs: Sampled for analytical.
								(16.5-19) Not sampled.		
<b>SS-4</b>	19-20.5	-	50/6"	0.3 aa= 0.3			20	(19.0-20.5) SP: POORLY GRADED SAND, brown with white, black and yellow grains, fine, very dense, wet. Trace silt. 15% winnowing. No odor or visible contamination.	265	Threaded end cap from 20-20.35 ft-bgs.



<b>Remarks and Datum Used:</b> The RETEC Group, Inc. 1011 SW Klickitat Way, Suite 207 Seattle, WA 98134-1162 Phone: (206) 624-9349 Fax: (206) 624-2839	aa = ambient air	<b>Sample Type</b> N = SPT DP = Direct Push SS = Split Spoon C = Core	<b>Groundwater</b>		
	ft-bgs = feet below ground surface			Date	Time
	Sch. = schedule		8/12/08	1230	14'
	HSA = Hollow Stem Auger				

# Boring/Well Log

Well #: MW-10

Sheet 1 of 2

Project: <b>Lora Lake Apartments</b>	Monument: <b>Flush Mount</b>	Stick Up: -
Project #: <b>05482-025-3000</b>	Northing: <b>174386.6154</b> Easting: <b>1272561.6472'</b>	Ground Elevation: <b>284.397'</b>
Location: <b>Seattle, WA</b>	Drill Rig Type: <b>Limited Access Track Rig</b>	MP Elevation: <b>284.149'</b>
Client: <b>Port of Seattle</b>	Method: <b>HSA</b>	Total Depth: <b>20.5'</b>
Start Date & Time: <b>08/12/08 1041</b>	Casing ID: <b>2"</b>	Filter Pack: <b>10/20 Silica Sand</b>
Finish Date & Time: <b>08/12/08 1115</b>	Boring ID: <b>4.25"</b>	Seal: <b>Bentonite Chips</b>
Contractor: <b>Cascade Drilling Inc.</b>	Bit Type: <b>4.25" HSA</b>	Grout: -
Operator: <b>Curtis Askew</b>	Logged By: <b>C. Smith</b>	Screen: <b>0.010-inch slot, Sch. 40 PVC</b>

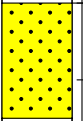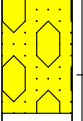Type & Depth Range	% Rec	Blows per 6"	PID (ppm)	Well Completion Log	Graphic	Depth (ft.)	Soil and Rock Description Classification Scheme: <b>USCS/ASTM</b>	Elevation (ft.)	Comments
SS -1	5-6.5	46	24 50/6"	0.3 aa= 0.3		0 5	(0.0-5.0) Not sampled.  (5.0-6.5) SP: POORLY GRADED SAND, orangish brown, medium, very dense, dry. Trace, angular, coarse sand to small gravel. Some fine sand and silt. No odor or visible contamination.	280	Flush mount monument.  Bentonite chip plug from 1.5-8 ft-bgs.
SS -2	10-11.5	44	21 25 30	0.3 aa= 0.3		10	(6.5-10.0) Not sampled.  (10.0-11.5) SW: WELL GRADED SAND, brown, fine to medium, very dense, moist. Some silt and coarse sand. No odor or visible contamination.	275	10/20 silica sand pack from 8-20.5 ft-bgs.  0.010-inch slot, 2-inch schedule 40 PVC screen from 10-20 ft-bgs.
							(11.5-12.5) Not sampled.		

<b>Remarks and Datum Used:</b> The RETEC Group, Inc. 1011 SW Klickitat Way, Suite 207 Seattle, WA 98134-1162 Phone: (206) 624-9349 Fax: (206) 624-2839	aa = ambient air	<b>Sample Type</b> N = SPT DP = Direct Push SS = Split Spoon C = Core	<b>Groundwater</b>		
	ft-bgs = feet below ground surface		Date	Time	Depth (ft.)
	Sch. = schedule		8/12/08	1115	13'
	HSA = Hollow Stem Auger				

# Boring/Well Log

Well #: MW-10

Sheet 2 of 2

Project: <b>Lora Lake Apartments</b>	Monument: <b>Flush Mount</b>	Stick Up: -
Project #: <b>05482-025-3000</b>	Northing: <b>174386.6154</b> Easting: <b>1272561.6472'</b>	Ground Elevation: <b>284.397'</b>
Location: <b>Seattle, WA</b>	Drill Rig Type: <b>Limited Access Track Rig</b>	MP Elevation: <b>284.149'</b>
Client: <b>Port of Seattle</b>	Method: <b>HSA</b>	Total Depth: <b>20.5'</b>
Start Date & Time: <b>08/12/08 1041</b>	Casing ID: <b>2"</b>	Filter Pack: <b>10/20 Silica Sand</b>
Finish Date & Time: <b>08/12/08 1115</b>	Boring ID: <b>4.25"</b>	Seal: <b>Bentonite Chips</b>
Contractor: <b>Cascade Drilling Inc.</b>	Bit Type: <b>4.25" HSA</b>	Grout: -
Operator: <b>Curtis Askew</b>	Logged By: <b>C. Smith</b>	Screen: <b>0.010-inch slot, Sch. 40 PVC</b>

Sample					Well Completion Log	Graphic	Depth (ft.)	Soil and Rock Description Classification Scheme: <b>USCS/ASTM</b>	Elevation (ft.)	Comments
Type & Depth Range	% Rec	Blows per 6"	PID (ppm)							

SS-3	12.5-14	60	50/6"	0.3 aa= 0.3			15	(12.5-14.0) SP: POORLY GRADED SAND, brown, medium, sub rounded, very dense, moist to wet at 13'. Trace, fine sand and silt. No odor or visible contamination.	270	12.5-14 ft-bgs: Sampled for analytical.
								(14.0-18.5) Not sampled.		
SS-4	19-20.5	80	50/6"	0.3 aa= 0.3			20	(19.0-20.5) SP: POORLY GRADED SAND, brown with black, white, yellow, and orange grains, medium, sub rounded, very dense, wet. Trace silt. No odor or visible contamination.	265	Threaded end cap from 20-20.35 ft-bgs.

<b>Remarks and Datum Used:</b> The RETEC Group, Inc. 1011 SW Klickitat Way, Suite 207 Seattle, WA 98134-1162 Phone: (206) 624-9349 Fax: (206) 624-2839	aa = ambient air	<b>Sample Type</b> N = SPT DP = Direct Push SS = Split Spoon C = Core	<b>Groundwater</b>		
	ft-bgs = feet below ground surface			Date	Time
	Sch. = schedule		8/12/08	1115	13'
	HSA = Hollow Stem Auger				

# Boring/Well Log

Well #: MW-11

Sheet 1 of 2

Project: <b>Lora Lake Apartments</b>	Monument: <b>Flush Mount</b>	Stick Up: -
Project #: <b>05482-025-3000</b>	Northing: <b>174287.7124</b> Easting: <b>1272485.4391</b>	Ground Elevation: <b>284.948'</b>
Location: <b>Seattle, WA</b>	Drill Rig Type: <b>Limited Access Track Rig</b>	MP Elevation: <b>284.36'</b>
Client: <b>Port of Seattle</b>	Method: <b>HSA</b>	Total Depth: <b>20.5'</b>
Start Date & Time: <b>08/12/08 0930</b>	Casing ID: <b>2"</b>	Filter Pack: <b>10/20 Silica Sand</b>
Finish Date & Time: <b>08/12/08 1005</b>	Boring ID: <b>4.25"</b>	Seal: <b>Bentonite Chips</b>
Contractor: <b>Cascade Drilling Inc.</b>	Bit Type: <b>4.25" HSA</b>	Grout: -
Operator: <b>Curtis Askew</b>	Logged By: <b>C. Smith</b>	Screen: <b>0.010-inch slot, Sch. 40 PVC</b>

Sample					Well Completion Log	Graphic	Depth (ft.)	Soil and Rock Description Classification Scheme: <b>USCS/ASTM</b>	Elevation (ft.)	Comments
Type & Depth Range	% Rec	Blows per 6"	PID (ppm)							

						0	(0.0-5.0) Not sampled.		Flush mount monument.
SS -1	5-6.5	100	50/2"	0.0		5	(5.0-6.5) SW: WELL GRADED SAND, dark brown, fine to medium, very dense, moist. Trace coarse sand. Few, angular gravel up to 1" in diameter. Few grass and rootlets. No odor or visible contamination.	280	Bentonite chip plug from 1.5-8 ft-bgs.  2-inch schedule 40 riser pipe from 0-10 ft-bgs.
SS -2	7.5-9	100	50/6"	0.0			(6.5-7.5) Not sampled.		
							(7.5-9.0) SW: WELL GRADED SAND, dark brown, fine to medium, very dense, moist. Trace, angular, coarse sand and small gravel. Some rootlets. No odor or visible contamination.		10/20 silica sand pack from 8-20.5 ft-bgs.
SS -3	10-11.5	100	50/6"	0.0		10	(9.0-10.0) Not sampled.		
							(10.0-10.3) SW: WELL GRADED SAND, brown, fine to medium, very dense, moist. Trace coarse sand. No odor or visible contamination.	275	
							(10.3-11.5) SP: POORLY GRADED SAND, brown, medium, very dense, moist. No odor or visible contamination.		0.010-inch slot, 2-inch schedule 40 PVC screen from 10-20 ft-bgs.
							(11.5-12.5) Not sampled.		

<b>Remarks and Datum Used:</b> The RETEC Group, Inc. 1011 SW Klickitat Way, Suite 207 Seattle, WA 98134-1162 Phone: (206) 624-9349 Fax: (206) 624-2839	ft-bgs = feet below ground surface	<b>Sample Type</b> N = SPT DP = Direct Push SS = Split Spoon C = Core	<b>Groundwater</b>		
	Sch. = schedule HSA = Hollow Stem Auger		Date	Time	Depth (ft.)
			8/12/08	0950	12.8'




# Boring/Well Log

Well #: MW-11

Sheet 2 of 2

Project: <b>Lora Lake Apartments</b>	Monument: <b>Flush Mount</b>	Stick Up: -
Project #: <b>05482-025-3000</b>	Northing: <b>174287.7124</b> Easting: <b>1272485.4391'</b>	Ground Elevation: <b>284.948'</b>
Location: <b>Seattle, WA</b>	Drill Rig Type: <b>Limited Access Track Rig</b>	MP Elevation: <b>284.36'</b>
Client: <b>Port of Seattle</b>	Method: <b>HSA</b>	Total Depth: <b>20.5'</b>
Start Date & Time: <b>08/12/08 0930</b>	Casing ID: <b>2"</b>	Filter Pack: <b>10/20 Silica Sand</b>
Finish Date & Time: <b>08/12/08 1005</b>	Boring ID: <b>4.25"</b>	Seal: <b>Bentonite Chips</b>
Contractor: <b>Cascade Drilling Inc.</b>	Bit Type: <b>4.25" HSA</b>	Grout: -
Operator: <b>Curtis Askew</b>	Logged By: <b>C. Smith</b>	Screen: <b>0.010-inch slot, Sch. 40 PVC</b>

Sample					Well Completion Log	Graphic	Depth (ft.)	Soil and Rock Description Classification Scheme: <b>USCS/ASTM</b>	Elevation (ft.)	Comments
Type & Depth Range	% Rec	Blows per 6"	PID (ppm)							

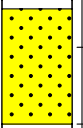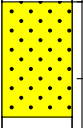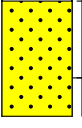SS-4	12.5-14	100	60/5"	0.0			15	(12.5-14.0) SP: POORLY GRADED SAND, brown, medium, moist to wet at 12.8'. Trace coarse sand. No odor or visible contamination.	270	
								(14.0-15.0) Not sampled.		
SS-5	15-16.5	100	50/5"	0.0			15	(15.0-16.5) SP: POORLY GRADED SAND, brown, medium, very dense, wet. Trace silt at 16'. No odor or visible contamination.	270	12.5-13 ft-bgs: Sampled for analytical.
								(16.5-19.0) Not sampled.		
SS-6	19-20.5	100	50/6"	0.0			20	(19.0-20.5) SP: POORLY GRADED SAND, brown with white, black, orange and yellow grains, medium, sub angular, very dense, wet. Trace silt. 10% winnowing. No odor or visible contamination.	265	Threaded end cap from 20-20.35 ft-bgs.

<b>Remarks and Datum Used:</b> ft-bgs = feet below ground surface  The RETEC Group, Inc. 1011 SW Klickitat Way, Suite 207 Seattle, WA 98134-1162 Phone: (206) 624-9349 Fax: (206) 624-2839	<b>Sch. = schedule</b>	<b>Sample Type</b> N = SPT DP = Direct Push SS = Split Spoon C = Core	<b>Groundwater</b>		
	<b>HSA = Hollow Stem Auger</b>		Date	Time	Depth (ft.)
			8/12/08	0950	12.8'


**Drill Date:** August 2, 2010  
**Logged By:** Megan McCullough  
**Drilled By:** Cascade Drilling  
**Drill Type:** Hollow Stem Auger  
**Sample Method:** 18" split spoon  
**Boring Diameter:** 8 inches  
**Boring Depth (ft bgs):** 19 ft  
**Groundwater ATD (ft bgs):** 10 ft

**Client:** Port of Seattle  
**Project:** POS-LLA  
**Task Number:** T 4010  
**Site Location:** LL Apts Parcel  
 15001 Des Moines Memorial Dr.

**Ground Surf Elev. & Datum:** 287.13 ft  
**Coordinate System:** NGVD29/NAD83  
**Latitude/Northing:** 174762.0372 ft  
**Longitude/Easting:** 1272711.531 ft  
**Casing Elevation:** 286.53 ft

**Remarks:**

SAMPLE INTERVAL	PID (ppm)	DRIVE / RECOVERY	BLOW COUNT	DEPTH FT BGS	USCS SYMBOL	SOIL DESCRIPTION AND OBSERVATIONS: (color, texture, moisture, MAJOR CONSTITUENT, odor, staining, sheen, debris, etc.)	MONITORING WELL DETAIL
-----------------	-----------	------------------	------------	--------------	-------------	---	------------------------

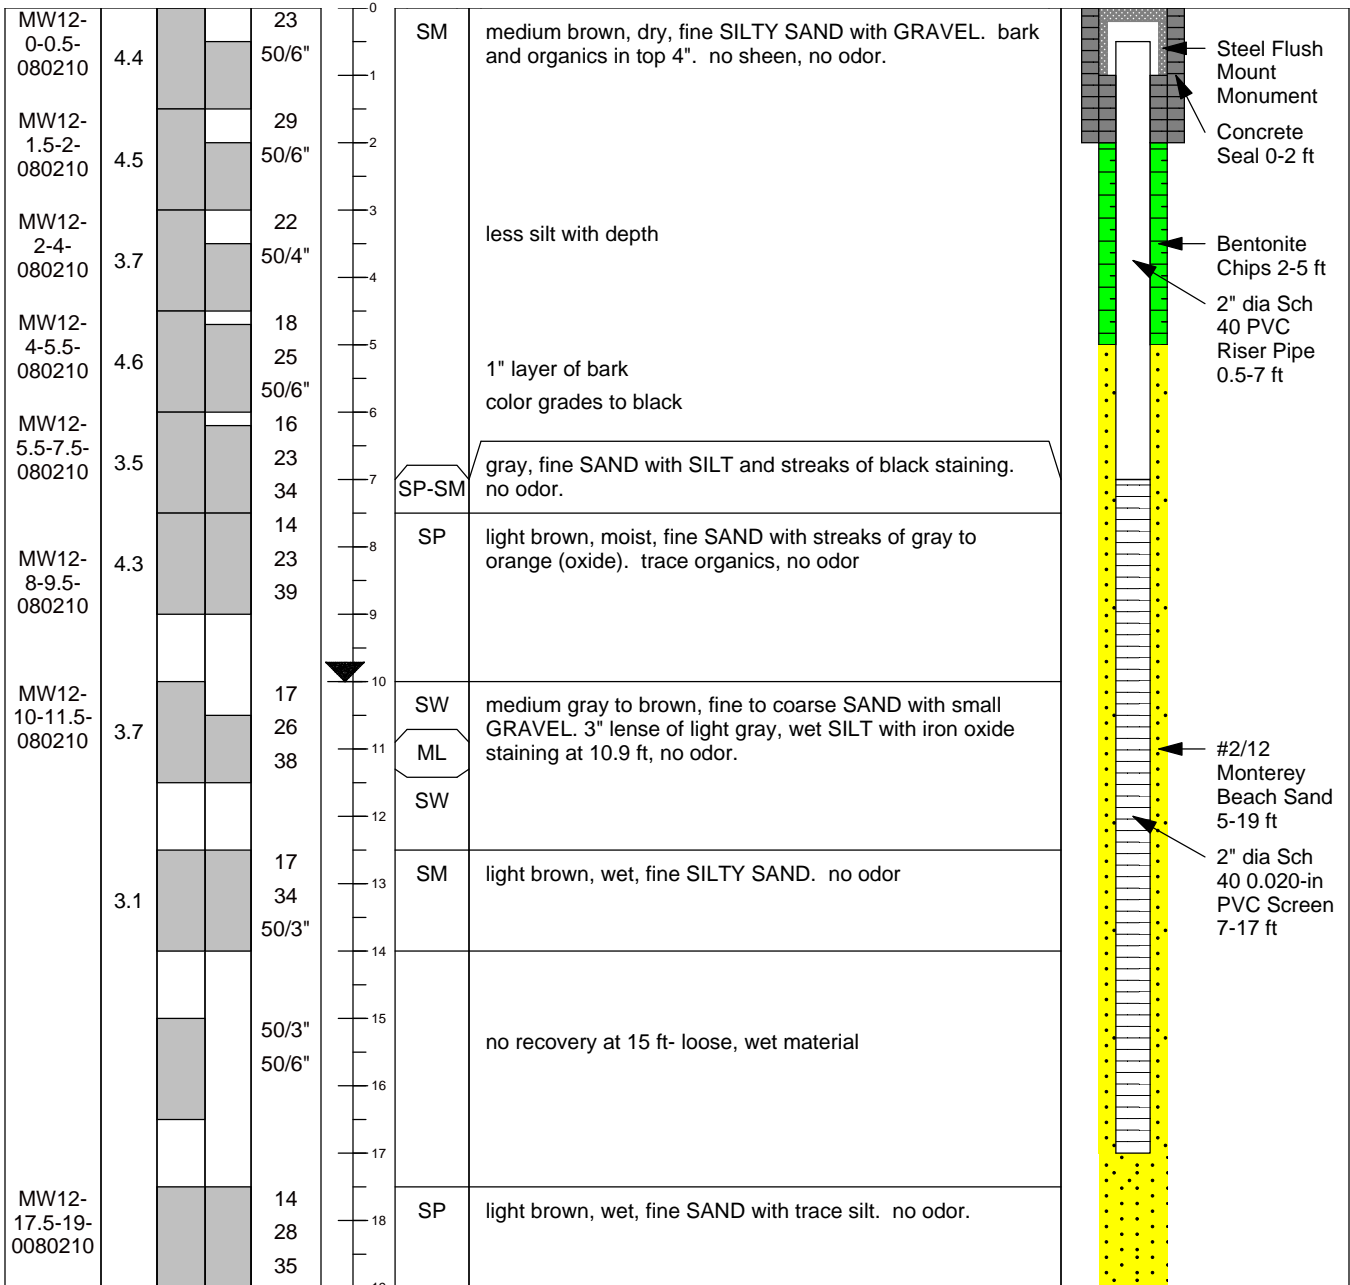

**Notes:**

FT BGS = feet below ground surface  
 ppm = parts per million

--- Dashed contact line in soil description indicates a gradational contact  
 USCS = Unified Soil Classification System  
 ▼ = denotes groundwater table




**Drill Date:** August 2, 2010  
**Logged By:** Megan McCullough  
**Drilled By:** Cascade Drilling  
**Drill Type:** Hollow Stem Auger  
**Sample Method:** 18" split spoon  
**Boring Diameter:** 8 inches  
**Boring Depth (ft bgs):** 20 ft  
**Groundwater ATD (ft bgs):** 13.75 ft

**Client:** Port of Seattle  
**Project:** POS-LLA  
**Task Number:** T 4010  
**Site Location:** LL Apts Parcel  
 15001 Des Moines Memorial Dr.

**Ground Surf Elev. & Datum:** 289.89 ft  
**Coordinate System:** NGVD29/NAD83  
**Latitude/Northing:** 174904.8622 ft  
**Longitude/Easting:** 1272777.633 ft  
**Casing Elevation:** 289.43 ft

**Remarks:**

SAMPLE INTERVAL	PID (ppm)	DRIVE / RECOVERY	BLOW COUNT	DEPTH FT BGS	USCS SYMBOL	SOIL DESCRIPTION AND OBSERVATIONS: (color, texture, moisture, MAJOR CONSTITUENT, odor, staining, sheen, debris, etc.)	MONITORING WELL DETAIL
-----------------	-----------	------------------	------------	--------------	-------------	---	------------------------

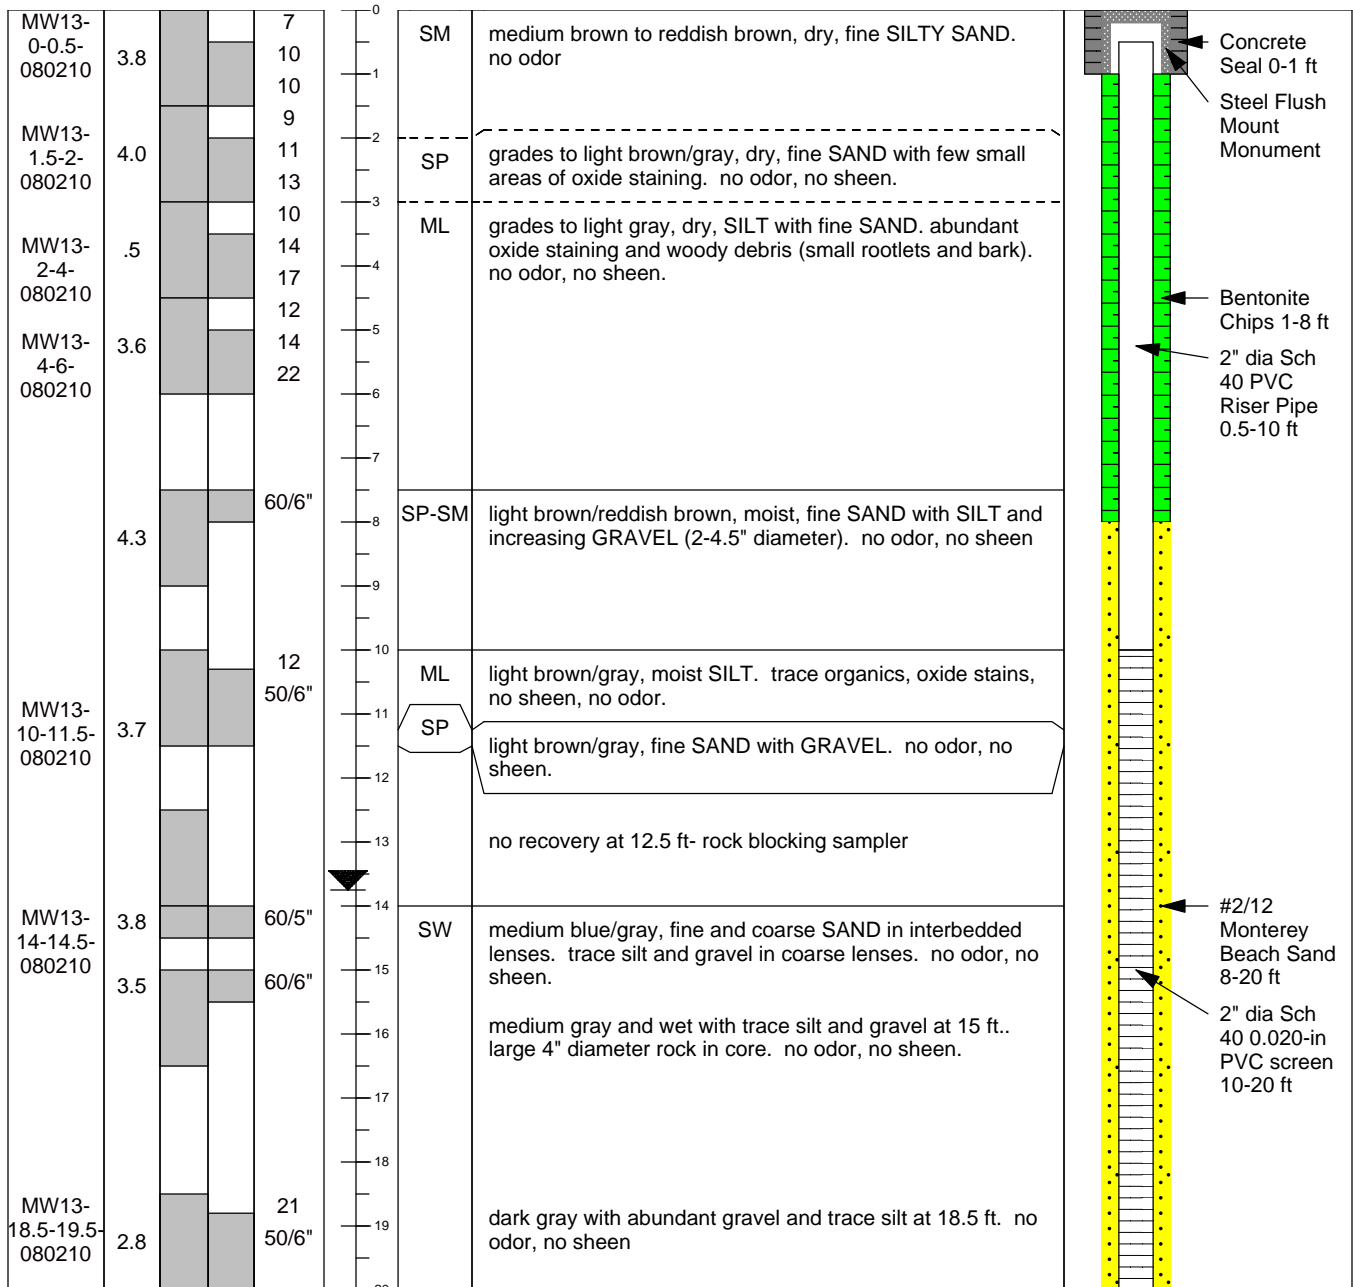

**Notes:**

FT BGS = feet below ground surface  
 ppm = parts per million

--- Dashed contact line in soil description indicates a gradational contact  
 USCS = Unified Soil Classification System  
 ▼ = denotes groundwater table


**Drill Date:** August 2, 2010  
**Logged By:** Megan McCullough  
**Drilled By:** Cascade Drilling  
**Drill Type:** Hollow Stem Auger  
**Sample Method:** 18" split spoon  
**Boring Diameter:** 8 inches  
**Boring Depth (ft bgs):** 25 ft  
**Groundwater ATD (ft bgs):** 15.25 ft

**Client:** Port of Seattle  
**Project:** POS-LLA  
**Task Number:** T 4010  
**Site Location:** LL Apts Parcel  
 15001 Des Moines Memorial Dr.

**Ground Surf Elev. & Datum:** 297.19 ft  
**Coordinate System:** NGVD29/NAD83  
**Latitude/Northing:** 174819.3889 ft  
**Longitude/Easting:** 1272606.284 ft  
**Casing Elevation:** 296.94 ft

**Remarks:**

SAMPLE INTERVAL	PID (ppm)	DRIVE / RECOVERY	BLOW COUNT	DEPTH FT BGS	USCS SYMBOL	SOIL DESCRIPTION AND OBSERVATIONS: (color, texture, moisture, MAJOR CONSTITUENT, odor, staining, sheen, debris, etc.)	MONITORING WELL DETAIL
-----------------	-----------	------------------	------------	--------------	-------------	---	------------------------

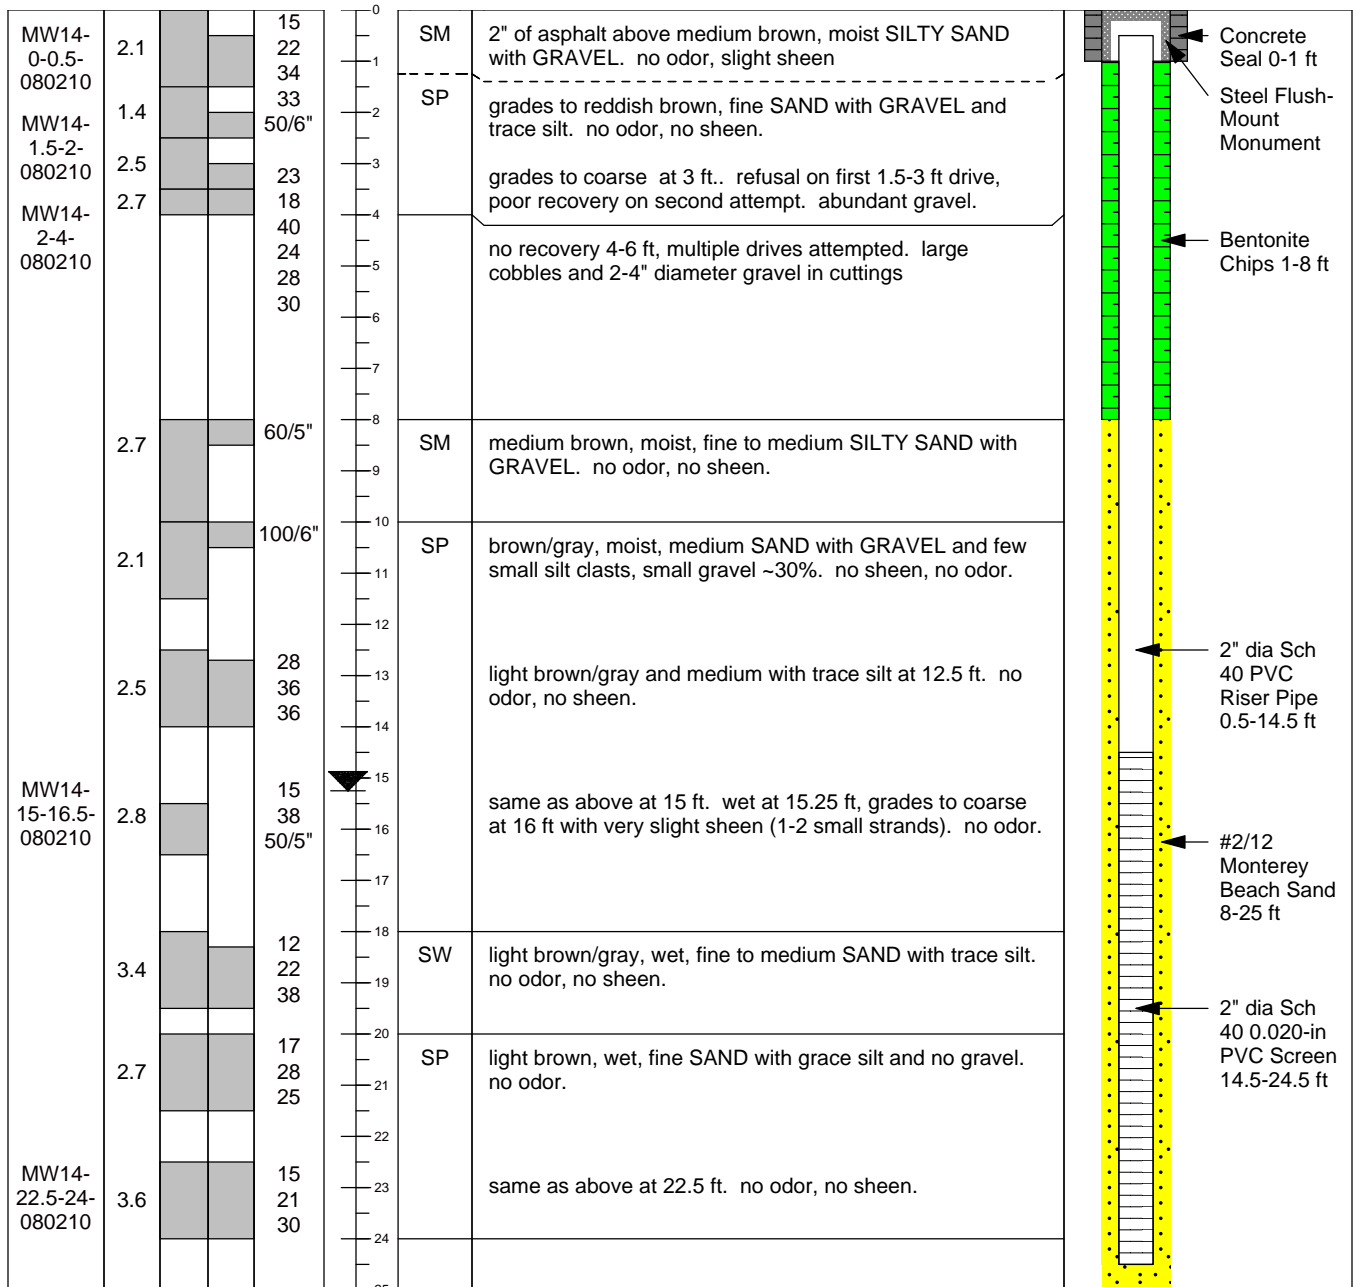

**Notes:**

FT BGS = feet below ground surface  
 ppm = parts per million

--- Dashed contact line in soil description indicates a gradational contact  
 USCS = Unified Soil Classification System  
 ▼ = denotes groundwater table

Monitoring Well Construction Log

Project Number  
090134-001-04

Well Number  
MW-15

Sheet  
1 of 3

Project Name: Lora Lake Apartment Parcel RI/FS

Ground Surface Elev. --

Location: Burien, WA

Top of Casing Elev. --

Driller/Method: Cascade / Rotasonic

Depth to Water (ft BGS) 17.93

Sampling Method: Continuous core

Start/Finish Date 8/23/2010-8/24/2010

Depth / Elevation (feet)	Borehole Completion	Sample Type/ID	Field Screening Observations	PID (ppm)	Density (psf)	Material Type	Description	Depth (ft)
1	Flush mount monument		No odor, sheen, or staining				<b>FILL</b> Dry, dark brown, slightly silty, slightly gravelly SAND (SP-SM); fine to medium sand, fine subrounded gravel, scattered organics (roots) Yellow-red/brown, fine to coarse gravel (1.5")	1
2	Neat cement (0-2')			2.0				2
3	Centralizer (2.5')							3
4							Decrease in gravel	4
5			No odor, sheen, or staining	7.0 (50)			Dry, yellow-red/brown, slightly silty, very gravelly SAND (SP-SM); predominantly fine to medium sand, fine to coarse subrounded gravel (2.5")	5
6								6
7	Bentonite chips (2-44.5')							7
8								8
9		Soil: MW15-8-10-082310	Slight sheen, slight sweet odor, no staining	3.0 (37)			Slightly moist, gray, gravelly SAND (SP); predominantly medium sand, fine to coarse rounded to subrounded gravel (2.5")	9
10								10
11			No odor, sheen, or staining	5.0			Slightly moist, dark gray, silty, gravelly SAND (SM); fine to coarse sand, fine to coarse rounded to subrounded gravel (2.5")	11
12								12
13							Red brick	13
14			No odor, sheen, or staining	2.0 (4.0)			Slightly moist, dark gray, slightly silty SAND (SP-SM); trace fine to coarse rounded gravel (1"); predominantly fine to medium sand	14
15	2" Sch40 PVC riser, flush-thread, O-rings (0.3-47.25')							15
16			No odor, sheen, or staining	2.5 (2)			<b>GLACIAL OUTWASH (Qvr/Qva)</b> Moist, light gray, silty SAND (SM); trace fine gravel, predominantly fine to medium sand	16
17			No odor, sheen, or staining	2.7 (7)			Moist, light gray SAND (SP); trace fine gravel, predominantly medium sand	17
18	▼ 9/13/2010							18
19	▽ 8/26/2010		No odor, sheen, or staining	2.7 (7)				19
20								20
21			No odor, sheen, or staining	2.8 (7.7)			Wet, light gray, slightly gravelly SAND (SP); predominantly coarse sand, fine gravel	21
22		Soil: MW15-20-25-082310	No odor, sheen, or staining	2.8 (7.7)			SAND (SP); trace gravel, predominantly medium sand	22
23			No odor, sheen, or staining	(2.8)			Wet, light gray/brown, very gravelly SAND (SP); medium to coarse sand, fine to coarse gravel (3.5")	23
24			No odor, sheen, or staining				Gravelly SAND (SP); predominantly medium sand; fine gravel	24

Sampler Type:

- No Recovery
- ▮ Continuous Core

PID - Photoionization Detector

- ▼ Static Water Level
- ▽ Water Level (ATD)

Logged by: JMS

Approved by: JJS

PID concentration in parenthesis measured directly from sonic sample bag.

Figure No.

**Monitoring Well Construction Log**

Project Number  
090134-001-04

Well Number  
MW-15

Sheet  
2 of 3

Project Name: Lora Lake Apartment Parcel RI/FS

Ground Surface Elev. --

Location: Burien, WA

Top of Casing Elev. --

Driller/Method: Cascade / Rotosonic

Depth to Water (ft BGS) 17.93

Sampling Method: Continuous core

Start/Finish Date 8/23/2010-8/24/2010

Depth / Elevation (feet)	Borehole Completion	Sample Type/ID	Field Screening Observations	PID (ppm)	Density (psf)	Material Type	Description	Depth (ft)
26			No odor, sheen, or staining	(5.6)			Wet, brown SAND (SP); trace fine gravel, predominantly medium sand	26
27		Soil: MW15-25-30-082310						27
28							Wet, dark brown, very gravelly SAND (SP); fine to coarse gravel (4"), predominantly medium sand	28
29								29
30			No odor, sheen, or staining	(3.2)			Gravelly SAND (SP); fine to coarse gravel (1.5")	30
31								31
32		Soil: MW15-30-35-082310						32
33							Wet, dark brown SAND (SP); medium sand	33
34								34
35			No odor, sheen, or staining	2.0 (10)				35
36								36
37		Soil: MW15-35-40-082310						37
38							Dark brown/gray	38
39								39
40			No odor, sheen, or staining	(2.5)			Gray, medium sand, coarsens downward to 42.5'	40
41								41
42		Soil: MW15-40-45-082310						42
43			No odor, sheen, or staining	(1.6)			Fine sand Medium sand, coarsens downward to 49'	43
44								44
45	2-12 sand (44.5-57.75')							45
46			No odor, sheen, or staining	(3.4)				46
47	Centralizer (46.75')							47
48			No odor, sheen, or staining	(5.9)				48
49		Soil: 49-50					Fine sand	49

Sampler Type:

- No Recovery
- Continuous Core

PID - Photoionization Detector

- Static Water Level
- Water Level (ATD)

Logged by: **JMS**

Approved by: **JJS**

PID concentration in parenthesis measured directly from sonic sample bag.

Figure No.

MONITORING WELL - SONIC LORA LAKE.GPJ July 20, 2011

**Monitoring Well Construction Log**

Project Number  
090134-001-04

Well Number  
MW-15

Sheet  
3 of 3

Project Name: Lora Lake Apartment Parcel RI/FS

Ground Surface Elev.           --          

Location: Burien, WA

Top of Casing Elev.           --          

Driller/Method: Cascade / Rotasonic

Depth to Water (ft BGS)           17.93          

Sampling Method: Continuous core

Start/Finish Date           8/23/2010-8/24/2010          

Depth / Elevation (feet)	Borehole Completion	Sample Type/ID	Field Screening Observations	PID (ppm)	Density (psf)	Material Type	Description	Depth (ft)
51	2" Sch40 PVC screen, flush-thread, O-rings, 0.010" slot (47.25-57.25')	Soil: MW15-50-55-082310	No odor, sheen, or staining	<1			Slightly moist to wet, gray SILT (ML)	51
52							Wet, gray SAND (SP); predominantly fine sand	52
53							No odor, sheen, or staining	2.1 (5.5)
54								54
55							Slightly moist to wet, gray, clayey SILT (CL-ML)	55
56								56
57	Centralizer (57.25')	Soil: MW15-55-60-082310	No odor, sheen, or staining	(2.0)				57
58	2" Sch40 PVC sump (57.25-57.75')							58
59	Bentonite chips (57.75-60')							59
60							Bottom of boring at 60'.	60
61								61
62								62
63								63
64								64
65								65
66								66
67								67
68								68
69								69
70								70
71								71
72								72
73								73
74								74

Sampler Type:

- No Recovery
- Continuous Core

PID - Photoionization Detector

- Static Water Level
- Water Level (ATD)

Logged by: **JMS**

Approved by: **JJS**

PID concentration in parenthesis measured directly from sonic sample bag.

Figure No.

### Monitoring Well Construction Log

Project Number  
090134-001-04

Well Number  
MW-16

Sheet  
1 of 2

Project Name: Lora Lake Apartment Parcel RI/FS

Ground Surface Elev. --

Location: Burien, WA

Top of Casing Elev. --

Driller/Method: Cascade / Rotosonic

Depth to Water (ft BGS) 11.54

Sampling Method: Continuous core

Start/Finish Date 8/24/2010-8/25/2010

Depth / Elevation (feet)	Borehole Completion	Sample Type/ID	Field Screening Observations	PID (ppm)	Density (psf)	Material Type	Description	Depth (ft)
1	Flush mount monument Neat cement (0-2')		No odor, sheen, or staining	3.3 (5.1)		FILL	Dry, brown, very sandy GRAVEL (GW); fine to coarse sand, fine to coarse subrounded gravel (3"), scattered organics	1
2							Dry, brown/yellow-red, silty SAND (SM); trace fine gravel, predominantly medium sand; silt lense w/ trace gravel at 3'	2
3			No odor, sheen, or staining	1.4 (4.7)			Dry, brown, slightly silty, very gravelly SAND (SP-SM); fine to coarse subrounded gravel (3"), fine to coarse sand	3
4								4
5							Slightly moist, brown/dark brown	5
6							<b>GLACIAL OUTWASH (Qvr/Qva)</b>	6
7	Bentonite chips (2-34.75')		No odor, sheen, or staining	2.2 (4.7)			Slightly moist, red-brown/dark brown SAND (SP); trace silt; trace fine rounded gravel; medium sand	7
8								8
9							Moist, dark brown, SAND (SP); trace silt, medium sand	9
10			No odor, sheen, or staining	2.7 (1.7)				10
11	▽ 8/26/2010 ▼ 9/13/2010						Moist, red-brown, slightly silty SAND (SP-SM); medium sand	11
12								12
13			No odor, sheen, or staining	1.8 (1.8)				13
14							Wet	14
15	2" Sch40 PVC riser, flush-thread, O-rings (0.3-37.25')						Wet, dark brown SAND (SP); medium sand; gradational color change to gray at 18'	15
16			No odor, sheen, or staining	1.9 (0.4)			Gray-purple sand pocket	16
17		Soil: MW16-15-20-082410						17
18							Gray, trace silt	18
19			No odor, sheen, or staining	2.3 (1.4)				19
20							Wet, gray-purple SAND (SP); medium sand	20
21								21
22		Soil: MW16-20-25-082410						22
23			No odor, sheen, or staining	1.7 (2.6)				23
24								24

Sampler Type:

- No Recovery
- Continuous Core

PID - Photoionization Detector

- ▼ Static Water Level
- ▽ Water Level (ATD)

Logged by: JMS

Approved by: JJS

PID concentration in parenthesis measured directly from sonic sample bag.

Figure No.

MONITORING WELL - SONIC LORA LAKE.GPJ September 27, 2010

### Monitoring Well Construction Log

Project Number  
090134-001-04

Well Number  
MW-16

Sheet  
2 of 2

Project Name: Lora Lake Apartment Parcel RI/FS

Ground Surface Elev. --

Location: Burien, WA

Top of Casing Elev. --

Driller/Method: Cascade / Rotosonic

Depth to Water (ft BGS) 11.54

Sampling Method: Continuous core

Start/Finish Date 8/24/2010-8/25/2010

Depth / Elevation (feet)	Borehole Completion	Sample Type/ID	Field Screening Observations	PID (ppm)	Density (psf)	Material Type	Description	Depth (ft)
26							Wet, dark brown SAND (SP); trace silt, medium-fine sand	26
27								27
28		Soil: MW16-25-30-082410	No odor, sheen, or staining	0.6 (2.5)				28
29							Medium sand	29
30								30
31								31
32		Soil: MW16-30-35-082410						32
33								33
34			No odor, sheen, or staining	0.8 (3.2)				34
35	2-12 sand (34.75-48.5')							35
36							Wet, dark brown SAND (SP); medium-fine sand; fining downward to silt at 39'	36
37	Centralizer (36.75')							37
38								38
39		Soil (Dup): 39-40	No odor, sheen, or staining	1.5 (5.8)			Wet, light gray SILT (ML)	39
40	2" Sch40 PVC screen, flush-thread, O-rings, 0.010" slot (37.25-47.25')	Soil: MW16-40-42-082410		0.9 (1.2)			Wet, gray, sandy SILT (ML); scattered organics	40
41								41
42							Wet, gray, very silty SAND (SM); fine sand	42
43			No odor, sheen, or staining	0.5 (1.5)				43
44		Soil: MW16-42-47.5-082410						44
45								45
46								46
47	Centralizer (47.25') 2" Sch40 PVC sump (47.25-47.75')		No odor, sheen, or staining	0.5 (1.1)			Wet, gray, clayey SILT (CL-SM)	47
48								48
49								49
Bottom of boring at 49.5'								

MONITORING WELL - SONIC LORA LAKE.GPJ September 27, 2010

Sampler Type:

- No Recovery
- Continuous Core

PID - Photoionization Detector

- Static Water Level
- Water Level (ATD)

Logged by: **JMS**

Approved by: **JJS**

PID concentration in parenthesis measured directly from sonic sample bag.

Figure No.

### Monitoring Well Construction Log

Project Number  
090134-001-04

Well Number  
MW-17

Sheet  
1 of 3

Project Name: Lora Lake Apartment Parcel RI/FS

Ground Surface Elev. --

Location: Burien, WA

Top of Casing Elev. --

Driller/Method: Cascade / Rotosonic

Depth to Water (ft BGS) 15.82

Sampling Method: Continuous core

Start/Finish Date 8/25/2010-8/26/2010

Depth / Elevation (feet)	Borehole Completion	Sample Type/ID	Field Screening Observations	PID (ppm)	Density (psf)	Material Type	Description	Depth (ft)
1	Flush mount monument		No odor, sheen, or staining	0.0		FILL	Dry, brown, slightly silty, gravelly SAND (SW-SM); fine to coarse sand, fine to coarse rounded to subrounded gravel (2.5"), scattered organics (roots)	1
2	Neat cement (0-2')							2
3			No odor, sheen, or staining	0.6			Dry, brown, gravelly SAND (SP); trace silt, predominantly medium sand, fine to coarse subrounded gravel (1.5"), occasional organics (wood)	3
4	2" Sch40 PVC riser, flush-thread, O-rings (0.3-42')							4
5							Yellow-red (oxidized), silty, gravelly SAND (SM) lense (6")	5
6			No odor, sheen, or staining	0.8			Yellow-red (oxidized), silty, gravelly SAND (SM) lense (6")	6
7	Bentonite chips (2-39.5')						Dry, brown, slightly silty, very gravelly SAND (SW-SM); fine to coarse sand, fine to coarse subrounded gravel (1.5")	7
8								8
9			No odor, sheen, or staining	0.4			Dry, yellow-red, slightly gravelly SAND (SP); trace silt, predominantly medium sand, fine rounded to subrounded gravel	9
10								10
11			No odor, sheen, or staining	1.3			Dry, dark brown, gravelly, silty SAND (SM); fine to coarse sand, fine rounded to subrounded gravel	11
12								12
13			No odor, sheen, or staining	0.9			<b>GLACIAL OUTWASH (Qvr/Qva)</b> Slightly moist, dark brown SAND (SP); trace silt, medium-fine sand	13
14								14
15			No odor, sheen, or staining	0.9			Moist, dark brown SAND (SP); with red-brown, silty SAND (SM) lense	15
16	▼ 9/13/2010		No odor, sheen, or staining	0.9			Wet Wet, dark brown SAND (SP); trace silt; with silty SAND (SM) lense	16
17		Soil: MW17-15-20-082610						17
18			No odor, sheen, or staining	0.8			Wet, dark brown SAND (SP); medium-fine sand; with scattered red-brown (oxidized) slightly silty SAND (SP-SM) pockets	18
19								19
20			No odor, sheen, or staining	1.3				20
21								21
22		Soil: MW17-20-25-082610	No odor, sheen, or staining	1.5				22
23								23
24			No odor, sheen, or staining				Brown, clayey silt laminae (0.25")	24

Sampler Type:

- No Recovery
- ▨ Continuous Core

PID - Photoionization Detector

- ▼ Static Water Level
- ▽ Water Level (ATD)

Logged by: JMS

Approved by: JJS

PID concentration in parenthesis measured directly from sonic sample bag.

Figure No.



### Monitoring Well Construction Log

Project Number  
090134-001-04

Well Number  
MW-17

Sheet  
2 of 3

Project Name: Lora Lake Apartment Parcel RI/FS

Ground Surface Elev. --

Location: Burien, WA

Top of Casing Elev. --

Driller/Method: Cascade / Rotosonic

Depth to Water (ft BGS) 15.82

Sampling Method: Continuous core

Start/Finish Date 8/25/2010-8/26/2010

Depth / Elevation (feet)	Borehole Completion	Sample Type/ID	Field Screening Observations	PID (ppm)	Density (psf)	Material Type	Description	Depth (ft)
26			No odor, sheen, or staining	1.4			Wet, dark brown/gray SAND (SP); medium sand	26
27		Soil: MW17-25-30-082610						27
28								28
29			No odor, sheen, or staining	1.2				29
30							Medium-fine sand	30
31			No odor, sheen, or staining	2.2				31
32		Soil: MW17-30-35-082610						32
33								33
34			No odor, sheen, or staining	1.1				34
35								35
36			No odor, sheen, or staining	0.6				36
37		Soil: MW17-35-40-082610						37
38								38
39			No odor, sheen, or staining	0.7				39
40	2-12 sand (39.5-52.5')						Wet, gray SAND (SP); medium sand	40
41	Centralizer (41.5')	Soil: MW17-40-42.5-082610						41
42			No odor, sheen, or staining	1.0				42
43					3500		Stiff, moist, gray, very clayey SILT (CL-ML)	43
44			No odor, sheen, or staining	0.5			Wet, gray SAND (SP); medium sand	44
45	2" Sch40 PVC screen, flush-thread, O-rings, 0.010" slot (42-52')				2500		Stiff, moist, gray, clayey SILT (CL-ML)	45
46			No odor, sheen, or staining	0.0				46
47		Soil: MW17-45-50-082610					Wet, gray, silty SAND (SM); fine sand	47
48							Wet, gray SAND (SP); trace silt, medium sand	48
49			No odor, sheen, or staining	0.0				49

Sampler Type:

- No Recovery
- Continuous Core

PID - Photoionization Detector

- Static Water Level
- Water Level (ATD)

Logged by: **JMS**

Approved by: **JJS**

PID concentration in parenthesis measured directly from sonic sample bag.

Figure No.

MONITORING WELL - SONIC LORA LAKE.GPJ September 27, 2010

### Monitoring Well Construction Log

Project Number  
090134-001-04

Well Number  
MW-17

Sheet  
3 of 3

Project Name: Lora Lake Apartment Parcel RI/FS

Ground Surface Elev.           --          

Location: Burien, WA

Top of Casing Elev.           --          

Driller/Method: Cascade / Rotosonic

Depth to Water (ft BGS)           15.82          

Sampling Method: Continuous core

Start/Finish Date           8/25/2010-8/26/2010          

Depth / Elevation (feet)	Borehole Completion	Sample Type/ID	Field Screening Observations	PID (ppm)	Density (psf)	Material Type	Description	Depth (ft)	
51	<p>Centralizer (52') 2" Sch40 PVC sump (52-52.5')</p>	Soil: 50-51	No odor, sheen, or staining	1.6	>5000		Very stiff, slightly moist, gray, very clayey SILT (CL-ML)	51	
52									52
53	<p>Bentonite chips (52.5-60')</p>		No odor, sheen, or staining	1.5			Moist/very moist, gray, silty SAND (SM) lense (6"); very fine sand	53	
54									54
55							4000	Moist	55
56				No odor, sheen, or staining	2.0				
57								57	
58		Soil: MW17-57.5-60-082610	No odor, sheen, or staining	2.1	3000		Stiff, slightly moist/moist, gray, very clayey SILT (CL-ML); with silty SAND (SM) pockets at 58'	58	
59									59
60								Bottom of boring at 60'	60
61									61
62								62	
63								63	
64								64	
65								65	
66								66	
67								67	
68								68	
69								69	
70								70	
71								71	
72								72	
73								73	
74								74	

Sampler Type:

- No Recovery
- Continuous Core

PID - Photoionization Detector

- Static Water Level
- Water Level (ATD)

Logged by: **JMS**

Approved by: **JJS**

PID concentration in parenthesis measured directly from sonic sample bag.

Figure No.

MONITORING WELL - SONIC LORA LAKE.GPJ September 27, 2010

# Boring Log HC99-B31

N 10,827.55, E 22,134.13

|| A\_MW23 ||

## Soil Descriptions

Ground Surface Elevation in Feet: 268.74

Very soft, moist, dark brown PEAT.

---

Dense to very dense, wet, gray, slightly silty, slightly gravelly to very gravelly, fine to coarse SAND.


2 feet of heave.

4 feet of heave.


3.5 feet of heave.

Bottom of Boring at 25.5 Feet.  
Completed 2/16/99.

Depth  
in Feet

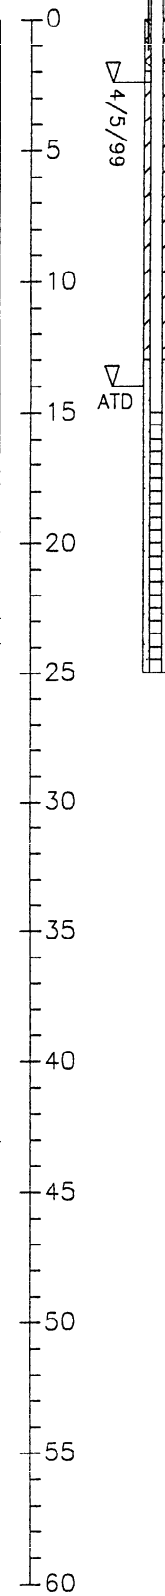


Sample

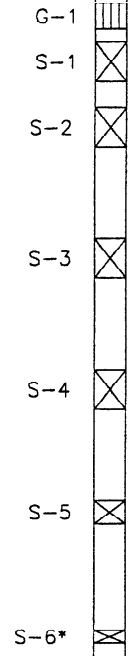

## STANDARD PENETRATION RESISTANCE

▲ Blows per Foot

1 2 5 10 20 50 100

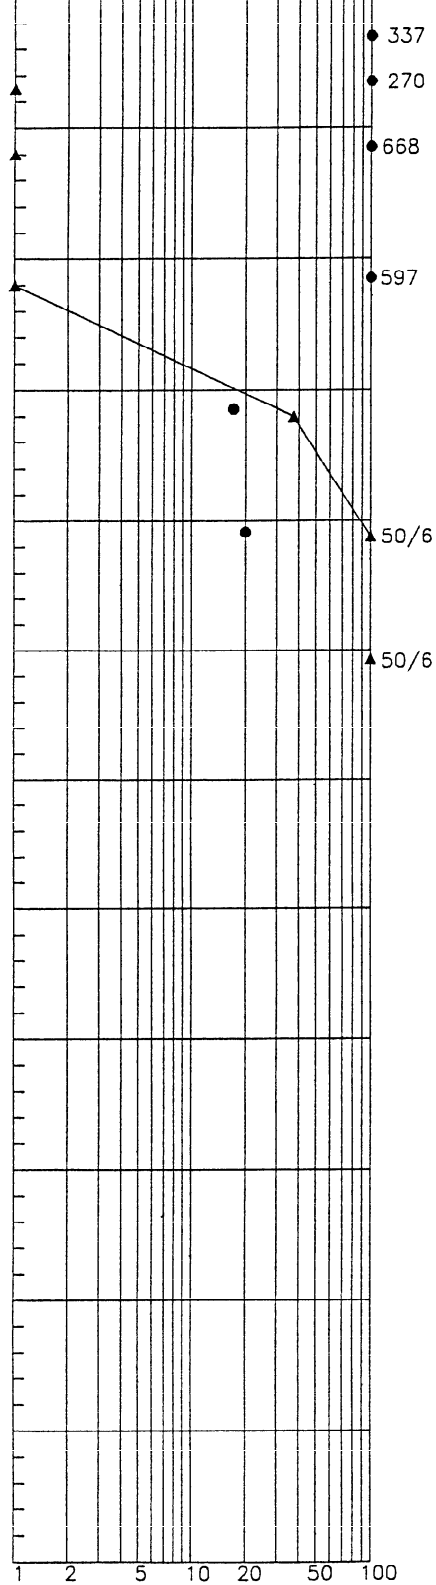

LAB TESTS



● Water Content in Percent

1. Refer to Figure A-1 for explanation of descriptions and symbols.
2. Soil descriptions and stratum lines are interpretive and actual changes may be gradual.
3. Groundwater level, if indicated, is at time of drilling (ATD) or for date specified. Level may vary with time.

3RDRW - B310  
(1665)

# Monitoring Well Log HC00-B310

|| A\_MW790 ||

N 22648  
E 11521

## Soil Descriptions

Ground Surface Elevation in Feet: 276

Top of Casing Elevation in Feet: 278.09



(Stiff), moist, brown, slightly gravelly, sandy SILT with organic material (FILL).

Dense, moist, brown to gray, silty, gravelly fine to medium SAND with trace organics and asphalt pieces (FILL).

Medium dense, moist to wet, brown to gray, slightly silty to silty, non-gravelly to gravelly, fine to medium SAND.

Bottom of Boring at 19.0 Feet.  
Completed 08/16/00.

Depth  
in Feet

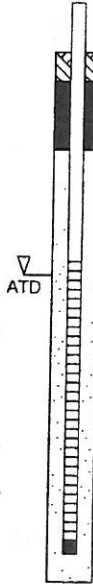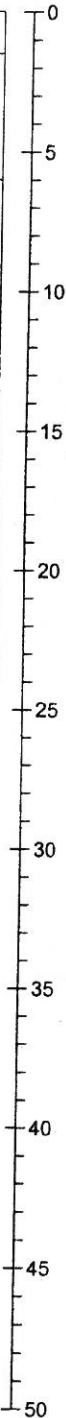


Sample


G-1  
S-1  
S-2  
S-3  
S-4

## STANDARD PENETRATION RESISTANCE

▲ Blows per Foot

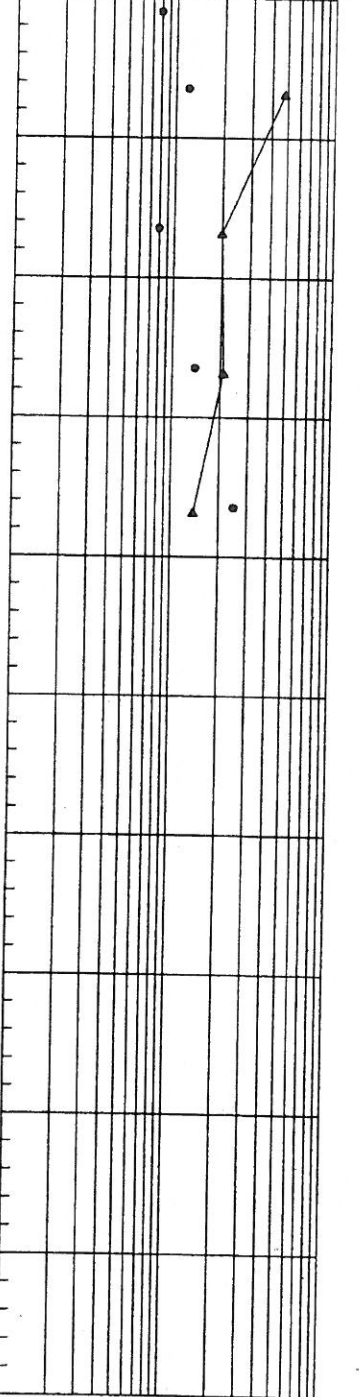

LAB  
TESTS

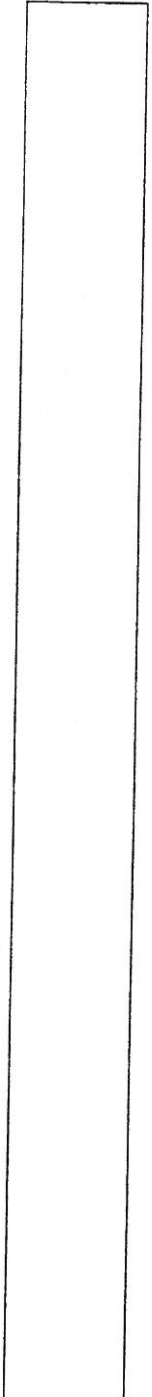

● Water Content in Percent

BORING LOG 497831F.GPJ HC\_CORP.GDT 9/1/00



**HARTCROWSER**

4978-31

08/00

Figure F-3

1. Refer to Figure A-1 for explanation of descriptions and symbols.
2. Soil descriptions and stratum lines are interpretive and actual changes may be gradual.
3. Ground water level, if indicated, is at time of drilling (ATD) or for date specified. Level may vary with time.

3RDRW-B311  
(1665)

# Monitoring Well Log HC00-B311



N 22417  
E 11370

## Soil Descriptions

Ground Surface Elevation in Feet: 274  
Top of Casing Elevation in Feet: 277.48

0 - 1.5	(Stiff), dry to moist, brown, gravelly, sandy SILT with organics.
1.5 - 4.5	Medium dense, moist, brown to gray, slightly gravelly, silty, fine to coarse SAND with organic material.
4.5 - 10.0	Medium dense, moist to wet, gray, silty, fine to medium SAND.
10.0 - 19.0	Stiff, wet, brown, sandy SILT.
19.0 - 50.0	Bottom of Boring at 19.0 Feet. Completed 08/16/00.


Depth  
in Feet

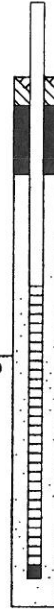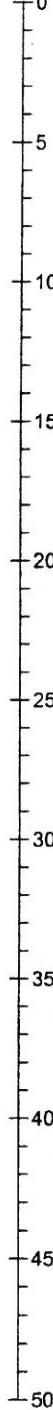

## || A\_MW792 ||

### STANDARD PENETRATION RESISTANCE

LAB TESTS

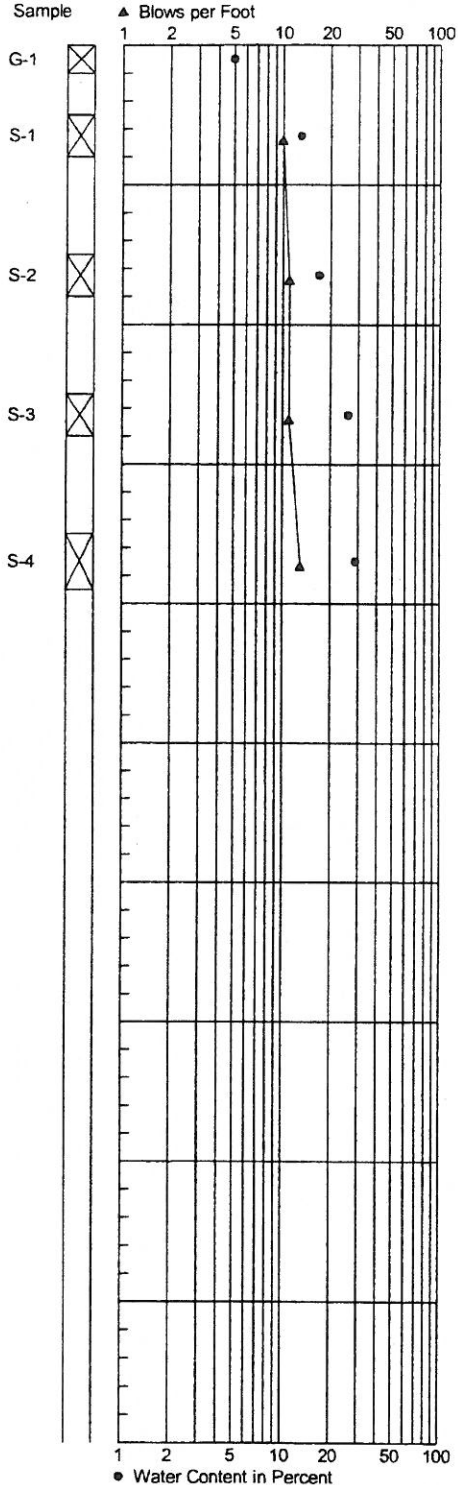

BORING LOG 497831F.GPJ HC\_CORP.GDT 9/1/00

1. Refer to Figure A-1 for explanation of descriptions and symbols.
2. Soil descriptions and stratum lines are interpretive and actual changes may be gradual.
3. Ground water level, if indicated, is at time of drilling (ATD) or for date specified. Level may vary with time.



4978-31

08/00

Figure F-4

2RDRW-B312  
(1665)

# Monitoring Well Log HC00-B312

N 22773  
E 11192  
Soil Descriptions

Ground Surface Elevation in Feet: 284  
Top of Casing Elevation in Feet: 283.79

|| A\_MW793 ||

STANDARD PENETRATION  
RESISTANCE

LAB  
TESTS



Very loose to (medium dense), moist, brown, slightly gravelly, silty, fine to coarse, SAND with clay lumps (possible FILL).

Loose to medium dense, moist to wet, brown, slightly gravelly, silty, fine to coarse, SAND.


Water added to counter heave.

Water added to counter heave.

Depth  
in Feet

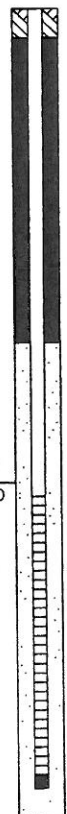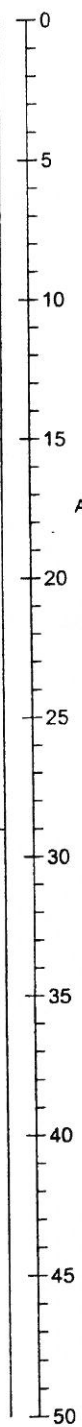

Sample  
G-1  
S-1  
S-2  
S-3  
S-4  
S-5  
S-6

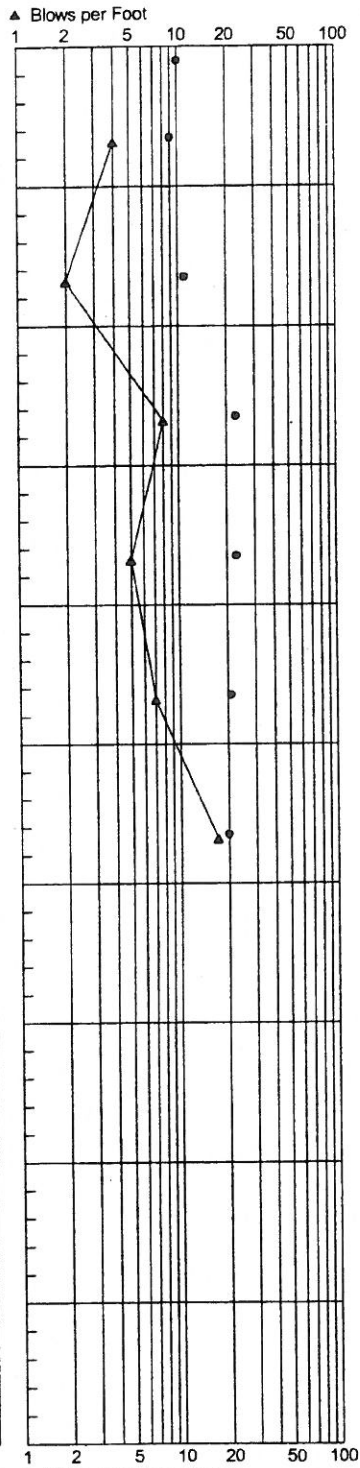

BORING LOG 497831F.GPJ HC\_CORP.GDT 9/5/00

Bottom of Boring at 29.0 Feet.  
Completed 08/16/00.

1. Refer to Figure A-1 for explanation of descriptions and symbols.
2. Soil descriptions and stratum lines are interpretive and actual changes may be gradual.
3. Ground water level, if indicated, is at time of drilling (ATD) or for date specified. Level may vary with time.



4978-31 08/00  
Figure F-5

Schematic of HPA1- mini-piezometers.

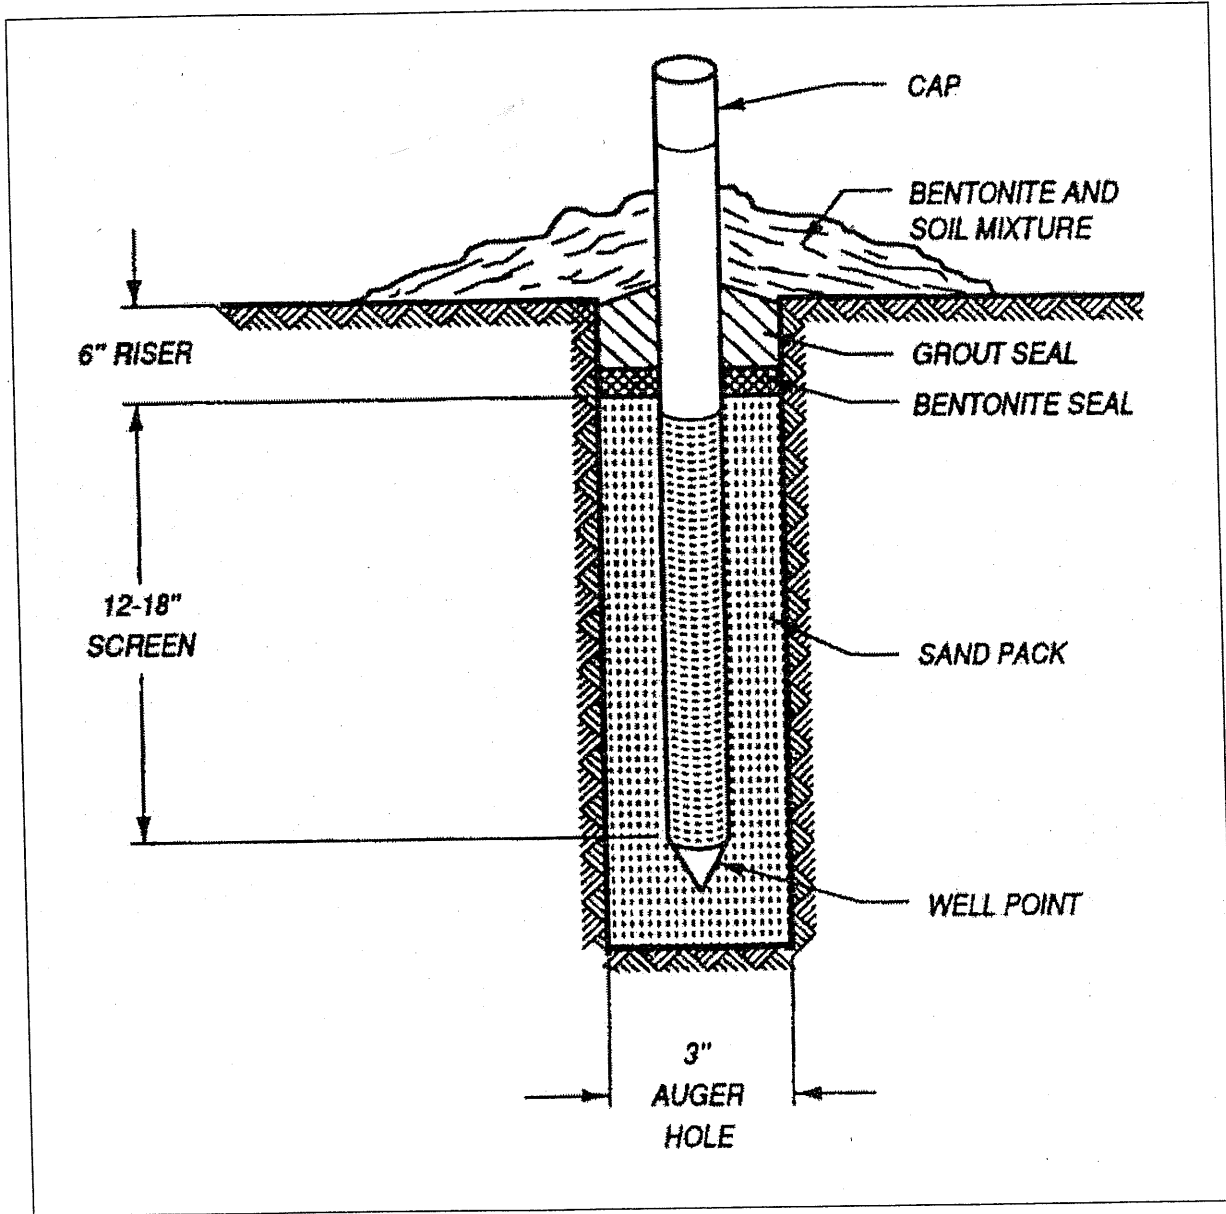


Figure 2-5. Groundwater Monitoring Well Design

## **APPENDIX C**

**Lora Lake 15-min and daily  
data\_with graphs.xlsx  
(Microsoft Excel File)**