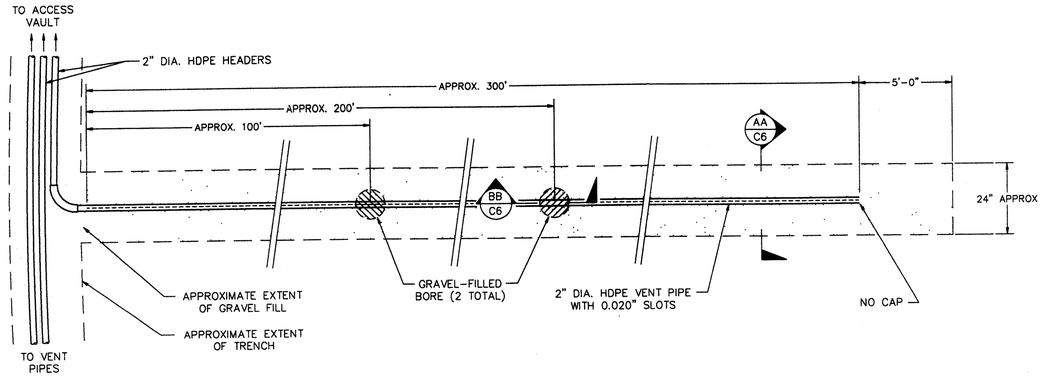

GAS COLLECTION TRENCH "TYPE I" TYPICAL DETAIL

1 / C6 NOT TO SCALE

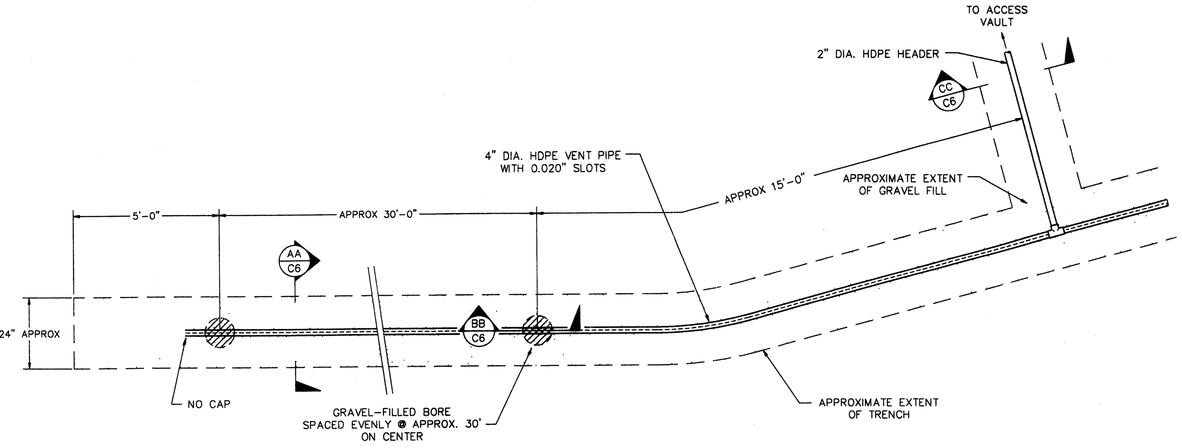

GAS COLLECTION TRENCH "TYPE II" TYPICAL DETAIL

2 / C6 NOT TO SCALE

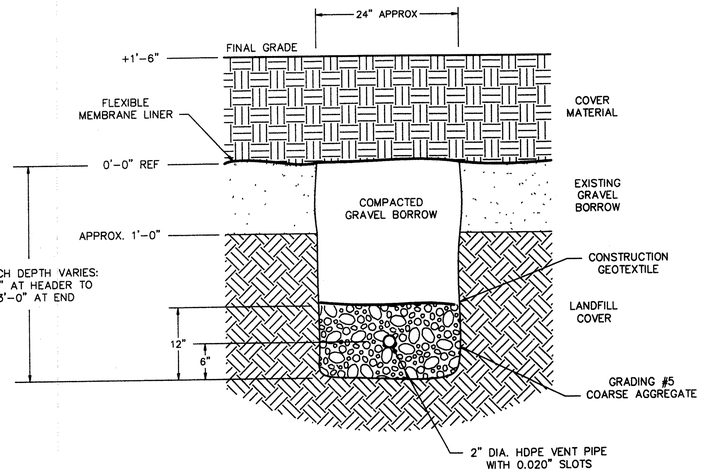

GAS COLLECTION TRENCH "TYPES I & II" TYPICAL SECTION

AA / C6 NOT TO SCALE

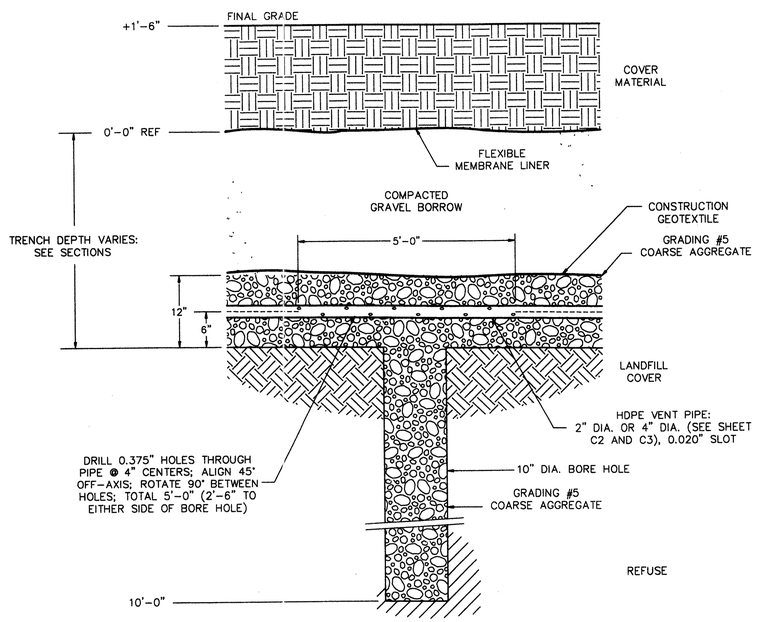

GRAVEL-FILLED BORE, TYPICAL SECTION

BB / C6 NOT TO SCALE

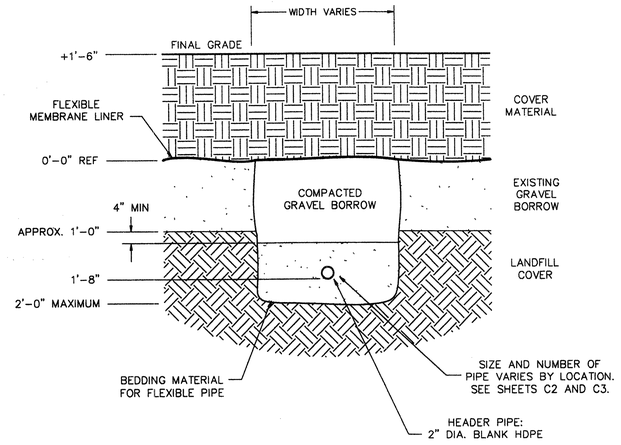

HEADER TRENCH "TYPE III" TYPICAL SECTION

CC / C6 NOT TO SCALE

JAMES S. DRANSFIELD — STATE OF WASHINGTON — 19361 — REGISTERED PROFESSIONAL ENGINEER — 4/27/95

EXPIRES 12/19/95

AS-BUILT

AGRA EARTH & ENVIRONMENTAL, INC. DRAWING No. \PLAN-SET\11\07764-04\C6.DWG

PLAN CHECK	BY	DATE	DATE	NO.	REVISION	BY

REGION NO.	STATE	FED. AID PROJ. NO.	SHEET NO
10	WASH.		7 OF 10

DESIGNED BY: MARTIN FOX — DRAWN BY: MARTIN FOX

DATE APPROVED: — FIELD BOOK(S):

AGRA
Earth & Environmental
11335 N.E. 122nd Way, Suite 100
Kirkland, Washington, U.S.A. 98034-6918
Tel (206) 820-4669 Fax (206) 821-3914

SNOHOMISH COUNTY ENGINEER

SNOHOMISH COUNTY DEPARTMENT OF PUBLIC WORKS

PROJECT NO.

128th ST. S.E. / DUMAS ROAD
LANDFILL GAS MANAGEMENT SYSTEM

GAS COLLECTION TRENCH DETAILS AND SECTIONS

SURVEY NO.

SHEET C6

Revised 12/17/96

Job Book 3321

DigiPrint™